


LEGAL DESCRIPTION

Being a portion of the SW 1/4 of the NE 1/4 of Section 31, T20S, R26E, M.D.M., Clark County, Nevada, more particularly described as follows: Beginning at the Southeast corner of the SW 1/4 of the NE 1/4 of said Section 31; thence N00°06'51" E along the East boundary line of said SW 1/4 a distance of 391.00 feet; thence S89°32'28" W a distance of 391.00 feet; thence S00°06'51" W a distance of 391.00 feet to a point on the South boundary line of said SW 1/4; thence N89°32'28" E along said South line a distance of 391.00 feet to the Point of Beginning.

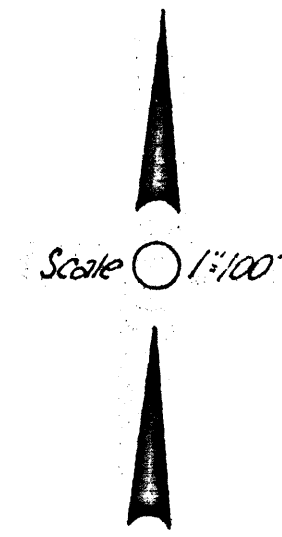

BASIS OF BEARINGS:

N89°32'28" E being the South boundary line of the NE 1/4 of Section 31, T20S, R26E, M.D.M., as shown by map on file in Office of the County Recorder as Page 69 of File 13 of Record Surveys, Clark County Nevada Official Records.

SURVEYOR'S CERTIFICATE

I, Kay L. Adams, a duly Registered Land Surveyor in the State of Nevada, do hereby certify that the survey of the land shown hereon was made under my direct supervision at the instance of Westminster Blueprint Co., owner of said parcel; the survey was completed on September 11, 1964 and the points found and set are correctly shown hereon. This plat is not intended to be a subdivision.

Kay L. Adams
Registered Land Surveyor
Nevada Certificate No. 2050



VOORHEIS-TRINDLE CO. OF NEVADA

953 A E. Sahara Ave. Suite 28-B Las Vegas, Nevada 89102

A PORTION OF THE SW 1/4 OF THE NE 1/4 OF SECTION 31, T20S, R26E, M.D.M.		SCALE: 1"=100'	DRAWN BY: Floyd
MAP FOR RECORD OF SURVEY FOR Westminster Blueprint Co.			
DATE: Sept. 11, 1964		WA: 102	

NO. 463490
RECORDED AT THE REQUEST OF
KAY L. ADAMS
DATE 10-7-64 AT 2:02 P.M.
FILE 15 PAGE 32 OF SURVEYS
OFFICIAL RECORDS BOOK NO. 576
CLARK COUNTY, NEVADA RECORDS
PAUL E. HORN RECORDER
FEE \$2.00 SS DEPUTY