


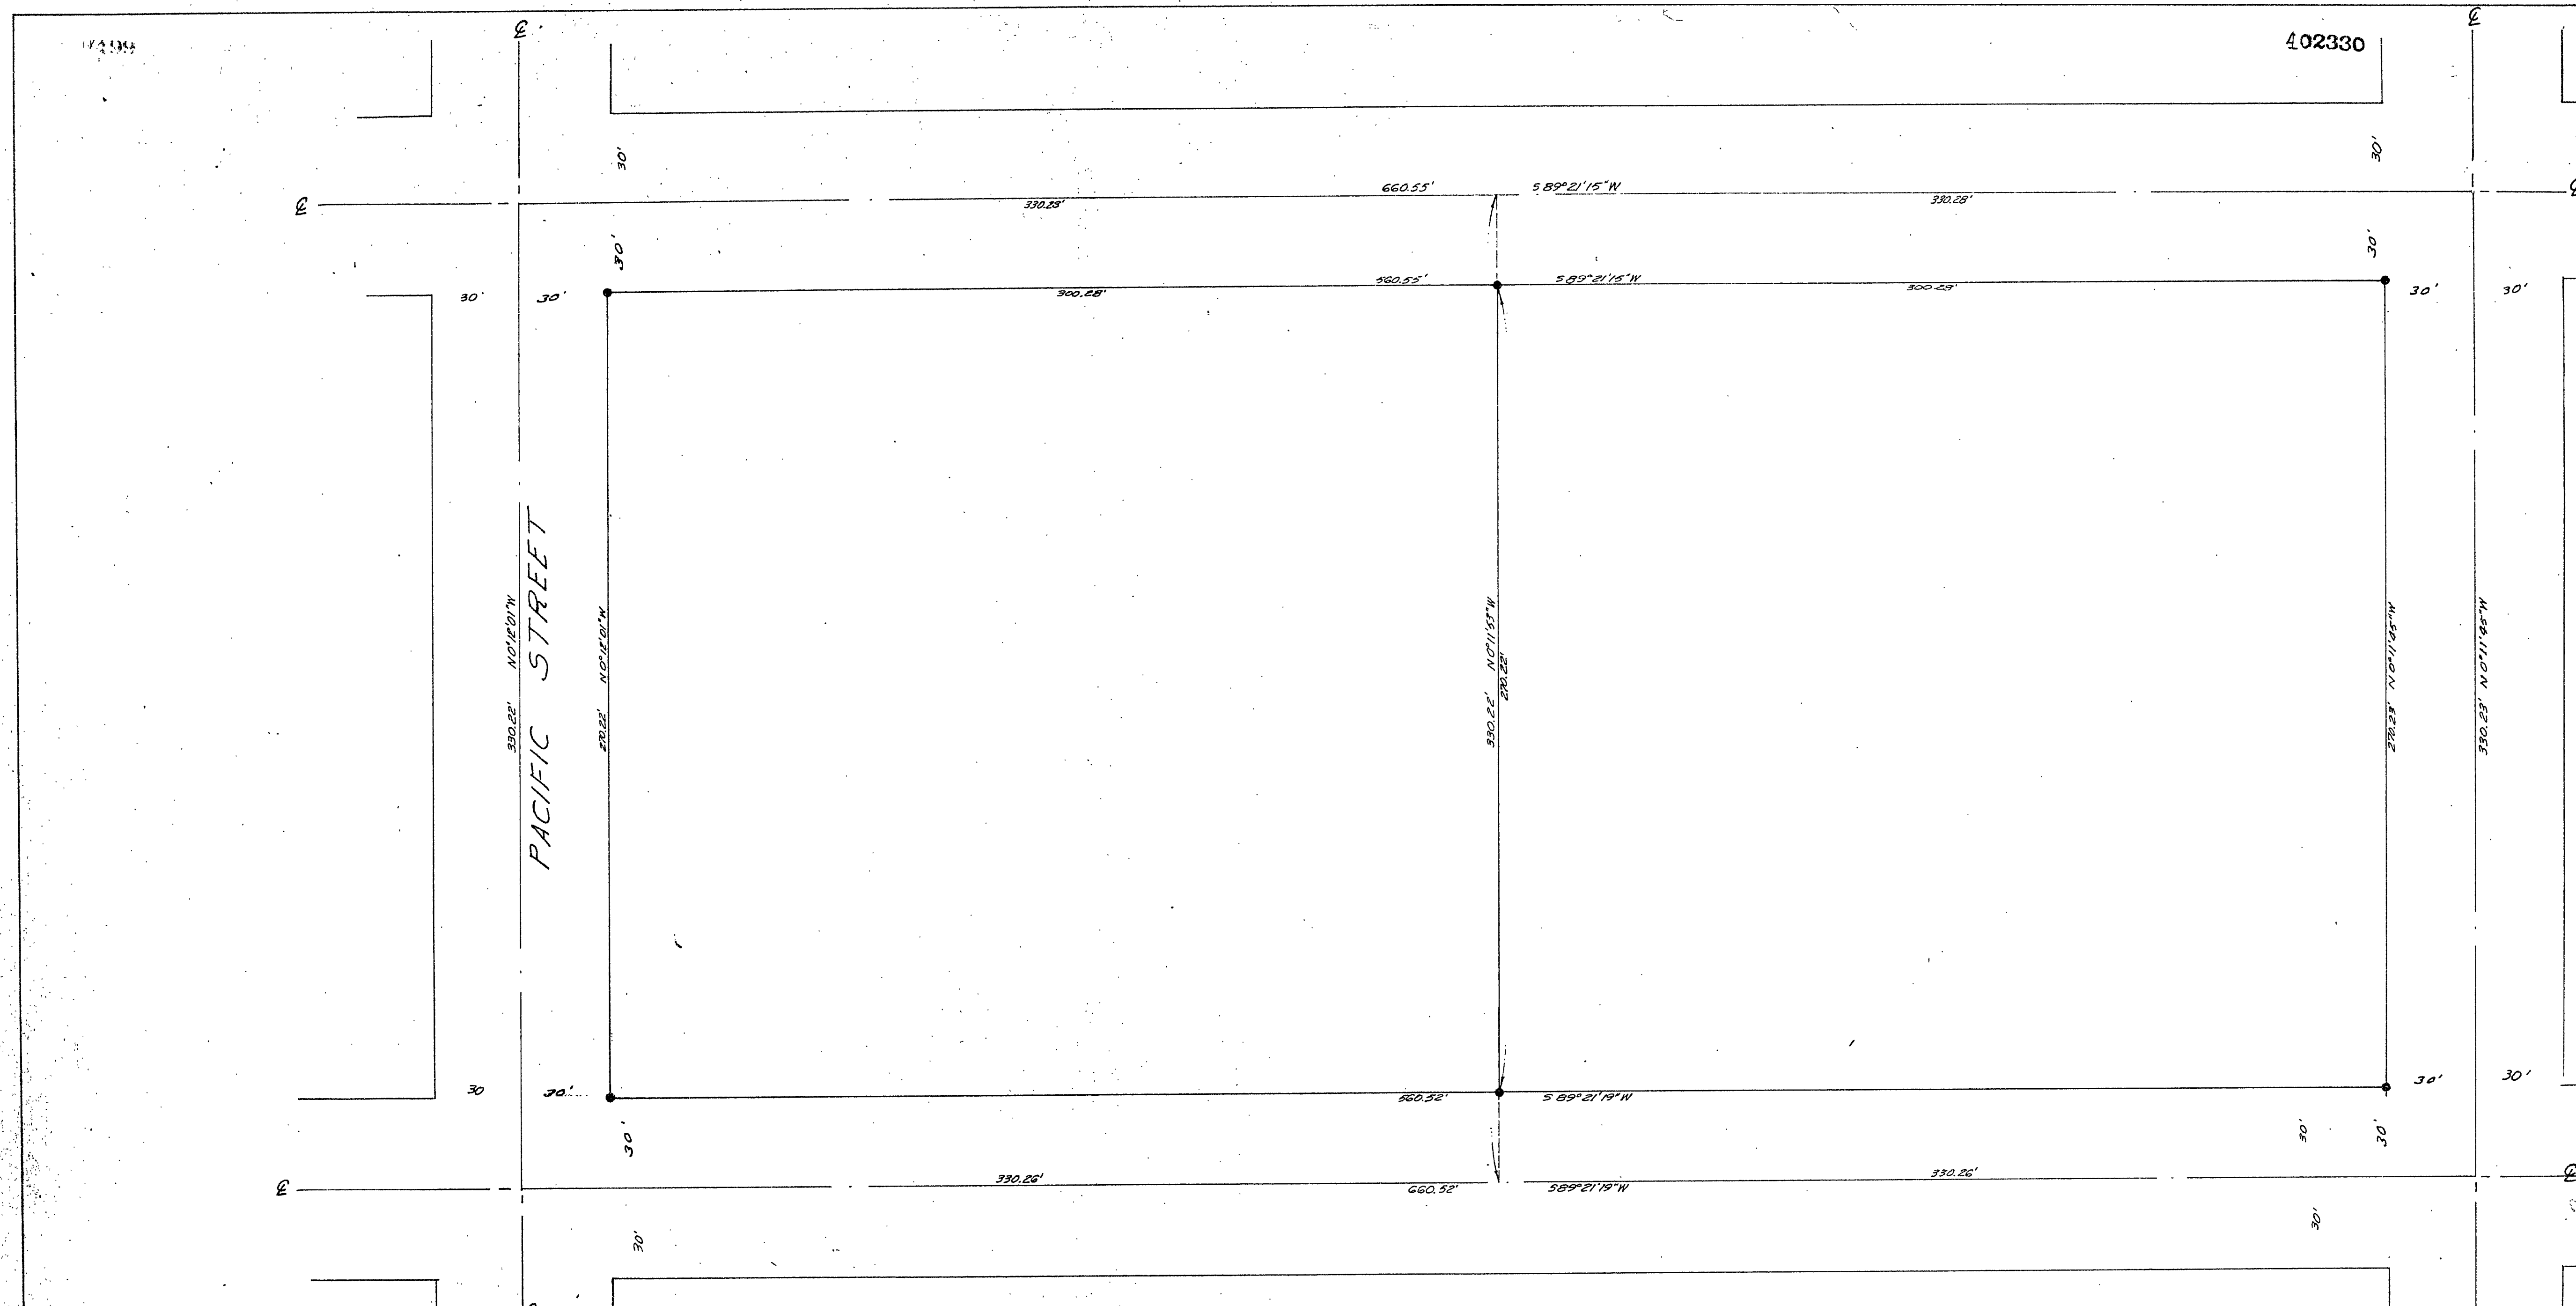

C E R T I F I C A T E

I, Jack K. Leavitt, Registered Professional Engineer and Land Surveyor do hereby certify that this map is a true and accurate representation of the lands shown hereon. All points found or set are correctly designated. This survey was completed on December 4, 1963 at the instance of Harold L. Miller and does not constitute a subdivision as defined by Nevada State Law.



Jack K. Leavitt
 Jack K. Leavitt
 Registered Professional Engineer
 Land Surveyor R.L.S. 807

L E G E N D

- o Indicates point found - as shown
- Indicates point set - 3/4" iron pipe with tag R.L.S. 807

Scale 1" = 30'

Basis of Bearings: The West Line of the SE 1/4, Section 19, T.22 S., R.63 E., M.D.B. & M. - N 0° 11' 45" W as per R.P.E. File 9, Page 68
 Reference Survey: R.P.E. File 9, File 68.

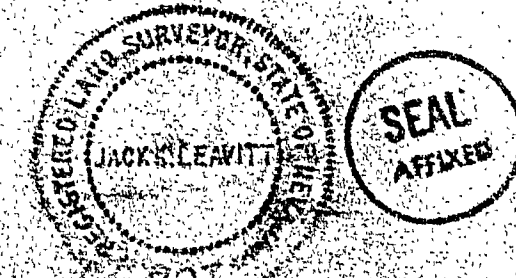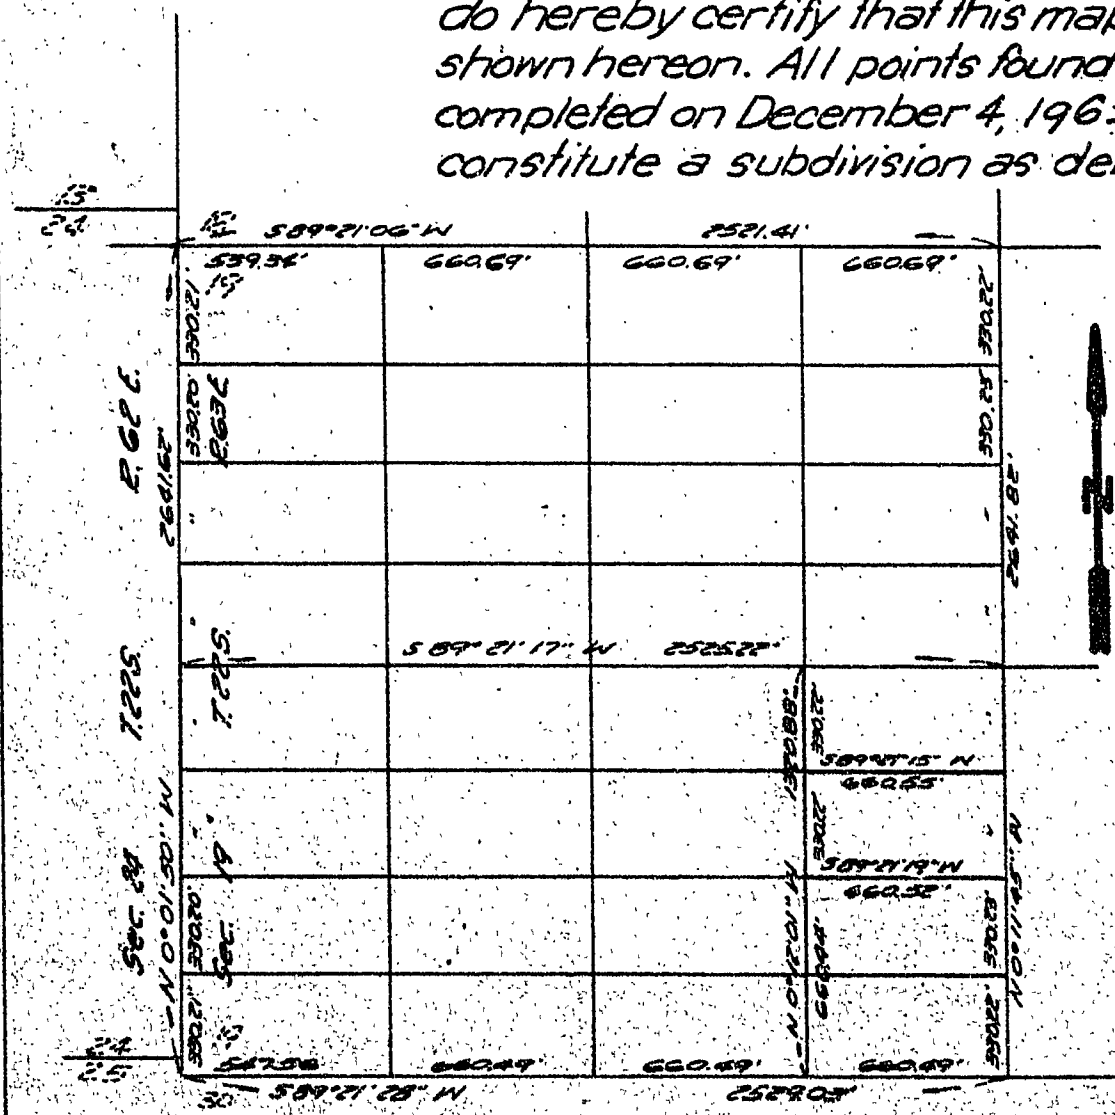

402330

Jack K. Leavitt
 Dec 12-17-63 at 2:31 P.M.
 File 14 Page 25
 CLARK COUNTY CLERK
 PAUL E. HORN, RECORDER
 Fee \$2.50

SURVEY
 PLAT

The S 1/2, NE 1/4, SE 1/4, SW 1/4, Section 19,
 T.22 S., R.63 E., M.D.B. & M.

Scale 1" = 30'

Surveyed by Jack K. Leavitt
 Registered Professional Engineer
 Land Surveyor R.L.S. 807

