



- IMPROVEMENTS**
- CONSTRUCT 3777.78 S.Y. OF 3" ASPHALT PAVEMENT OVER 4" TYPE II AGGREGATE BASE. A 1" OVERLAY IS REQUIRED UNDER SEPARATE CONTRACT.
  - INSTALL 1,000.00 L.F. OF 8" "L" TYPE CURB AND GUTTER
  - INSTALL 1 EA. TYPE 3 MONUMENTS.
- STREET LIGHTING AND ELECTRICAL**
- (SHOW FOR REFERENCE ONLY; SEE SHEETS SL-1 & SL-2 FOR STREET LIGHTING INSTALLATION).
- (SEE NEVADA POWER CO. DWGS. FOR ELECTRICAL DISTRIBUTION).
- BENCHMARK**
- RIVET AND PLATE IN TOP OF CURB NW SIDE OF TOWN CENTER DRIVE AND SOUTH ROUNDABOUT ISLAND.  
ELEVATION = 2725.925  
PER CITY OF LAS VEGAS DATUM STATION: OLVOO 1954  
SEE SHEET CG-3 FOR LOCATION.

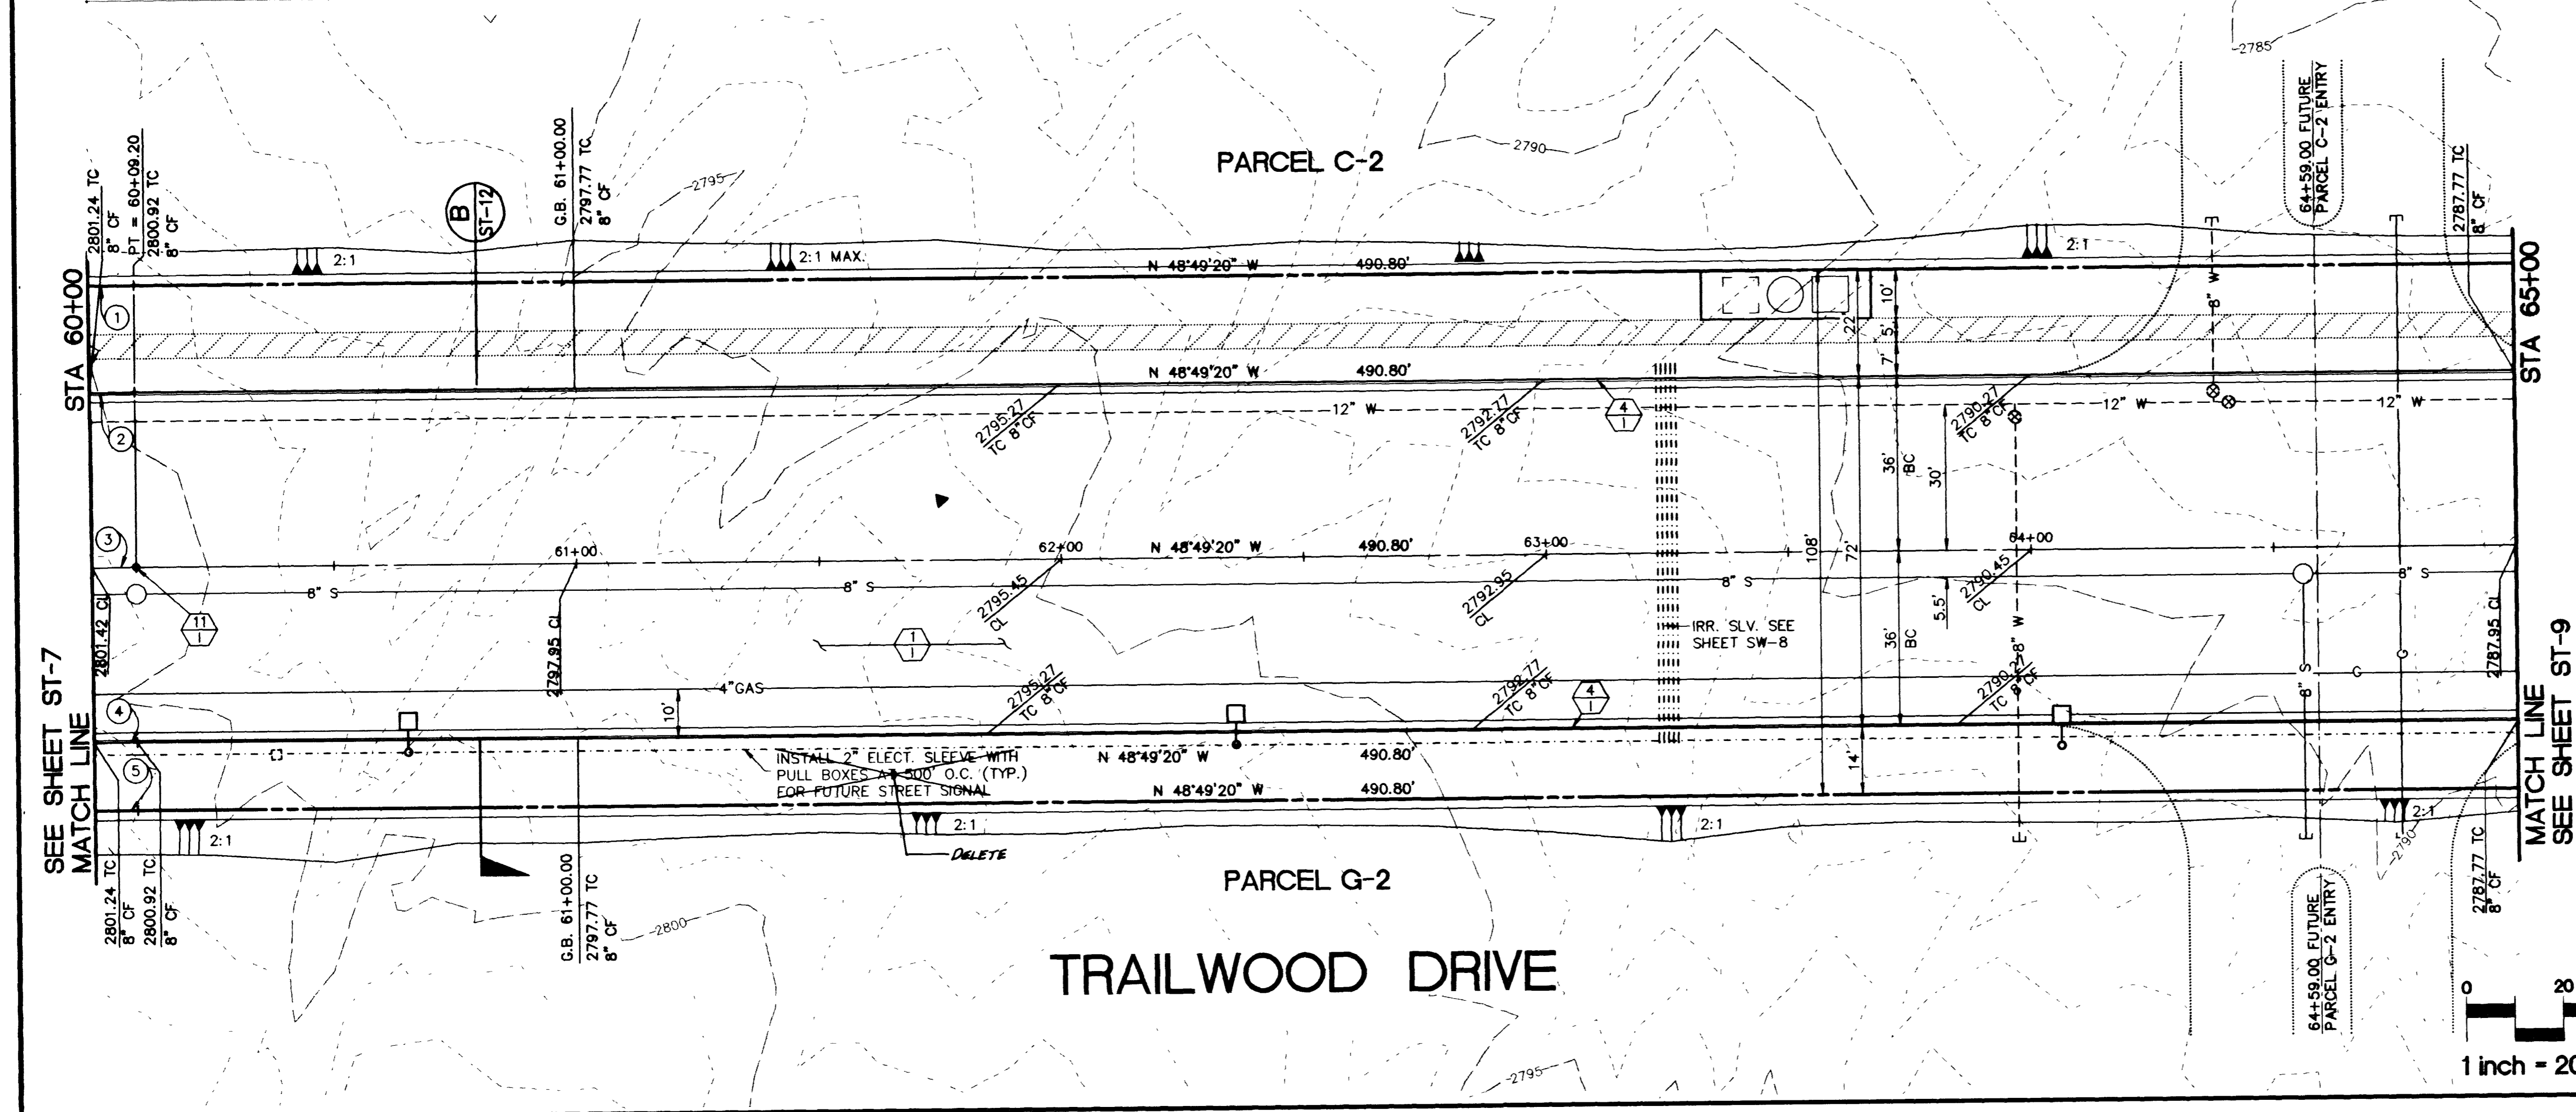

CURVE NUMBERS ARE SHOWN (D) ON PLANS

CURVE DATA				
CURVE	RADIUS	LENGTH	TANGENT	DELTA
1	1558.00'	9.55'	4.78'	00°21'05"
2	1536.00'	9.42'	4.71'	00°21'05"
3	1500.00'	9.20'	4.60'	00°21'05"
4	1464.00'	8.98'	4.49'	00°21'05"
5	1450.00'	8.89'	4.45'	00°21'05"

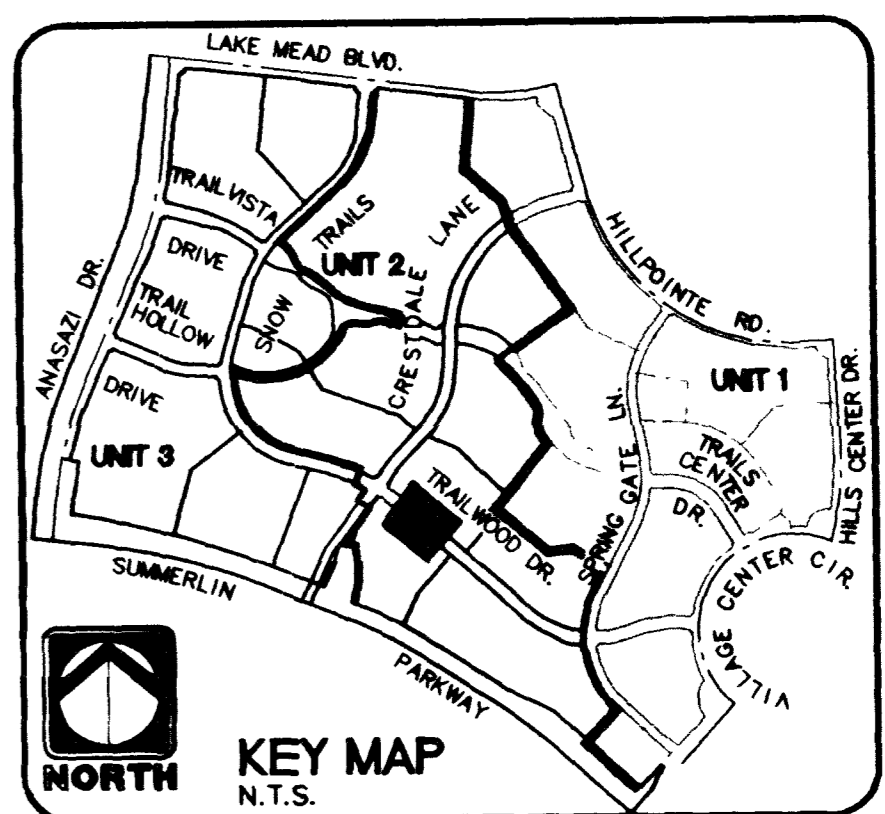

1 inch = 20 ft

NORTH

Call before you Dig.  
1-800-227-2800  
UNDERGROUND SERVICE (USA)

**RECORD DRAWING**  
RECORD INFORMATION REQUIRED BY FIELD CONTRACTOR

RECOMMENDED

PLANNING  
ENGINEERING  
LANDSCAPE ARCHITECTURE  
LAND SURVEYING  
CONSTRUCTION MANAGEMENT

THE KEITH COMPANIES NEVADA  
4052 SO. INDUSTRIAL RD. LAS VEGAS, NV 89103 (702) 753-0660

HOWARD HUGHES PROPERTIES  
SUMMERLIN VILLAGE 7 - THE TRAILS - UNIT 2  
TRAILWOOD DRIVE  
PLAN AND PROFILE  
STA 60+00 - STA 65+00

SHEET  
**ST-8**  
SHT 18 OF 48

DATE APPROVAL  
REVISION DESCRIPTION DATE APPROVAL

REVISION 1  
REVISION 2  
REVISION 3

REVISION 1001

HP DesignJet 6001 HP-GL/2 ADI 4.2 plotter driver by Hewlett-Packard 1.0

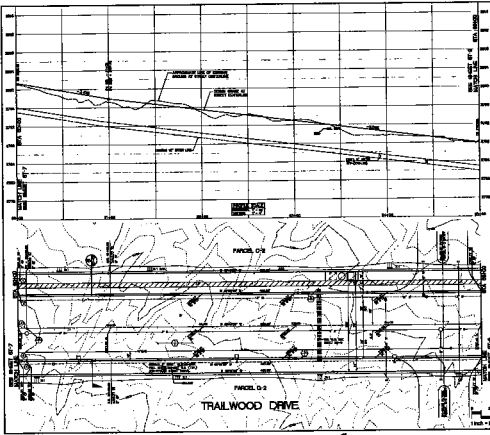

**REVISIONS**

① REVISIONS TO BE MADE BY THE ENGINEER

② REVISIONS TO BE MADE BY THE ARCHITECT

③ REVISIONS TO BE MADE BY THE CITY ENGINEER

④ REVISIONS TO BE MADE BY THE STATE ENGINEER

**STREET LIGHTING AND ELECTRICAL**

SEE SPECIFICATIONS AND NOTES FOR DETAILS

**NOTES**

SEE SPECIFICATIONS AND NOTES FOR DETAILS

SEE SPECIFICATIONS AND NOTES FOR DETAILS

SEE SPECIFICATIONS AND NOTES FOR DETAILS

NO.	DATE	DESCRIPTION
1		
2		
3		
4		
5		
6		
7		
8		
9		
10		



RECORD DRAWING

PROJECT NO. 11-2-77  
 SHEET NO. ST-5  
 DATE: 11-2-77  
 DRAWN BY: [Signature]  
 CHECKED BY: [Signature]  
 ENGINEER: [Signature]  
 ARCHITECT: [Signature]  
 CITY ENGINEER: [Signature]  
 STATE ENGINEER: [Signature]

11-2-77