

- IMPROVEMENTS**
- CONSTRUCT 2027.70 S.Y. OF 2" ASPHALT PAVEMENT WITH A 1" OVERLAY OVER 4" TYPE II AGGREGATE BASE.
  - INSTALL 1000.70 L.F. OF 8" T.I. TYPE CURB AND CUTTER.
  - INSTALL 1 EA. TYPE 3 MONUMENTS.



**STREET LIGHTING AND ELECTRICAL**

(SHOW FOR REFERENCE ONLY; SEE SHEETS SW-1 & SW-2 FOR STREET LIGHTING INSTALLATION)

(SEE NEVADA POWER CO. DWGS. FOR ELECTRICAL DISTRIBUTION)


**BENCHMARK**

RIVET AND PLATE IN TOP OF CURB NW SIDE OF TOWN CENTER DRIVE AND SOUTH ROUNDABOUT ISLAND  
 ELEVATION = 2725.923  
 PER CITY OF LAS VEGAS DATUM STATION: 14900  
 1954  
 SEE SHEET SW-3 FOR LOCATION

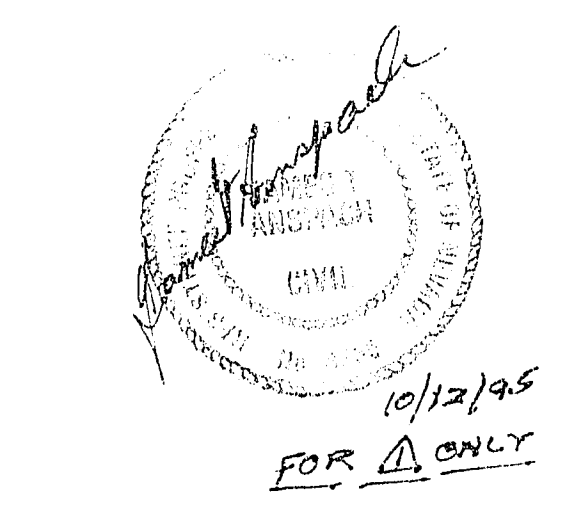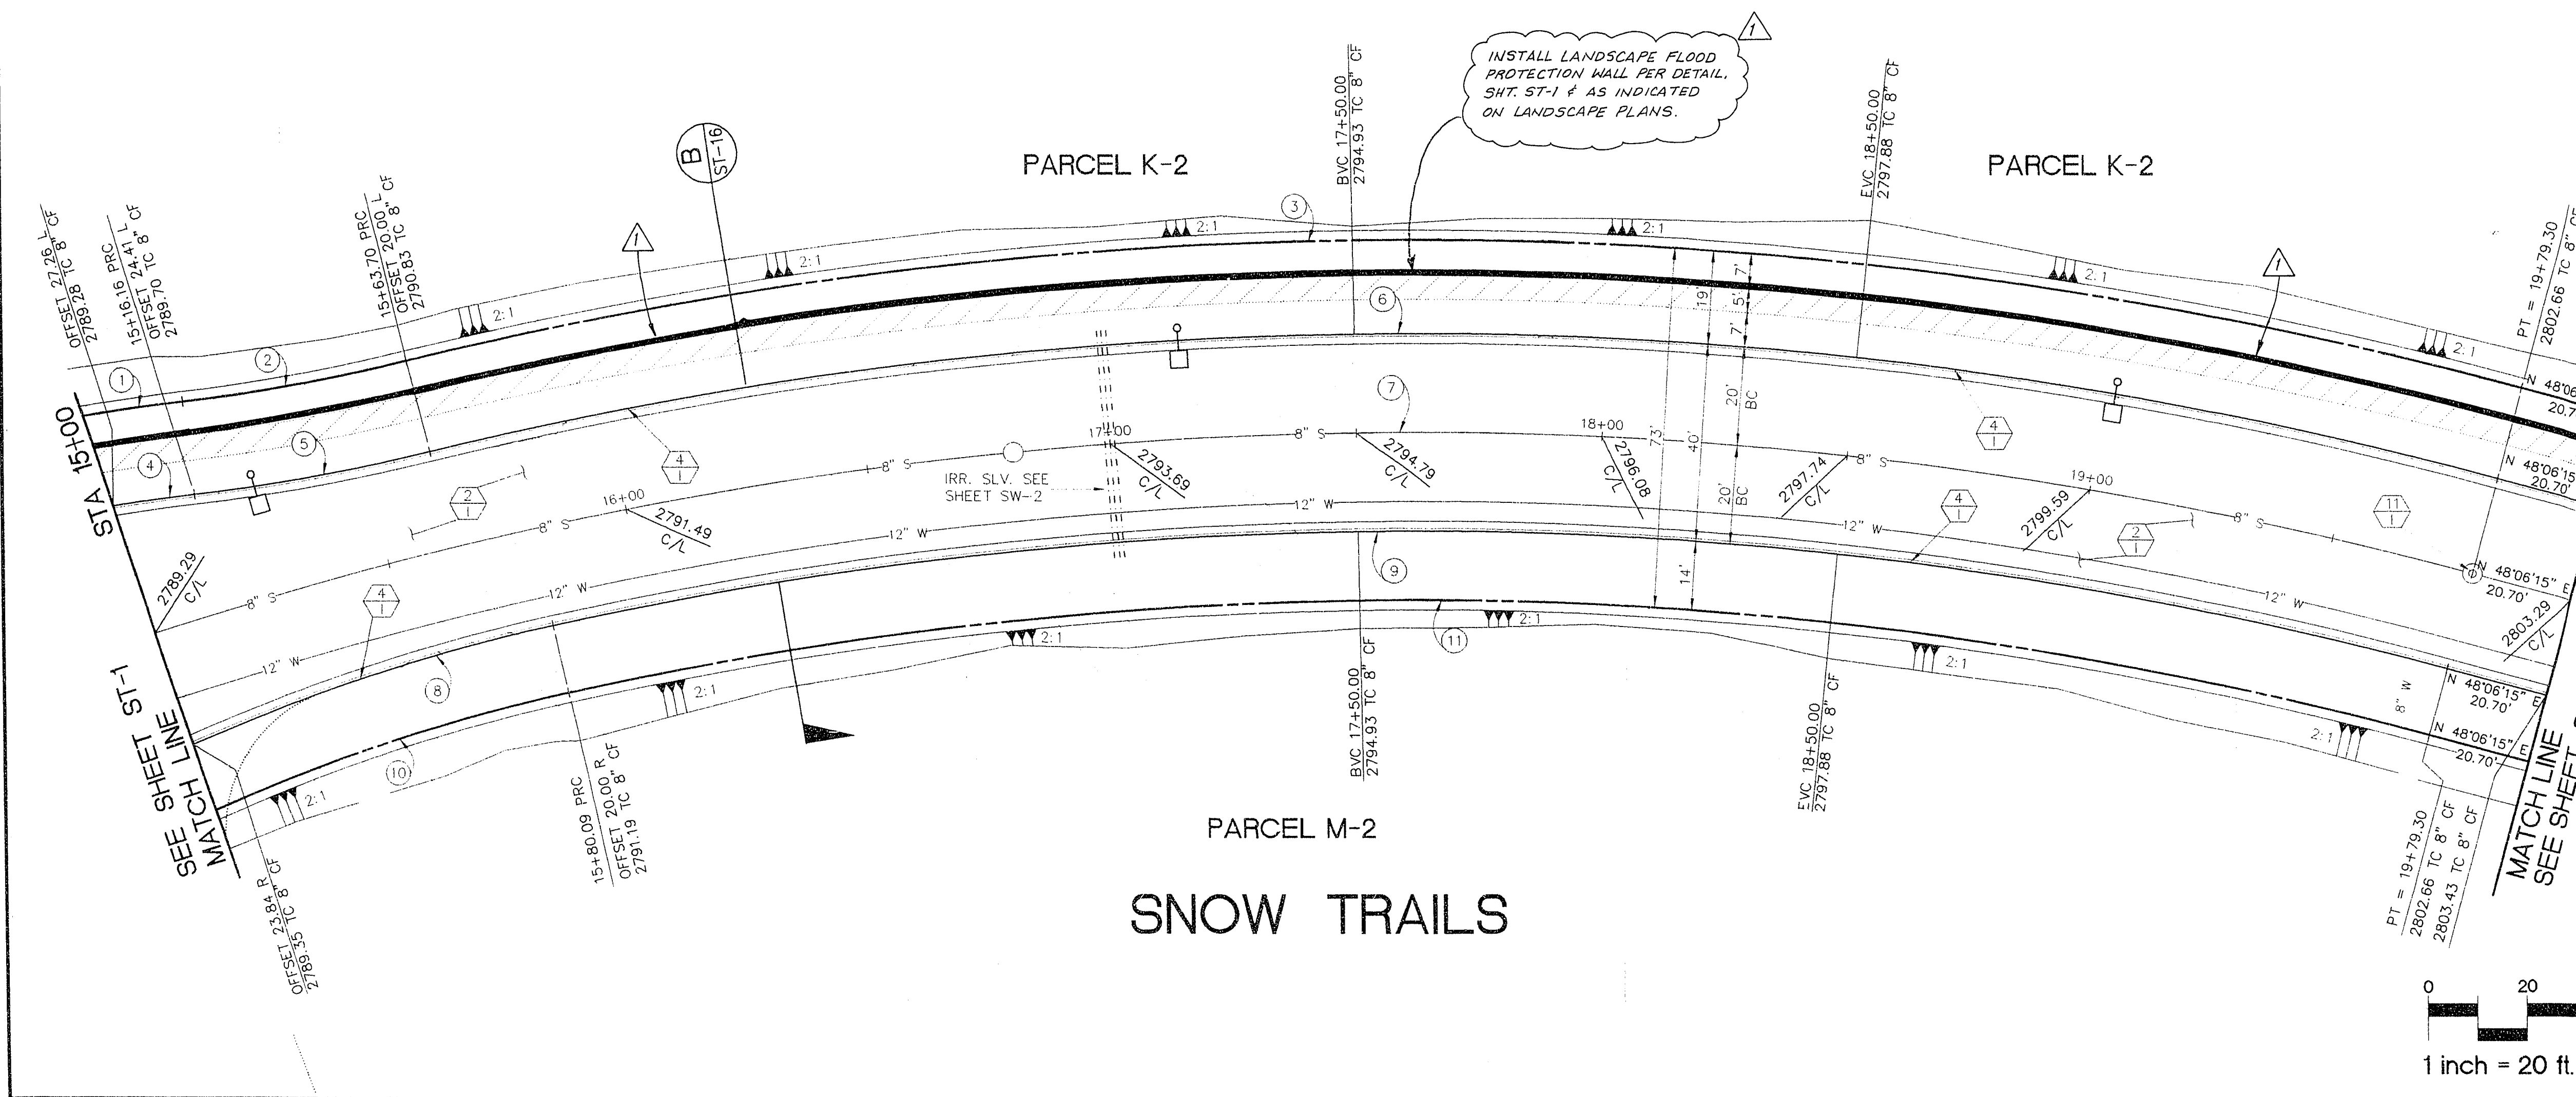

CURVE NUMBERS ARE SHOWN (O) ON PLANS

CURVE	RADIUS	LENGTH	TANGENT	DELTA
1	419.00'	20.73'	10.36'	02°50'02"
2	381.00'	46.72'	23.39'	07°01'33"
3	864.00'	435.24'	222.34'	28°51'46"
4	400.00'	16.90'	8.45'	02°25'16"
5	400.00'	49.05'	24.56'	07°01'33"
6	845.00'	425.67'	217.45'	28°51'46"
7	825.00'	479.30'	246.62'	33°17'13"
8	400.00'	78.15'	39.20'	11°11'38"
9	805.00'	389.53'	198.86'	27°43'29"
10	386.00'	76.79'	38.52'	11°23'55"
11	791.00'	382.76'	195.20'	27°43'29"

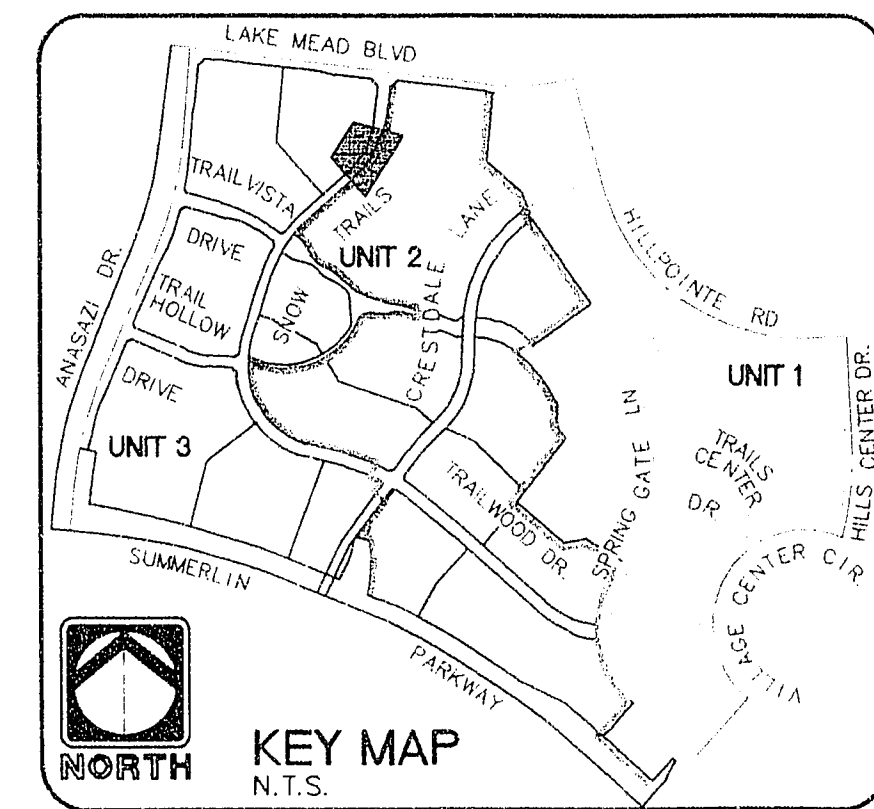

**RECORD DRAWING**

RECORD INFORMATION PROVIDED BY FIELD CONTRACTOR

RECOMMENDED  
 PLANNING  
 ENGINEERING  
 SURVEYING  
 LANDSCAPE ARCHITECTURE  
 AND SURVEYING  
 CONSTRUCTION

THE KEITH COMPANIES  
 NEVADA  
 4085 SO. INDUSTRIAL RD. LAS VEGAS, NV 89102 (702) 784-0880

ENGINEER  
 HOWARD HUGHES PROPERTIES  
 SUMMERLIN VILLAGE 7 - THE TRAILS - UNIT 3  
 SNOW TRAILS  
 PLAN AND PROFILE  
 STA 15+00 - STA 20+00

SHEET  
 ST-2  
 SHT 11 OF 54

DATE: 7/19/19  
 R.P.E.: [Signature]  
 DATE: 10/12/19  
 DATE: 10/12/19  
 DATE: 10/12/19

107Y-4271-3