


3: 5/24/2017 10:45:15, Tue 11:19:10 42-48 1994, SHARED 1-9, WHITEOUT 10, SOLID 11 & UP, 48P-50P40
4: 1/25/2017 10:45:15, Tue 11:19:10 42-48 1994, SHARED 1-9, WHITEOUT 10, SOLID 11 & UP, 48P-50P40

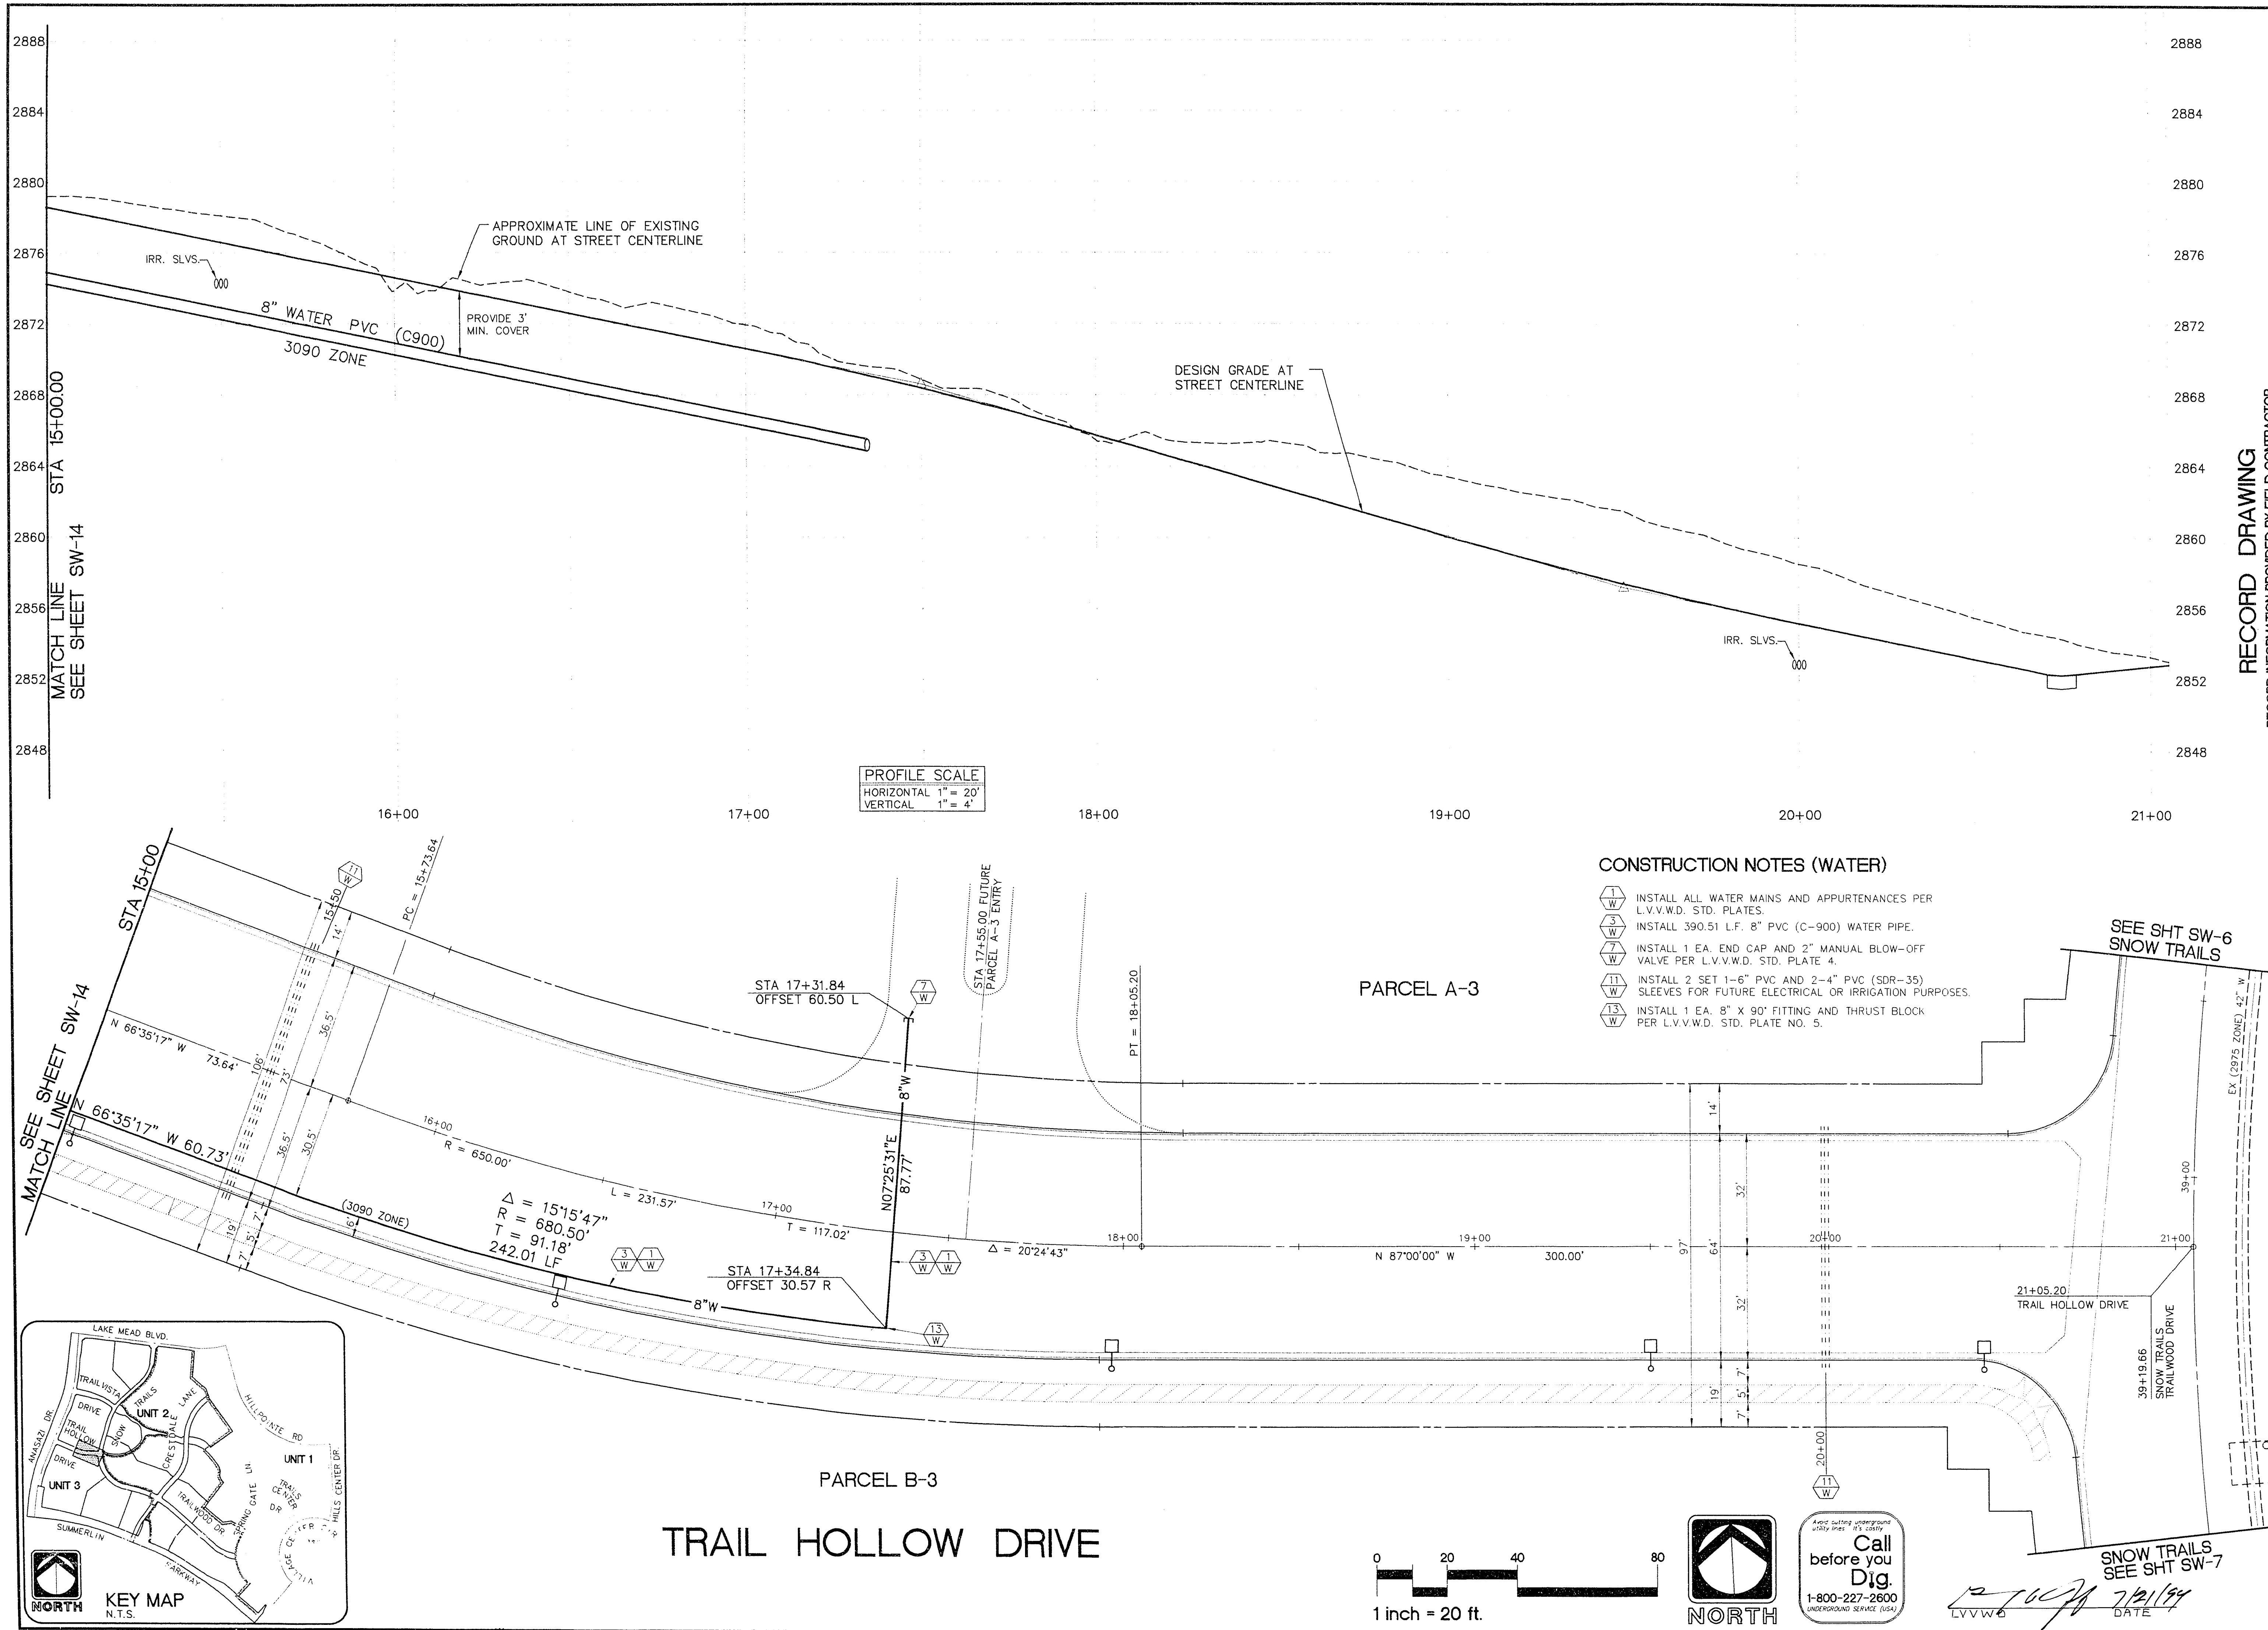

PROFILE SCALE
HORIZONTAL 1" = 20'
VERTICAL 1" = 4'

CONSTRUCTION NOTES (WATER)

1. INSTALL ALL WATER MAINS AND APPURTENANCES PER L.V.V.W.D. STD. PLATES.
3. INSTALL 390.51 L.F. 8" PVC (C-900) WATER PIPE.
7. INSTALL 1 EA. END CAP AND 2" MANUAL BLOW-OFF VALVE PER L.V.V.W.D. STD. PLATE 4.
11. INSTALL 2 SET 1-6" PVC AND 2-4" PVC (SDR-35) SLEEVES FOR FUTURE ELECTRICAL OR IRRIGATION PURPOSES.
13. INSTALL 1 EA. 8" X 90° FITTING AND THRUST BLOCK PER L.V.V.W.D. STD. PLATE NO. 5.

RECORD DRAWING

RECORD INFORMATION PROVIDED BY FIELD CONTRACTOR

RECOMMENDED	DATE
PLANNING	
CIVIL ENGINEERING	
LANDSCAPE ARCHITECTURE	
CONSTRUCTION MANAGEMENT	
10584	2/19/94
R.P.E.	DATE
LARRY R. BERRY	
DATE	
REV	DATE
DESCRIPTION	
DATE	
APPROVAL	

ENGINEER
THE KEITH COMPANIES
NEVADA
4082 SO. INDUSTRIAL RD. LAS VEGAS, NV 89102 (702) 735-0350

HOWARD HUGHES PROPERTIES
SUMMERLIN VILLAGE 7 - THE TRAILS - UNIT 3
TRAIL HOLLOW DRIVE
SEWER AND WATER
STA 15+00.00 - STA 21+05.20

SHEET
SW-15
SHT 44 OF 54

11-2-13

307Y-4271-3