

3-153A-YT03
 8-W2 SEE SHEET 8-3
 8-W2 SEE SHEET 8-3
 8-W2 SEE SHEET 8-3

HOWARD HUGHES PROPERTIES
 3 UNIT 3 - THE TRAILS AT
 TRAILWOOD DRIVE
 BAYVIEW AND REMER
 00+88 ATB - 00+103 ATB




ENGINEERS
KEITH ADAMS COMPANY
 10801
 48201
 10801
 48201

RECOMMENDED
 10801
 48201

DATE
 DESCRIPTION
 DATE

HTP NOW
 DATE
 80
 40
 0
 ft
 1 inch = 20 ft

HTP NOW
 DATE

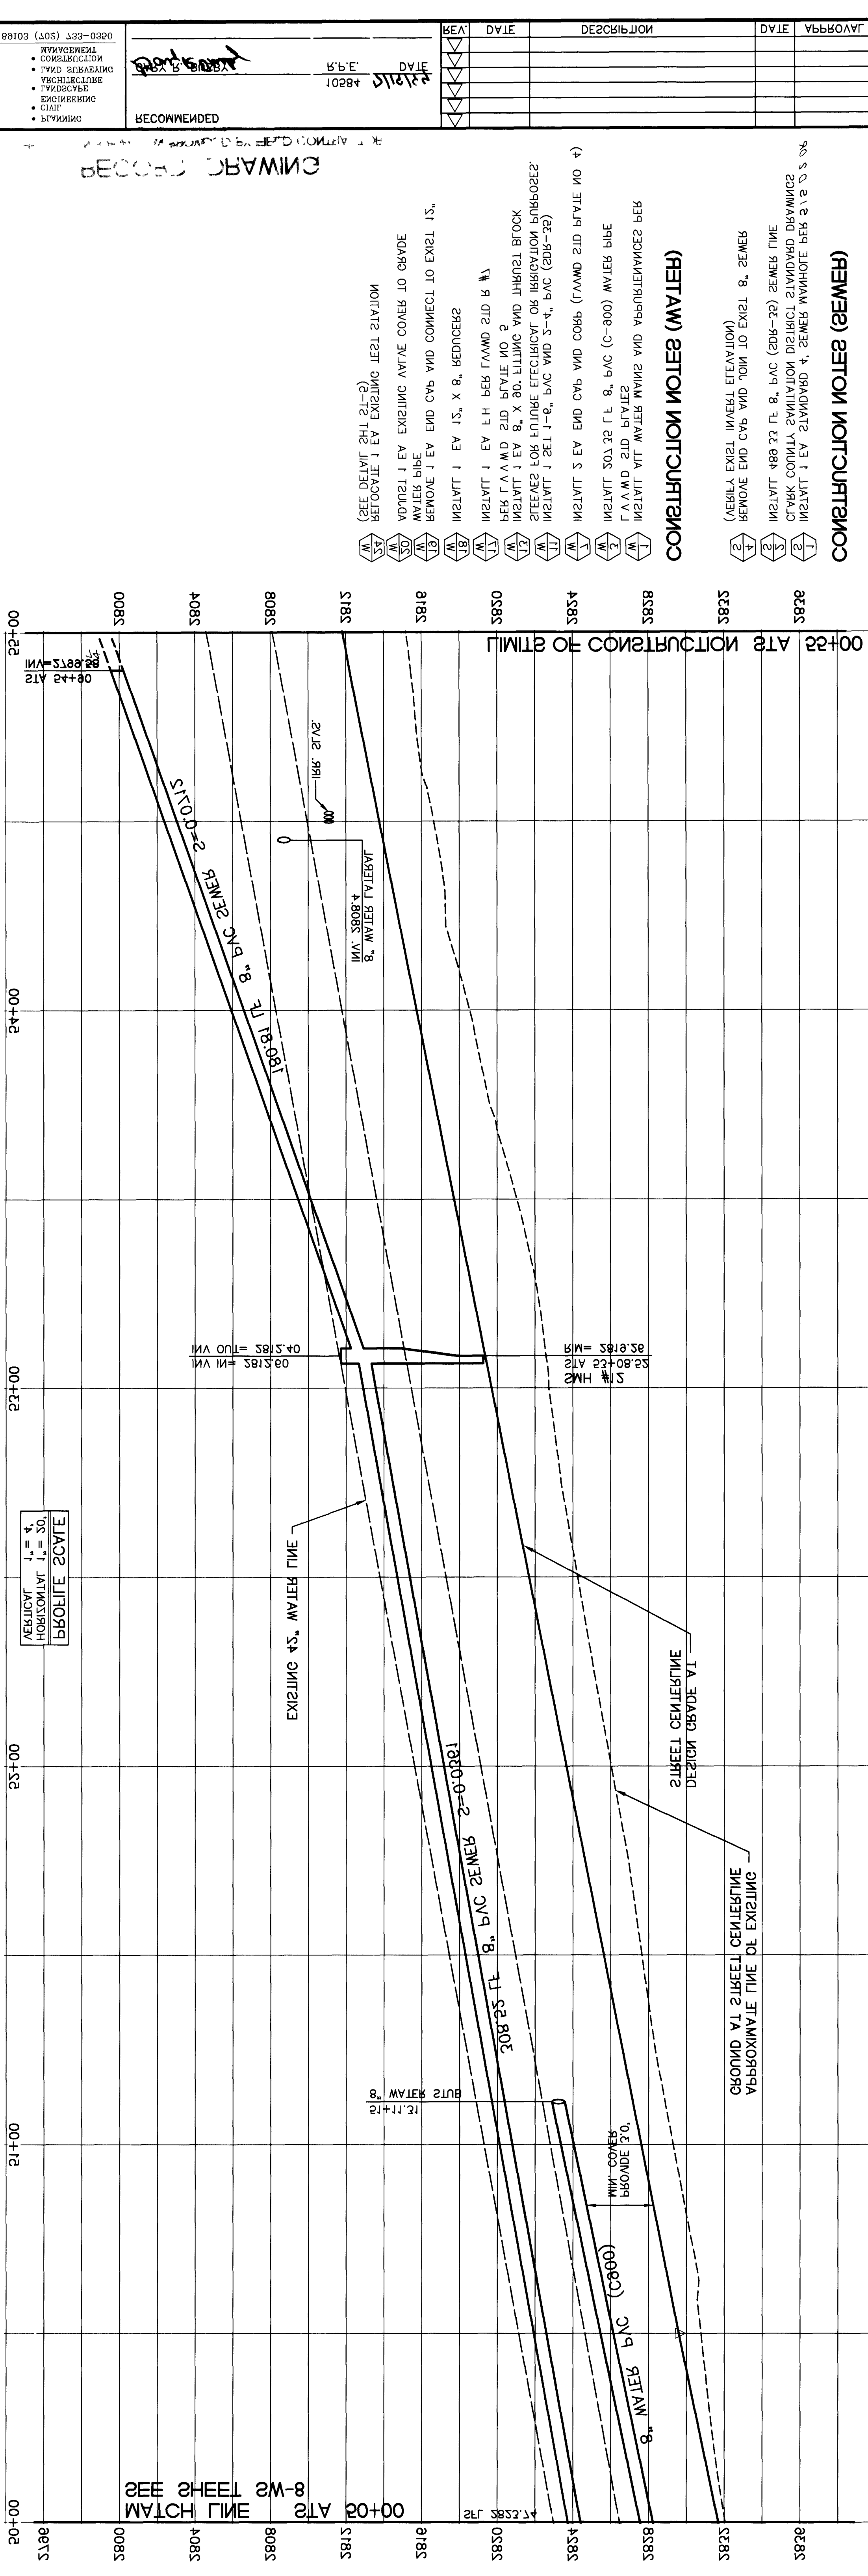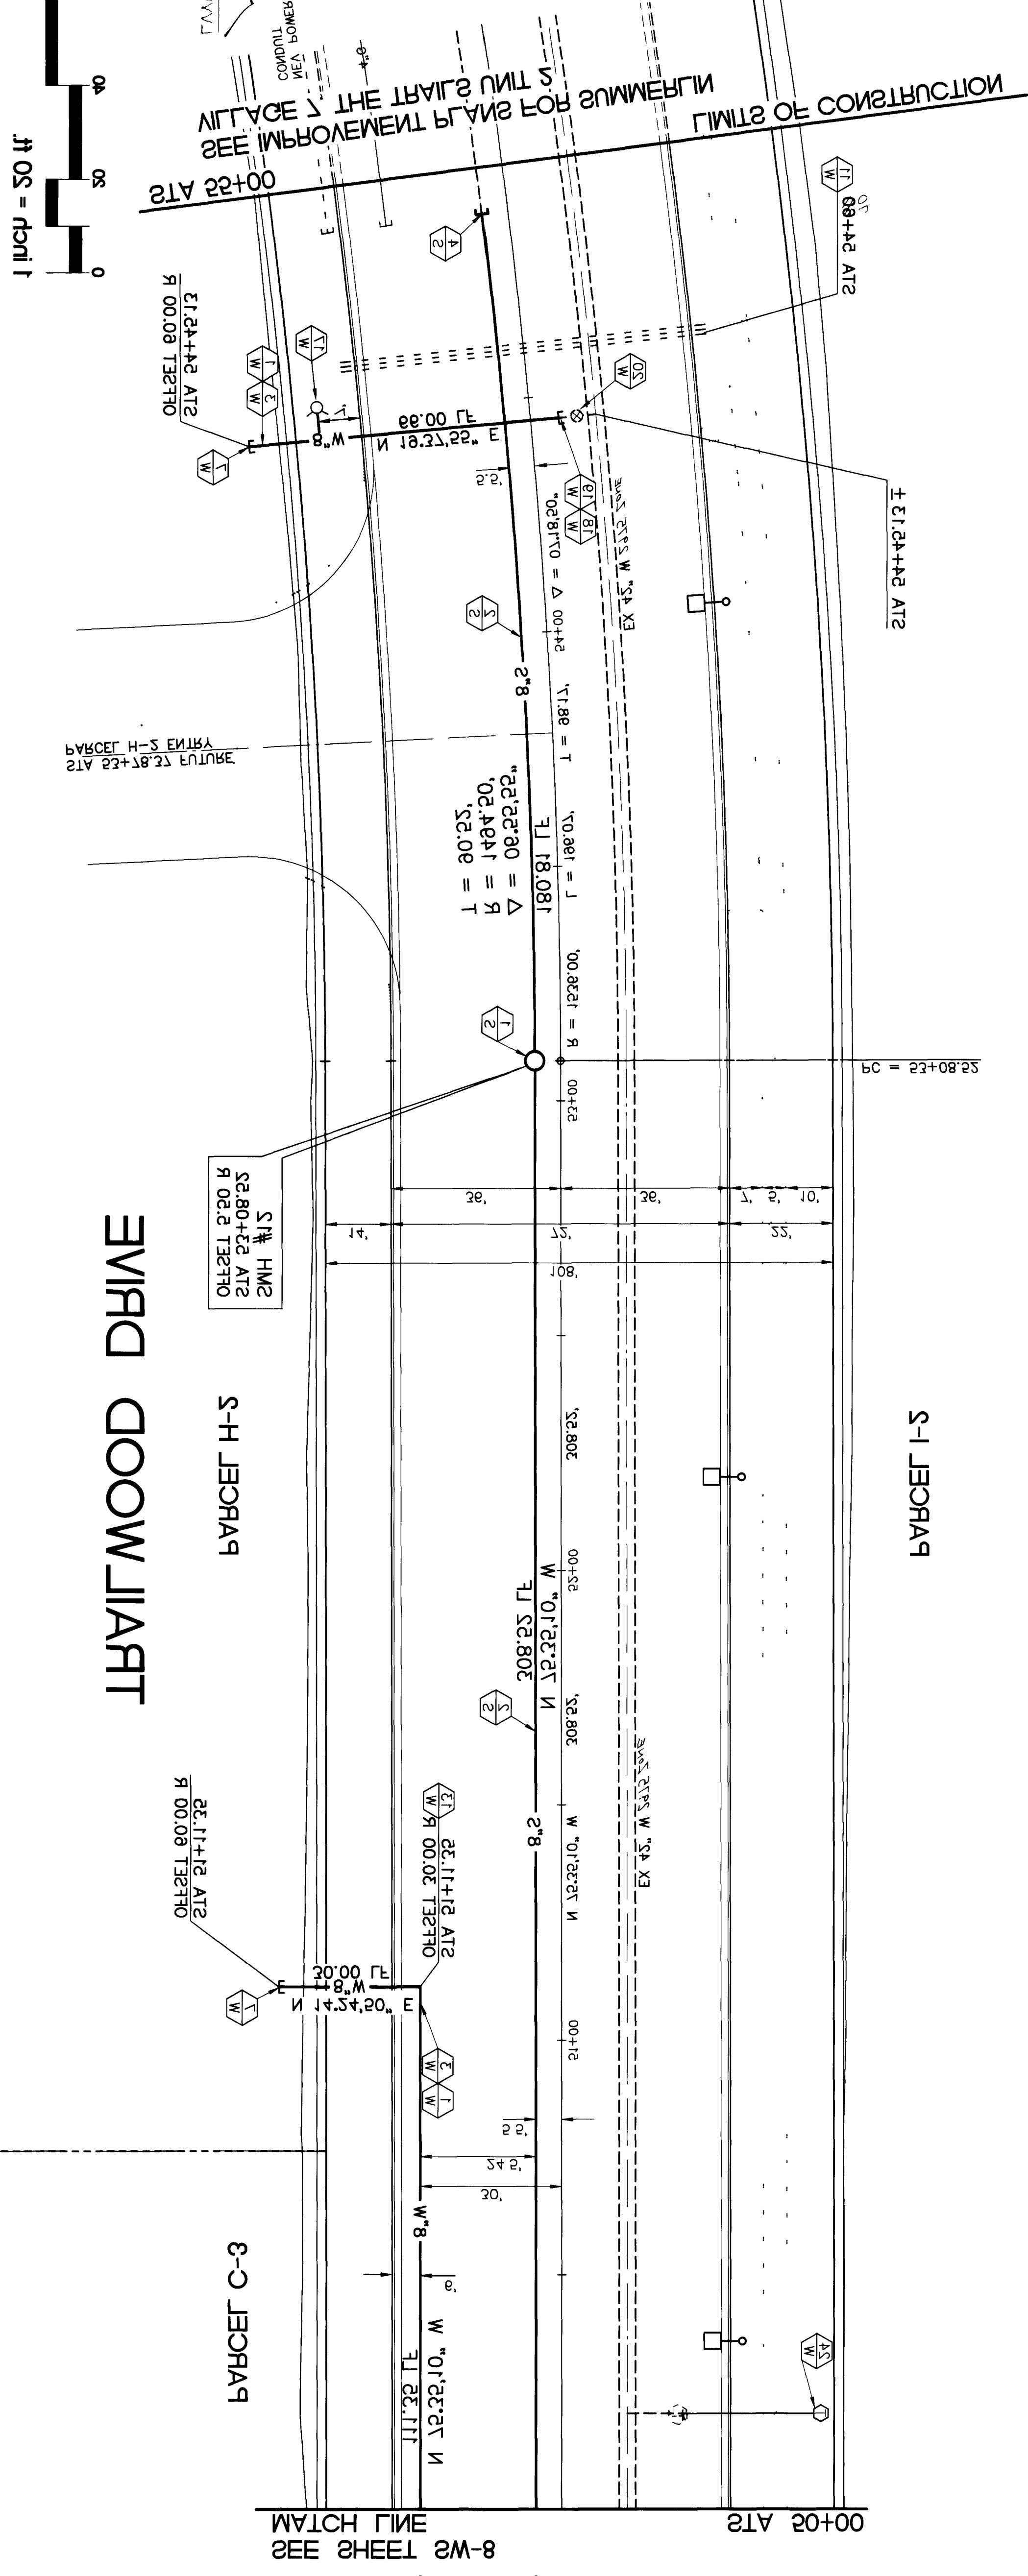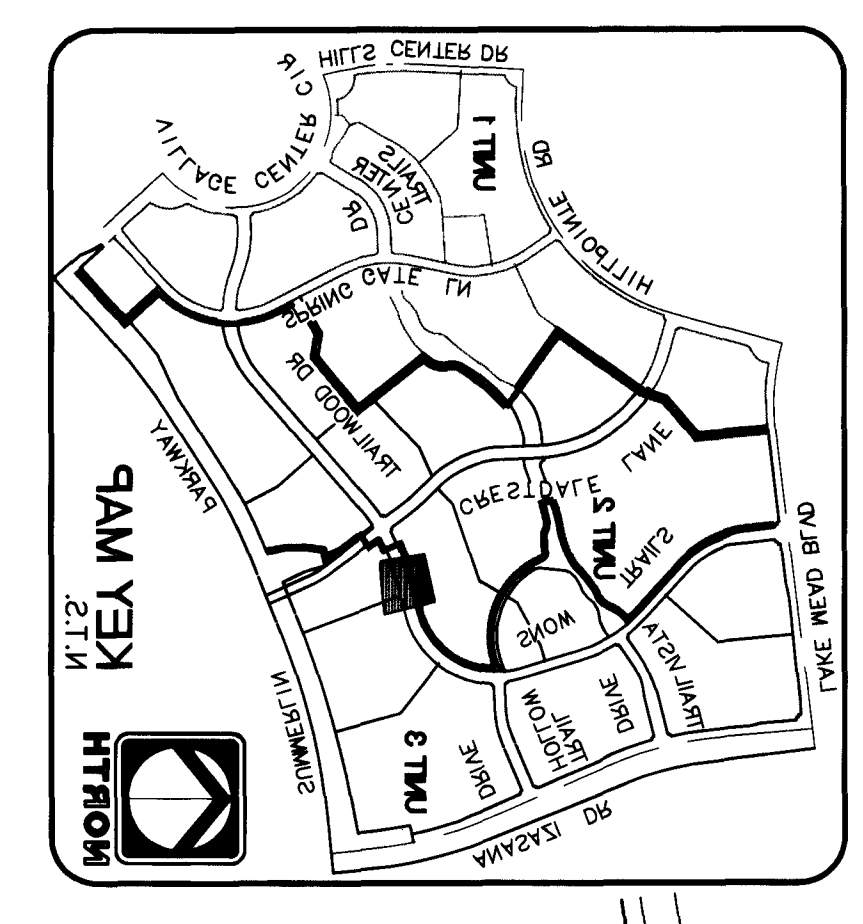

- RECOMMENDED
- 1. REMOVE EXISTING 12\"/>
- COMMENTS (SEE SHEET 8-3)
- 1. REMOVE EXISTING 12\"/>

3-153A-YT03
 8-W2 SEE SHEET 8-3
 8-W2 SEE SHEET 8-3
 8-W2 SEE SHEET 8-3

