



Call before you Dig. 1-800-227-2600

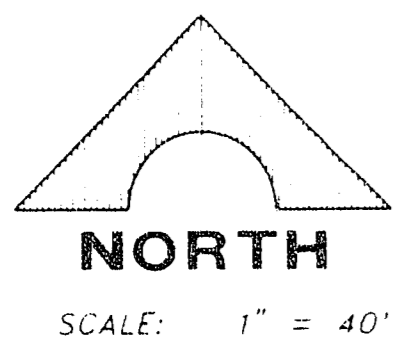

MATCH LINE SEE SHT. 5

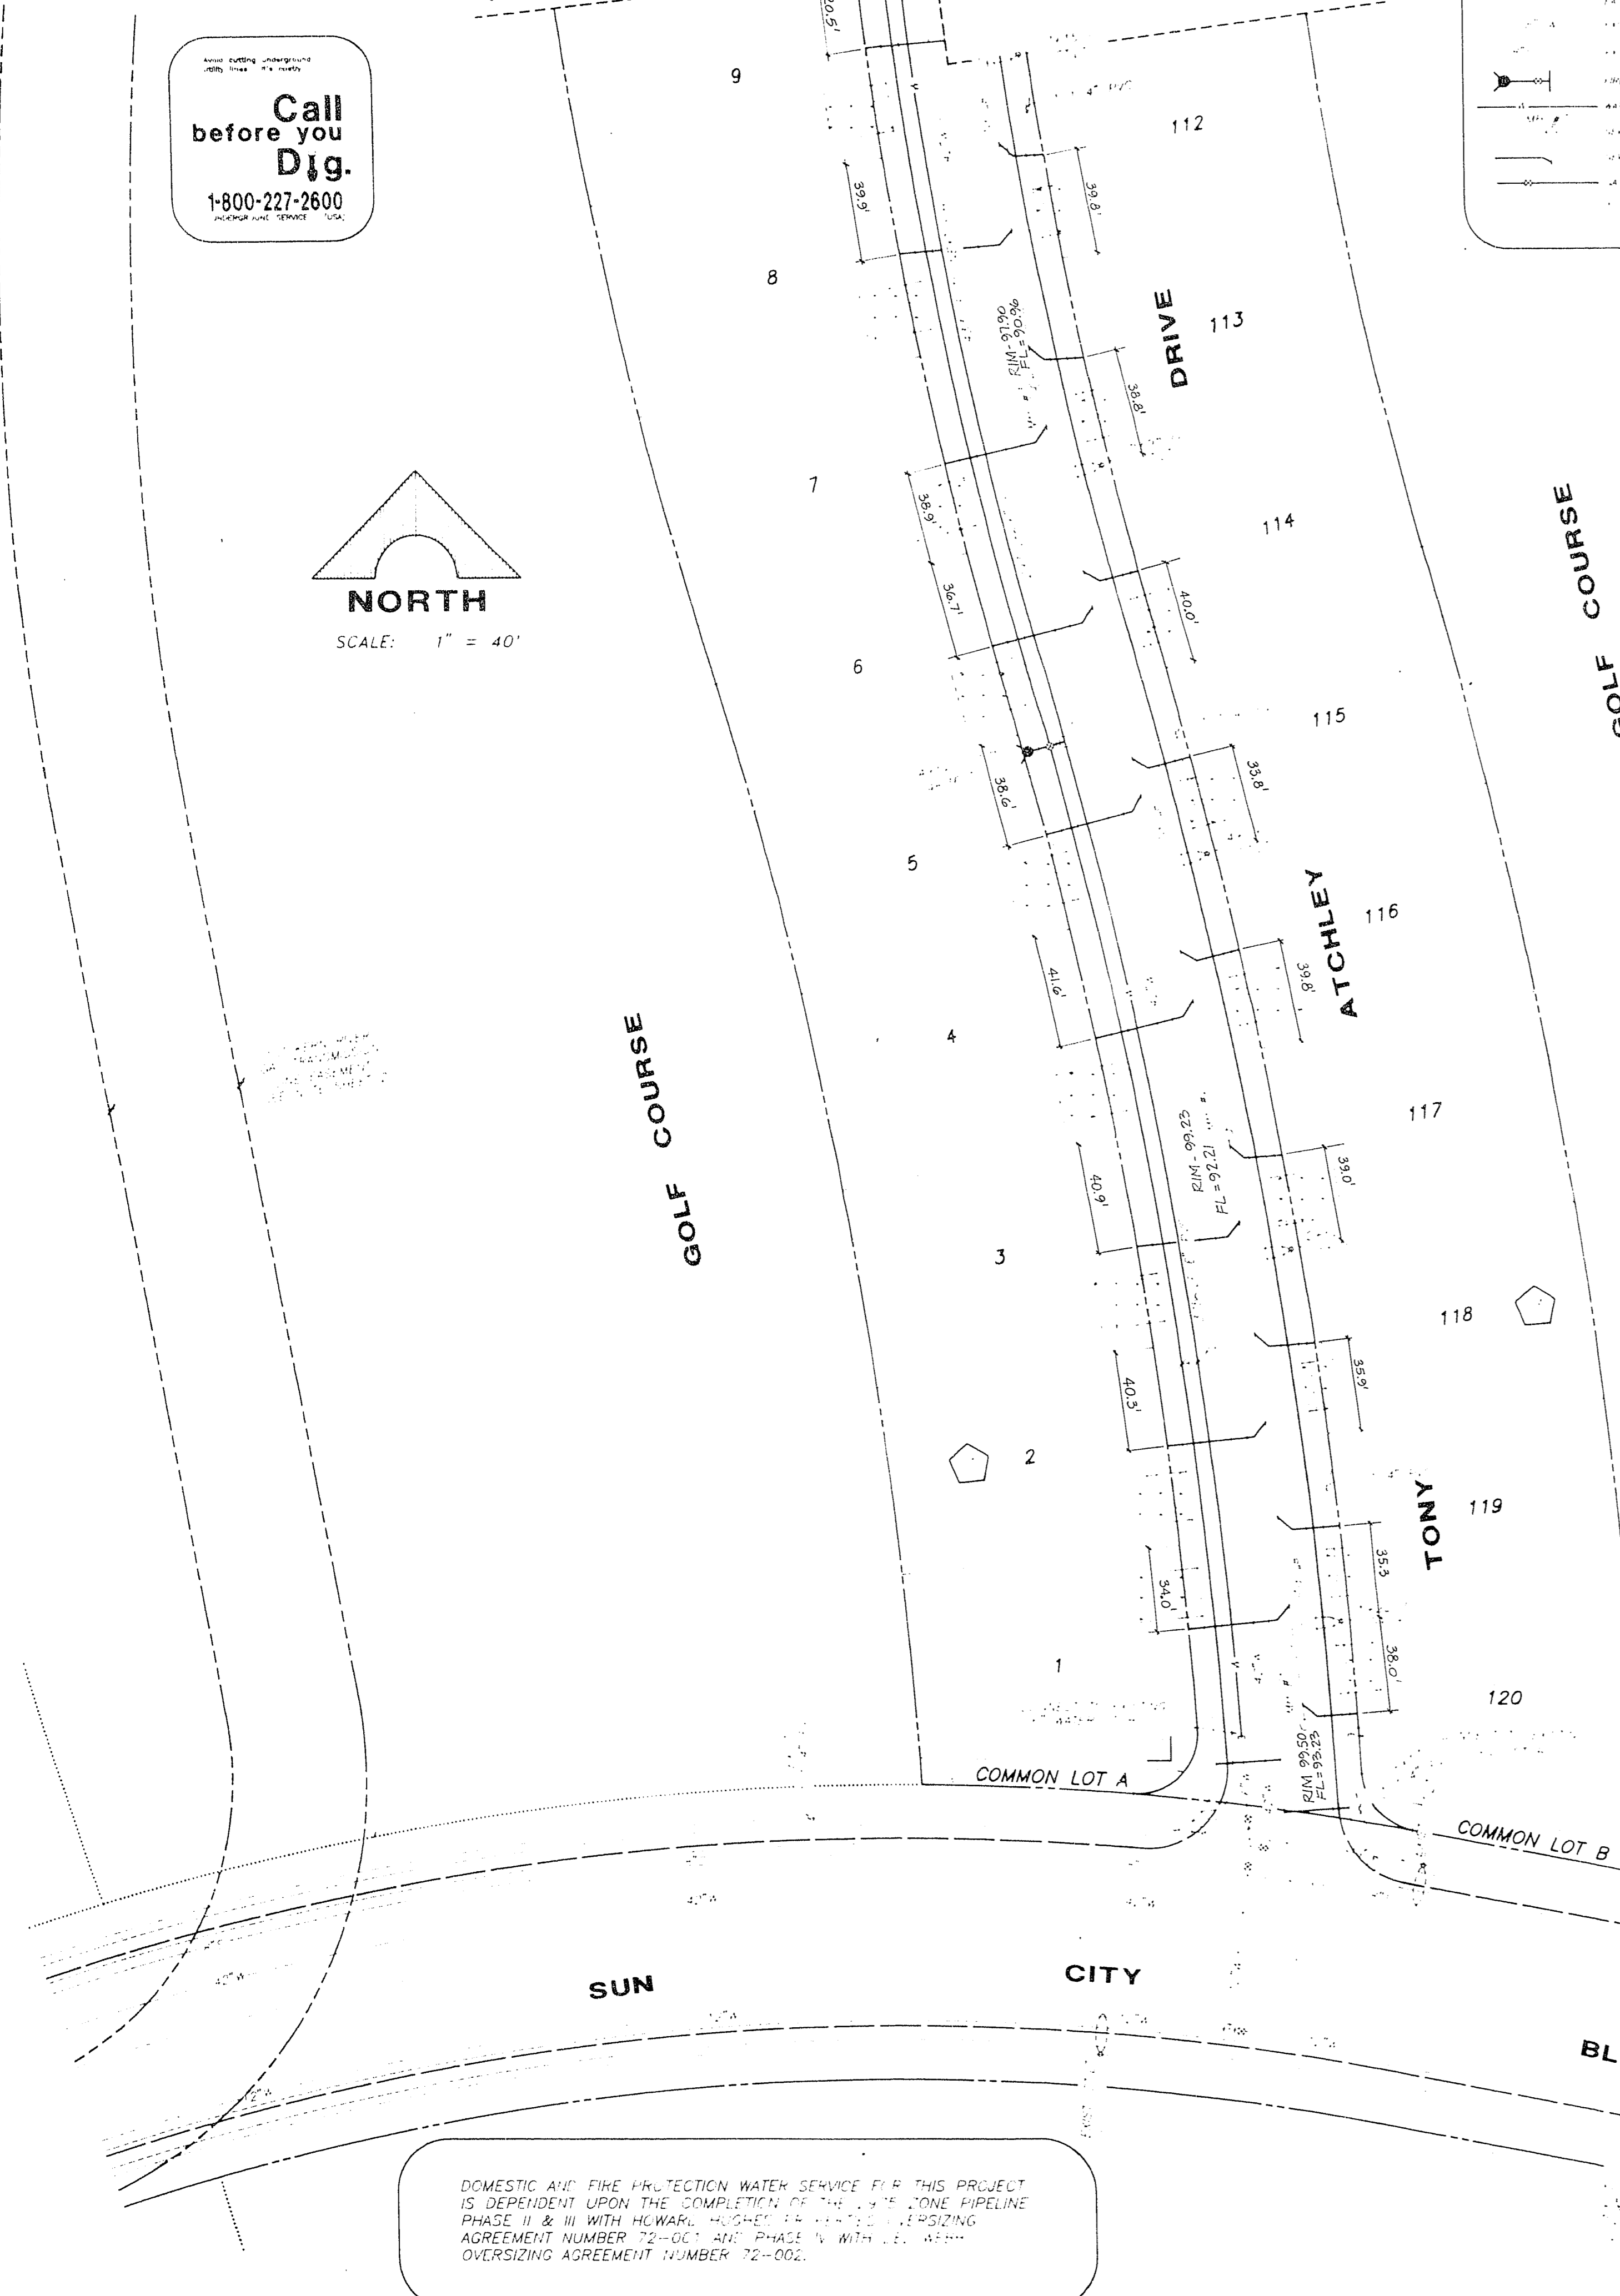

LEGEND: Symbols for water main, fire hydrant, sewer, etc.

LAS VEGAS FIRE DEPARTMENT: Notes regarding fire hydrant locations and standards.

STREET LIGHTING NOTE: Information about street lighting requirements.

BENCHMARKS: List of benchmark locations and elevations.

Diagram showing a benchmark location with elevation 92.21.

Diagram showing another benchmark location with elevation 92.21.

ESTIMATE OF QUANTITIES: Table listing materials and quantities for the project.

TRAFFIC SIGN QUANTITIES: Table listing traffic signs and their quantities.

LAS VEGAS VALLEY WATER DISTRICT STANDARD NOTES: A large box with a diagonal 'X' indicating that these notes are not applicable.

FIRE HYDRANT LOCATION DETAIL: Diagram showing the specific location and details of a fire hydrant.


FIRE DEPT. NOTES: Detailed notes from the fire department regarding hydrant placement and standards.

SEWER NOTES: Notes regarding sewer line installation, materials, and standards.

LAS VEGAS VALLEY WATER DISTRICT STANDARD NOTES: Another set of standard notes, partially obscured by a diagonal 'X'.

AS-BUILT NOTE: THE AS-BUILT ELEVATIONS AND LATERAL LOCATION DISTANCES ADDED TO THIS MAP WERE THE RESULTS OF A FIELD SURVEY MADE UNDER MY DIRECTION.

SAM LONG, PLS NEVADA CERTIFICATE NO. 9047

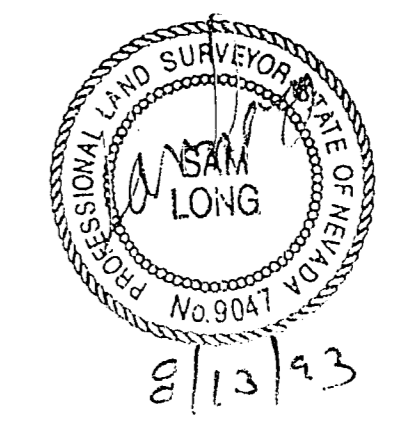

AS-BUILTS

Vertical title block containing project information: DEL WEBB COMMUNITIES, INC., SUN CITY LAS VEGAS UNIT NO. 37, UTILITY PLAN I, SHEET 4 OF 28 SHEETS, and G.C. WALLACE, INC. Engineering Architecture.