

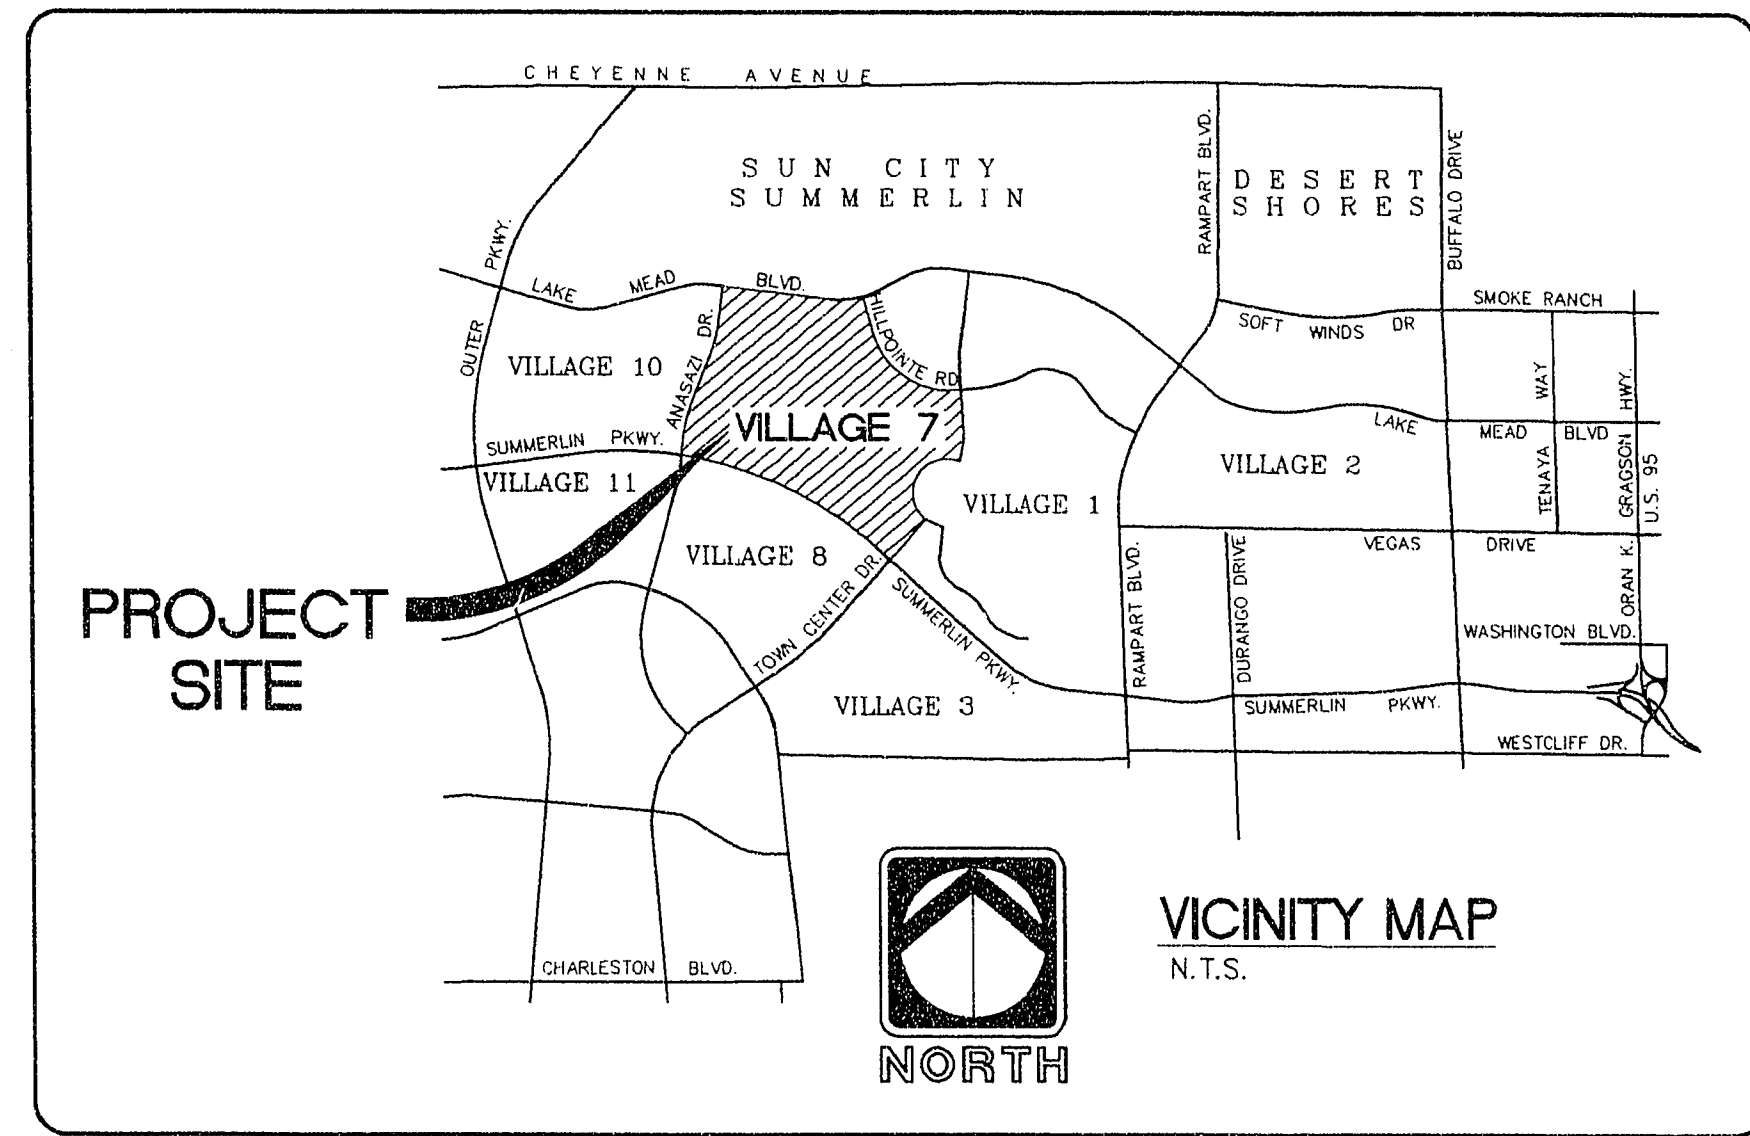


7. SUMMERLIN VILLAGE 7 - THE TRAILS - UNIT 2
11-2-64
1074-4271-2

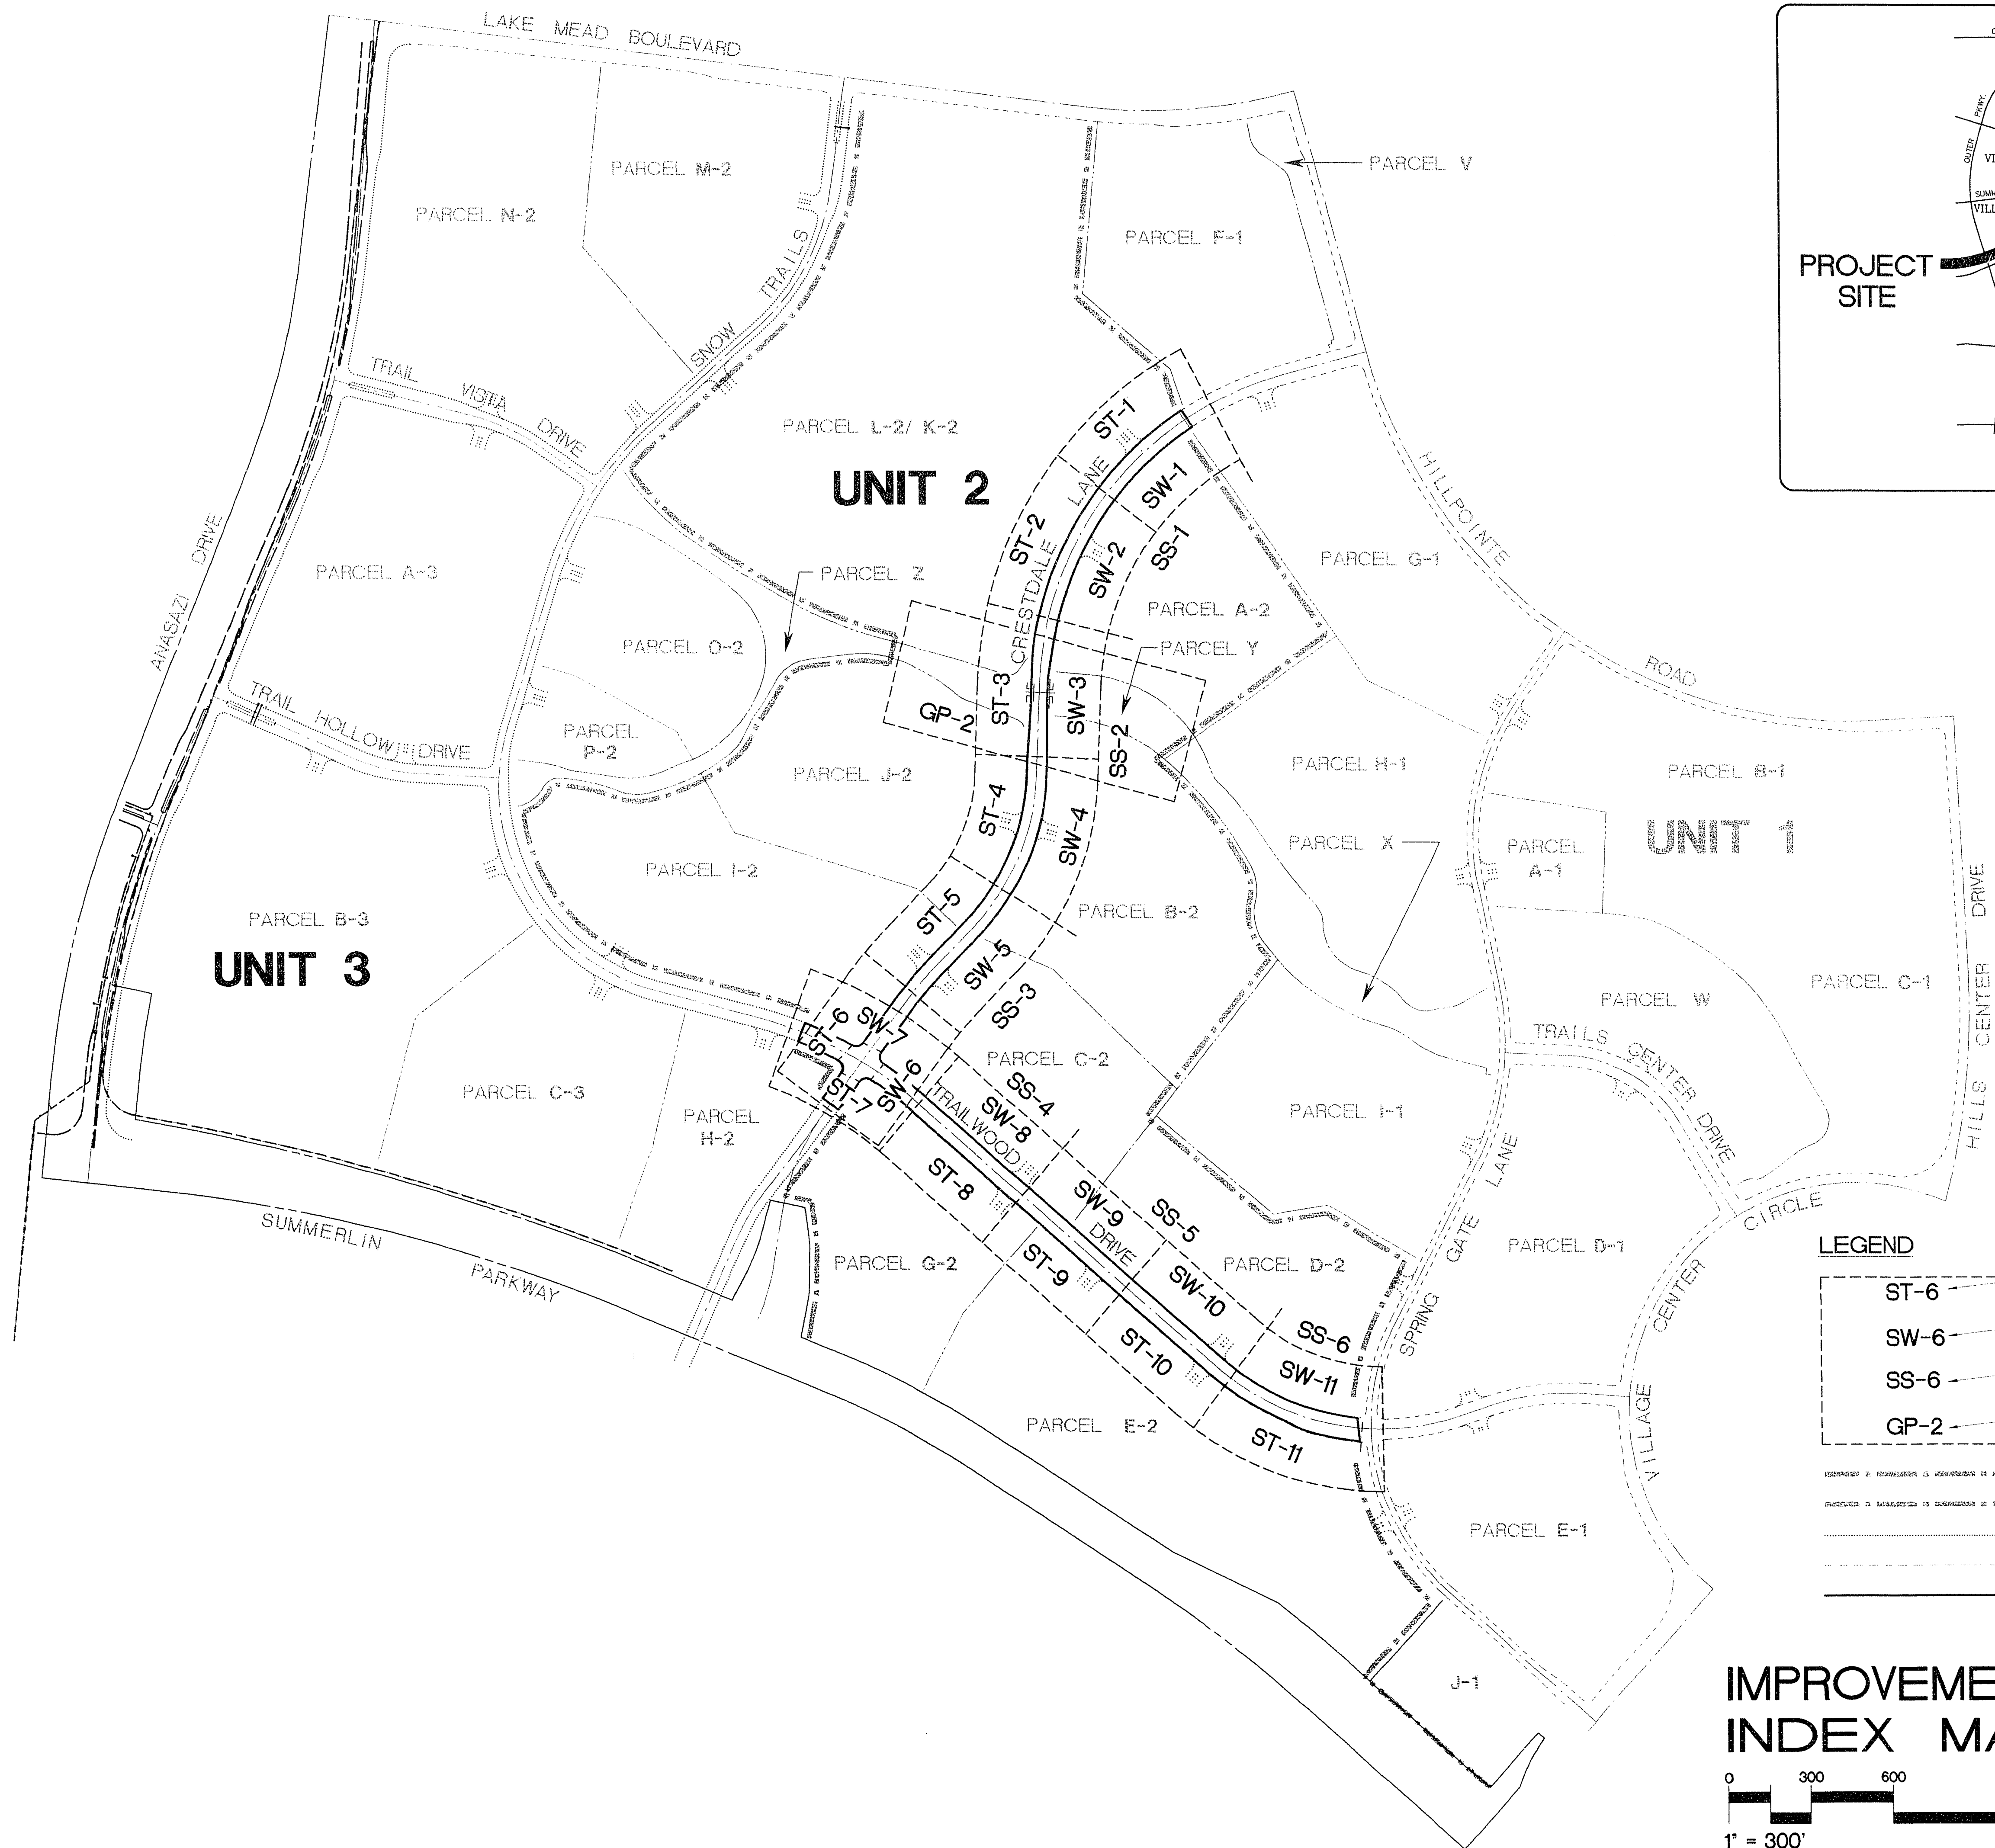

- LEGEND**
- ST-6 STREET IMPROVEMENT SHEET NUMBER (TYPICAL)
 - SW-6 SEWER AND WATER IMPROVEMENT SHEET NUMBER (TYPICAL)
 - SS-6 SIGNING AND STRIPING SHEET NUMBER (TYPICAL)
 - GP-2 GRADING PLAN AND UTILITIES SHEET NUMBER
- UNIT 1/UNIT 2 BOUNDARY LINE
UNIT 2/UNIT 3 BOUNDARY LINE
FUTURE IMPROVEMENTS
EXISTING IMPROVEMENTS
PROPOSED IMPROVEMENTS

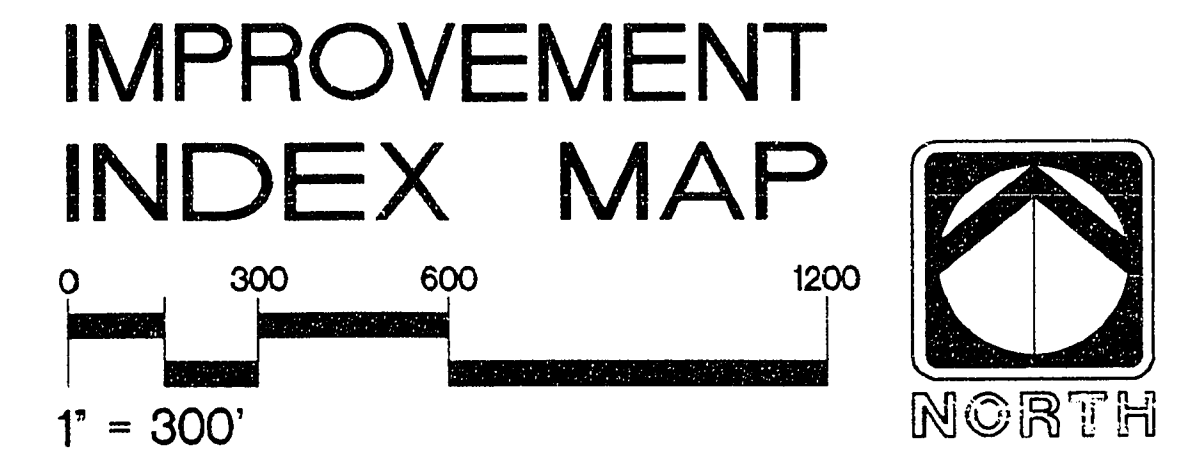

RECORD DRAWING
RECORD INFORMATION PROVIDED BY FIELD CONTRACTOR

HOWARD HUGHES PROPERTIES
SUMMERLIN VILLAGE 7 - THE TRAILS - UNIT 2
IMPROVEMENT INDEX MAP

SHEET
CG-4
SHT 4 OF 4

ENGINEER
THE KEITH
COMPANIES
NEVADA
4082 SO. INDUSTRIAL RD. LAS VEGAS, NV 89103 (702) 733-0550

RECOMMENDED
GARY R. BUSBY
10584
R.P.E.
DATE

REV.	DATE	DESCRIPTION	DATE	APPROVAL
1				
2				
3				
4				
5				
6				
7				
8				
9				
10				