

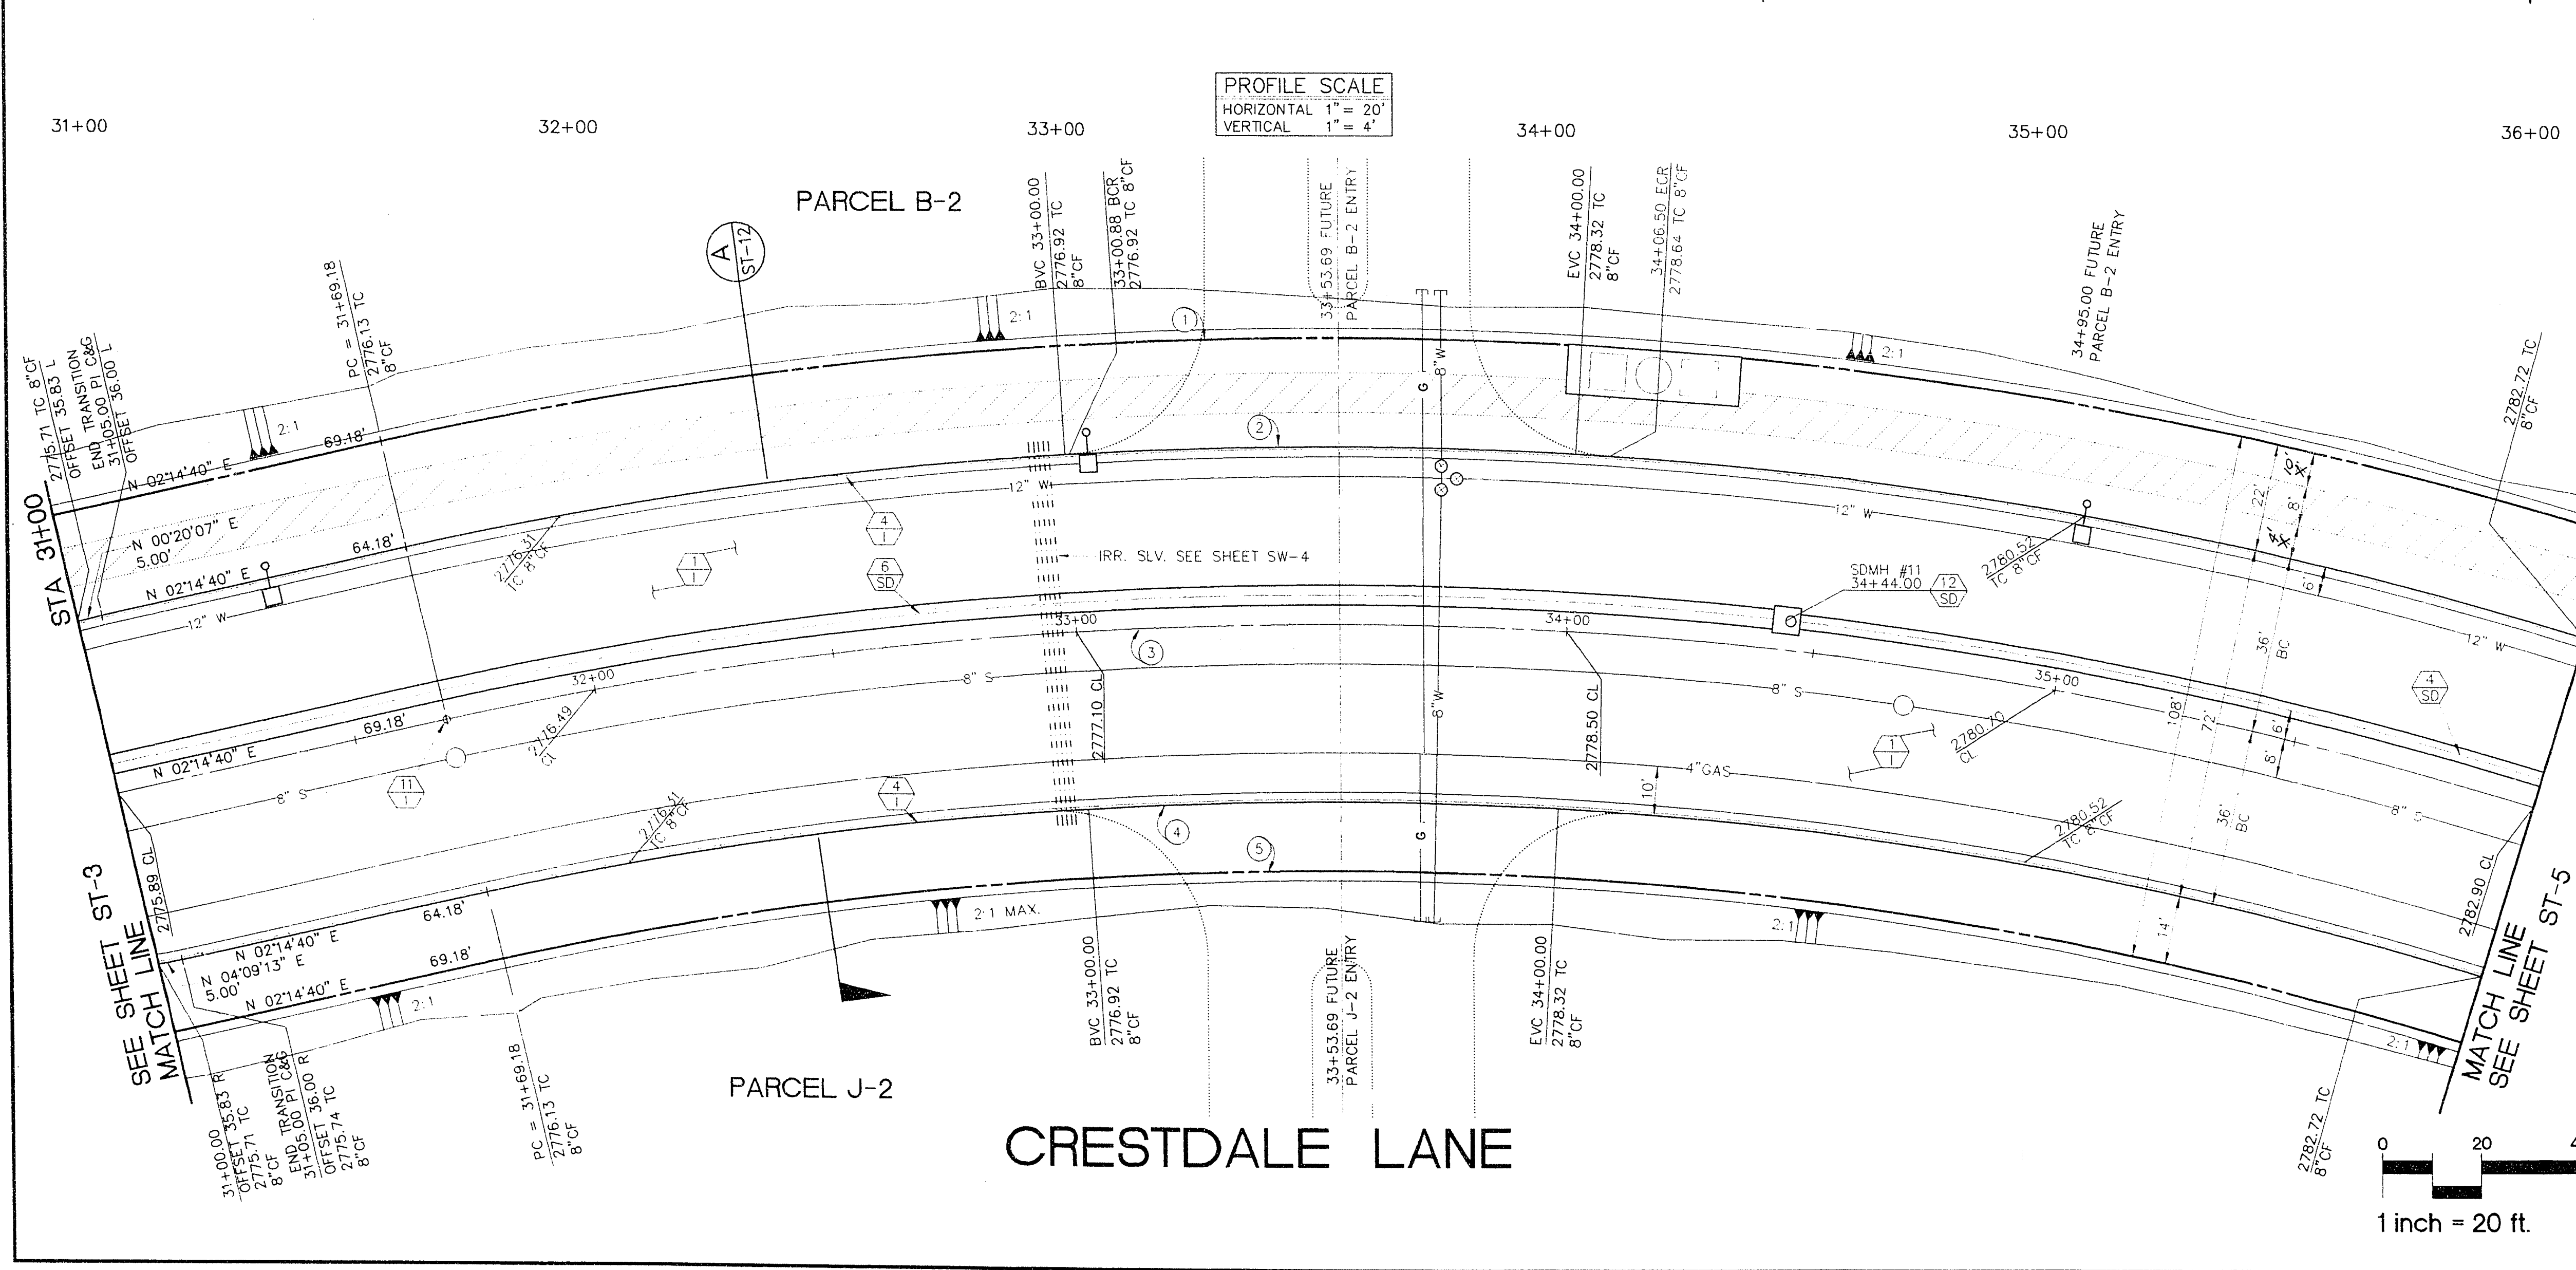


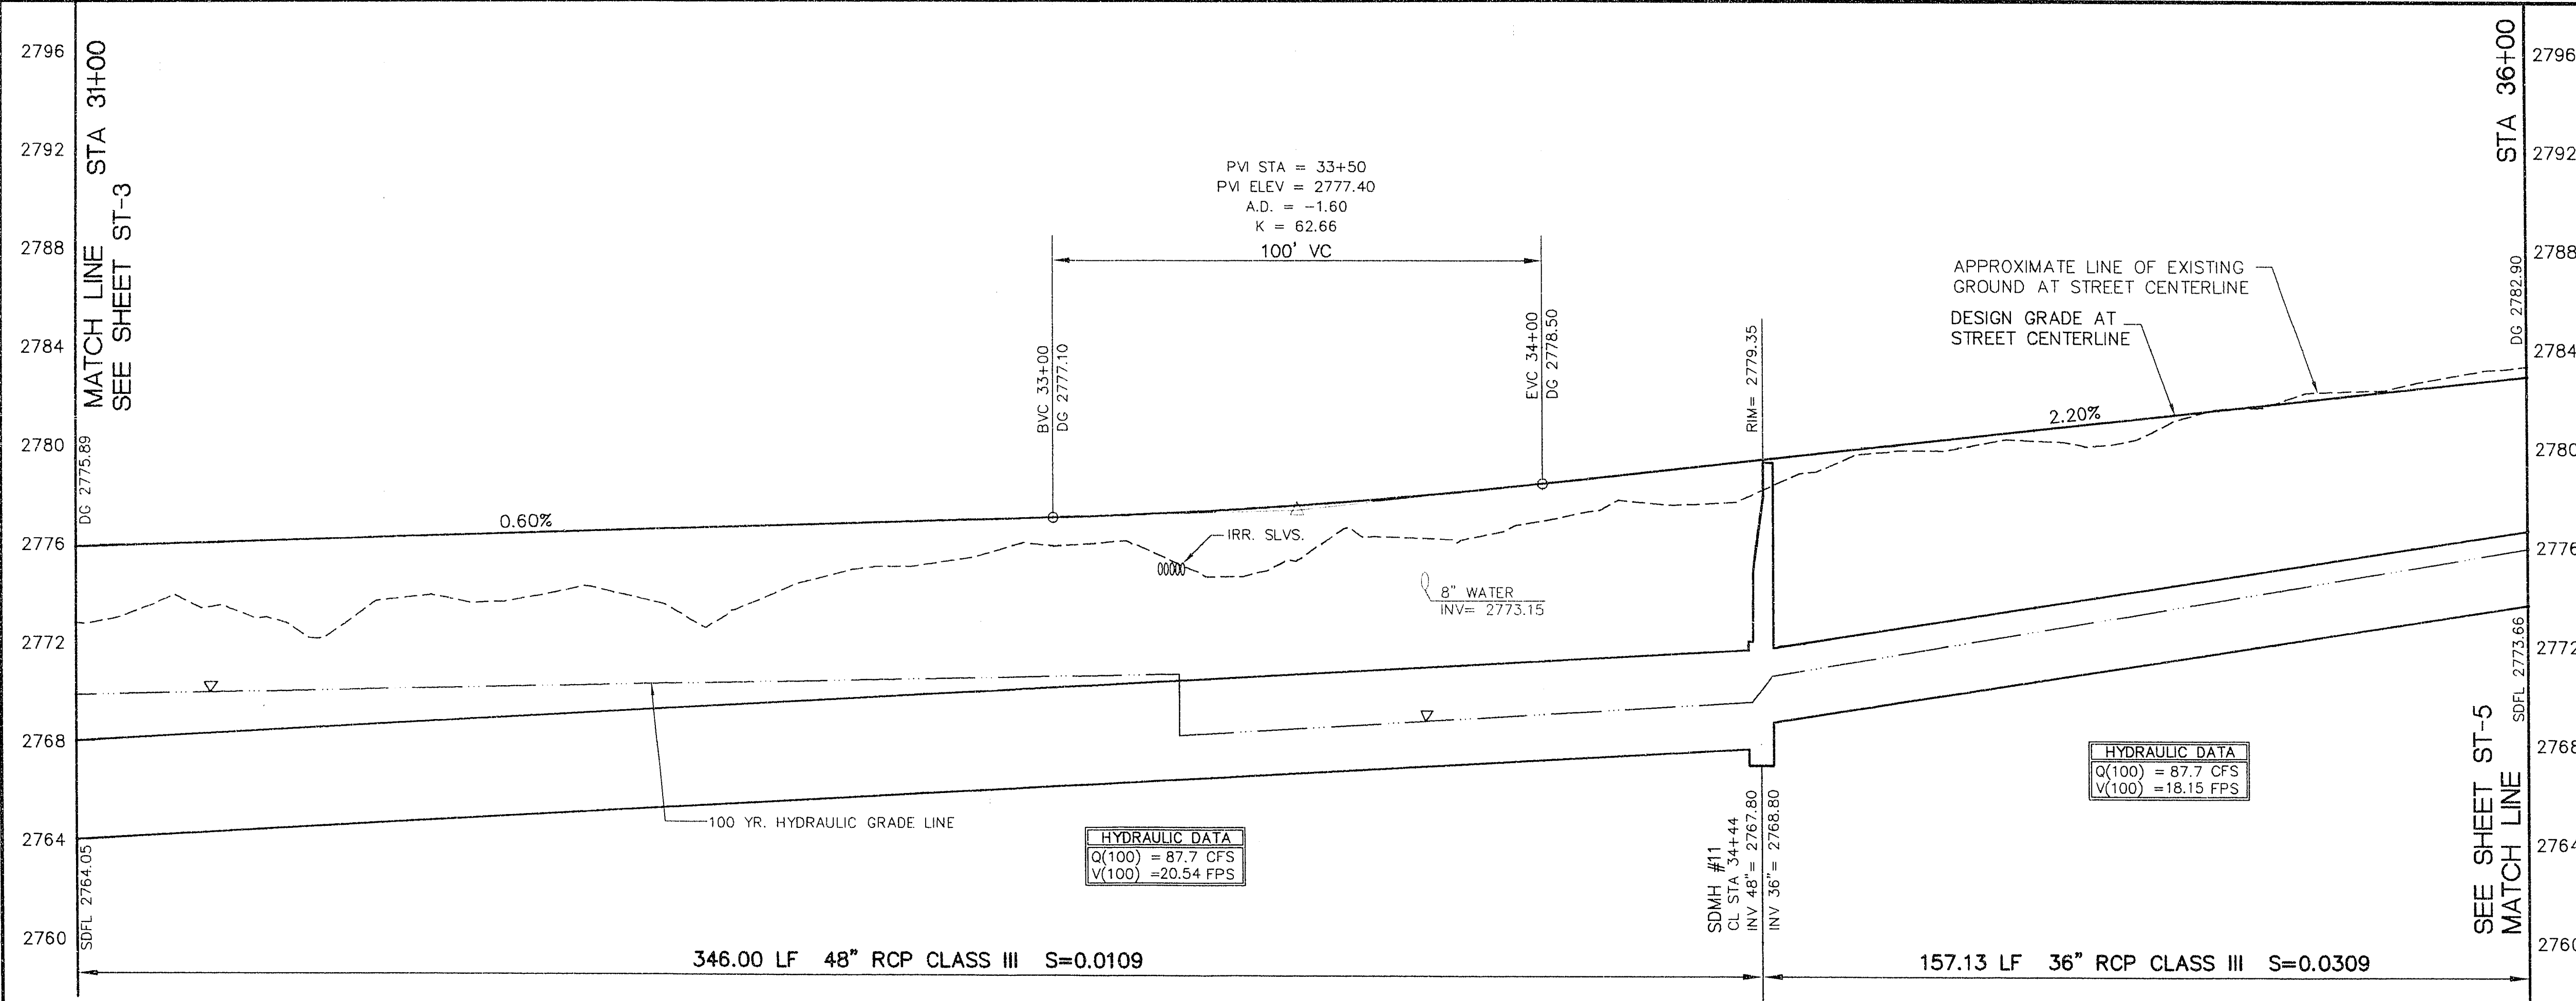

- IMPROVEMENTS**
- CONSTRUCT 3777.68 S.Y. OF 3" ASPHALT PAVEMENT OVER 4" TYPE II AGGREGATE BASE. A 1" FUTURE OVERLAY IS REQUIRED UNDER SEPARATE CONTRACT.
 - INSTALL 1000.00 L.F. OF 8" "L" TYPE CURB AND GUTTER.
 - INSTALL 1 EA. TYPE 3 MONUMENTS.
- STORM DRAIN**
- INSTALL 157.13 L.F. OF 36" RCP STORM DRAIN.
 - INSTALL 346.00 L.F. OF 48" RCP STORM DRAIN.
 - INSTALL 1 EA. OF TYPE II STORM DRAIN MANHOLE.
- STREET LIGHTING AND ELECTRICAL**
- (SHOW FOR REFERENCE ONLY. SEE SHEETS SL-1 & SL-2 FOR STREET LIGHTING INSTALLATION).
- (SEE NEVADA POWER CO. DWGS. FOR ELECTRICAL DISTRIBUTION).
- BENCHMARK**
- RIVET AND PLATE IN TOP OF CURB NW SIDE OF TOWN CENTER DRIVE
- AND SOUTH ROUNDABOUT ISLAND.
ELEVATION = 2725.923
PER CITY OF LAS VEGAS DATUM STATION: OLVOO 1954
- SEE SHEET CG-3 FOR LOCATION.

CURVE NUMBERS ARE SHOWN ON PLANS

CURVE	RADIUS	LENGTH	TANGENT	DELTA
1	883.00'	461.11'	235.94'	29°55'13"
2	861.00'	449.62'	230.06'	29°55'13"
3	825.00'	430.82'	220.44'	29°55'13"
4	789.00'	412.02'	210.82'	29°55'13"
5	775.00'	404.71'	207.08'	29°55'13"

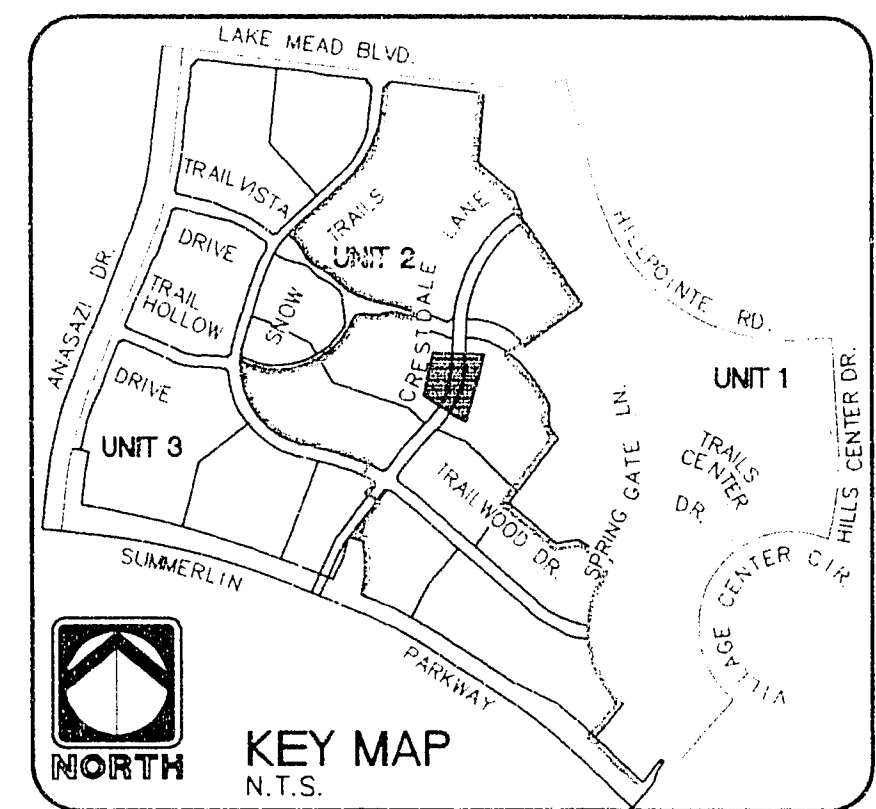

RECORD DRAWING

RECORD INFORMATION PROVIDED BY FIELD CONTRACTOR

HOWARD HUGHES PROPERTIES
SUMMERLIN VILLAGE 7 - THE TRAILS - UNIT 2
CRESTDALE LANE
PLAN AND PROFILE
STA 31+00 - STA 36+00

ST-4

SHT 14 OF 48

11-2-75

1079-4271-2