


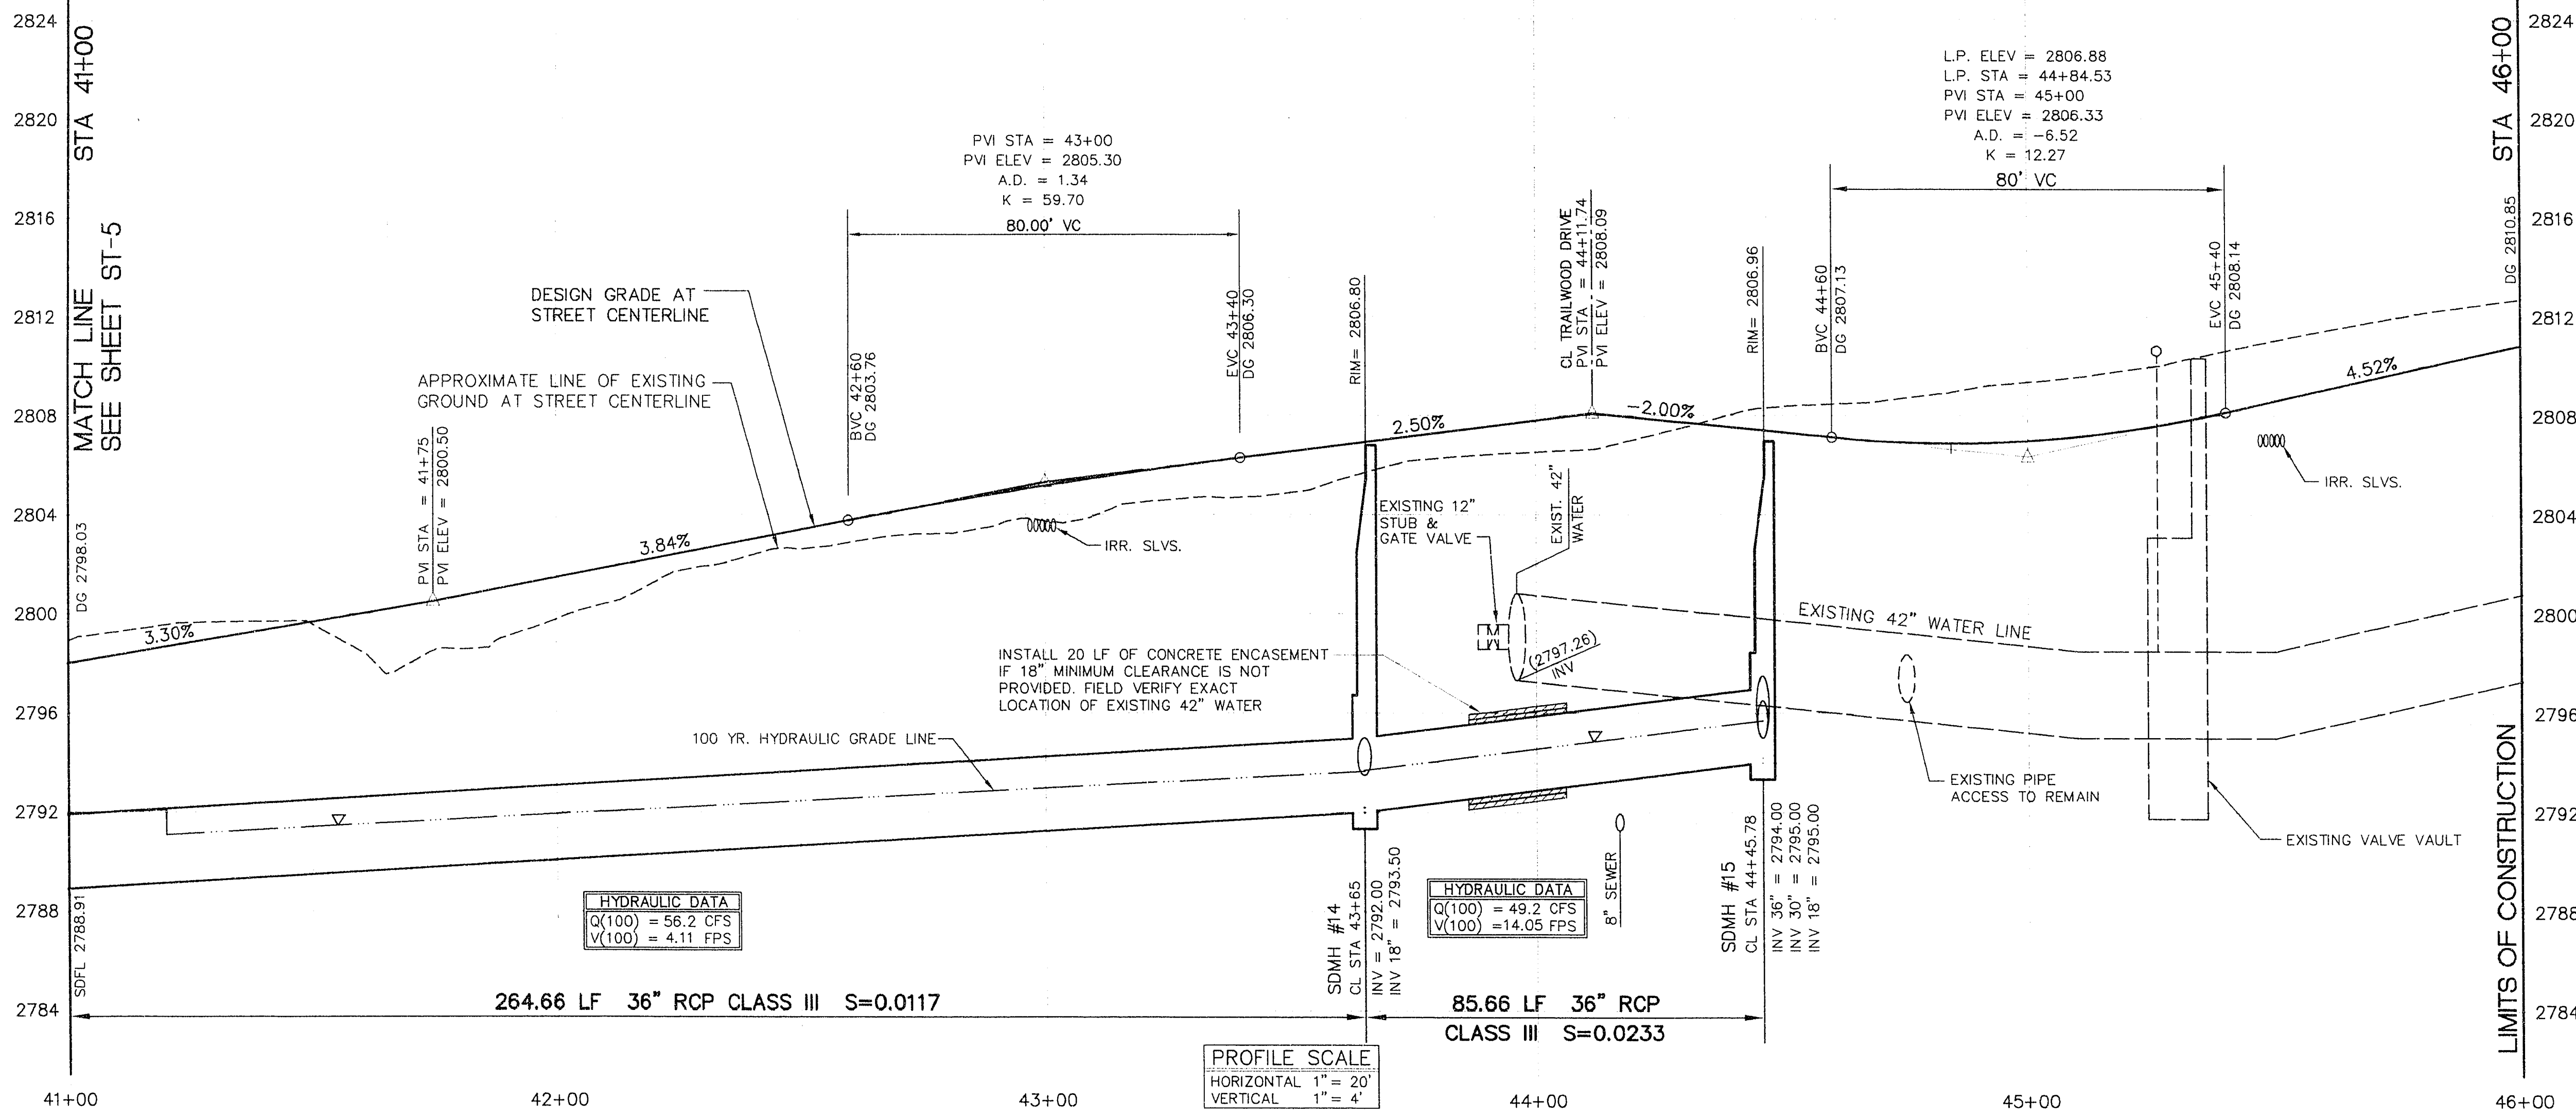



- IMPROVEMENTS**
- CONSTRUCT 4356.36 S.Y. OF 3" ASPHALT PAVEMENT OVER 4" TYPE II AGGREGATE BASE.
 - INSTALL 240.63 L.F. 6" "L" TYPE CURB AND GUTTER.
 - INSTALL 682.43 L.F. OF 8" "L" TYPE CURB AND GUTTER.
 - CONSTRUCT (QUANTITIES INCLUDED IN 4) DEPRESSED CURB FOR FUTURE SIDEWALK RAMP.
 - CONSTRUCT (QUANTITIES INCLUDED IN 4) 8" TO 6" CURB FACE TRANSITION THROUGH CURB RETURN.
 - INSTALL 2 EA. TYPE 3 MONUMENTS.
 - CONSTRUCT 72 LF OF BARRICADE.
- STORM DRAIN**
- INSTALL 122.59 L.F. OF 18" RCP STORM DRAIN.
 - INSTALL 54.10 L.F. OF 30" RCP STORM DRAIN.
 - INSTALL 350.32 L.F. OF 36" RCP STORM DRAIN.
 - INSTALL 2 EA. OF TYPE III STORM DRAIN MANHOLE.
 - INSTALL 1 EA. OF TYPE "A" DROP INLET.
- STREET LIGHTING AND ELECTRICAL**
- (SHOW FOR REFERENCE ONLY; SEE SHEETS SL-1 & SL-2 FOR STREET LIGHTING INSTALLATION).
- (SEE NEVADA POWER CO. DWGS. FOR ELECTRICAL DISTRIBUTION).
- BENCHMARK**
- RIVET AND PLATE IN TOP OF CURB NW SIDE OF TOWN CENTER DRIVE AND SOUTH ROUNDAOUT ISLAND.
ELEVATION = 2725.923
PER CITY OF LAS VEGAS DATUM STATION: OLVOO 1954
SEE SHEET CG-3 FOR LOCATION.

RECORD DRAWING
RECORD INFORMATION PROVIDED BY FIELD CONTRACTOR


RECOMMENDED
PLANNING
ENGINEERING
LANDSCAPE
LAND SURVEYING
CONSTRUCTION
DATE
10584
GARY BUSBY
R.P.E.

CURVE NUMBERS ARE SHOWN ON PLANS

CURVE	RADIUS	LENGTH	TANGENT	DELTA
1	1442.00	82.43	41.23	0316.30
2	1484.00	83.68	41.85	0316.30
3	1500.00	85.74	42.88	0316.30
4	1536.00	87.80	43.91	0316.30
5	1550.00	88.60	44.31	0316.30
6	30.00	48.61	31.53	9250.47
7	30.00	45.50	28.41	8653.29
8	30.00	43.09	26.22	8218.08
9	30.00	51.53	34.76	9824.41
10	1036.00	27.00	13.50	0129.35

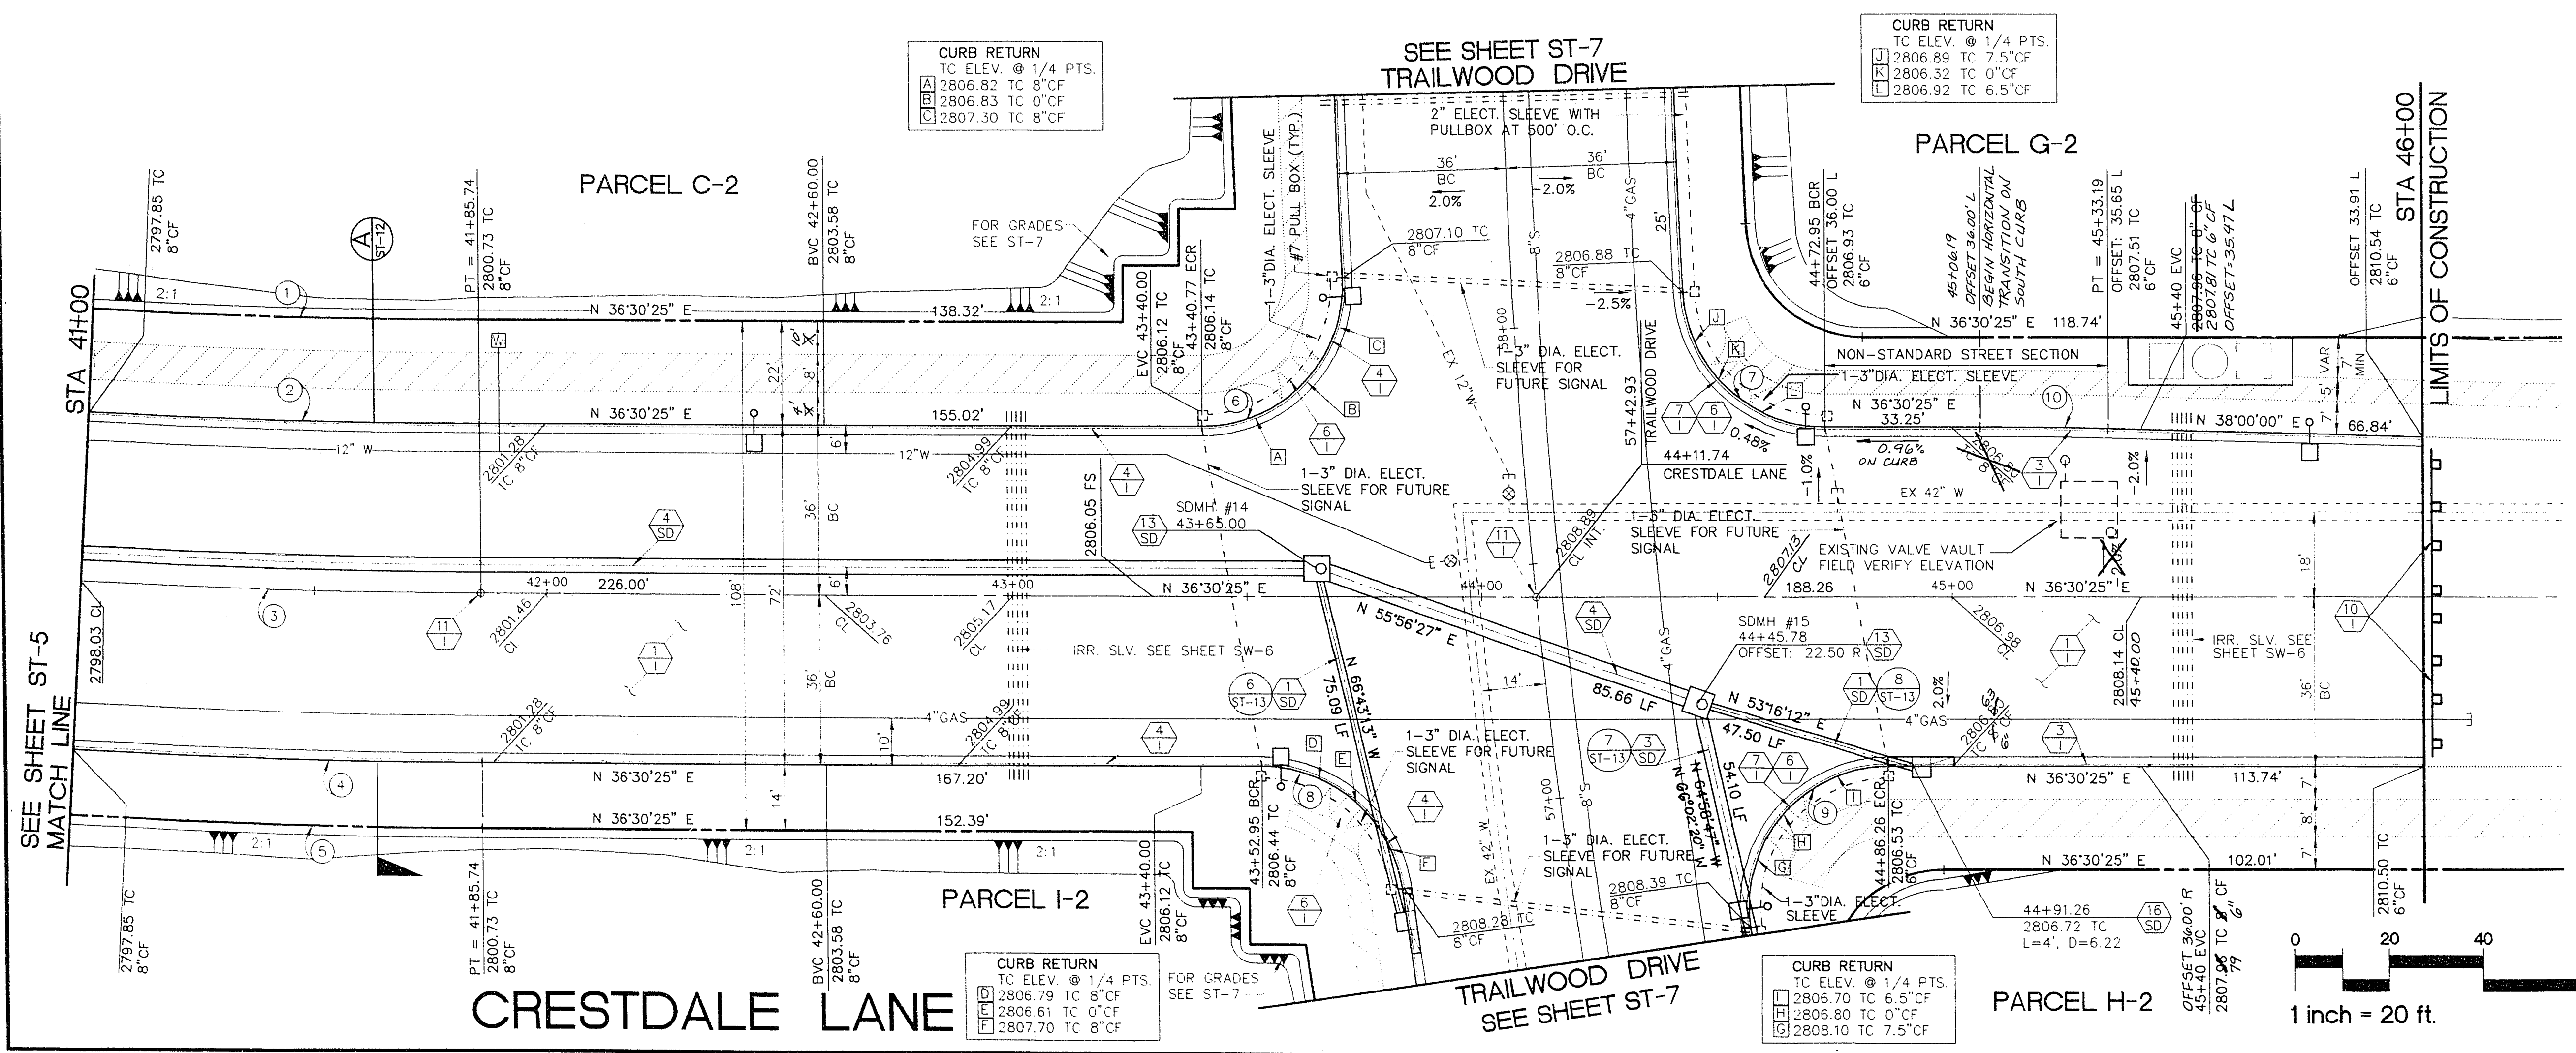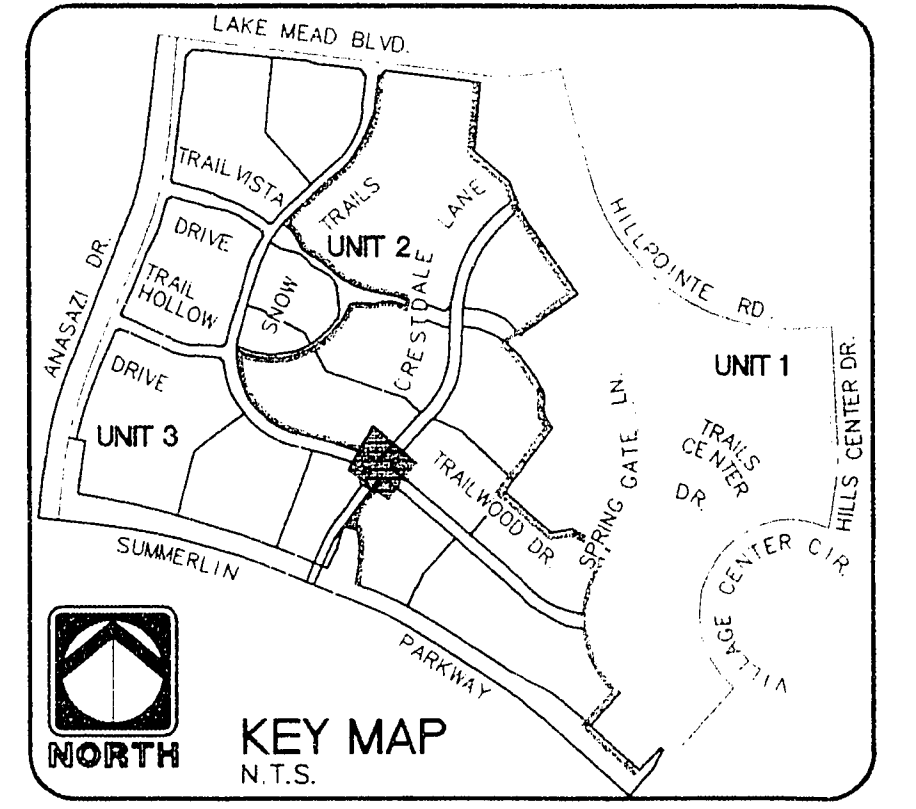

ENGINEER
HOWARD HUGHES PROPERTIES
SUMMERLIN VILLAGE 7 - THE TRAILS - UNIT 2
CRESTDALE LANE
PLAN AND PROFILE
STA 41+00 - STA 46+00
SHEET
ST-6
SHT 16 OF 47

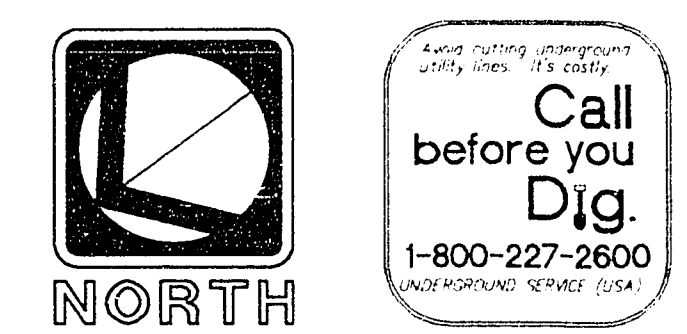

Call before you Dig
1-800-227-2800
UNDEGROUND UTILITY LOCATOR