

IMPROVEMENTS

- 1 CONSTRUCT 3777.78 S.Y. OF 3" ASPHALT PAVEMENT OVER 4" TYPE II AGGREGATE BASE. A 1" OVERLAY IS REQUIRED UNDER SEPARATE CONTRACT.
- 4 INSTALL 1,000.00 L.F. OF 8" "L" TYPE CURB AND GUTTER
- 11 INSTALL 1 EA. TYPE 3 MONUMENTS.

STREET LIGHTING AND ELECTRICAL

(SHOW FOR REFERENCE ONLY; SEE SHEETS SL-1 & SL-2 FOR STREET LIGHTING INSTALLATION).

(SEE NEVADA POWER CO. DWGS. FOR ELECTRICAL DISTRIBUTION).

BENCHMARK

RIVET AND PLATE IN TOP OF CURB NW SIDE OF TOWN CENTER DRIVE AND SOUTH ROUNDABOUT ISLAND.
 ELEVATION = 2725.923
 PER CITY OF LAS VEGAS DATUM STATION: 0LV00
 1954

SEE SHEET CG-3 FOR LOCATION

RECORD DRAWING

RECORD INFORMATION PROVIDED BY FIELD CONTRACTOR

REV.	DATE	DESCRIPTION
1		
2		
3		
4		
5		

RECOMMENDED

GARY R. BUSBY
 R.P.E.
 10584
 DATE



TRAINING

- ENGINEERING
- ARCHITECTURE
- LAND SURVEYING
- PROJECT MANAGEMENT

ENGINEER THE KEITH COMPANIES NEVADA
 4082 SO. INDUSTRIAL RD. LAS VEGAS, NV 89103 (702) 733-0350

CURVE NUMBERS ARE SHOWN (O) ON PLANS

CURVE	RADIUS	LENGTH	TANGENT	DELTA
1	1558.00	9.55'	4.78'	00°21'05"
2	1536.00	9.42'	4.71'	00°21'05"
3	1500.00	9.20'	4.60'	00°21'05"
4	1464.00	8.98'	4.49'	00°21'05"
5	1450.00	8.89'	4.45'	00°21'05"

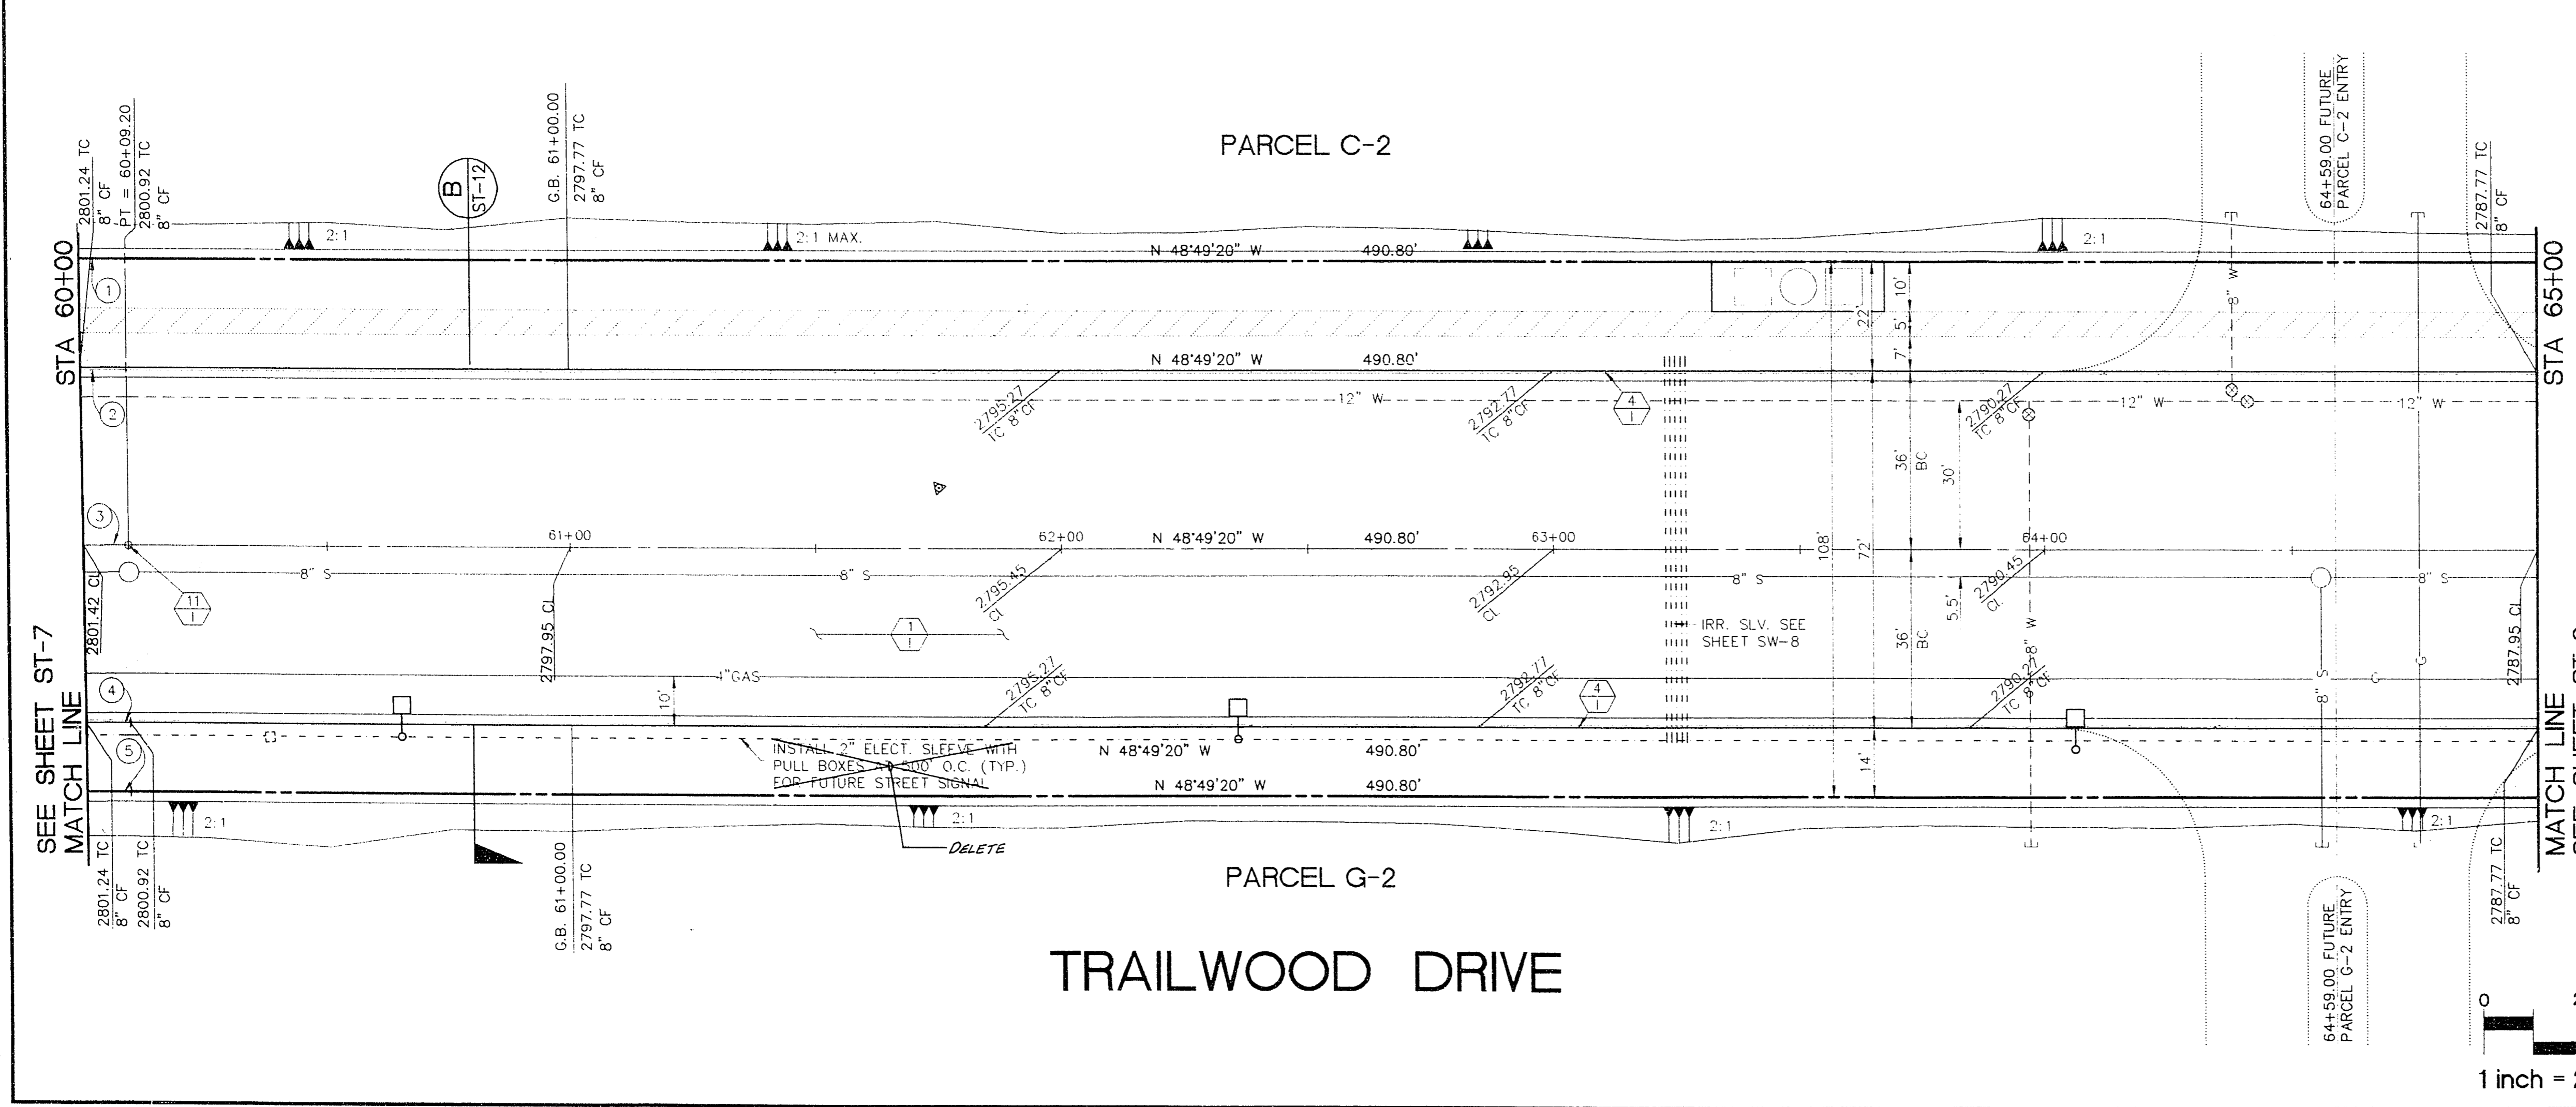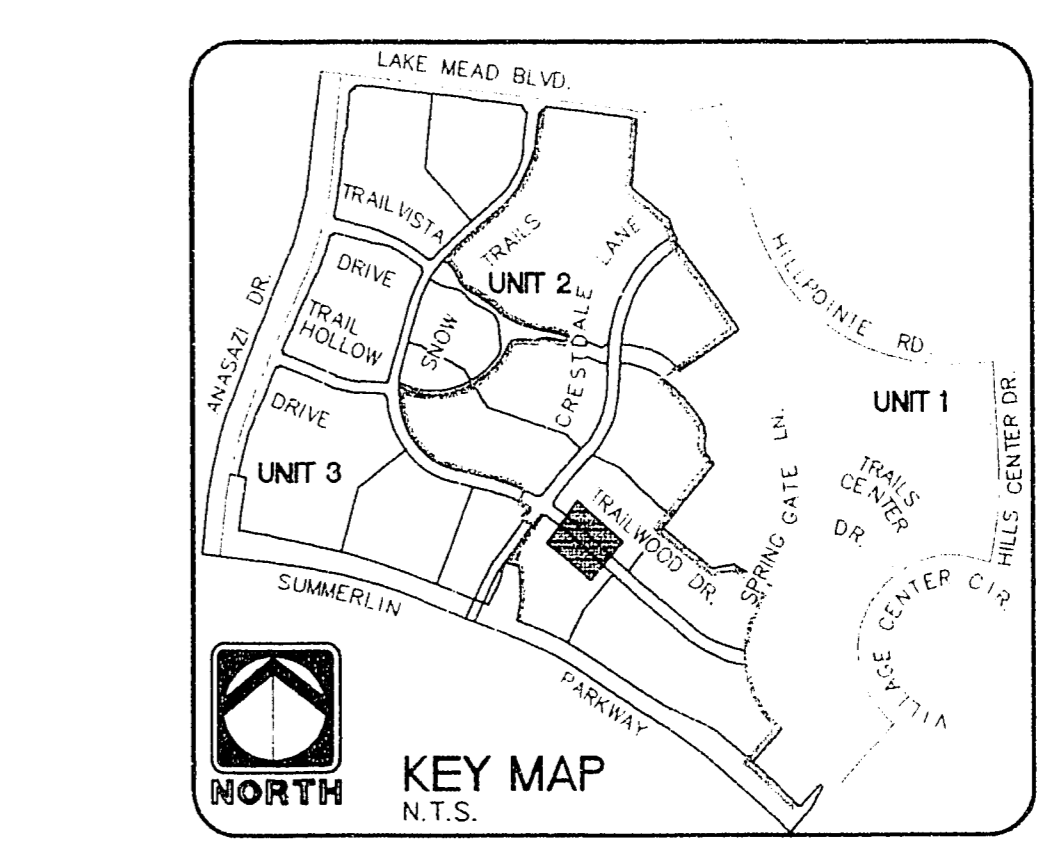

HOWARD HUGHES PROPERTIES
 SUMMERLIN VILLAGE 7 - THE TRAILS - UNIT 2
 TRAILWOOD DRIVE
 PLAN AND PROFILE
 STA 60+00 - STA 65+00

1 inch = 20 ft.

Call before you Dig.
 1-800-227-2600

SHIT 18 OF 48
 ST-8

11-2-79 1074-42-1-3