

SERVICE PANEL SP-10 1 PH, 3 WIRE 120/240 VOLTS 125 AMP MAIN CB MIN INTERRUPTING RATING 10,000 RMS SYM AMPS LOCATION: TRAILWOOD NEMA 3R									
L=LIGHTS, R=RECEPTACLES, M=MECHANICAL EQUIPMENT, N=NEW, SO=SPACE ONLY, SC=SPARE CIRCUIT, E=EXISTING, MLO=MAIN LUGS ONLY, MCB=MAIN CIRCUIT BREAKERS									
POLE SPACE ckt #	CIRCUIT USE	CKT BKR RATING	CONNECTED LOAD VA		CKT BKR RATING	CIRCUIT USE	POLE SPACE ckt #		
A	B	A	B		A	B			
1	1	60/2	2820	1400	60/2	SPRINGS GATE LN. L-STREET LIGHTS	2	2	
3	X	X	2820	1400	X	X	4		
5	5	N-L-PHOTOCELL	200	200	20	L-PHOTOCELL	6	4	
7	50								
9	50					50	8		
11	50					50	10		
13						50	12		
15							14		
			4620	4220			16		
				8840					

CONTACTOR SCHEDULE

CONTACTOR #	RATING	No. POLES	CKT #'S
C1	60	2	1
C2	60	2	2

* EXISTING PANEL

Copyright (c) 1993 by T.J. KROB CONSULTING ENGINEERS, INC.

SERVICE PANEL SP-11 1 PH, 3 WIRE 120/240 VOLTS 125 AMP MAIN CB MIN INTERRUPTING RATING 10,000 RMS SYM AMPS LOCATION: TRAILWOOD NEMA 3R									
L=LIGHTS, R=RECEPTACLES, M=MECHANICAL EQUIPMENT, N=NEW, SO=SPACE ONLY, SC=SPARE CIRCUIT, E=EXISTING, MLO=MAIN LUGS ONLY, MCB=MAIN CIRCUIT BREAKERS									
POLE SPACE ckt #	CIRCUIT USE	CKT BKR RATING	CONNECTED LOAD VA		CKT BKR RATING	CIRCUIT USE	POLE SPACE ckt #		
A	B	A	B		A	B			
1	1	60/2	2040	1630	60/2	CRESTDALE LANE L-TRAILWOOD DRIVE	2	2	
3	X	X	2040	1630	X	X	4		
5	5	L-PHOTOCELL CKT 1	200	200	20	L-PHOTOCELL CKT 2	6	4	
7	X	X							
9	50					50	8		
11	50					50	10		
13						50	12		
15							14		
			4120	3120			16		
				7840					

CONTACTOR SCHEDULE

CONTACTOR #	RATING	No. POLES	CKT #'S
C1	60	2	1
C2	60	2	2

Copyright (c) 1993 by T.J. KROB CONSULTING ENGINEERS, INC.

SERVICE PANEL SP-13 1 PH, 3 WIRE 120/240 VOLTS 125 AMP MAIN CB MIN INTERRUPTING RATING 10,000 RMS SYM AMPS LOCATION: CRESTDALE NEMA 3R									
L=LIGHTS, R=RECEPTACLES, M=MECHANICAL EQUIPMENT, N=NEW, SO=SPACE ONLY, SC=SPARE CIRCUIT, E=EXISTING, MLO=MAIN LUGS ONLY, MCB=MAIN CIRCUIT BREAKERS									
POLE SPACE ckt #	CIRCUIT USE	CKT BKR RATING	CONNECTED LOAD VA		CKT BKR RATING	CIRCUIT USE	POLE SPACE ckt #		
A	B	A	B		A	B			
1	1	60/2	2330			50	2		
3	X	X	2330			50	4		
5	5	L-PHOTOCELL	200			50	6		
7	50					50	8		
9	50					50	10		
11	50					50	12		
13							14		
15							16		
			2530	2330					
				4860					

CONTACTOR SCHEDULE

CONTACTOR #	RATING	No. POLES	CKT #'S
C1	60	2	1

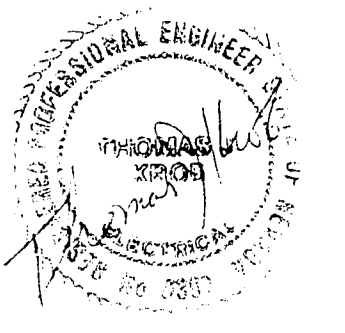
Copyright (c) 1993 by T.J. KROB CONSULTING ENGINEERS, INC.

NOTES:

- 1
- PANELS SP-11, SP-13 ARE INSTALLED IN UNIT 2.
- 2
- PANELS SP-12, SP-14 WILL BE INSTALLED IN UNIT 3.
- 3
- PANEL SP-10 WAS INSTALLED IN UNIT 1.

RECORD DRAWING

RECORD INFORMATION PROVIDED BY FIELD CONTRACTOR

SHEET TITLE:		JOB NUMBER:	
ELECTRICAL SCHEDULES		3116/SCHED2	
PROJECT:		DATE:	
HOWARD HUGHES PROPERTIES SUMMERLIN VILLAGE 7 - THE TRAILS UNIT 2		5/12/94	
DRAWN BY:		CHECKED BY:	
DSN/DSN		TOM KROB	
RECOMMENDED:		DATE:	
		6-14-94	
SHEET:		10 OF: 48	
SL-2			

TJ KROB
CONSULTING
ENGINEERS, INC.

1815 S. BONER BLVD. SUITE B
LAS VEGAS, NEVADA 89102
(702) 871-3921

ELECTRICAL ENGINEERING

DESCRIPTION

DATE

REV