

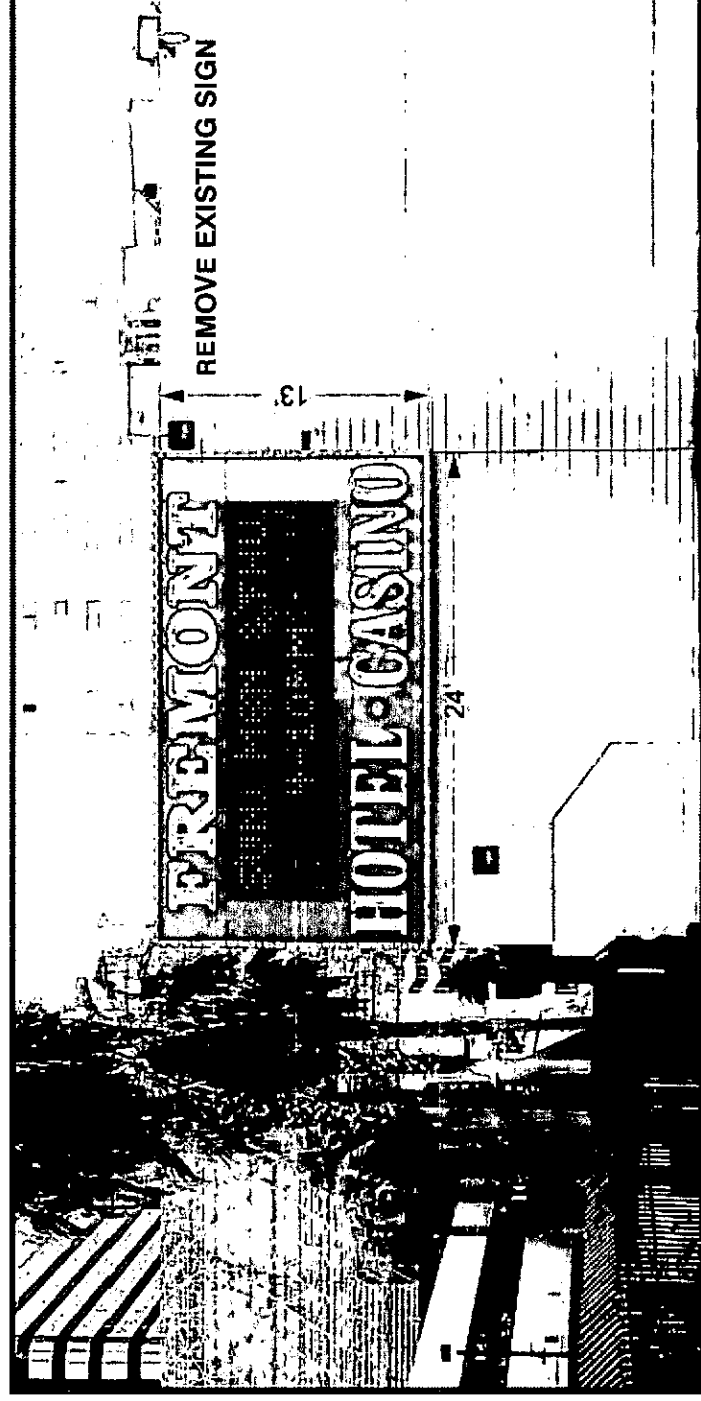


PROPOSED ELEVATION

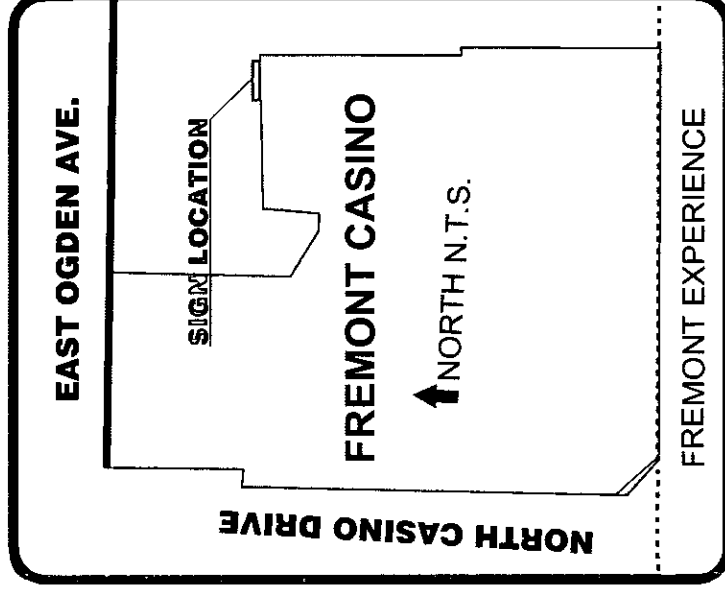

EXISTING ELEVATION

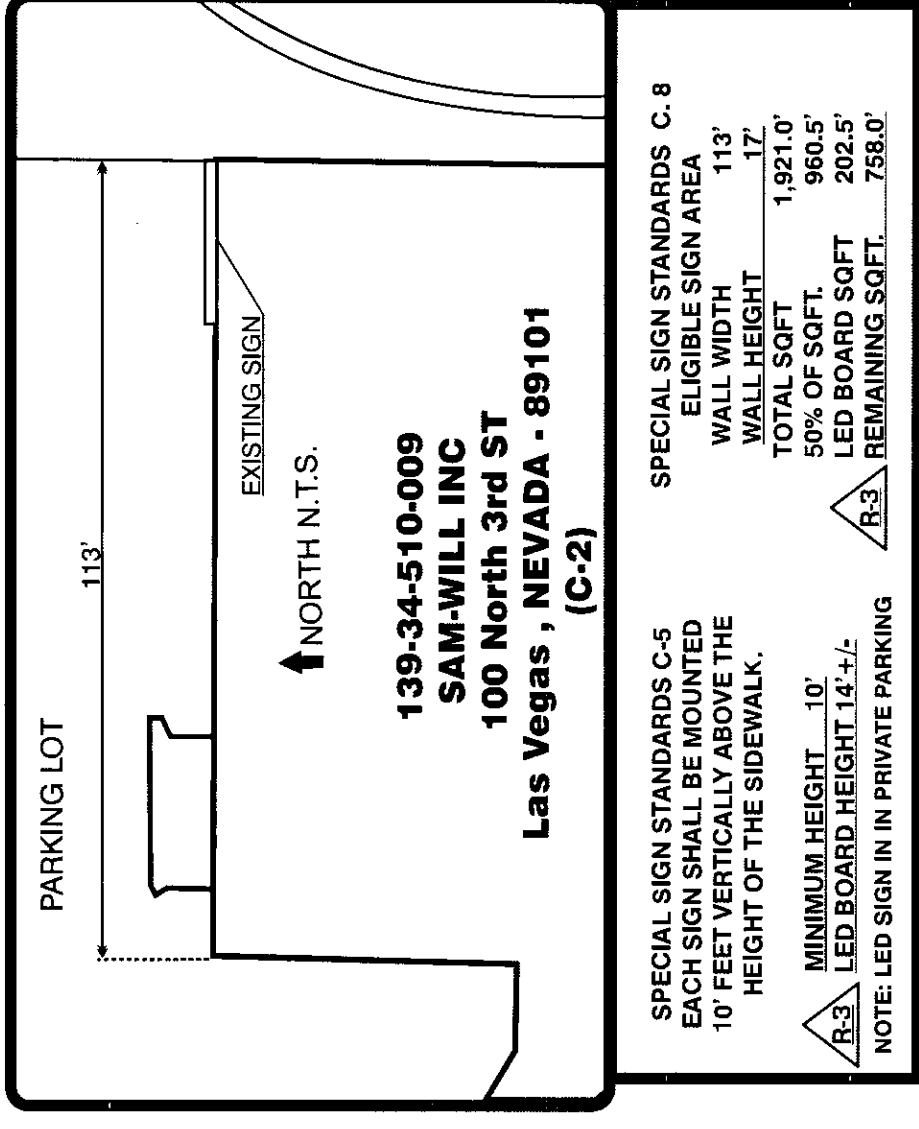

RECEIVED

NOV 25 2013

City of Las Vegas
 Department of Planning

FEDERAL HEATH

SIGN COMPANY
 WWW.FEDERALHEATH.COM

3900 W. Dewey Drive Las Vegas, NV 89118
 (702) 739-9466 Fax (702) 795-0378

Manufacturing Facilities:
 Operate: CA - Eureka, TX - Jacksonville, TX - Delaware, OH

Office Locations:
 Oceanside, CA - Las Vegas, NV - Laughlin, AZ
 Idaho Falls, ID - El Paso, TX - Jacksonville, TX - San Antonio, TX
 Houston, TX - Corpus Christi, TX - Indianapolis, IN
 Louisville, KY - Knoxville, TN - Grapewind, WI - Delaware, OH
 Willowbrook, IL - Turlock, CA - Atlanta, GA
 Tampa, FL - Daytona Beach, FL - Orlando, FL

Building Quality Signage Since 1901

REVISIONS:

1 - add decorative signage m.e. 11-6-13

Colors Depicted In This Rendering May Not Match Actual Finished Materials. Refer to Product Samples for Exact Color Match.
 Client Approval/Date: _____
 Landlord Approval/Date: _____


Account Rep: **DERON GROWE**
 Project Manager: **CRAIG RODERY**
 Drawn By: **RICHARD SHADE**

Underwriters Laboratories Inc. **ELECTRICAL TO USE UL LISTED COMPONENTS AND SHALL MEET ALL ELECTRICAL REQUIREMENTS TO COMPLY WITH U.S. AND ALL APPLICABLE CODES OF THE N.E.C. STANDARDS, INCLUDING THE PROPER GROUNDING AND BONDING OF ALL SIGNS.**

Project / Location:
139-34-510-009
SAM-WILL INC
100 North 3rd ST
Las Vegas, NEVADA - 89101
(C-2)

Job Number: **21-05678**
 Date: **10/25/13**
 Sheet Number: **1** Of **2**
 Design Number: **0**

This original drawing is provided as part of a planned project and is not to be exhibited, copied or reproduced without the written permission of Federal Heath Sign Company, LLC or its authorized agent. © FHSC

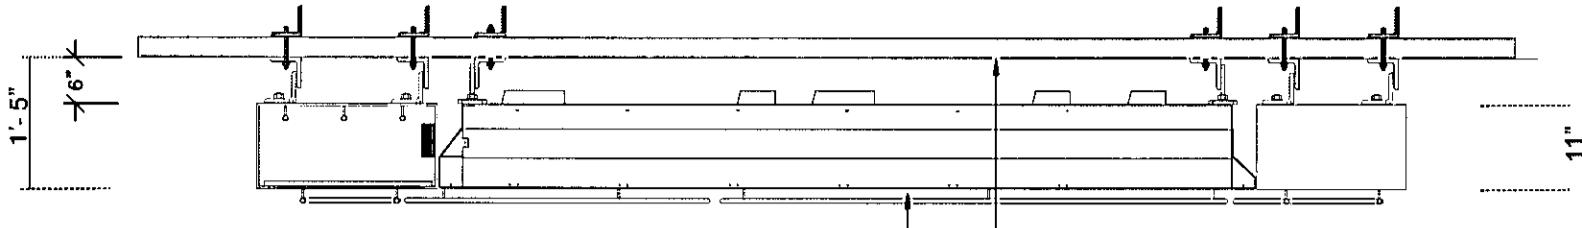



OPTION C

COPY: ROUTED OUT
 COPY BACKED W/
 LEXAN/ 3M 3630-125
 GOLDEN YELLOW
 VINYL 2ND SURF.
 W/ DIFFUSER.
 (COPY IS BACKED
 W/ WHITE LEDS)

15mm CLEAR RED
 NEON BORDER
 (on face)

NEW LED BOARD

ALUM. CABINET PTD.
 PMS 200 RED

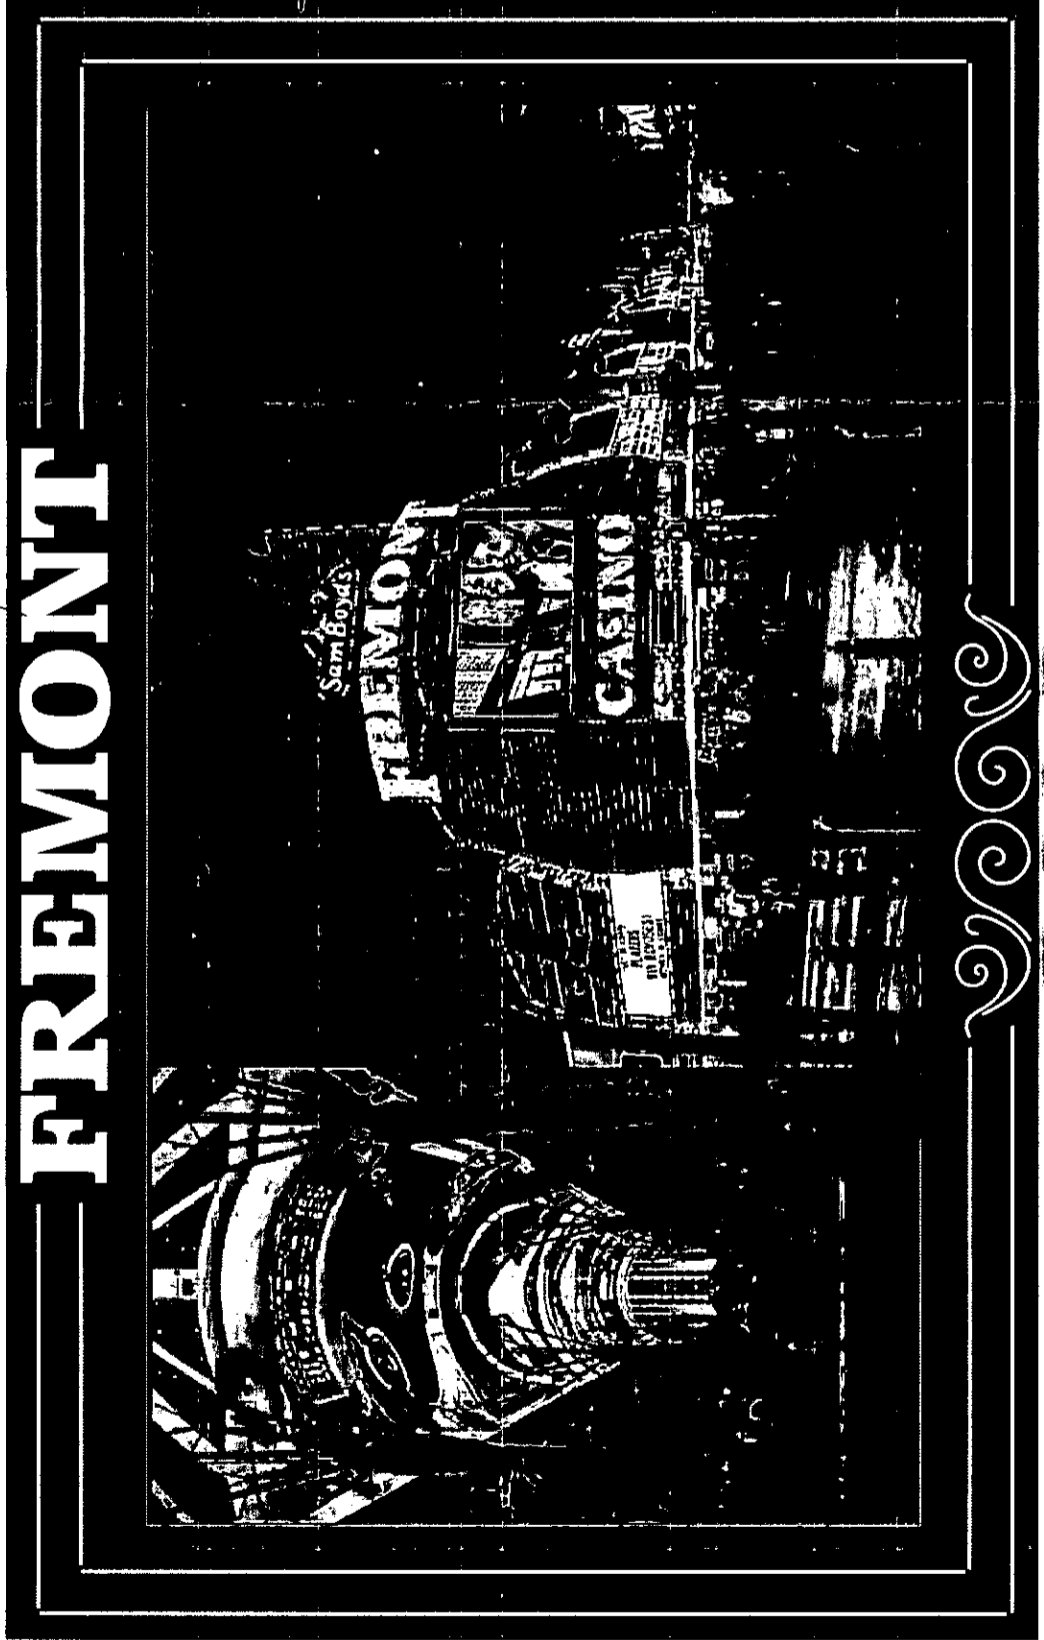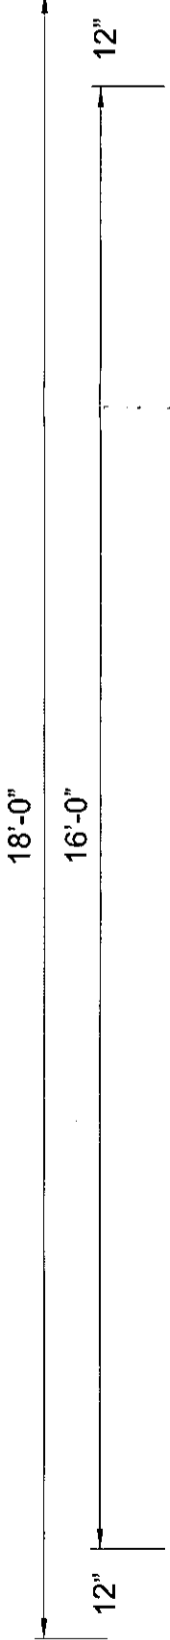

S/F WALL DISPLAY

scale 1/2"=1'-0"

RECEIVED
 NOV 25 2013

City of Las Vegas
 Department of Planning

FEDERAL HEATH
SIGN COMPANY
 www.FederalHeath.com
 3900 W. Dewey Drive Las Vegas, NV 89118
 (702) 739-9466 Fax (702) 795-0378

Manufacturing Facilities:
 Oceanside, CA - El Paso, TX - Jacksonville, TX - Delaware, OH
 Office Locations:
 Oceanside, CA - Las Vegas, NV - Laughlin, AZ
 Kalamo Falls, ID - El Paso, TX - Jacksonville, TX - San Antonio, TX
 Houston, TX - Corpus Christi, TX - Indianapolis, IN
 Louisville, KY - Knoxville, TN - Canton, WI - Delaware, OH
 Wilkesboro, NC - Tumboltz, MS - Atlanta, GA
 Tampa, FL - Daytona Beach, FL - Orlando, FL
Building Quality Signage Since 1901

Revisions:
 1- add decorative signage m.e. 11-6-13
 2-CHANGE TO ROUTED COPY, FRAME SIZE M.E. 11-20-13
 Colors Depicted In This Rendering May Not Match Actual Finished Materials Refer To Product Samples For Exact Color Match.
 Client Approval/Date: _____
 Landlord Approval/Date: _____

Account Rep: **DERON GROWE**
 Project Manager: **CRAIG RODERY**
 Drawn By: **RICHARD SHADE**
 Underwriters Laboratories Inc. (UL) Electrical to use U.L. LISTED ALL N.E.C. STANDARDS
 ALL ELECTRICAL SIGNS ARE TO COMPLY WITH U.L. 84 AND ARTICLE 600 OF THE N.E.C. STANDARDS, INCLUDING THE PROPER GROUNDING AND BONDING OF ALL SIGNS.

Project / Location:

 139-34-510-009
SAM-WILL INC
 100 North 3rd St
 Las Vegas, NEVADA - 89101

Job Number:
 Date: 10/25/13
 Sheet Number: 2 Of 2
 Design Number: 21-0567800 R2

This original drawing is provided as part of a planned project and is not to be exhibited, copied or reproduced without the written permission of Federal Heath Sign Company, LLC or its authorized agent. © FHSC