

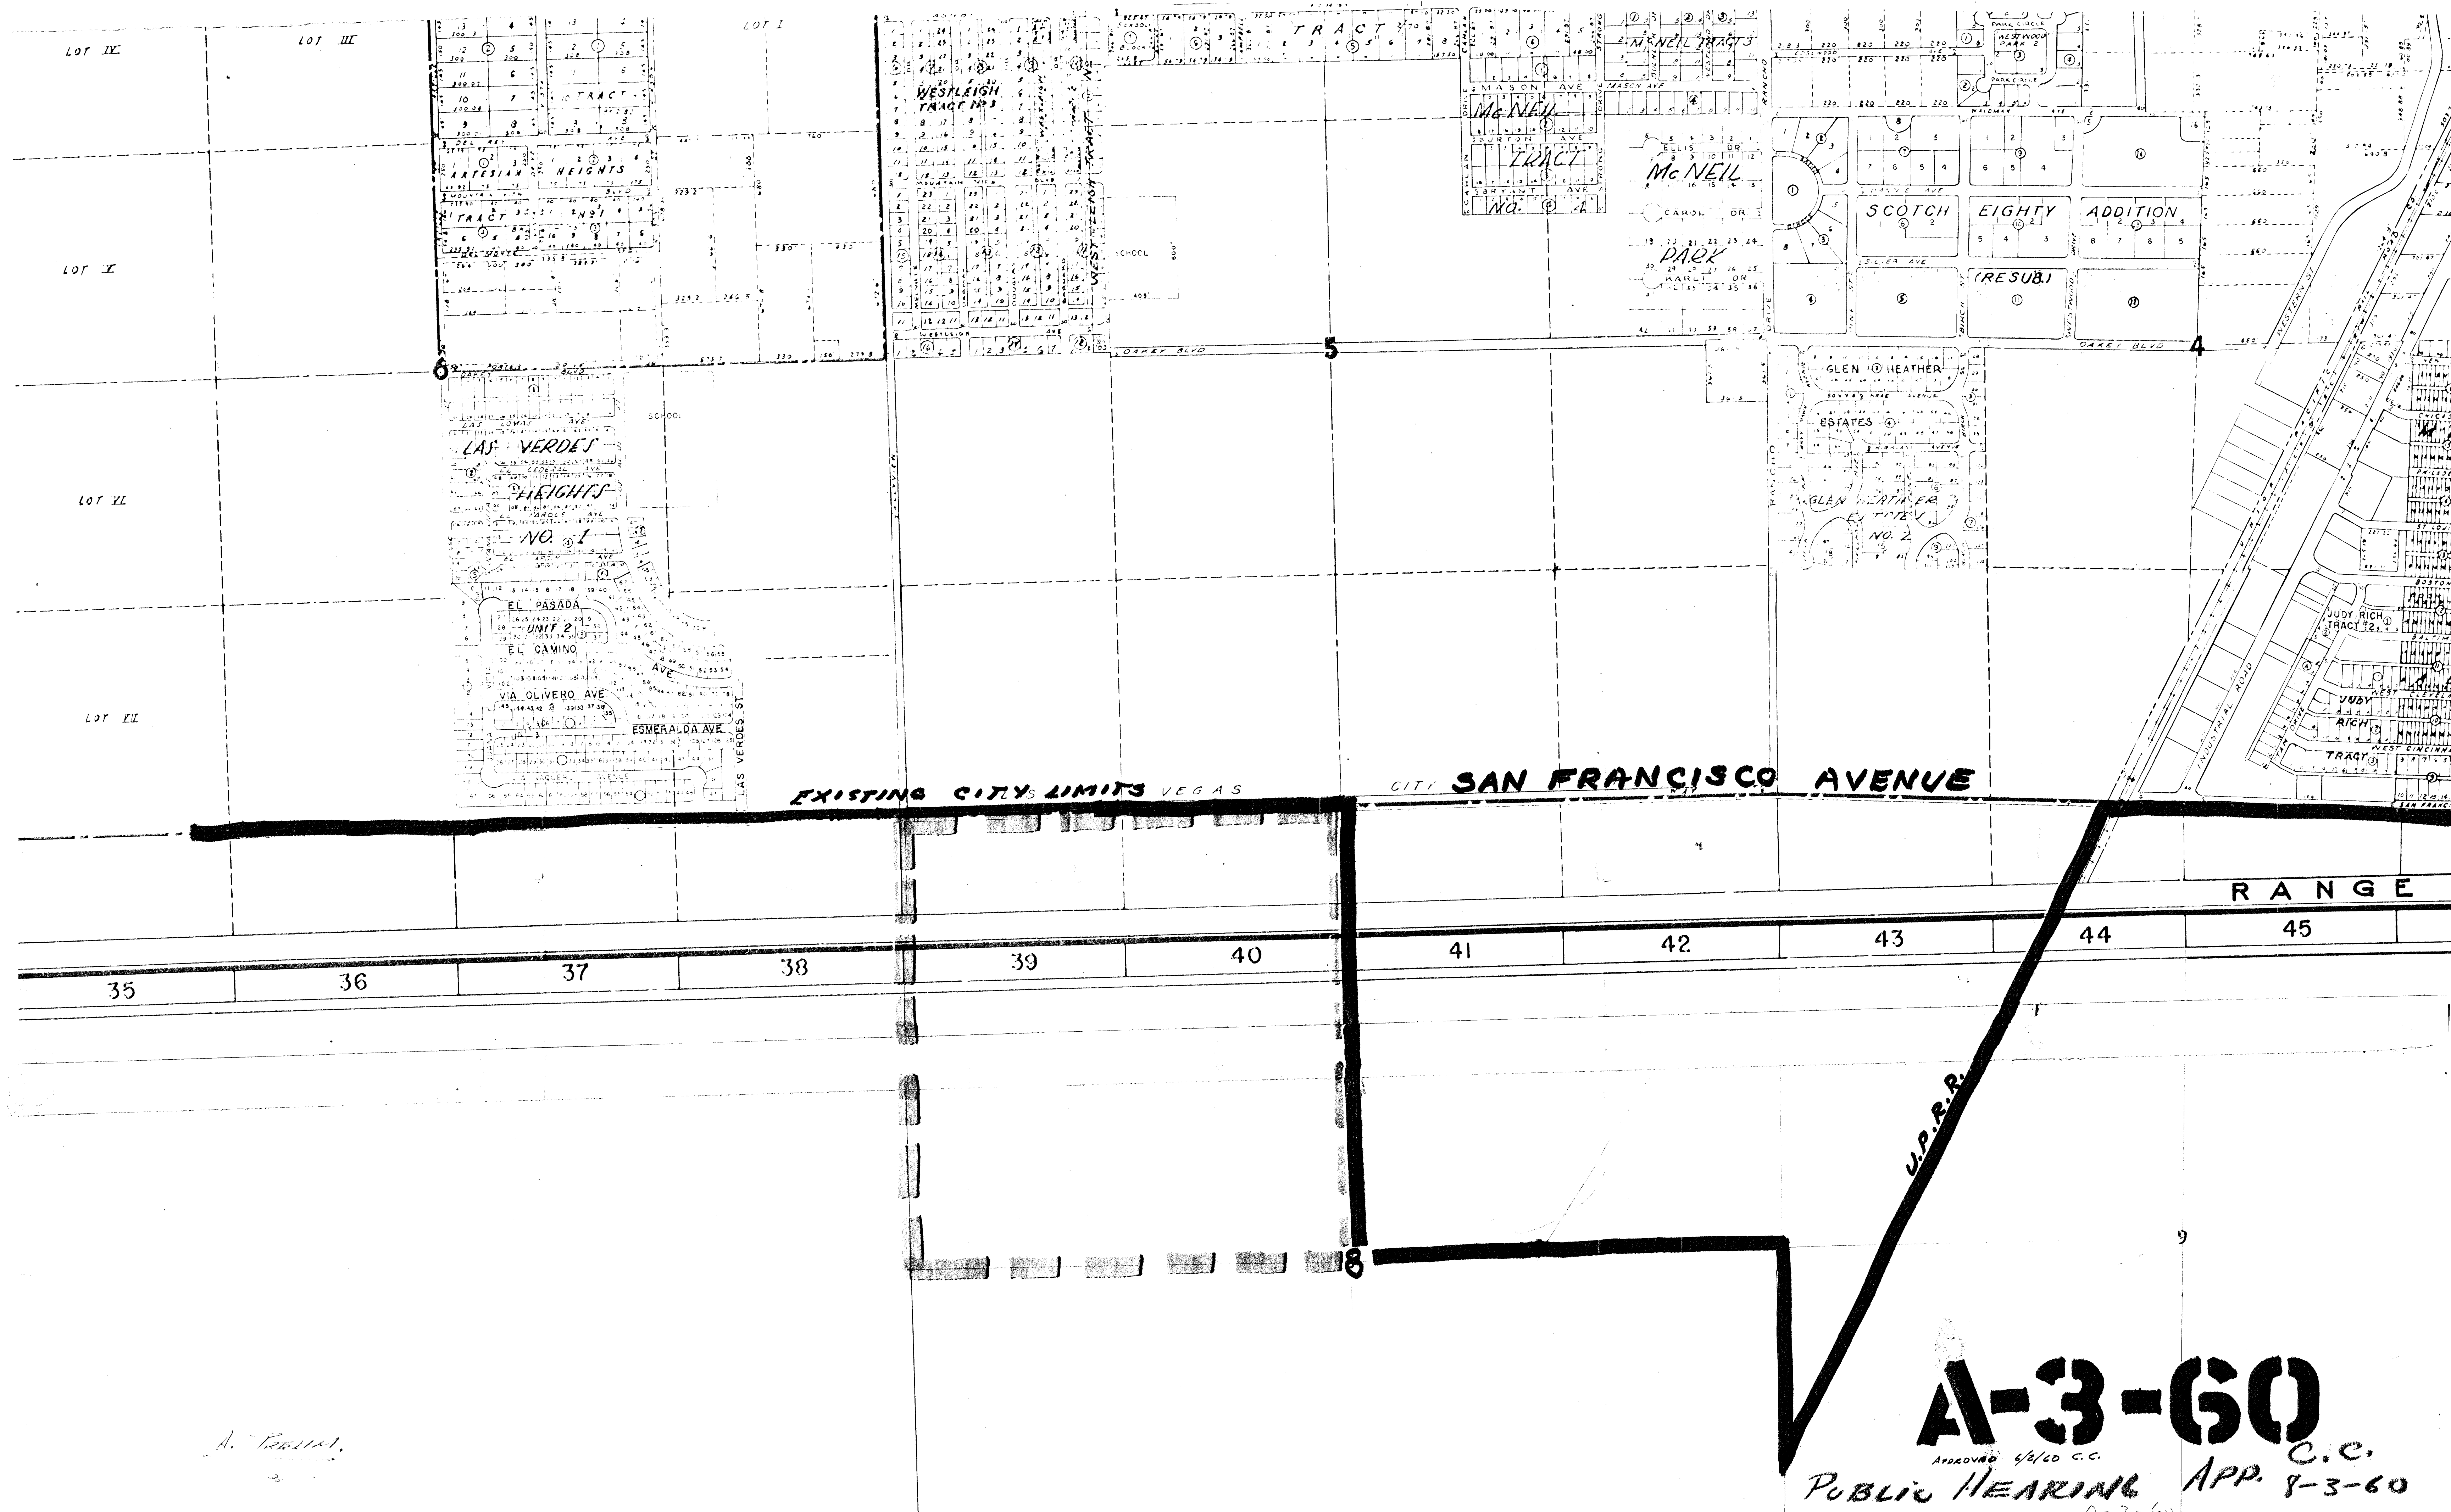


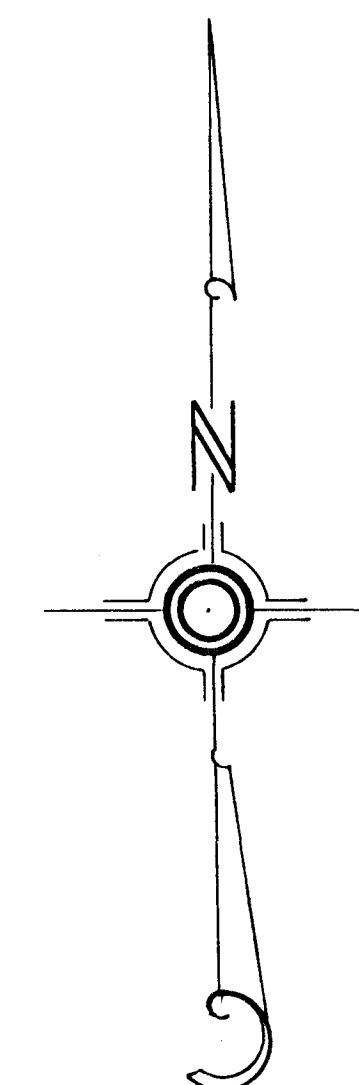

A. [illegible]
2

A-3-60
APPROVED 4/6/60 C.C.
PUBLIC HEARING APP. 8-3-60 C.C.
A-3-60

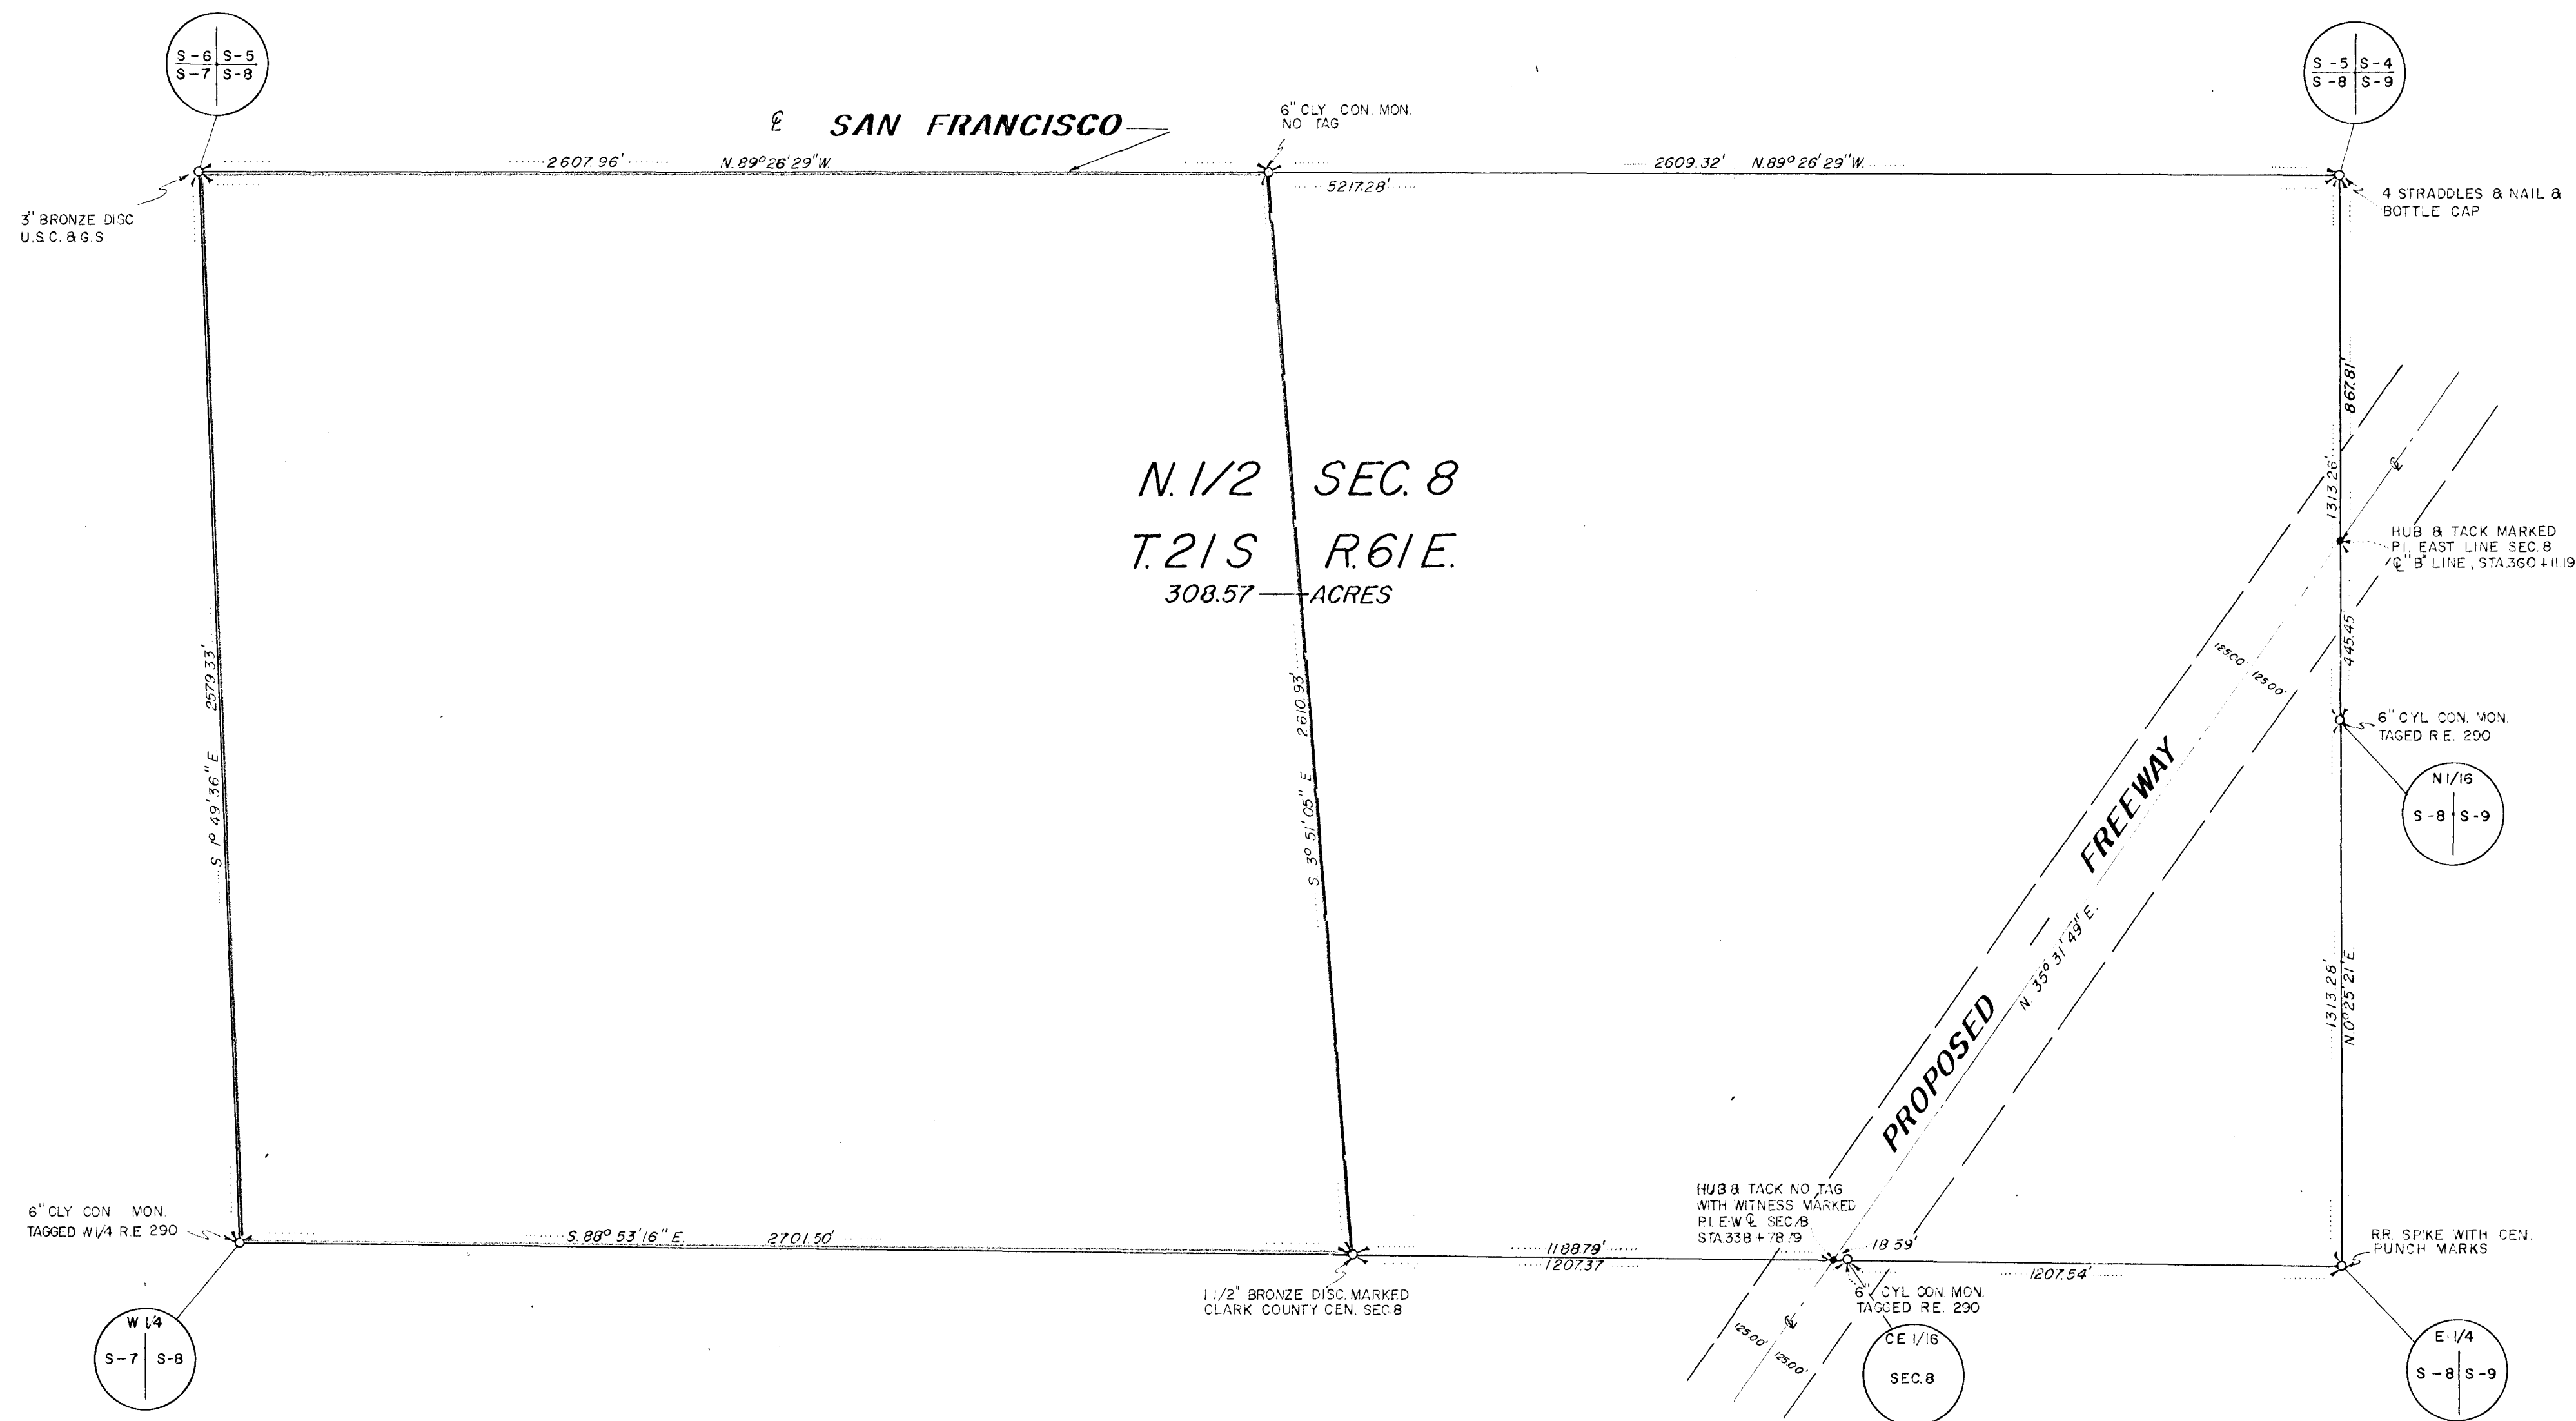

BASIS OF BEARING: (NORTH LINE SEC. 8 T. 21 S, RECORDED FILE 2 PAGE 31, N. 89° 26' 23" W.)

ENGINEER'S CERTIFICATE

I, L. E. TYSON, REGISTERED CIVIL ENGINEER AND LAND SURVEYOR NEVADA #560 DO HEREBY CERTIFY THAT THIS MAP IS A TRUE AND CORRECT PLAT OF THE LAND SURVEYED BY ME AT THE INSTANCE OF TEDDY RICH ENTERPRISES AND LOCATED IN THE N 1/2 SEC. 8, T. 21 S, R. 61 E., M.D.B. & M., CLARK COUNTY, NEVADA AND COMPLETED ON THIS 25TH DAY OF MAY, 1959. THIS SURVEY IS NOT A SUBDIVISION AS DEFINED IN THE PLANNING & ZONING LAW AS SHOWN IN 1943-1949 SUPP NEVADA COMPLIED LAWS

L. E. Tyson
L. E. TYSON REG. CIVIL ENG. & LAND SURVEYOR NEV. #560

MAP FOR RECORD OF SURVEY
FOR
TEDDY RICH ENTERPRISES
N 1/2 SECTION 8, T. 21 S, R. 61 E.
M.D.B. & M.
CLARK COUNTY, NEVADA