

SURVEYOR'S CERTIFICATE

I, STEPHEN F. TURNER, A REGISTERED PROFESSIONAL ENGINEER AND LAND SURVEYOR, DO HEREBY CERTIFY THAT THIS MAP IS A TRUE AND ACCURATE REPRESENTATION OF THE LANDS SHOWN HEREON. ALL POINTS FOUND OR SET ARE CORRECTLY DESIGNATED. THIS SURVEY WAS COMPLETED ON JANUARY 14, 1991, AT THE INSTANCE OF JIM SMITH AND DOES NOT CONSTITUTE A SUBDIVISION AS DEFINED BY NEVADA STATE LAW.

Stephen F. Turner
STEPHEN F. TURNER
R.P.E. - R.L.S. NO. 1803

LEGAL DESCRIPTION

THE S.W. 1/4 OF THE S.W. 1/4 OF THE S.W. 1/4 OF THE N.E. 1/4 OF SECTION 14, TOWNSHIP 20 SOUTH, RANGE 60 EAST, M.D.B. & M.

BASIS OF BEARINGS

N04°13'42"W - THE WEST LINE OF THE N.W. 1/4 OF THE N.E. 1/4, OF THE S.W. 1/4, OF THE N.E. 1/4, OF SECTION 14, TOWNSHIP 20 SOUTH, RANGE 60 EAST, M.D.B. & M., AS SHOWN ON PARCEL MAP FILE 13, PAGE 23, CLARK COUNTY RECORDS, NEVADA.

LEGEND

- PROPERTY LINE
- STREET CENTERLINE
- POINT FOUND AS NOTED
- POINT SET REBAR & CAP R.L.S. 1803
- UNLESS OTHERWISE NOTED, SET 2" x 2" HUB AND TACK

"ANNEXED TO THE CITY OF LAS VEGAS
ORDINANCE NO. 2160"


RECORD MAP OF SURVEY FOR JIM SMITH


THE S.W. 1/4 OF THE S.W. 1/4 OF THE S.W. 1/4 OF THE N.E. 1/4 OF SECTION 14, TOWNSHIP 20 SOUTH, RANGE 60 EAST, M.D.B. & M. CLARK COUNTY, NEVADA

NO. 1359413
FILED AT THE REQUEST OF
JIM Smith
DATE 5/13/91 AT 2:16 P.M.
FILE 37 PAGE 42
OF SURVEY MAPS
OFFICIAL RECORDS BOOK NO. 1400
CLARK COUNTY NEVADA RECORDS
JOAN L. SWIFT, RECORDER
FEE 5.20 DEPUTY J.W. 2


BAUGHMAN & TURNER
CIVIL ENGINEERS MINING ENGINEERS
LAND SURVEYORS
3325 WEST CHARLESTON BOULEVARD LAS VEGAS, NEVADA 89102
702 870-8771

FILE 37 PAGE 42

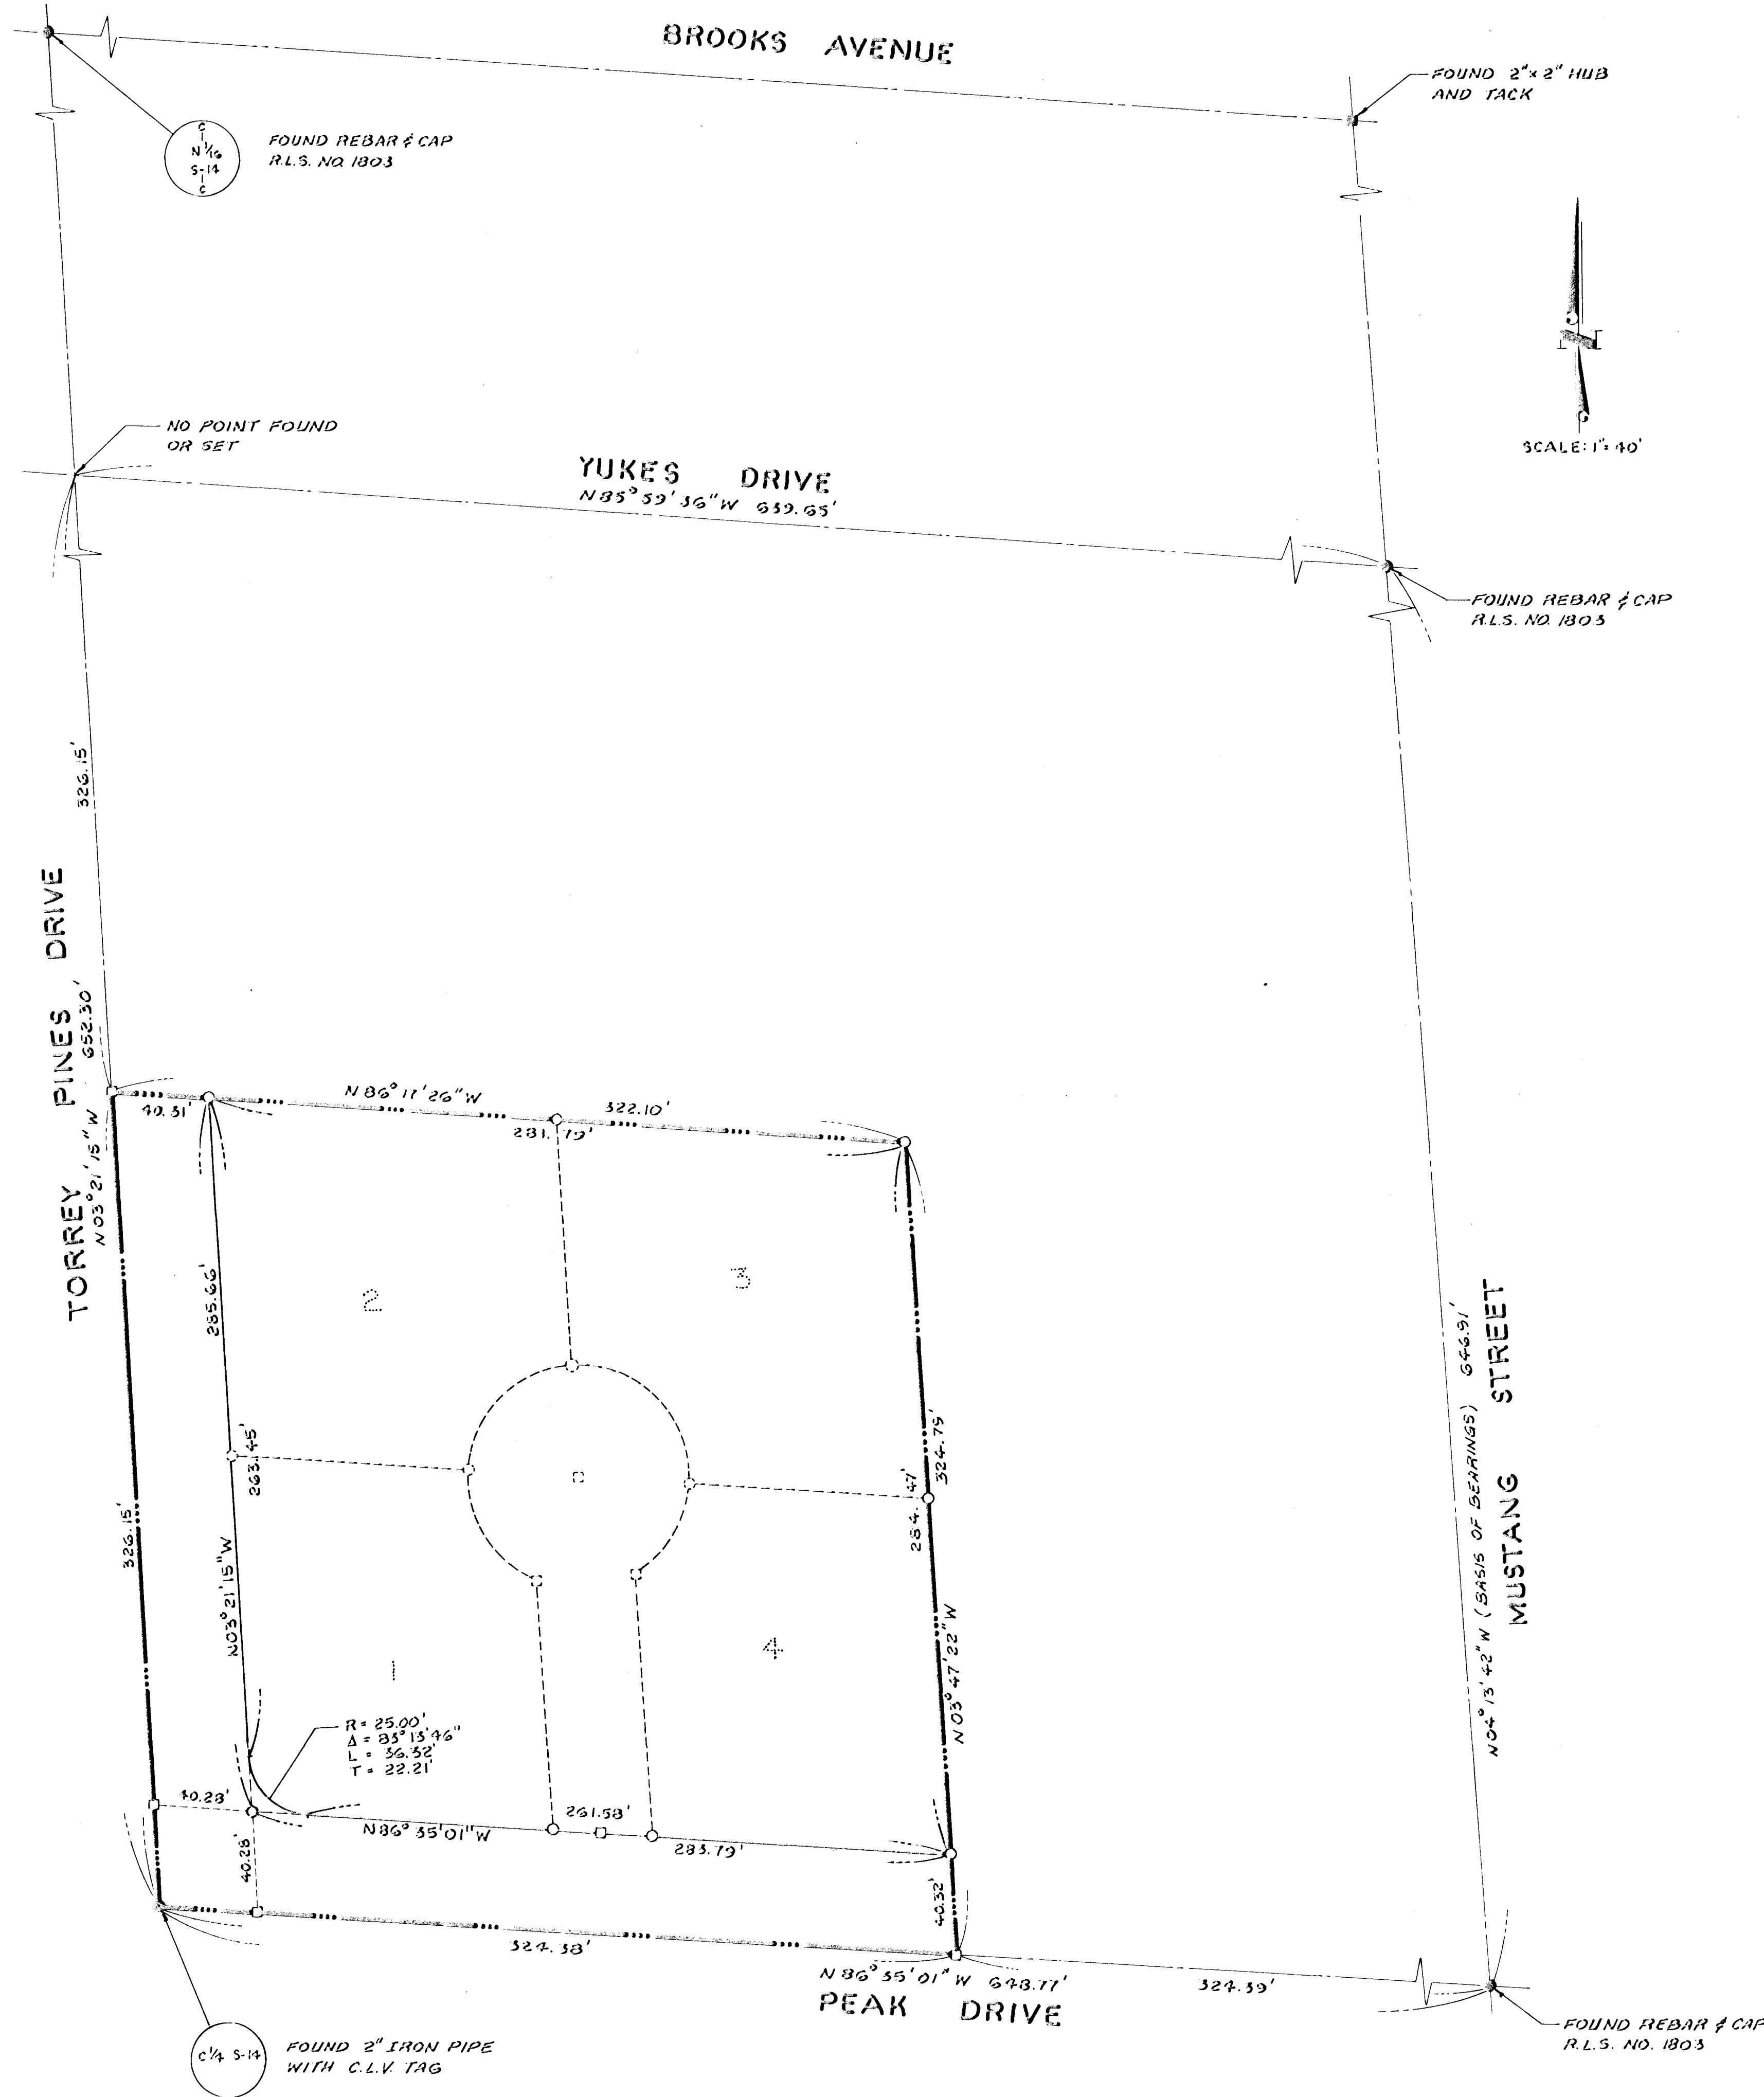

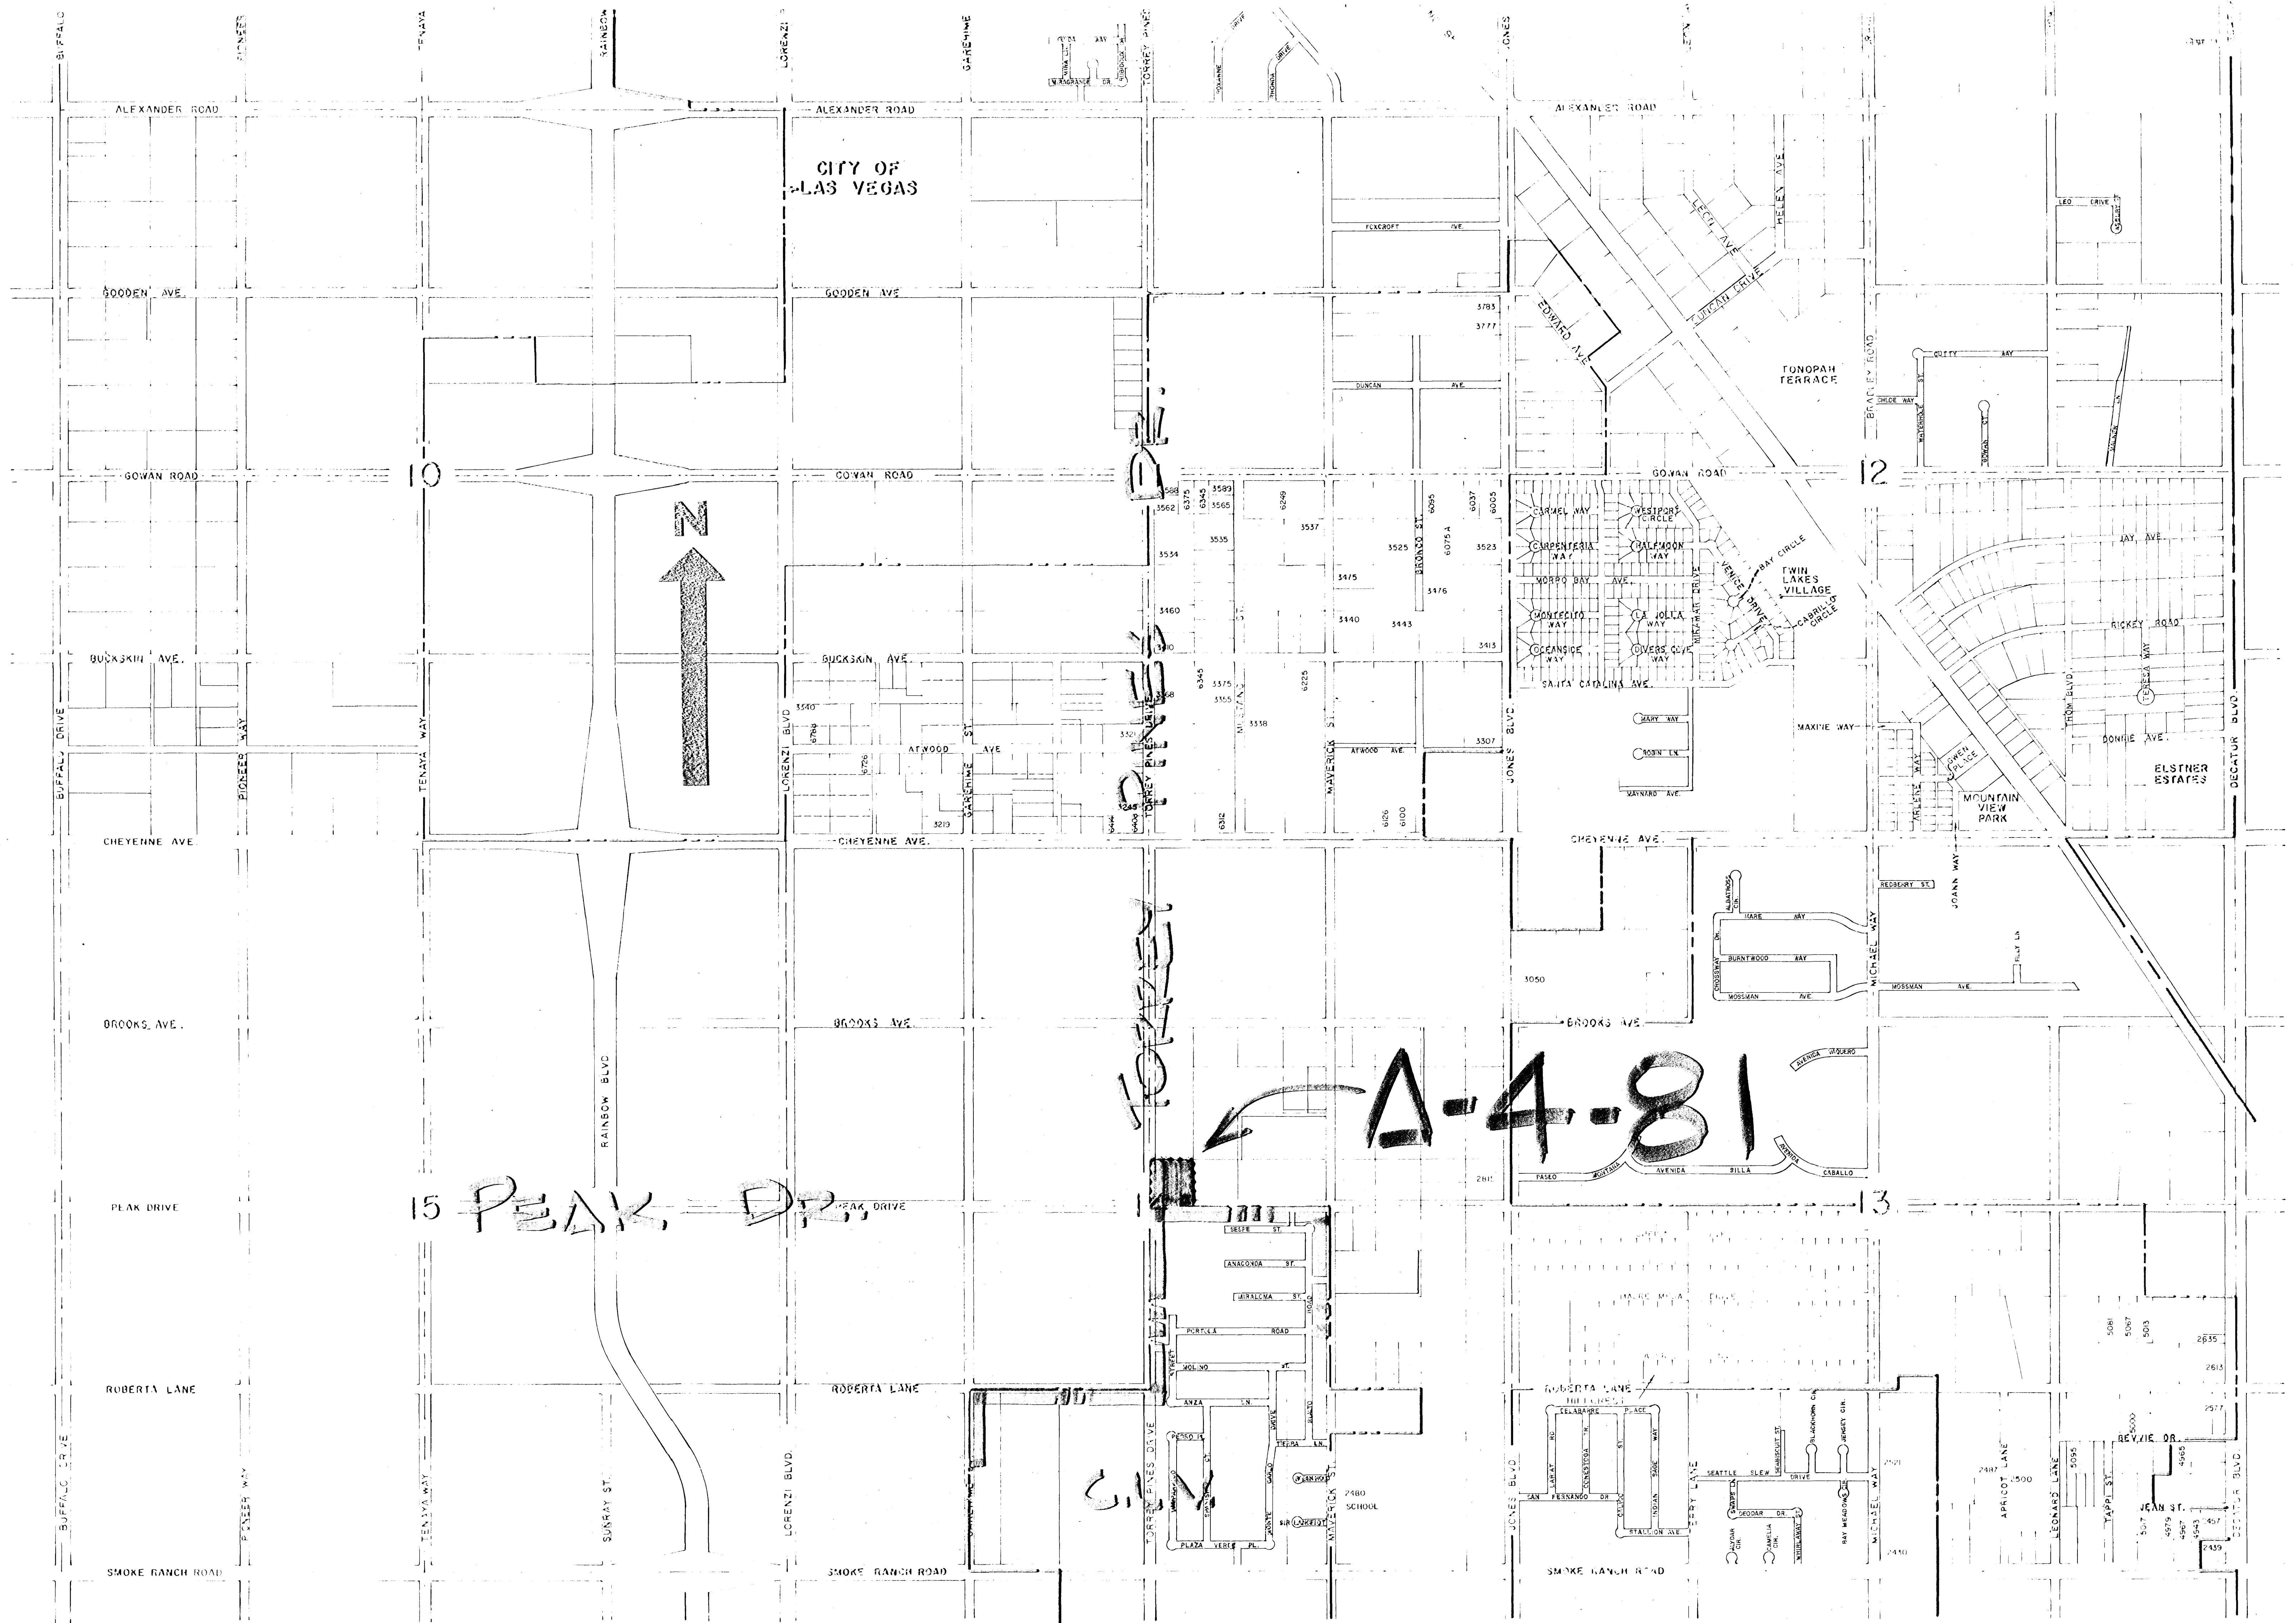

CITY OF LAS VEGAS

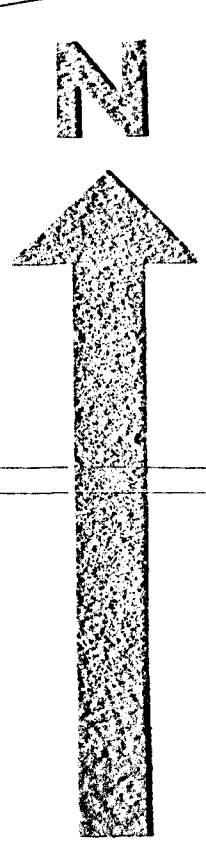

15 PEAK DR.

A-4-81

TORREY DRIVE