



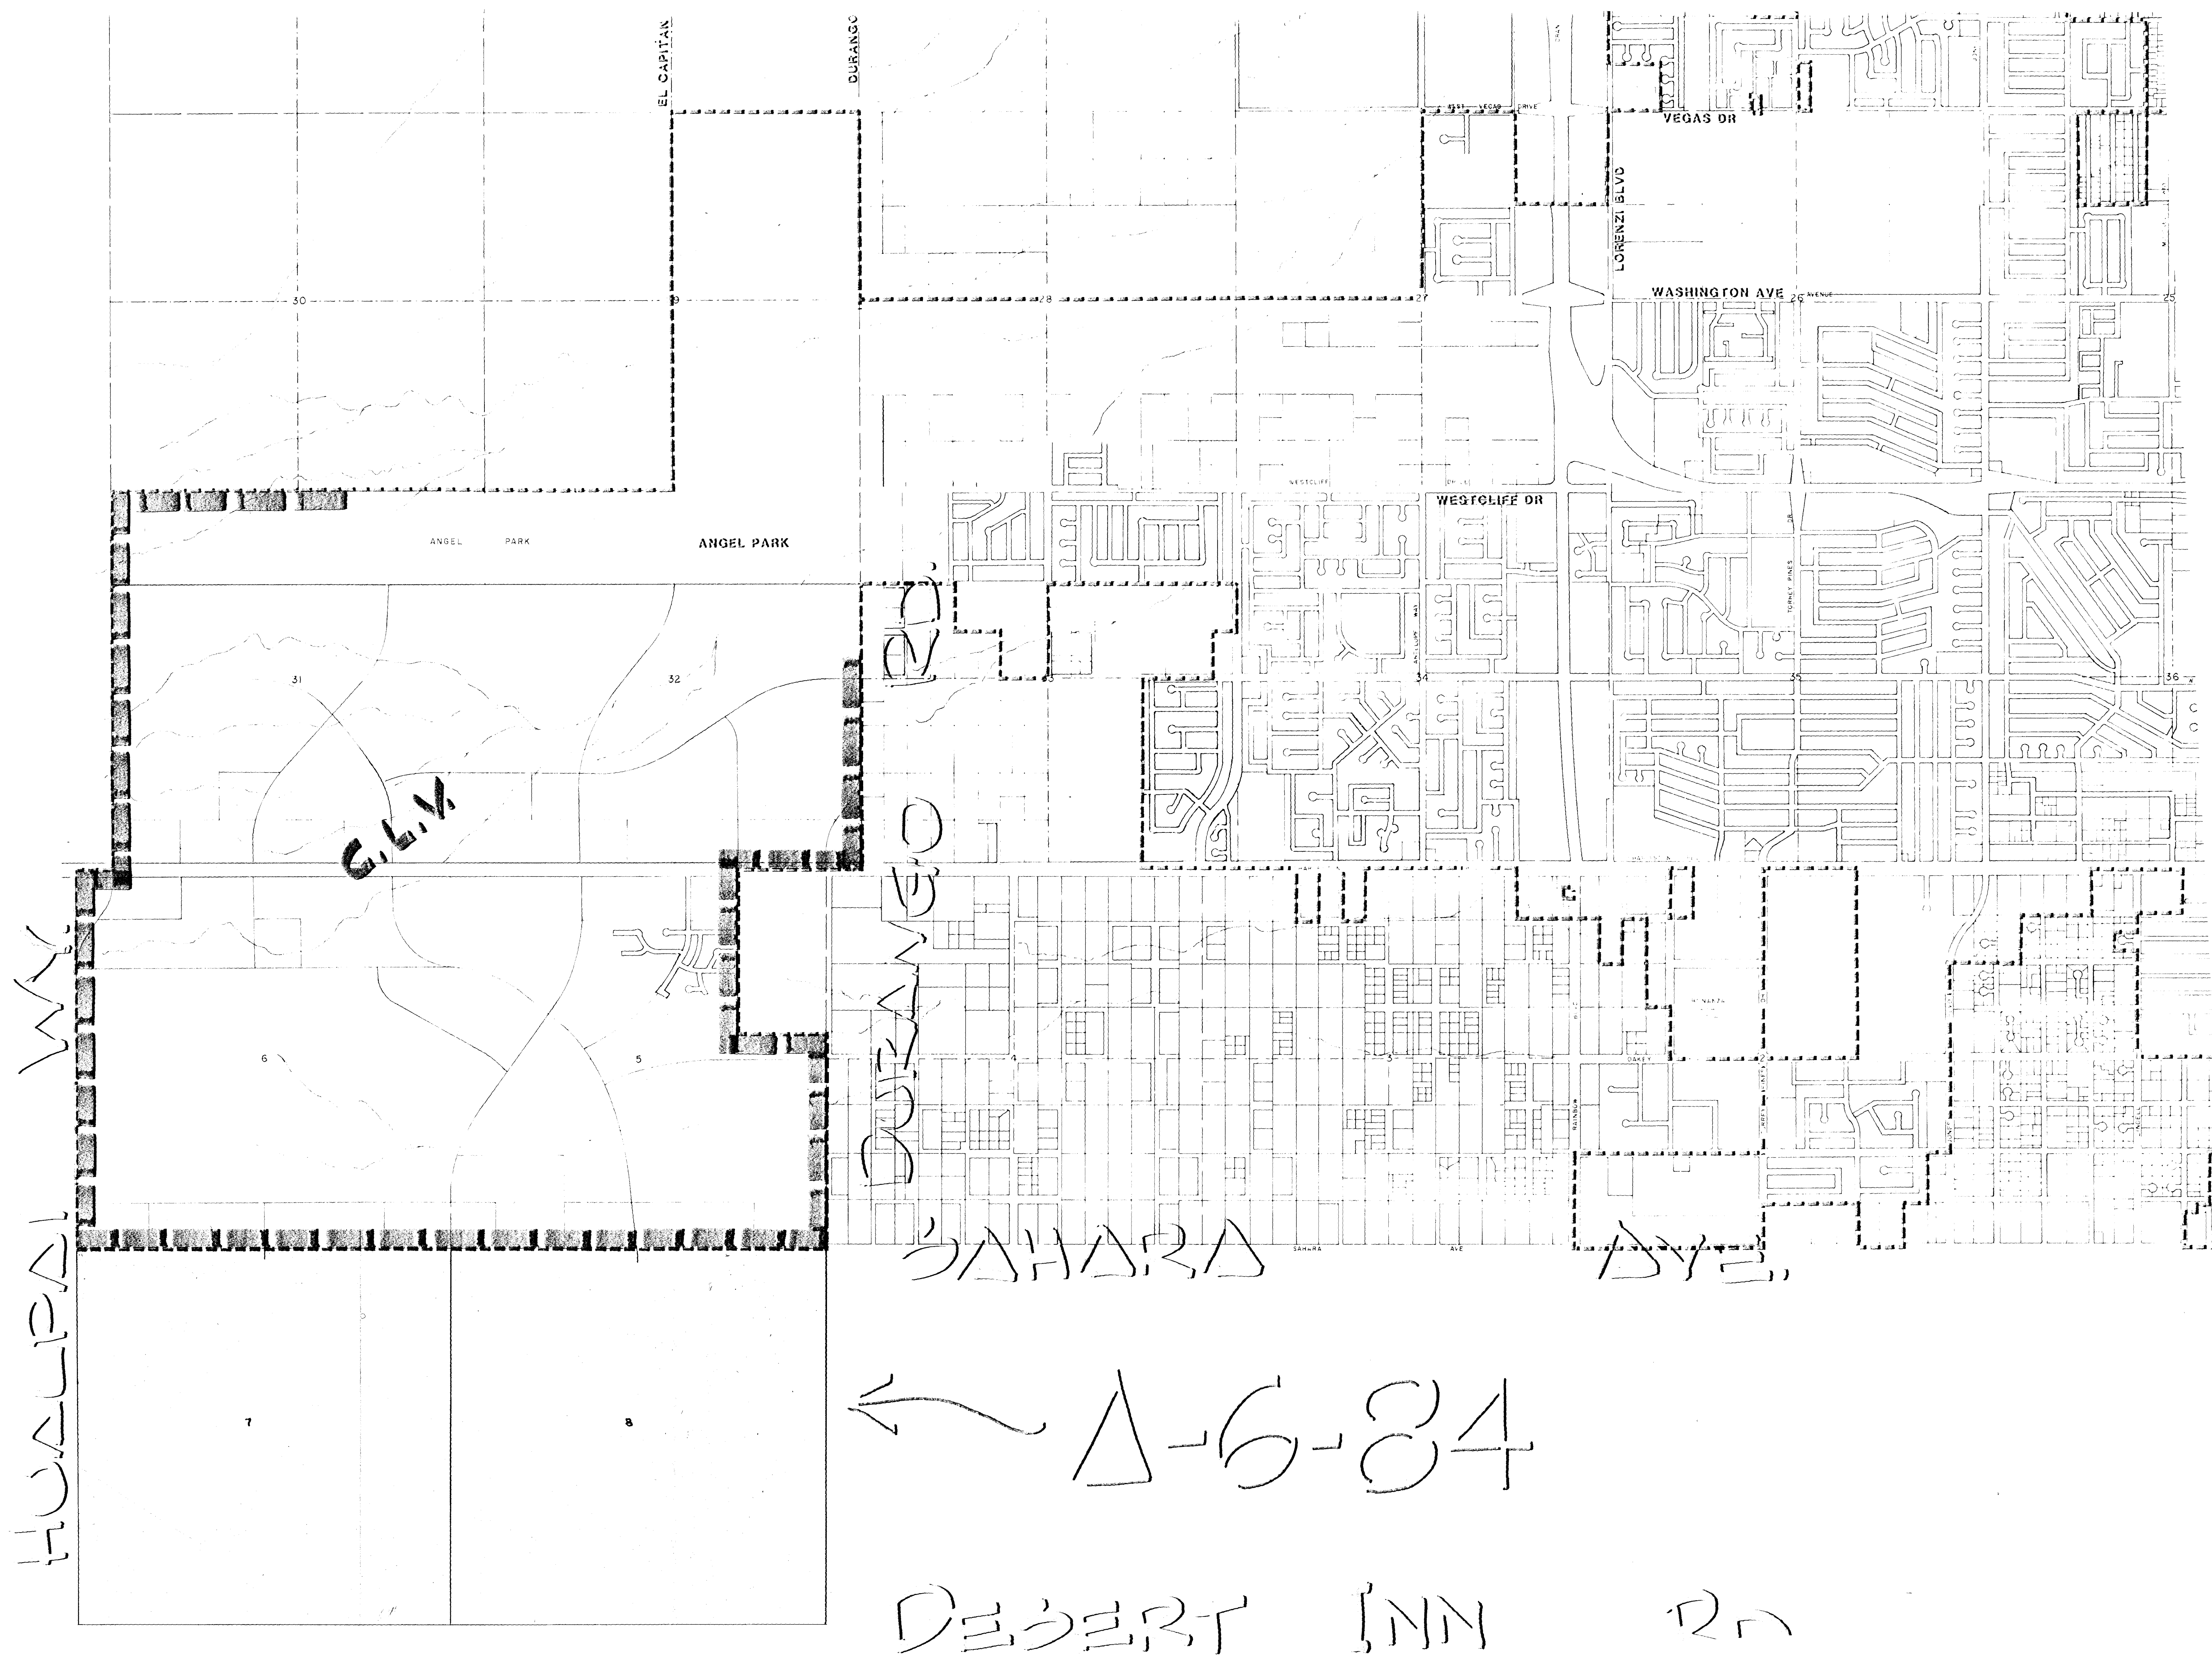

Book 1908

1867009

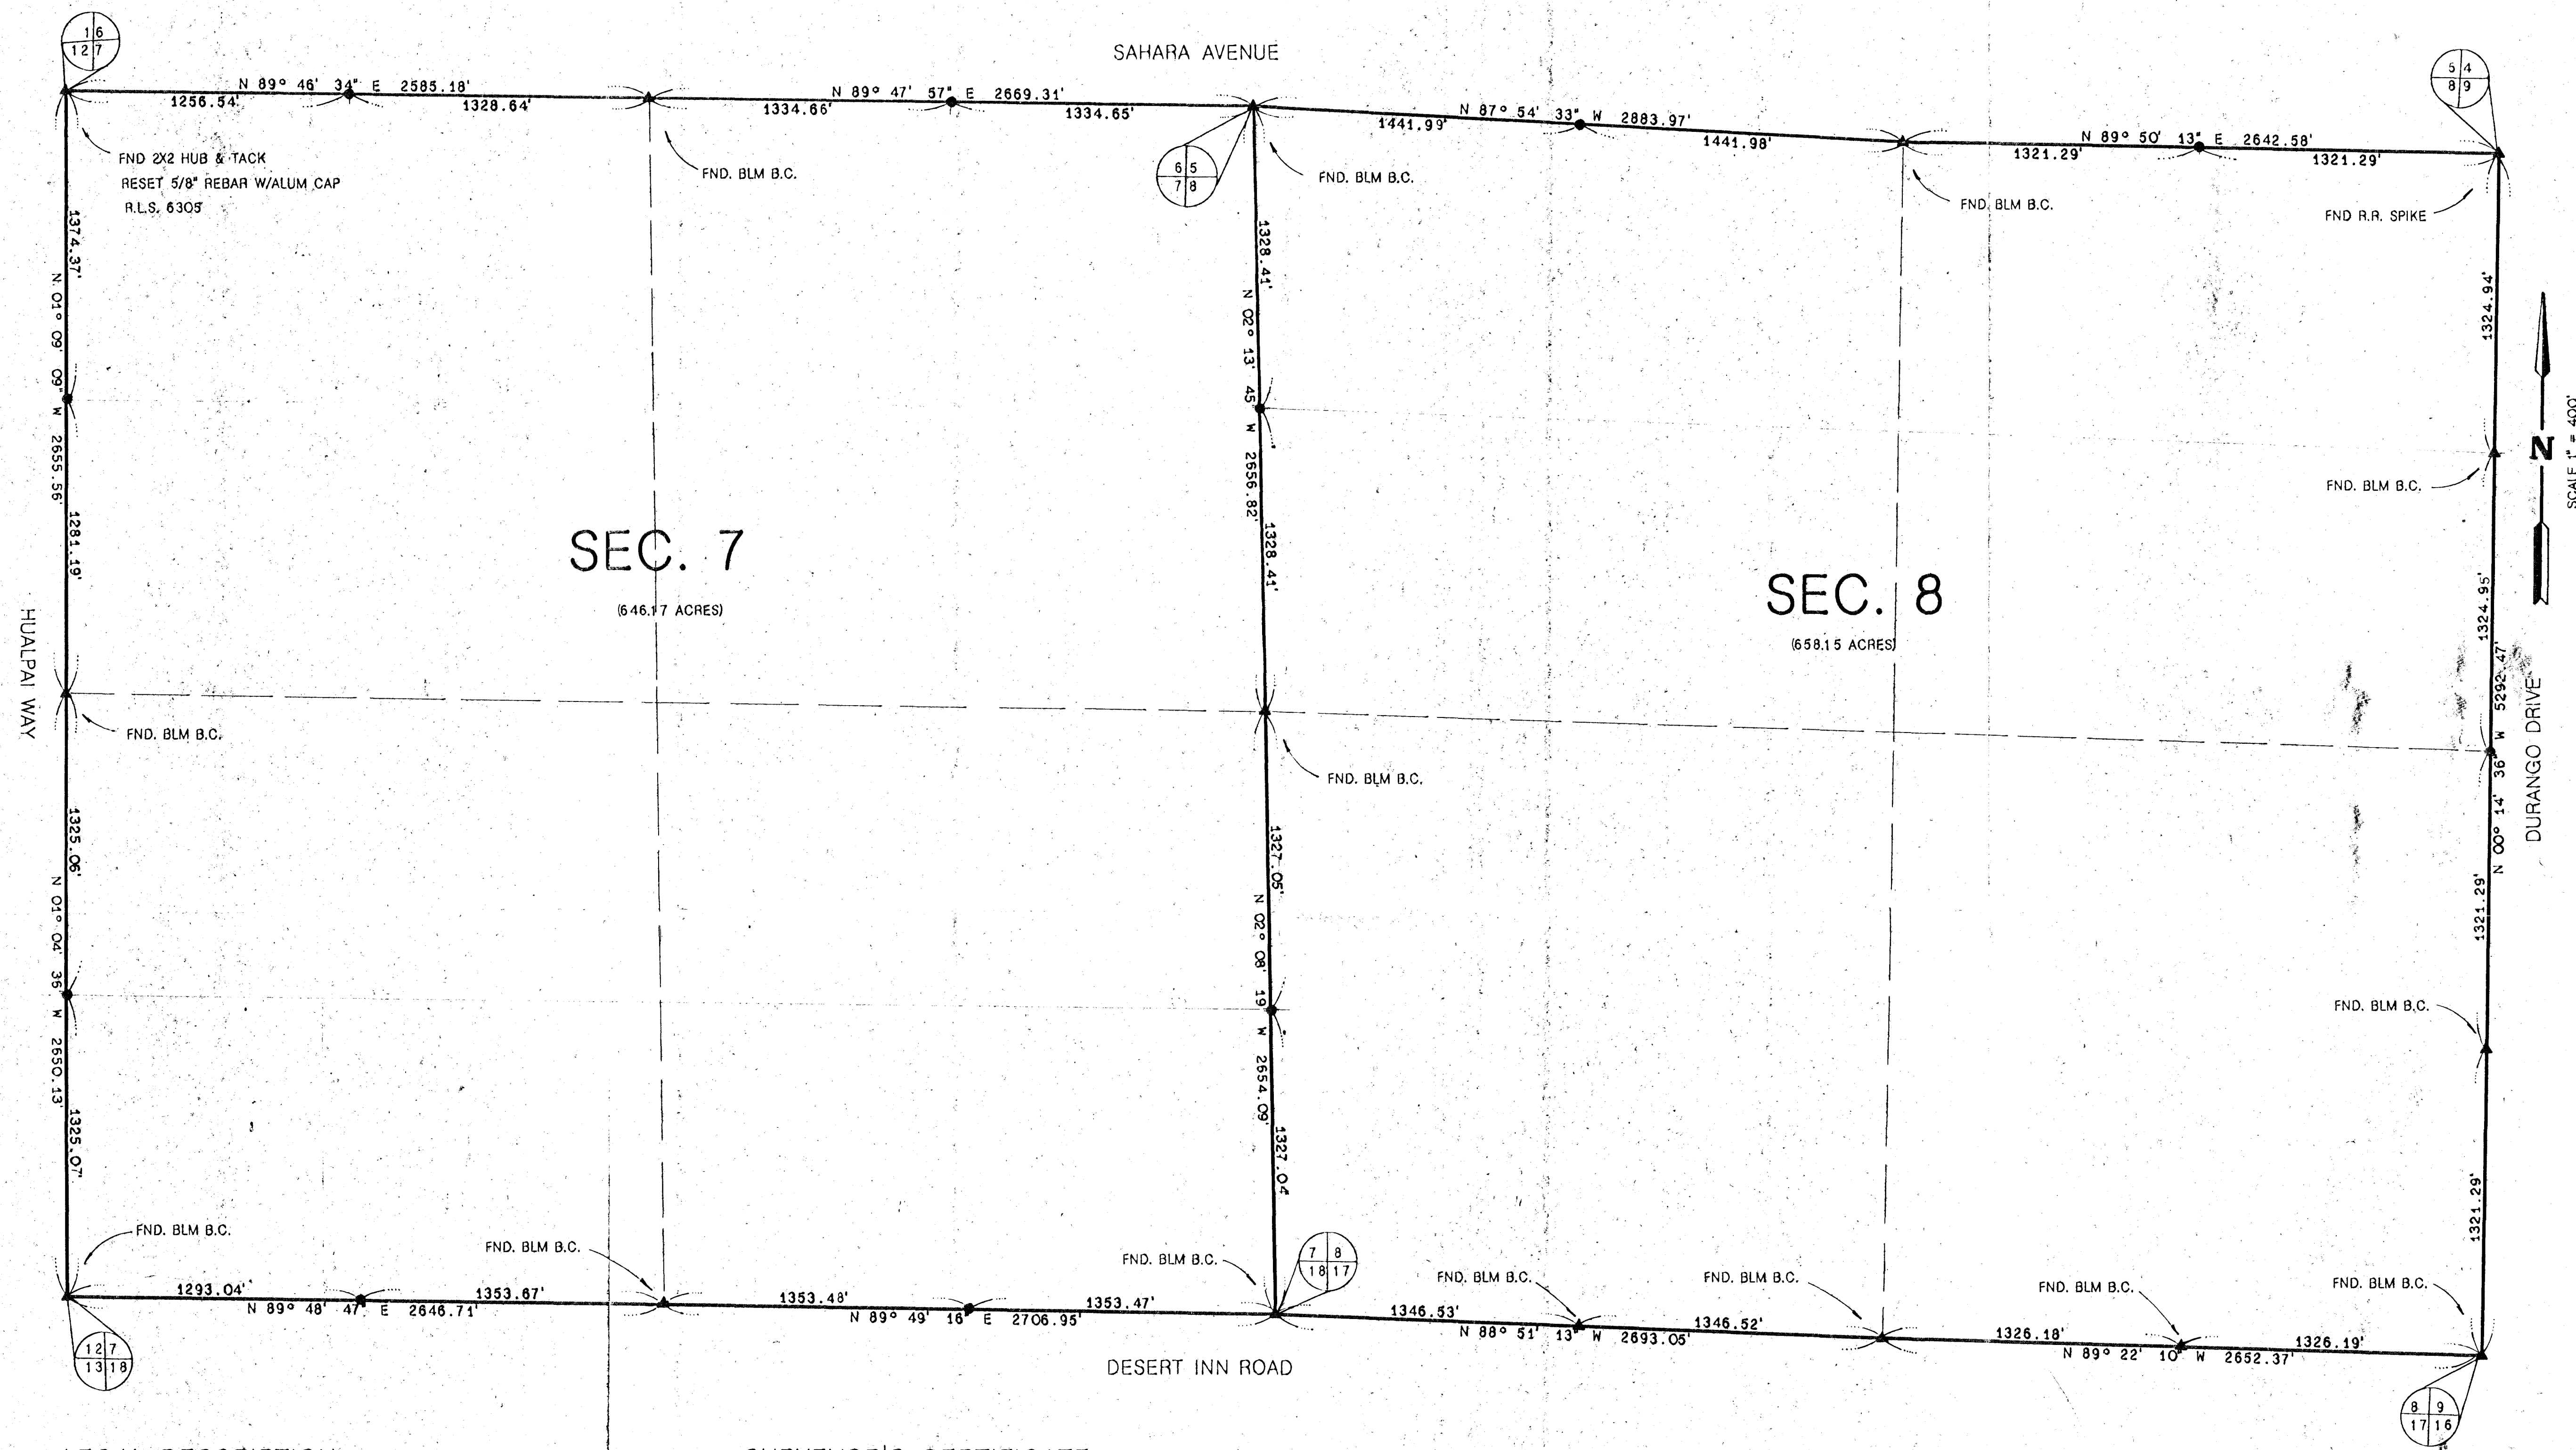

LEGAL DESCRIPTION

SECTION 7 AND SECTION 8, TOWNSHIP 21 SOUTH, RANGE 60 EAST, M.D.M., CLARK COUNTY, NEVADA.

BASIS OF BEARING

N. 89° 50' 13" E., THE SOUTH LINE OF THE SE 1/4 OF SECTION 5, T. 21 S., R. 60 E., M.D.M., AS SHOWN ON RECORD OF SURVEY IN FILE 36, PAGE 89, IN THE OFFICE OF THE COUNTY RECORDER OF CLARK COUNTY, NEVADA.

SURVEYOR'S CERTIFICATE

I, DENE E. KRAMETBAUER, A DULY REGISTERED LAND SURVEYOR IN THE STATE OF NEVADA, DO HEREBY CERTIFY THAT THIS MAP TRULY AND CORRECTLY REPRESENTS THE RESULTS OF A SURVEY MADE UNDER MY SUPERVISION AND COMPLETED ON THE 15th DAY OF FEBRUARY 1984, FOR HUSITE INC., AND WEST SAHARA INVESTMENT CO. THIS SURVEY IS NOT A SUBDIVISION AS DEFINED IN THE NEVADA REVISED STATUTES AND COMPLIES WITH THE APPLICABLE STATE STATUTES AND LOCAL ORDINANCES.

DENE E. KRAMETBAUER, R.L.S. # 6305

2/21/84
DATE

LEGEND

- ▲ FOUND AS INDICATED
- SET 5/8" REBAR WITH ALUM. CAP R.L.S. 6305

REFERENCE DATA

- DEPENDENT RESURVEY T. 21 S., R. 60 E., M.D.M., CLARK COUNTY, NEVADA, DATED JAN. 10, 1956
- RECORD OF SURVEY FILE 36, PAGE 89

ENGINEERS & SURVEYORS INCORPORATED	7022 W. CHARLESTON BLVD. LAS VEGAS, NEVADA 89117 PHONE 702 - 363 - 6415	NO. 1867009
	FILED AT THE REQUEST OF: ENGINEERS AND SURVEYORS INC. DATE 4-19-84 AT 9:22 A.M. BOOK 41 PAGE 48	
RECORD OF SURVEY		OF SURVEYS
SECTION 7 AND SECTION 8, T. 21 S., R. 60 E., M.D.M., ANNEXED TO THE CITY OF LAS VEGAS, NEVADA		OFFICIAL RECORDS BOOK NO. 1908
BY ORDINANCE NO. 3105		CLARK COUNTY, NEVADA RECORDS
		JOAN L. SWIFT, RECORDER
		FEE \$ 10.00 DUPLY NA

FILE 41 PAGE 48