


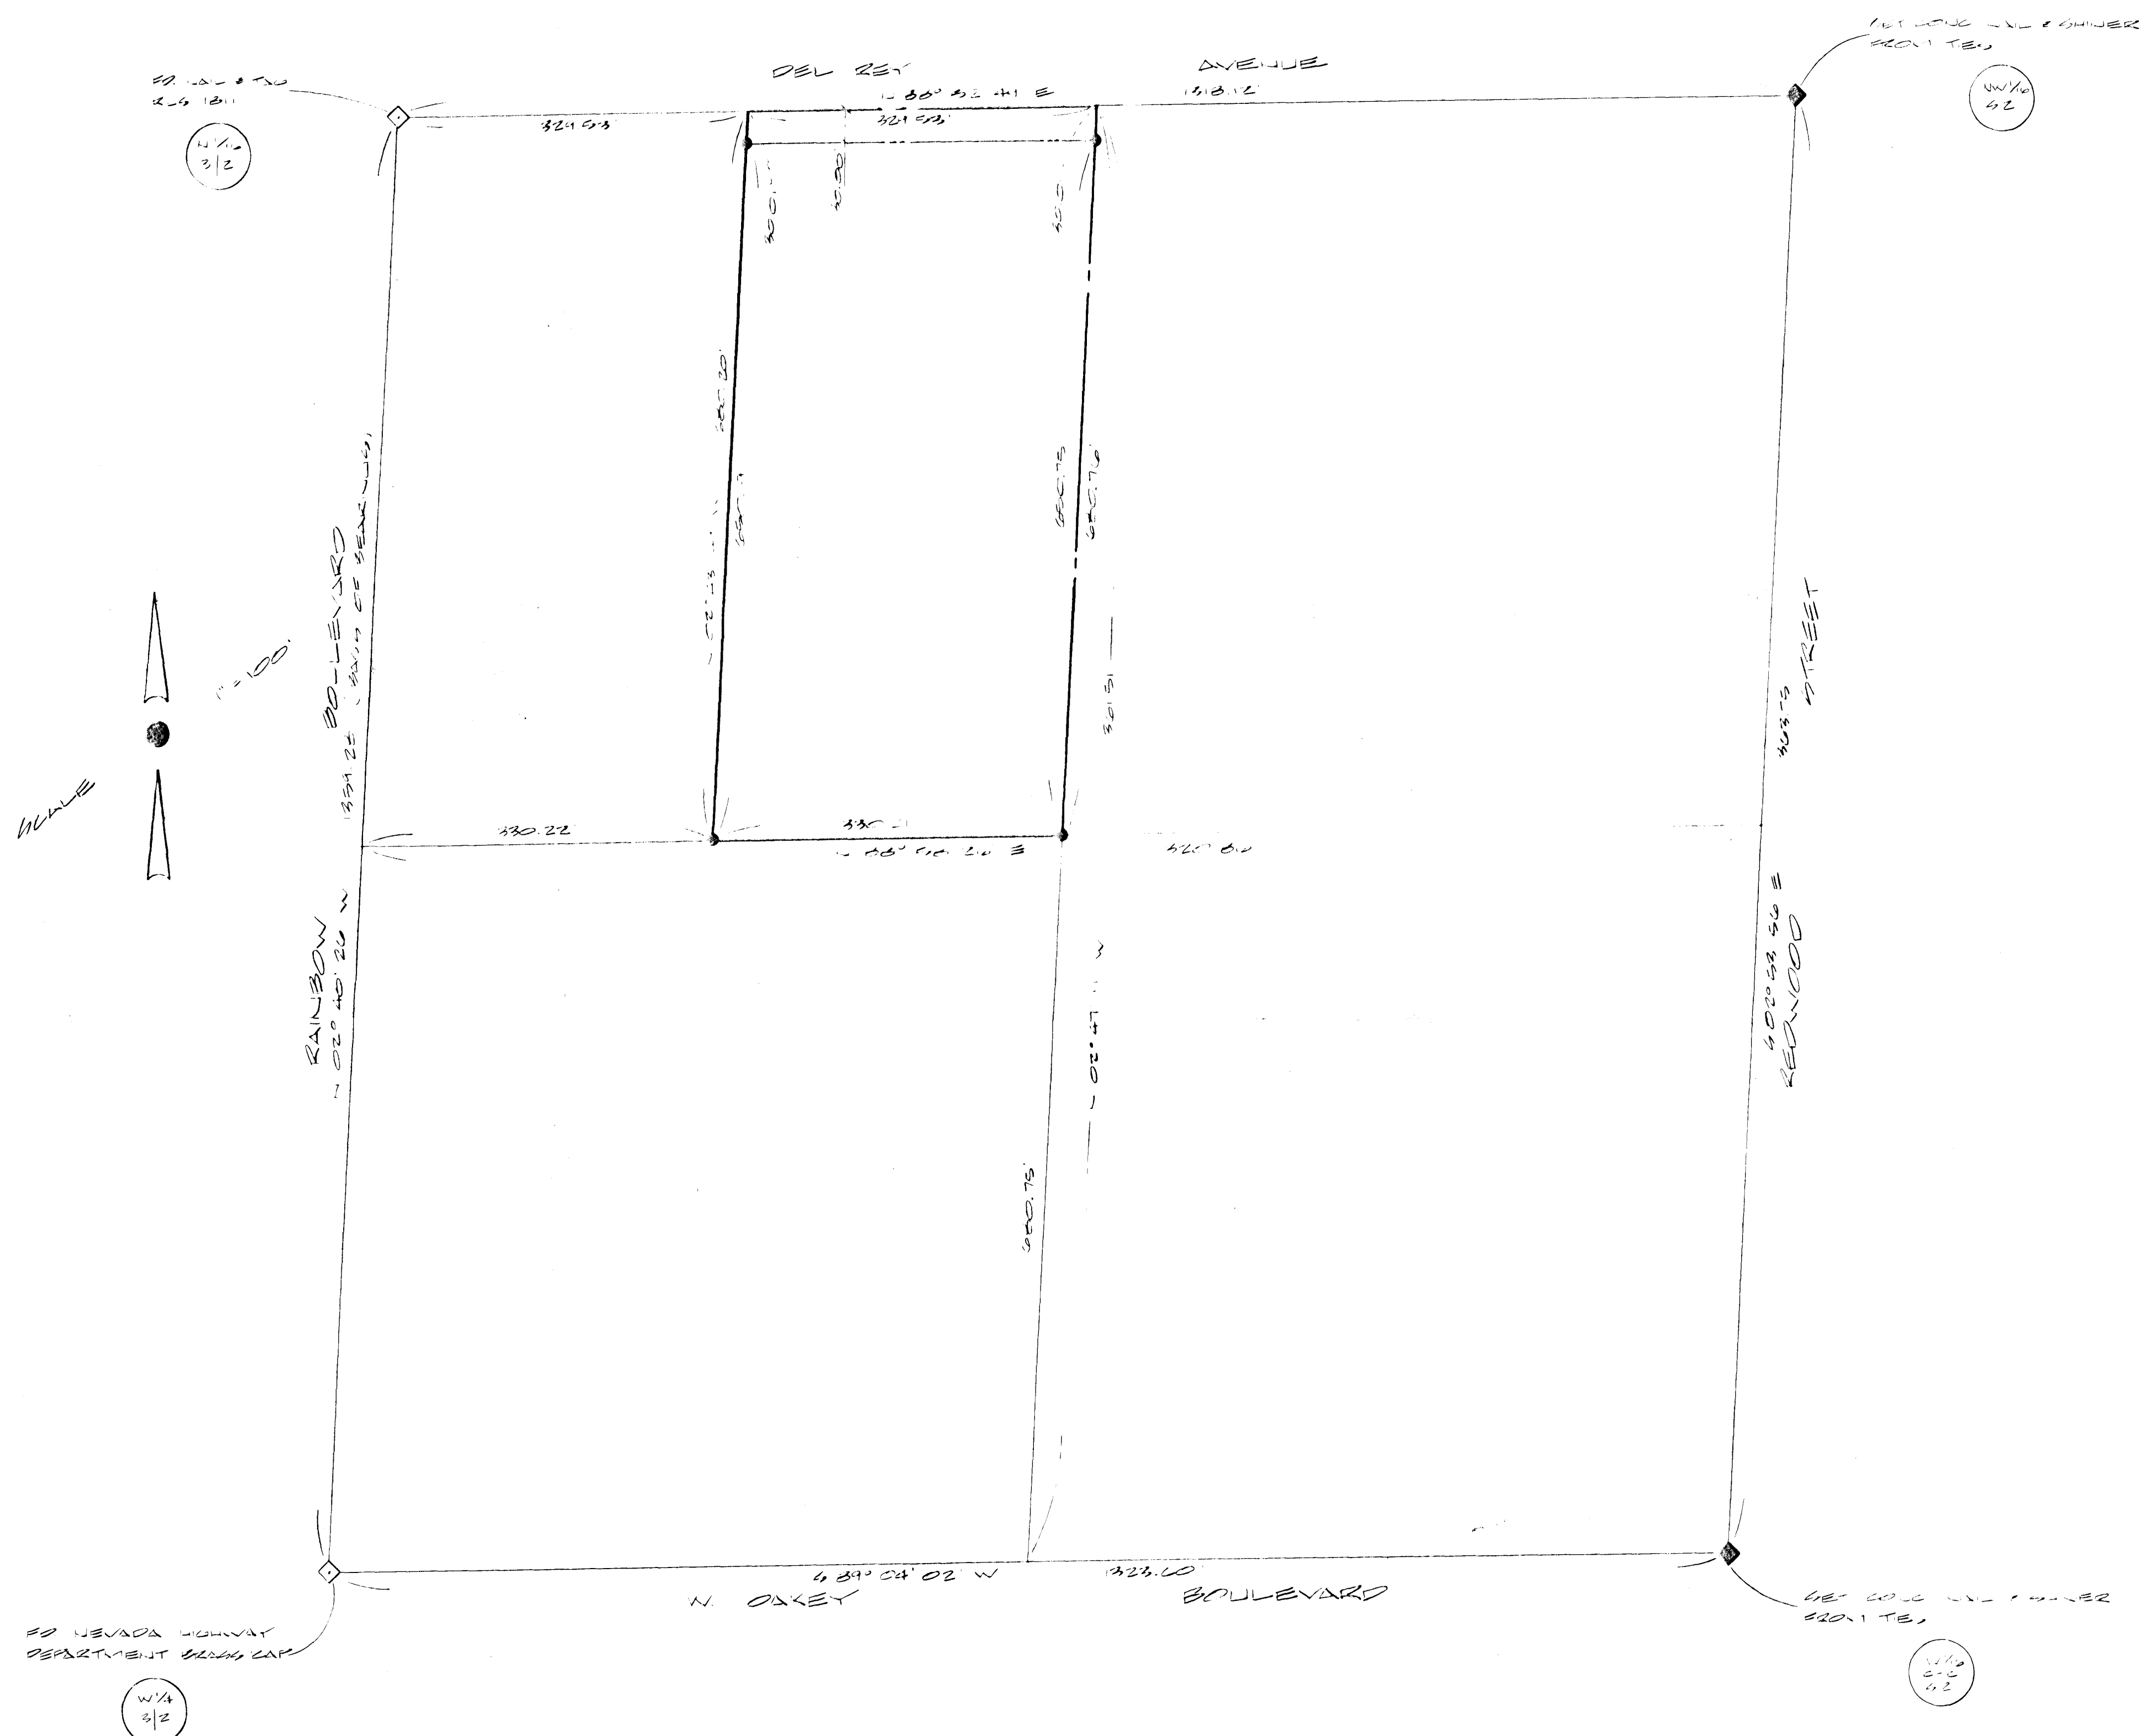

SURVEYORS CERTIFICATE

I, JERRY SLIGAR, A DULY REGISTERED LAND SURVEYOR, DO HEREBY CERTIFY THAT THIS MAP TRULY AND CORRECTLY REPRESENTS THE RESULTS OF A SURVEY MADE UNDER MY SUPERVISION AND COMPLETED ON THE 8 DAY OF AUGUST, 1983, FOR CARL JOHNS. THIS SURVEY IS NOT A SUBDIVISION AS DEFINED IN THE NEVADA REVISED STATUTES, AND COMPLIES WITH THE APPLICABLE STATE STATUTES AND LOCAL ORDINANCES.

Jerry Sligar
8-9-83

JERRY SLIGAR
REGISTERED LAND SURVEYOR
NEVADA CERTIFICATE NO. 6030

LEGAL DESCRIPTION

GOVERNMENT LOT 23 IN SECTION 2,
TOWNSHIP 21 NORTH, RANGE 40 EAST,
M.D.M. CLARK COUNTY, NEVADA

LEGEND


- ◇ SET POINTS AS NOTED
- SET 3/8" REBAR W/ ALUM. CAP JULY 1980
- ◆ SET POINTS AS NOTED

BASIS OF BEARINGS

N 02° 40' 26" W BEING THE WEST LINE OF THE NW 1/4 OF THE NW 1/4 OF SECTION 2 T21S, R40E M.D.M. AS SHOWN BY RECORD OF SURVEY ON FILE IN THE CLARK COUNTY RECORDERS OFFICE IN FILE NO. PAGE 8.

BOUNDARY SURVEY OF GOVERNMENT LOT 23 IN SECTION 2 TOWNSHIP 21 NORTH, RANGE 40 EAST, M.D.M. CLARK COUNTY, NEVADA ANNEXED TO THE CITY OF LAS VEGAS, NEV. UNDER ORDINANCE NO. 3080		NO. _____ FILED AT THE REQUEST OF ALCA ENGINEERING & SURVEYING INC. DATE _____ AT _____ FILE _____ PAGE _____ OFFICIAL RECORD BOOK NO. _____ CLARK COUNTY, NEVADA RECORDED JON L. ENST, RECORDER FEE _____ DEPUTY _____
BY JEP CHECK	SCALE 1" = 100' JOB NO. 8301-1-4	SHEET 1 OF 1


C.L.V.

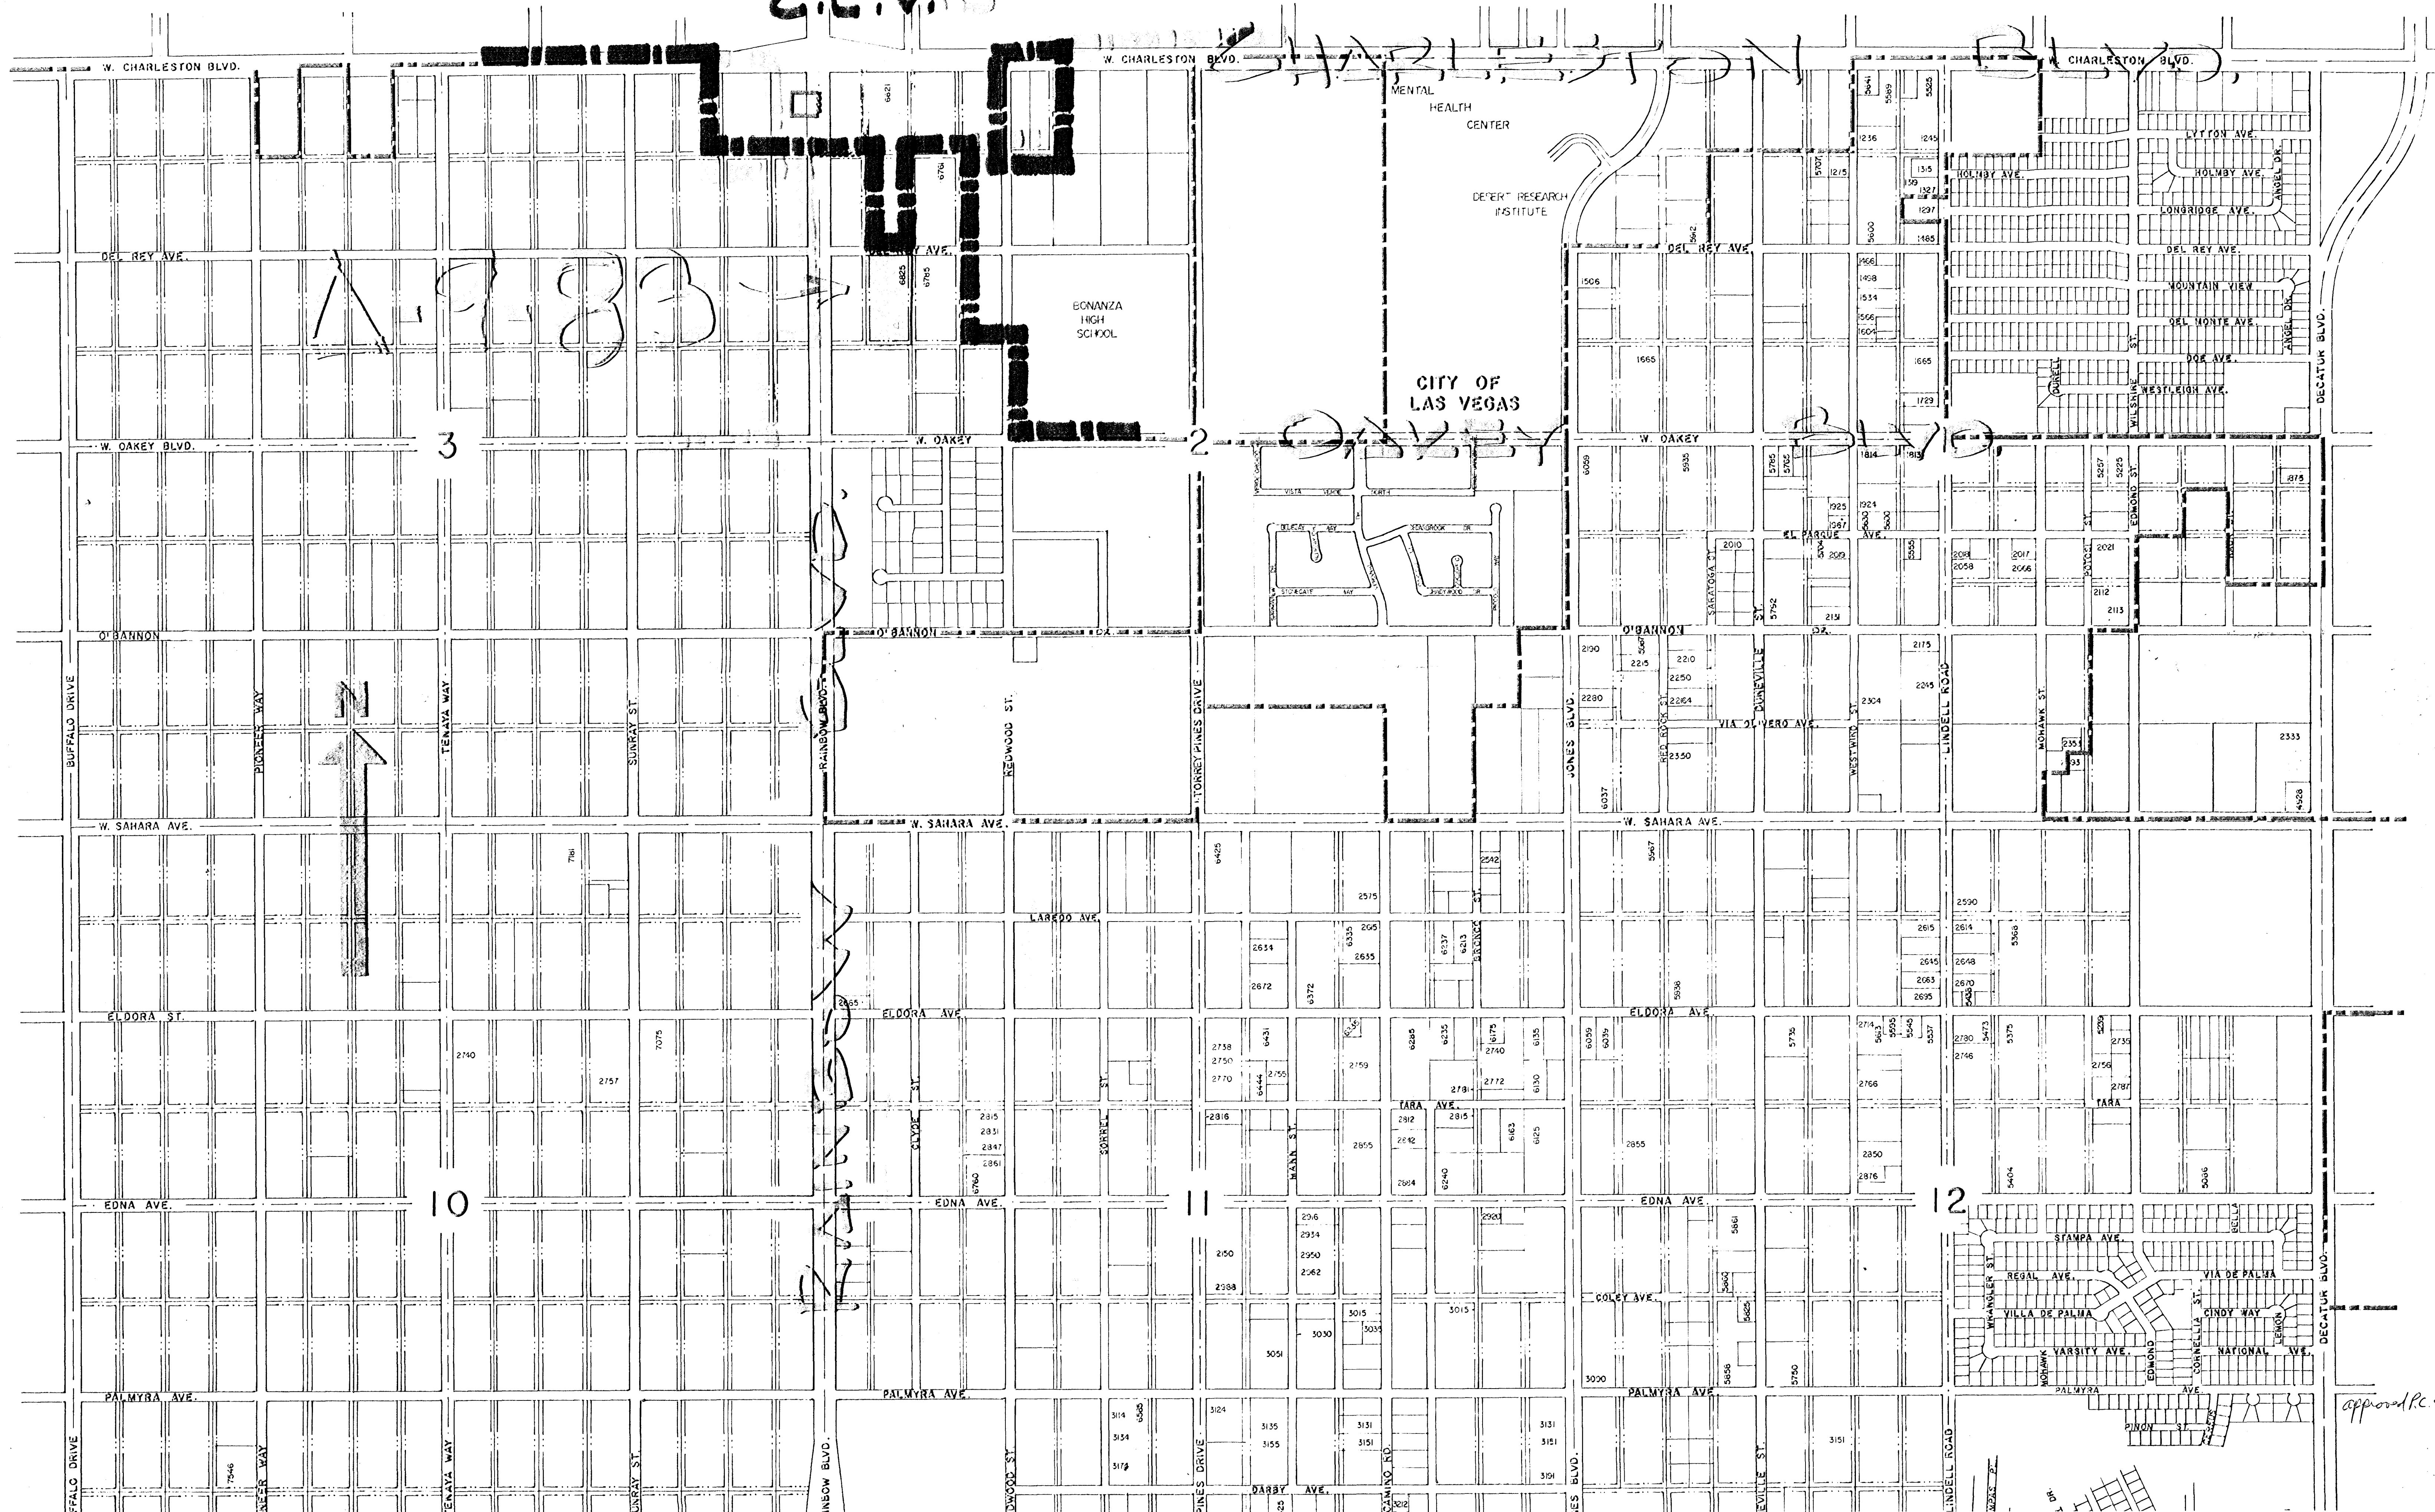

Approved R.C. 1/18/10

BOOK 1831

1790570

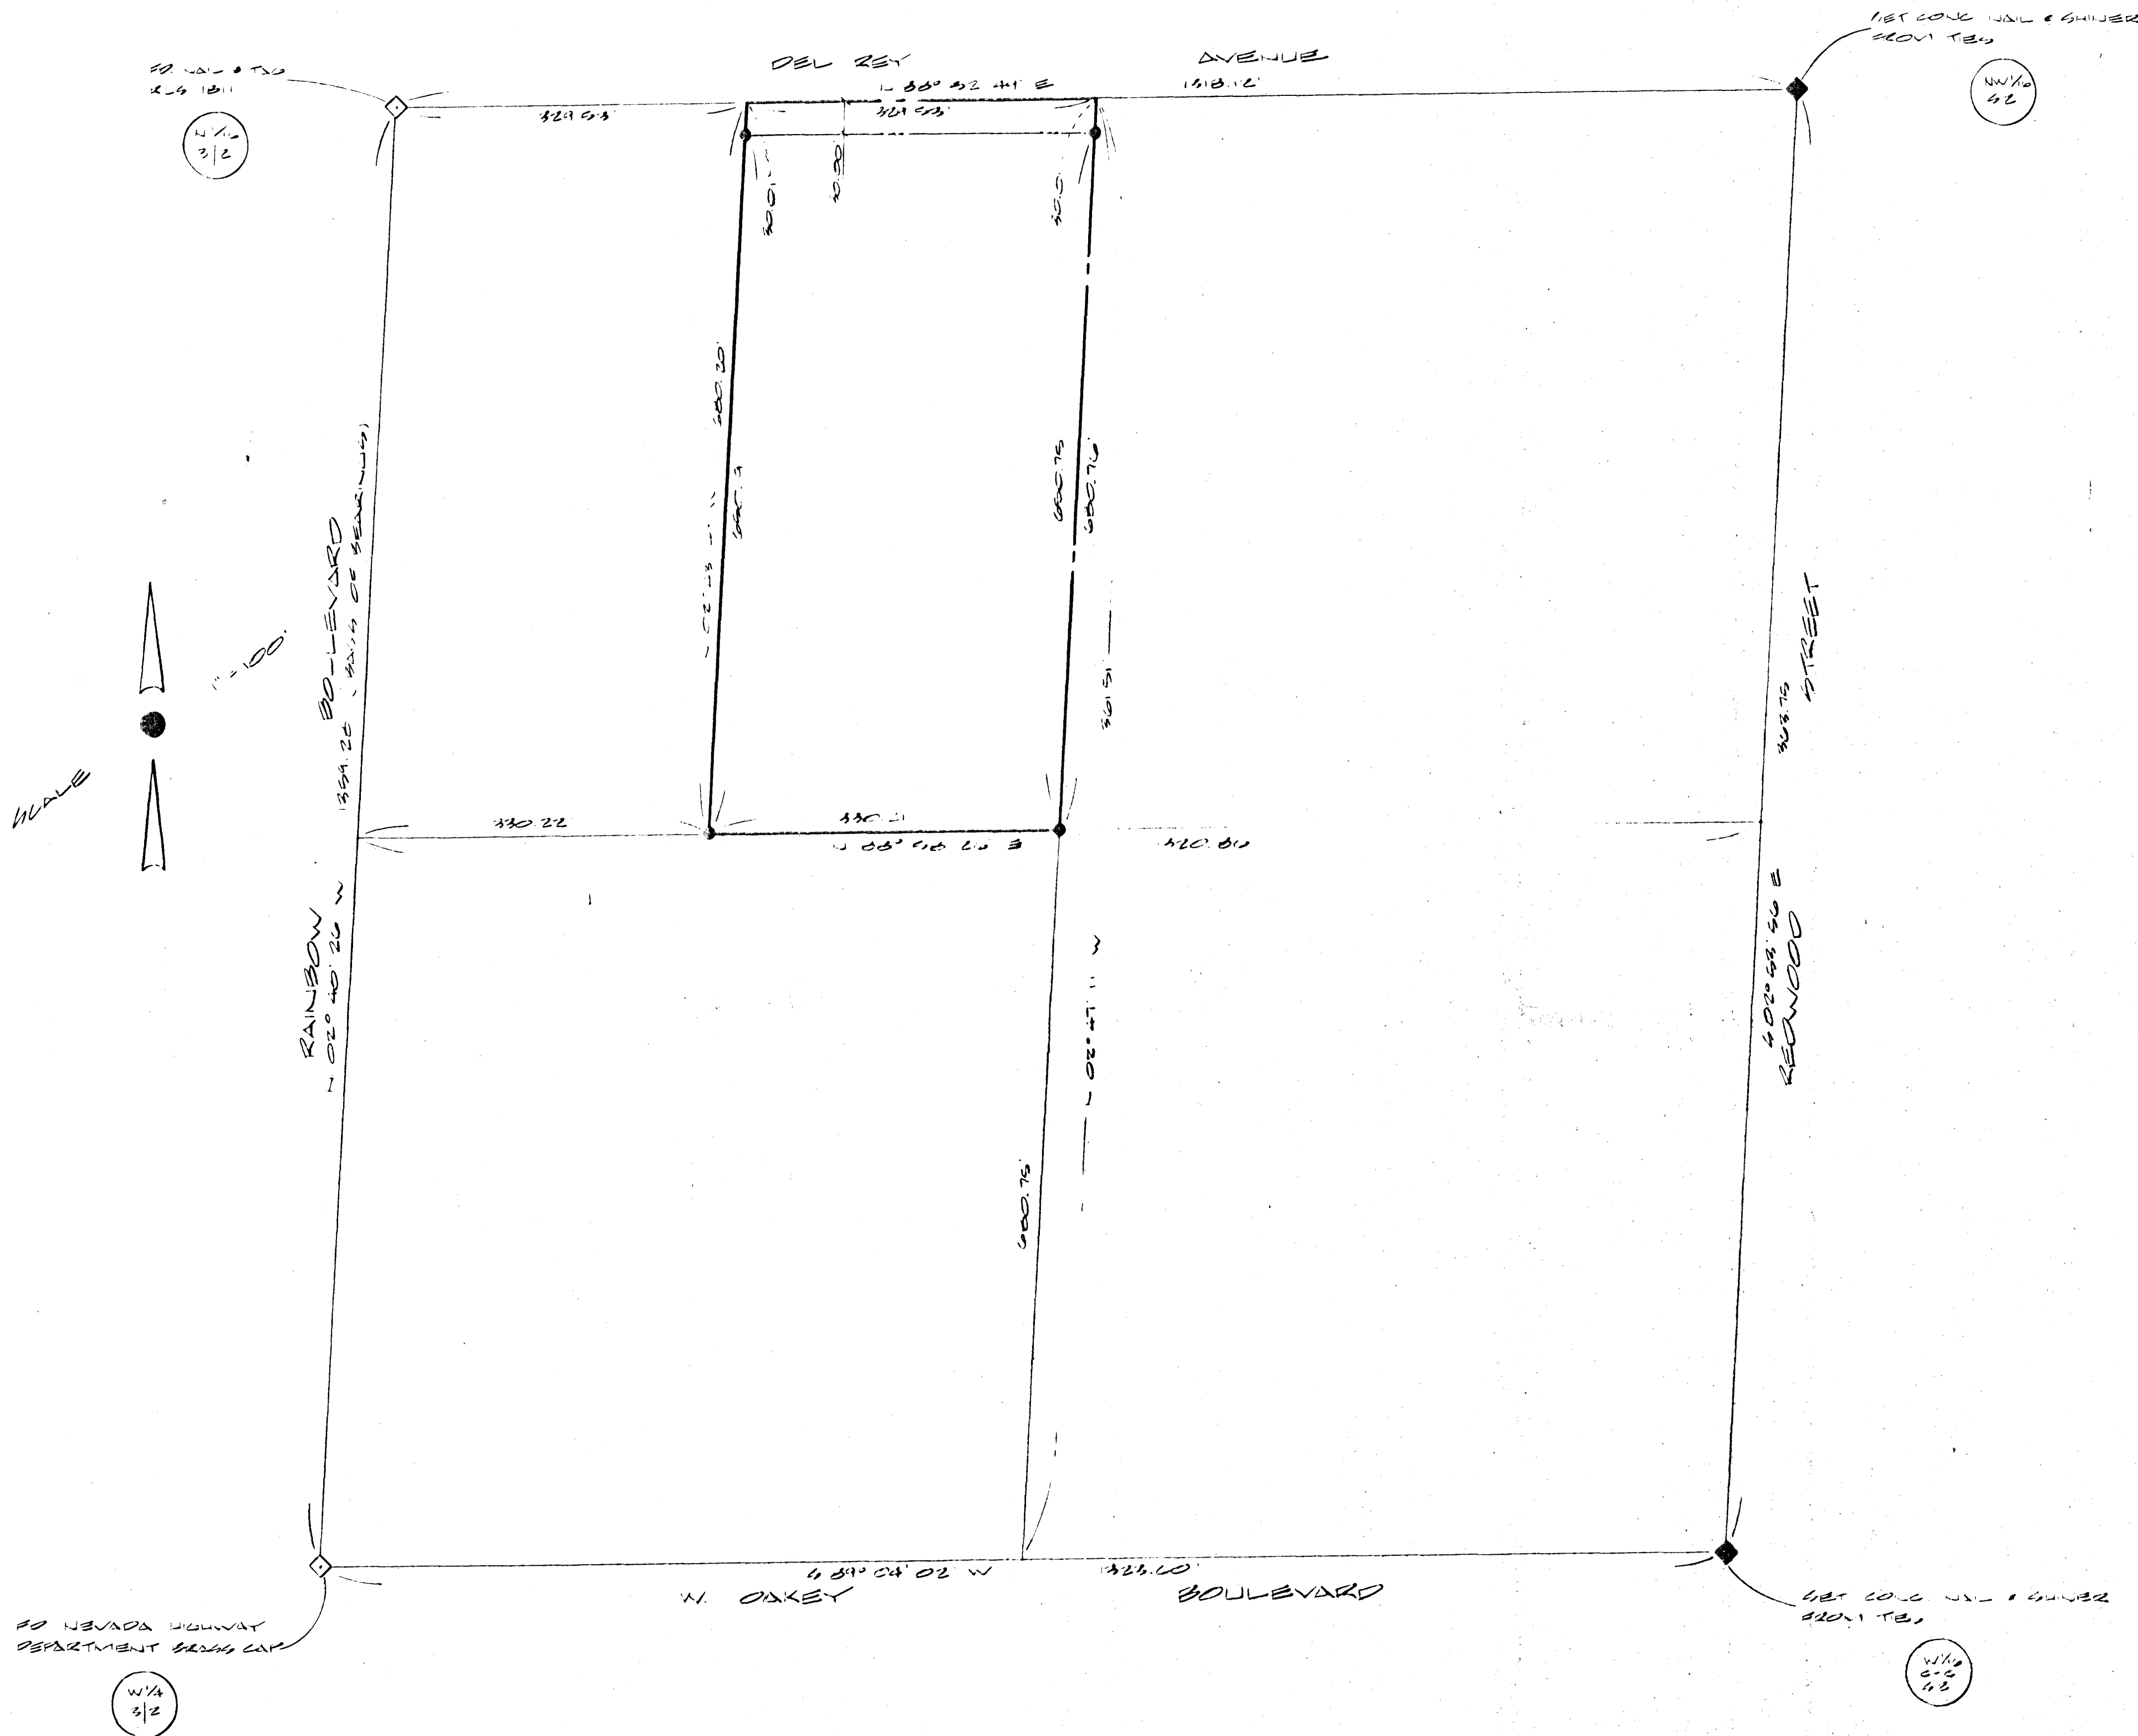

SURVEYORS CERTIFICATE

I, JERRY SLIGAR, A DULY REGISTERED LAND SURVEYOR, DO HEREBY CERTIFY THAT THIS MAP TRULY AND CORRECTLY REPRESENTS THE RESULTS OF A SURVEY MADE UNDER MY SUPERVISION AND COMPLETED ON THE 8 DAY OF AUGUST, 1983, FOR CARL JOHNS. THIS SURVEY IS NOT A SUBDIVISION AS DEFINED IN THE NEVADA REVISED STATUTES, AND COMPLIES WITH THE APPLICABLE STATE STATUTES AND LOCAL ORDINANCES.



JERRY SLIGAR
REGISTERED LAND SURVEYOR
NEVADA CERTIFICATE NO. 6030

LEGAL DESCRIPTION

CONVEYMENT LOT 23 IN SECTION 2,
TOWNSHIP 21 SOUTH, RANGE 40 EAST,
N.M.M. CLARK COUNTY, NEVADA

LEGEND

- ◆ FOUND MONUMENTS AS NOTED
- SET 3/8" CESSAR W/ ALUM. CAP
BY 6030
- ◆ SET MONUMENTS AS NOTED

BASIS OF BEARINGS

N 02° 40' 20" W BEING THE WEST LINE
OF THE NW 1/4, OF THE NW 1/4, OF SECTION 2,
T21S, R40E, N.M.M. AS SHOWN BY RECORD
OF SURVEY ON FILE IN THE CLARK COUNTY
RECORDERS' OFFICE IN FILE NO. PAGE 3.

BOUNDARY SURVEY OF CONVEYMENT LOT 23 IN SECTION 2 TOWNSHIP 21 SOUTH, RANGE 40 EAST, N.M.M. CLARK COUNTY, NEVADA ANNEXED TO THE CITY OF LAS VEGAS, NV. UNDER ORDINANCE NO. 3080		NO. 1790570 FILED AT THE REQUEST OF ALCA ENGINEERING & SURVEYING INC. DATE 11-9-83 AT 12:58 PM FILE 40 PAGE 81 OFFICIAL RECORD BOOK NO. 1831 CLARK COUNTY, NEVADA RECORDED JOAN L. WAT. RECORDER FEE 1000 DEPUTY REC'D
BY J.S.P. CHECKED	SCALE 1" = 100' JOB NO. 8301-1-4	SHEET 1 OF 1

FILE 40 PAGE 81 A-4-83(2)