


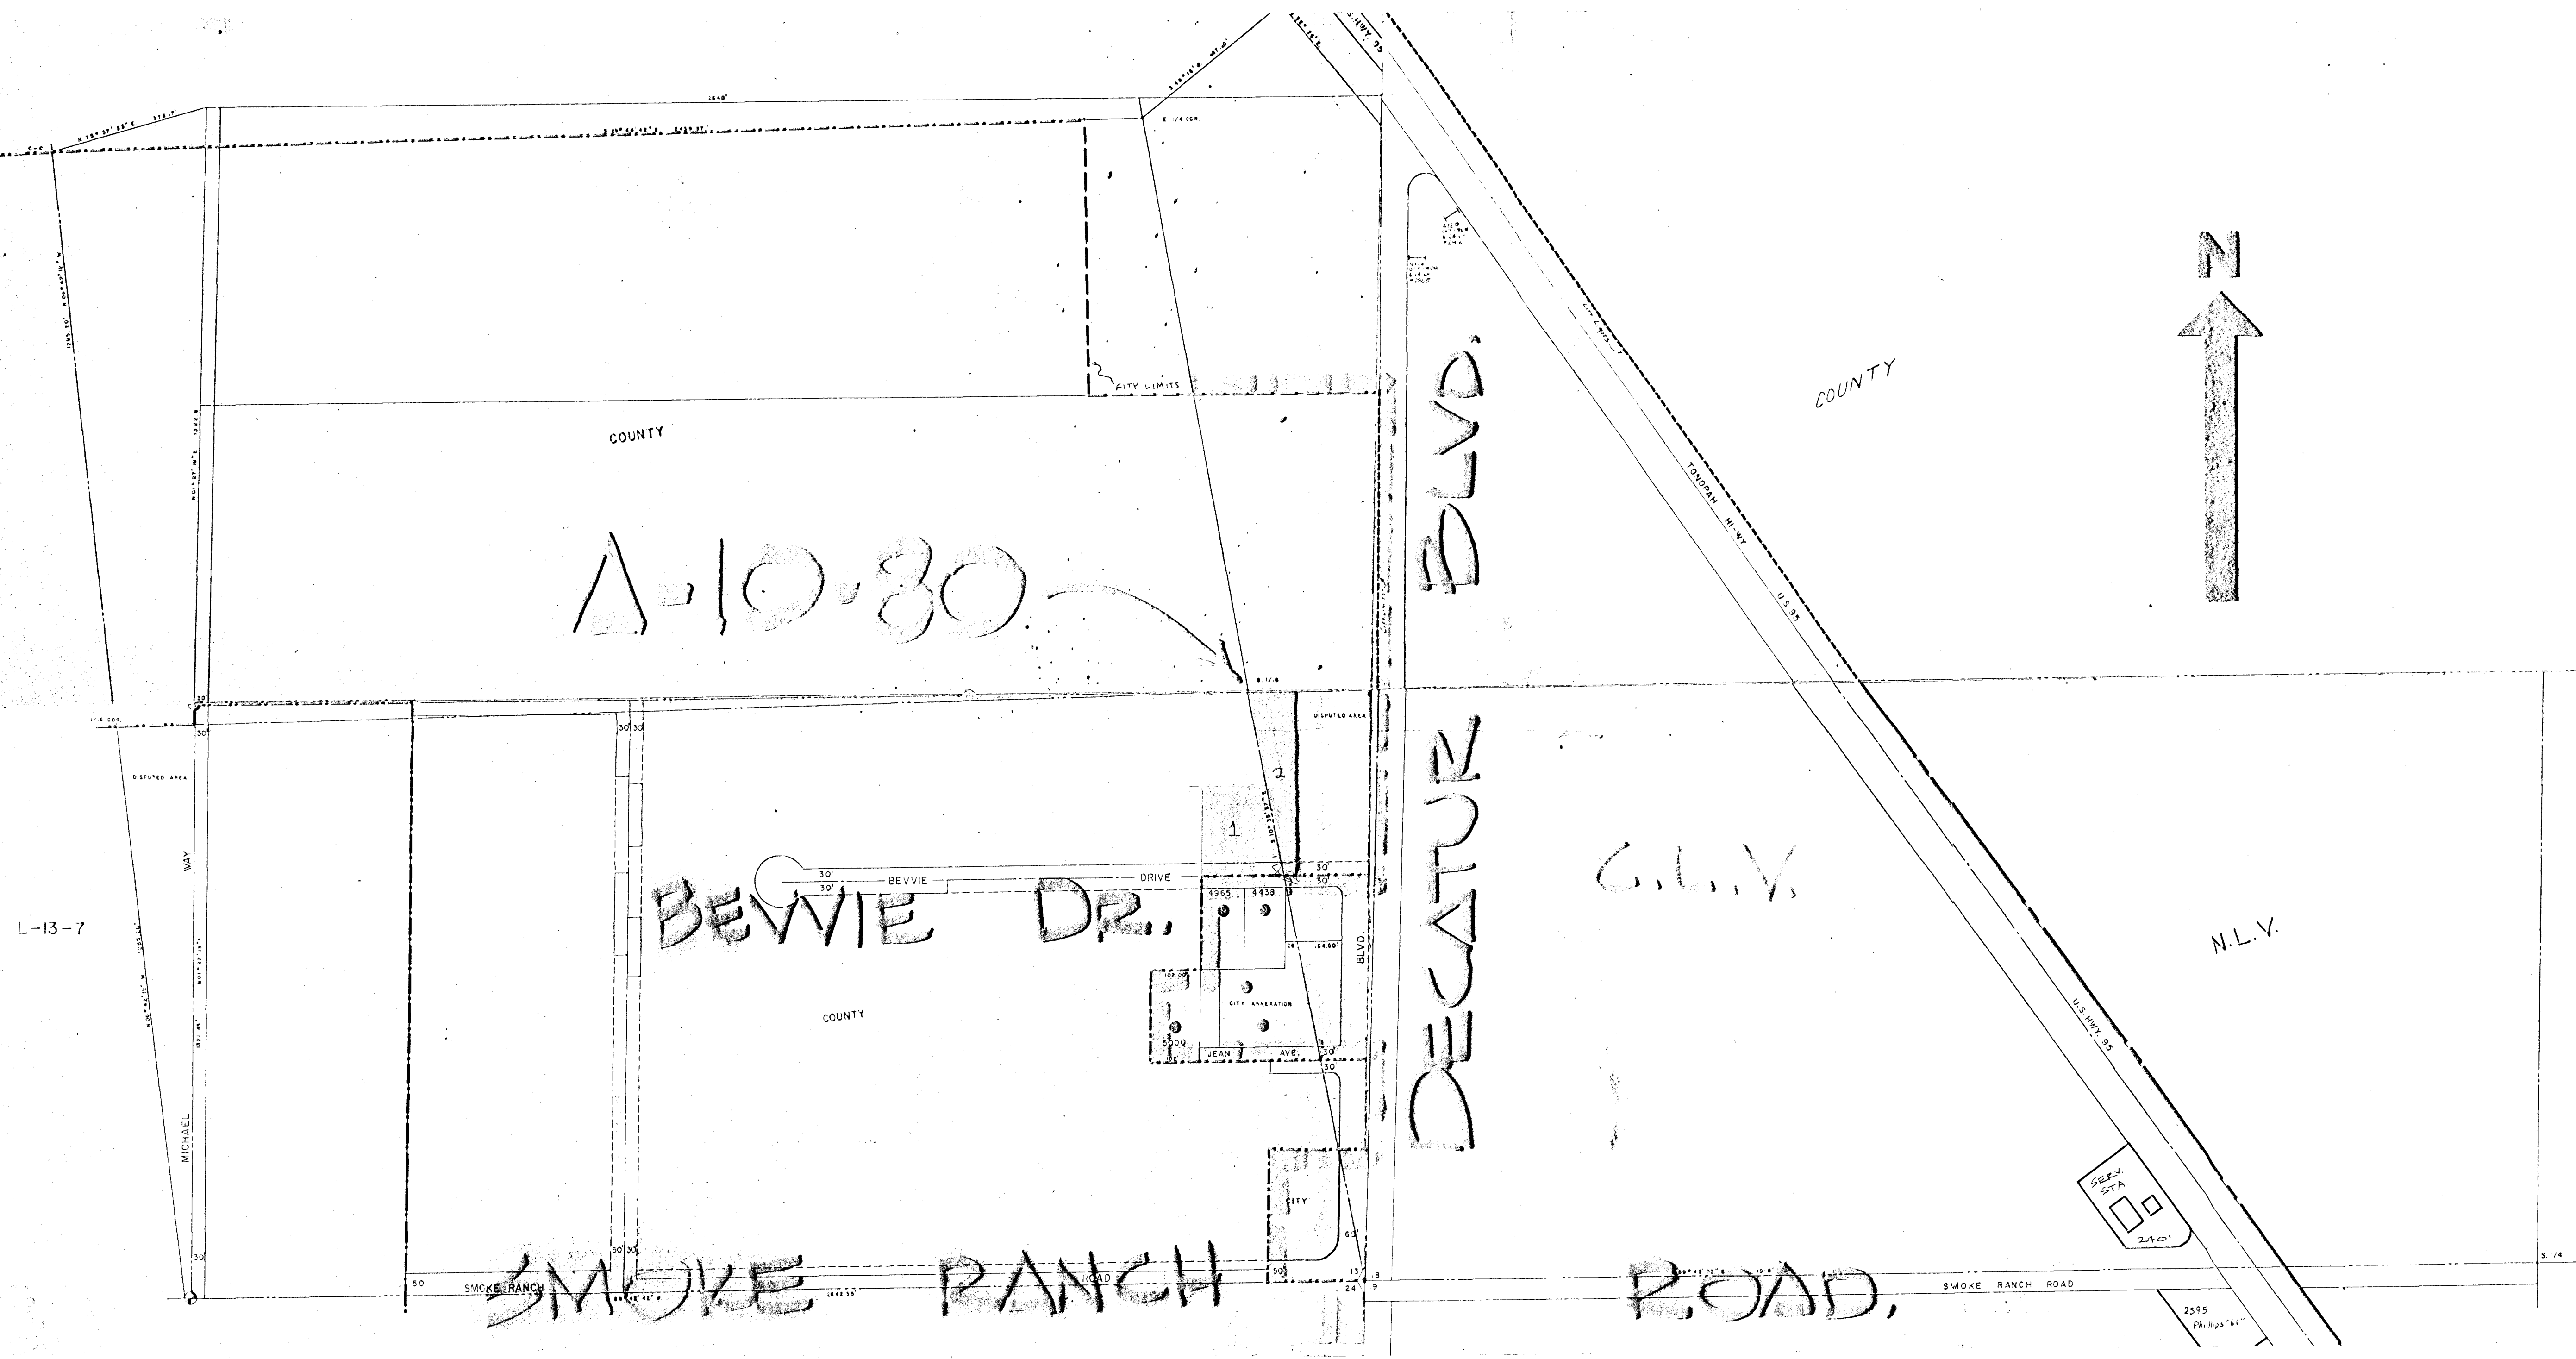

City of Las Vegas, Nevada
 Department of
 Community Planning and Development
 Don J. Saylor, A.I.P., Director

Design By:	Date:	Revised By:	Date:
Drawn By:	Date:	Revised By:	Date:
Division:		Scale:	

Sheet
 Drawing no:
 W. O. no:
 of

I, RICHARD L. HAFEN A DULY REGISTERED LAND SURVEYOR IN THE STATE OF NEVADA
ACTING AS AGENT FOR MYSELF
DO HEREBY CERTIFY THAT THE SURVEY OF THE LAND SHOWN HEREON WAS MADE
UNDER MY DIRECT SUPERVISION AT THE INSTANCE OF THE BIBLE WAY FELLOWSHIP
THE SURVEY WAS COMPLETED JUNE 26, 1980,
AND THAT THE POINTS FOUND AND SET ARE CORRECTLY SHOWN HEREON, THIS
PLAN DOES NOT CONSTITUTE A SUBDIVISION AS DEFINED BY NEVADA REVISED
STATUTES.

Richard L. Hafen
RICHARD L. HAFEN
REGISTERED LAND SURVEYOR
NEVADA CERTIFICATE NO. 4428




N 10° 55' 57" W BEING THE EAST LINE OF THE SE⁴ OF
SECTION 13, T.20S., R.60E. M.D.M. AS PER RECORD
OF SURVEY FILE 19 PAGE 28 CLARK COUNTY NEV. RECORDS-


BEING A PORTION OF SE⁴ OF SEC. 13, T. 20S., R. 60E.
M.D.B. & M. DEED 699678 AND 699679 OF BOOK 740
CLARK COUNTY, NEVADA RECORDS.

1--SET 5/8" REBAR PLASTIC CAP RLS 4428
0--POINTS FOUND AS INDICATED

FILE 19, PAGE 28 RECORD OF SURVEY

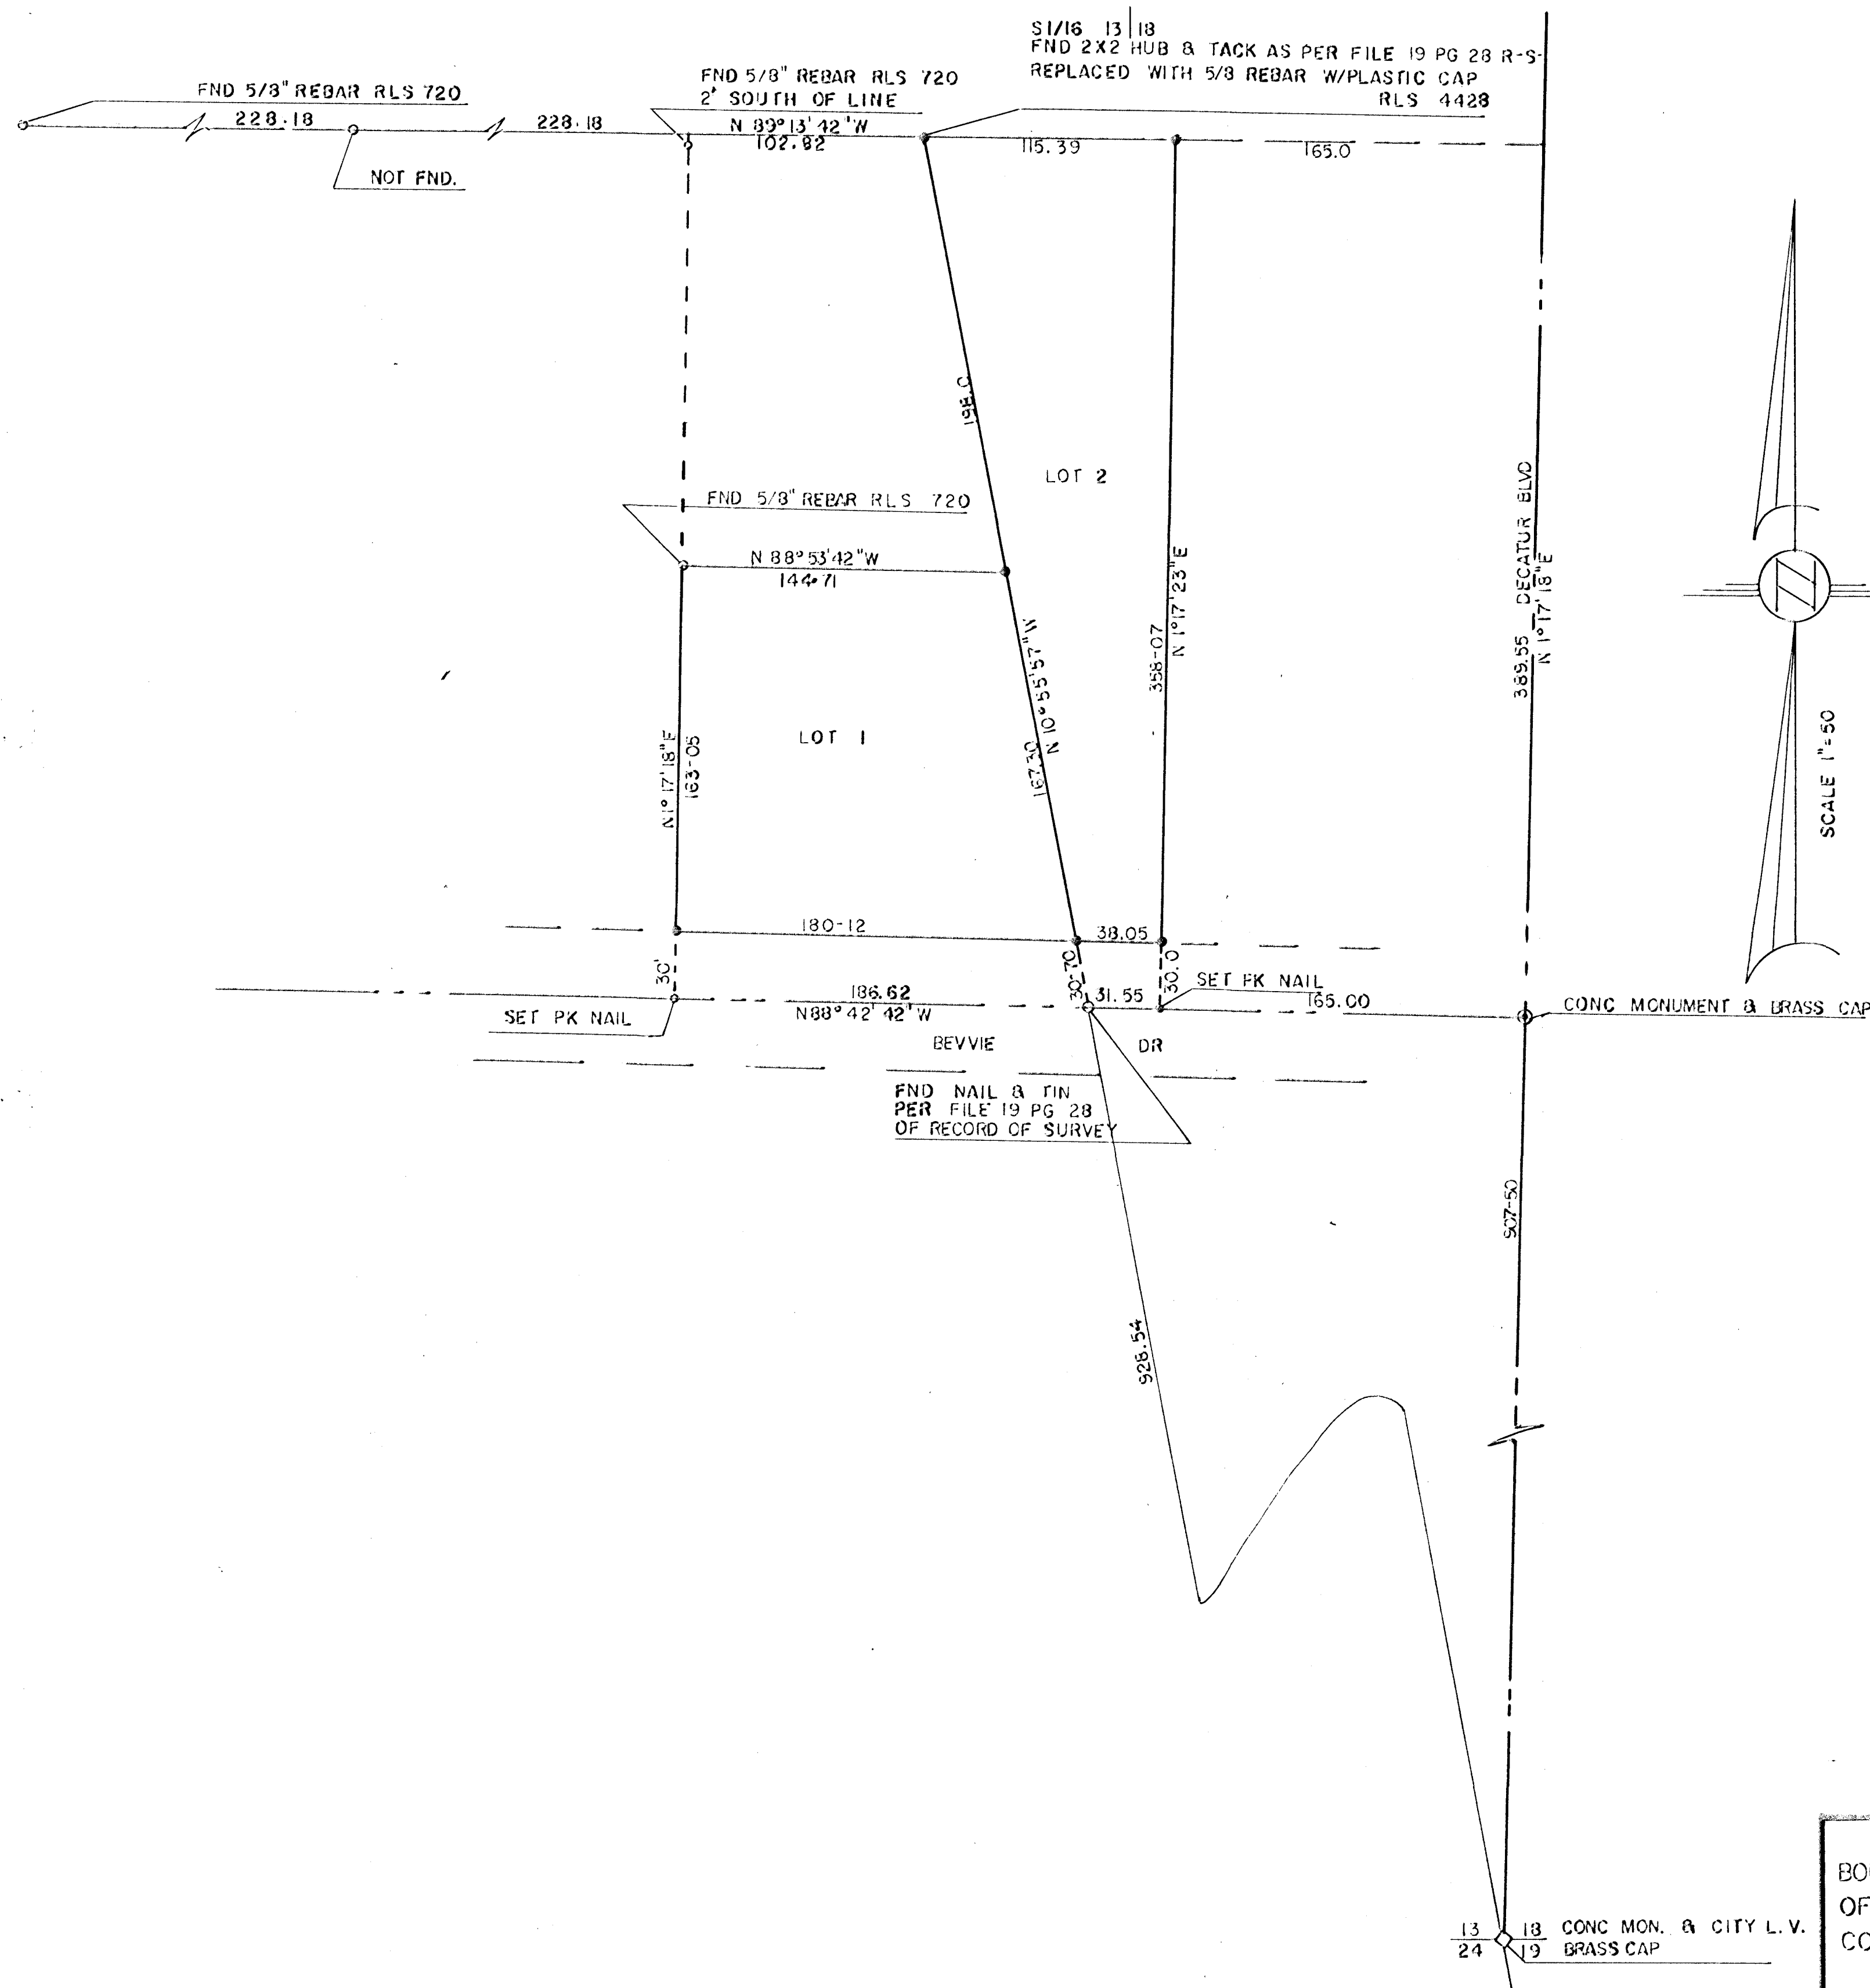

RECORD OF SURVEY BOUNDARY SURVEY OF A PORTION OF THE SE 4 OF SEC. 13, T. 20S., R. 60E. M.D.B. & M. CLARK COUNTY, NEVADA		NO. <u>1389801</u> FILED AT THE REQUEST OF THE <u>BIBLE WAY FELLOWSHIP</u> DATE <u>7-7-81</u> AT <u>11:04 A.</u> M. FILE <u>37</u> PAGE <u>67</u> OF SURVEYS OFFICIAL RECORDS BOOK NO. <u>1430</u> CLARK COUNTY, NEVADA RECORDS JOAN L. SWIFT, RECORDER FEE <u>40.00</u> DEPUTY <u>J.G.</u>
ANNEXED TO THE CITY OF LAS VEGAS, NEVADA UNDER ORDINANCE NO. <u>2167</u>	BY DH	SCALE: 1" = 50' DATE: 6-26-80

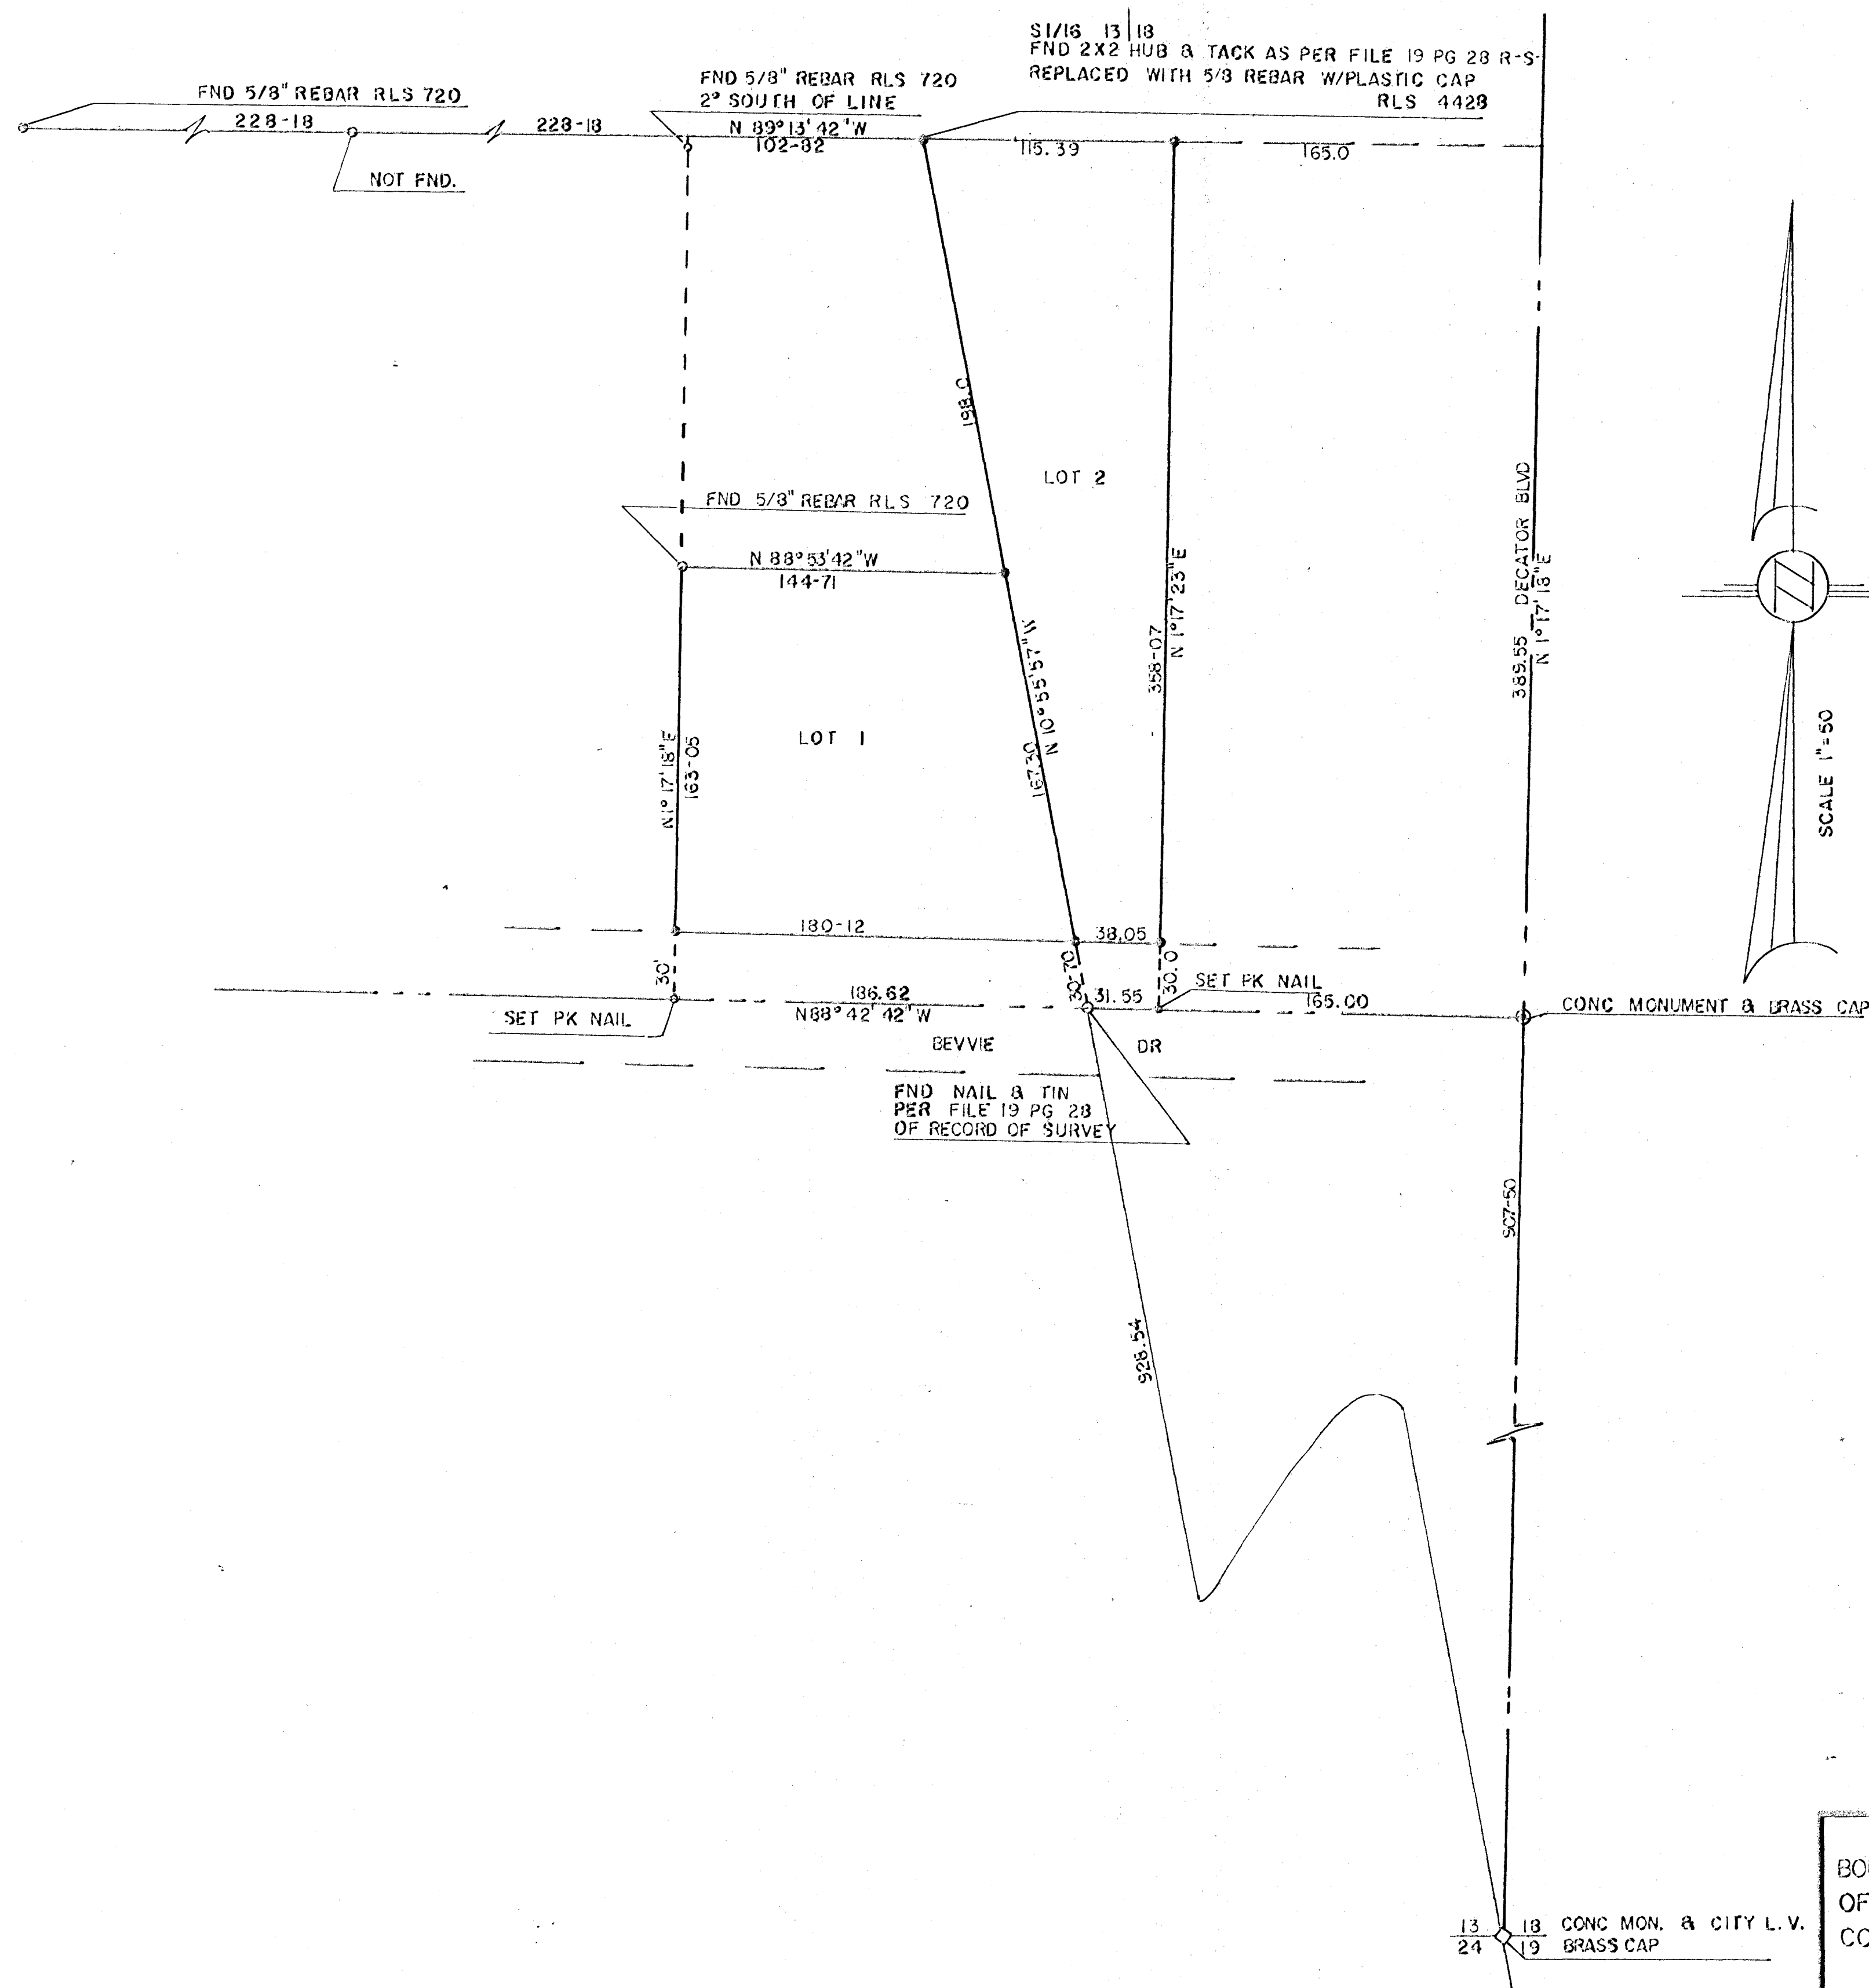


SURVEYORS CERTIFICATE

I, RICHARD L. HAFEN A DULY REGISTERED LAND SURVEYOR IN THE STATE OF NEVADA ACTING AS AGENT FOR MYSELF DO HEREBY CERTIFY THAT THE SURVEY OF THE LAND SHOWN HEREON WAS MADE UNDER MY DIRECT SUPERVISION AT THE INSTANCE OF THE BIBLE WAY FELLOWSHIP. THE SURVEY WAS COMPLETED JUNE 26, 1980, AND THAT THE POINTS FOUND AND SET ARE CORRECTLY SHOWN HEREON, THIS PLAT DOES NOT CONSTITUTE A SUBDIVISION AS DEFINED BY NEVADA REVISED STATUTES.

Richard L. Hafen
RICHARD L. HAFEN
REGISTERED LAND SURVEYOR
NEVADA CERTIFICATE NO. 4428

6/26/80
DATE

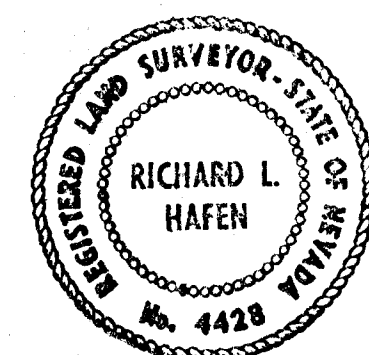

BASIS OF BEARING

N 10° 55' 57" W BEING THE EAST LINE OF THE SE 4 OF SECTION 13, T. 20S., R. 60E. M.D.M. AS PER RECORD OF SURVEY FILE 19 PAGE 28 CLARK COUNTY NEV. RECORDS.

LEGAL DESCRIPTION

BEING A PORTION OF SE 4 OF SEC. 13, T. 20S., R. 60E. M.D.B. & M. DEED 692678 AND 692679 OF BOOK 740 CLARK COUNTY, NEVADA RECORDS.

LEGEND

• SET 5/8" REBAR PLASTIC CAP RLS 4428
○ POINTS FOUND AS INDICATED

REFERENCE SURVEY

FILE 19, PAGE 28 RECORD OF SURVEY

RECORD OF SURVEY BOUNDARY SURVEY OF A PORTION OF THE SE 4 OF SEC. 13, T. 20S., R. 60E. M.D.B. & M. CLARK COUNTY, NEVADA		NO. FILED AT THE REQUEST OF
ANNEXED TO THE CITY OF LAS VEGAS, NEVADA UNDER ORDINANCE NO.		DATE AT .M. FILE PAGE OF SURVEYS OFFICIAL RECORDS BOOK NO.
BY: DH	SCALE: 1" = 50'	DATE: 6-26-80 FEE DEPUTY

A-108001
JUN 28 1980