
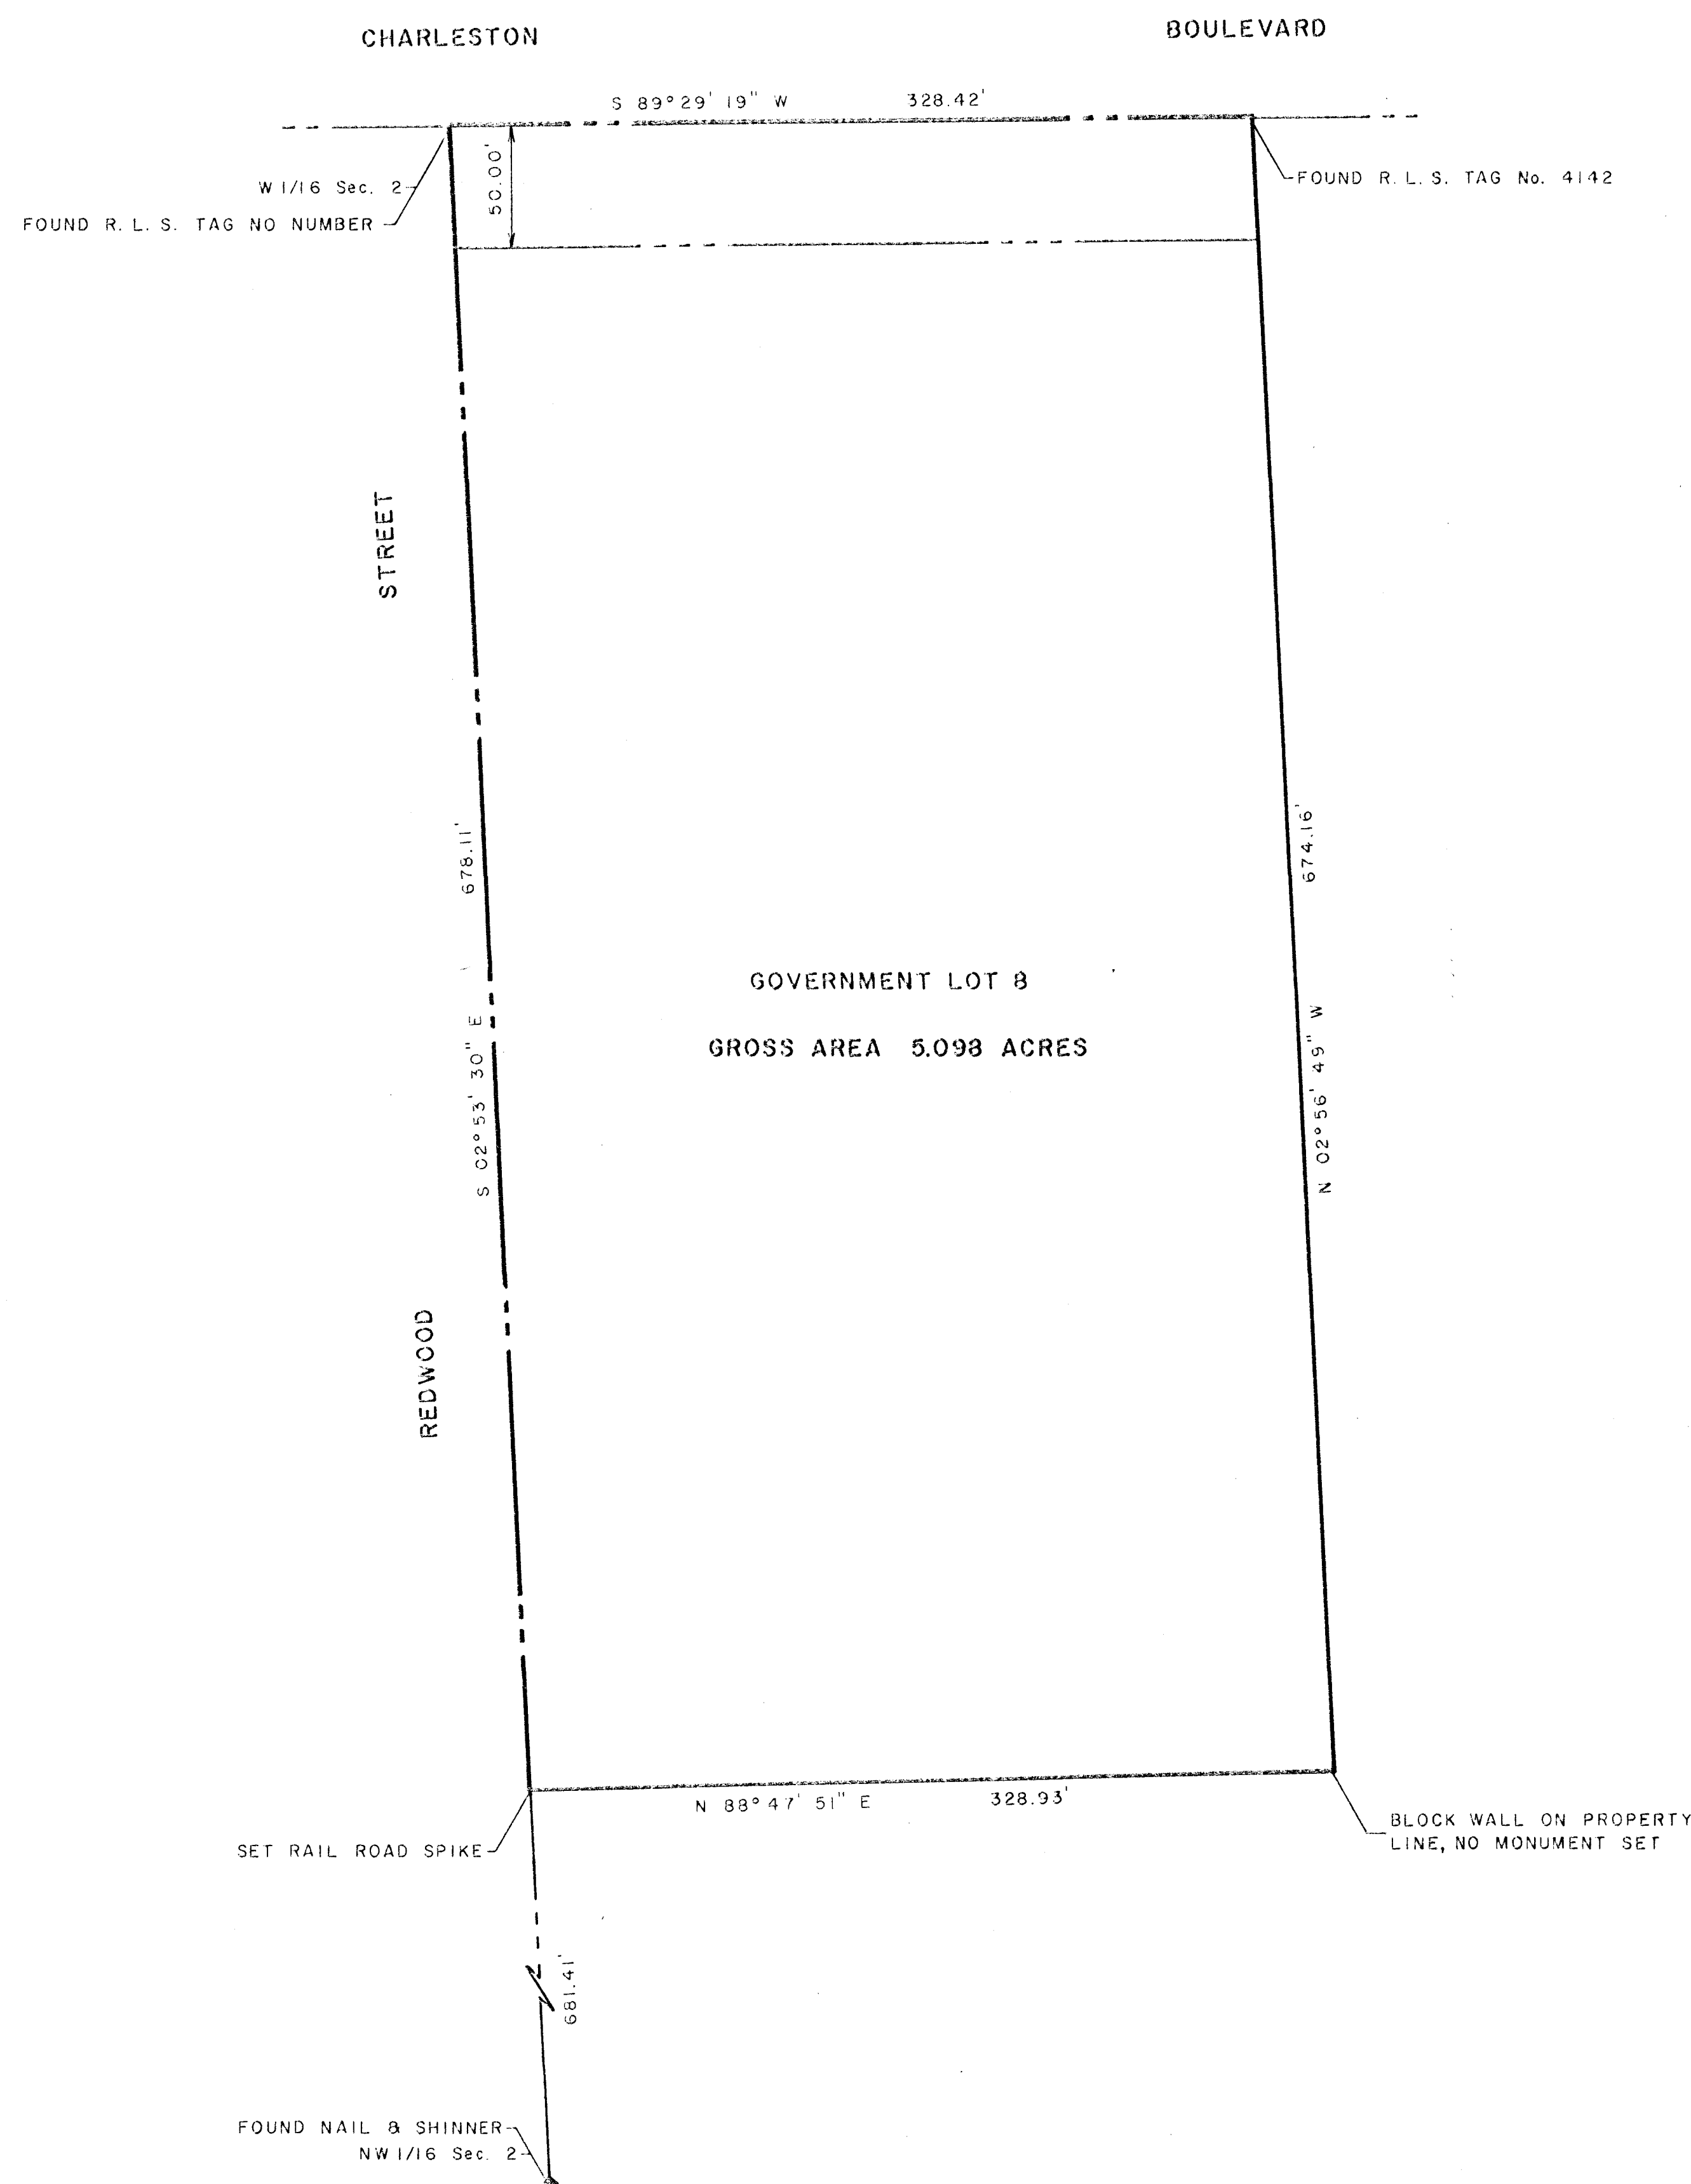


SURVEYOR'S CERTIFICATE

I, CARL D. PETERSON, A DULY REGISTERED LAND SURVEYOR, DO HEREBY CERTIFY THAT THIS MAP TRULY AND CORRECTLY REPRESENTS THE RESULTS OF A SURVEY MADE UNDER MY SUPERVISION AND COMPLETED ON THE 3RD DAY OF JULY, 1984, FOR THE CITY OF LAS VEGAS, NEVADA. THIS SURVEY IS NOT A SUBDIVISION AS DEFINED IN THE NEVADA REVISED STATUTES, AND COMPLIES WITH THE APPLICABLE STATE STATUTES AND LOCAL ORDINANCES.

Carl D. Peterson
CARL D. PETERSON
R. L. S. No. 6734

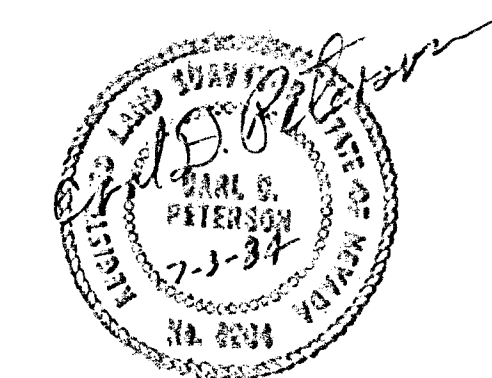

BASIS OF BEARING

NORTH 89° 29' 19" EAST - THE NORTH LINE OF SECTION 2, TOWNSHIP 21 SOUTH, RANGE 60 EAST, M.D.M., AS SHOWN ON RECORD OF SURVEY IN FILE 33, PAGE 85 IN THE OFFICE OF THE COUNTY RECORDER OF CLARK COUNTY, NEVADA.

LEGAL DESCRIPTION

GOVERNMENT LOT 8 IN SECTION 2, TOWNSHIP 21 SOUTH, RANGE 60 EAST, M.D.M., IN THE COUNTY OF CLARK, STATE OF NEVADA.

BOUNDARY SURVEY OF
GOVERNMENT LOT 8 IN SECTION 2,
TOWNSHIP 20 SOUTH, RANGE 60 EAST, M. D. M.
ANNEXED TO THE CITY OF LAS VEGAS, NEVADA
UNDER ORDINANCE NO. 3136

NO. 1947570
FILED AT THE REQUEST OF
CITY OF LAS VEGAS
DATE 7-11-84 AT 2:14 P.M.
FILE 42 PAGE 8
OF SURVEYS
OFFICIAL RECORDS BOOK NO. 1988
CLARK COUNTY NEVADA, RECORDS
JOAN SWIFT
RECORDER
FEE D.H.
DEPUTY CAR

1-10-84

CHARLESTON

BLVD.

