




SURVEYOR'S CERTIFICATE
I, ROBERT FULSTONE, REGISTERED LAND SURVEYOR IN THE STATE OF NEVADA AS AGENT FOR FULSTONE ENTERPRISES DO HEREBY CERTIFY THAT THIS MAP IS A TRUE AND CORRECT FLAT OF THE LAND SURVEYED BE ME OR UNDER MY DIRECTION AT THE INSTANCE OF C.D.S. DEVELOPMENT OF CALIFORNIA, INC.
AND WAS COMPLETED ON THIS 25TH DAY OF APRIL 1984
THIS SURVEY IS NOT A SUBDIVISION AS DEFINED BY NEVADA STATE LAW, AND IS NOT IN CONFLICT WITH THE REQUIREMENTS OF NRS 278.010 TO 278.030 INCLUSIVE.
Robert Fulstone 4/25/84
ROBERT FULSTONE RLS 5269 DATE

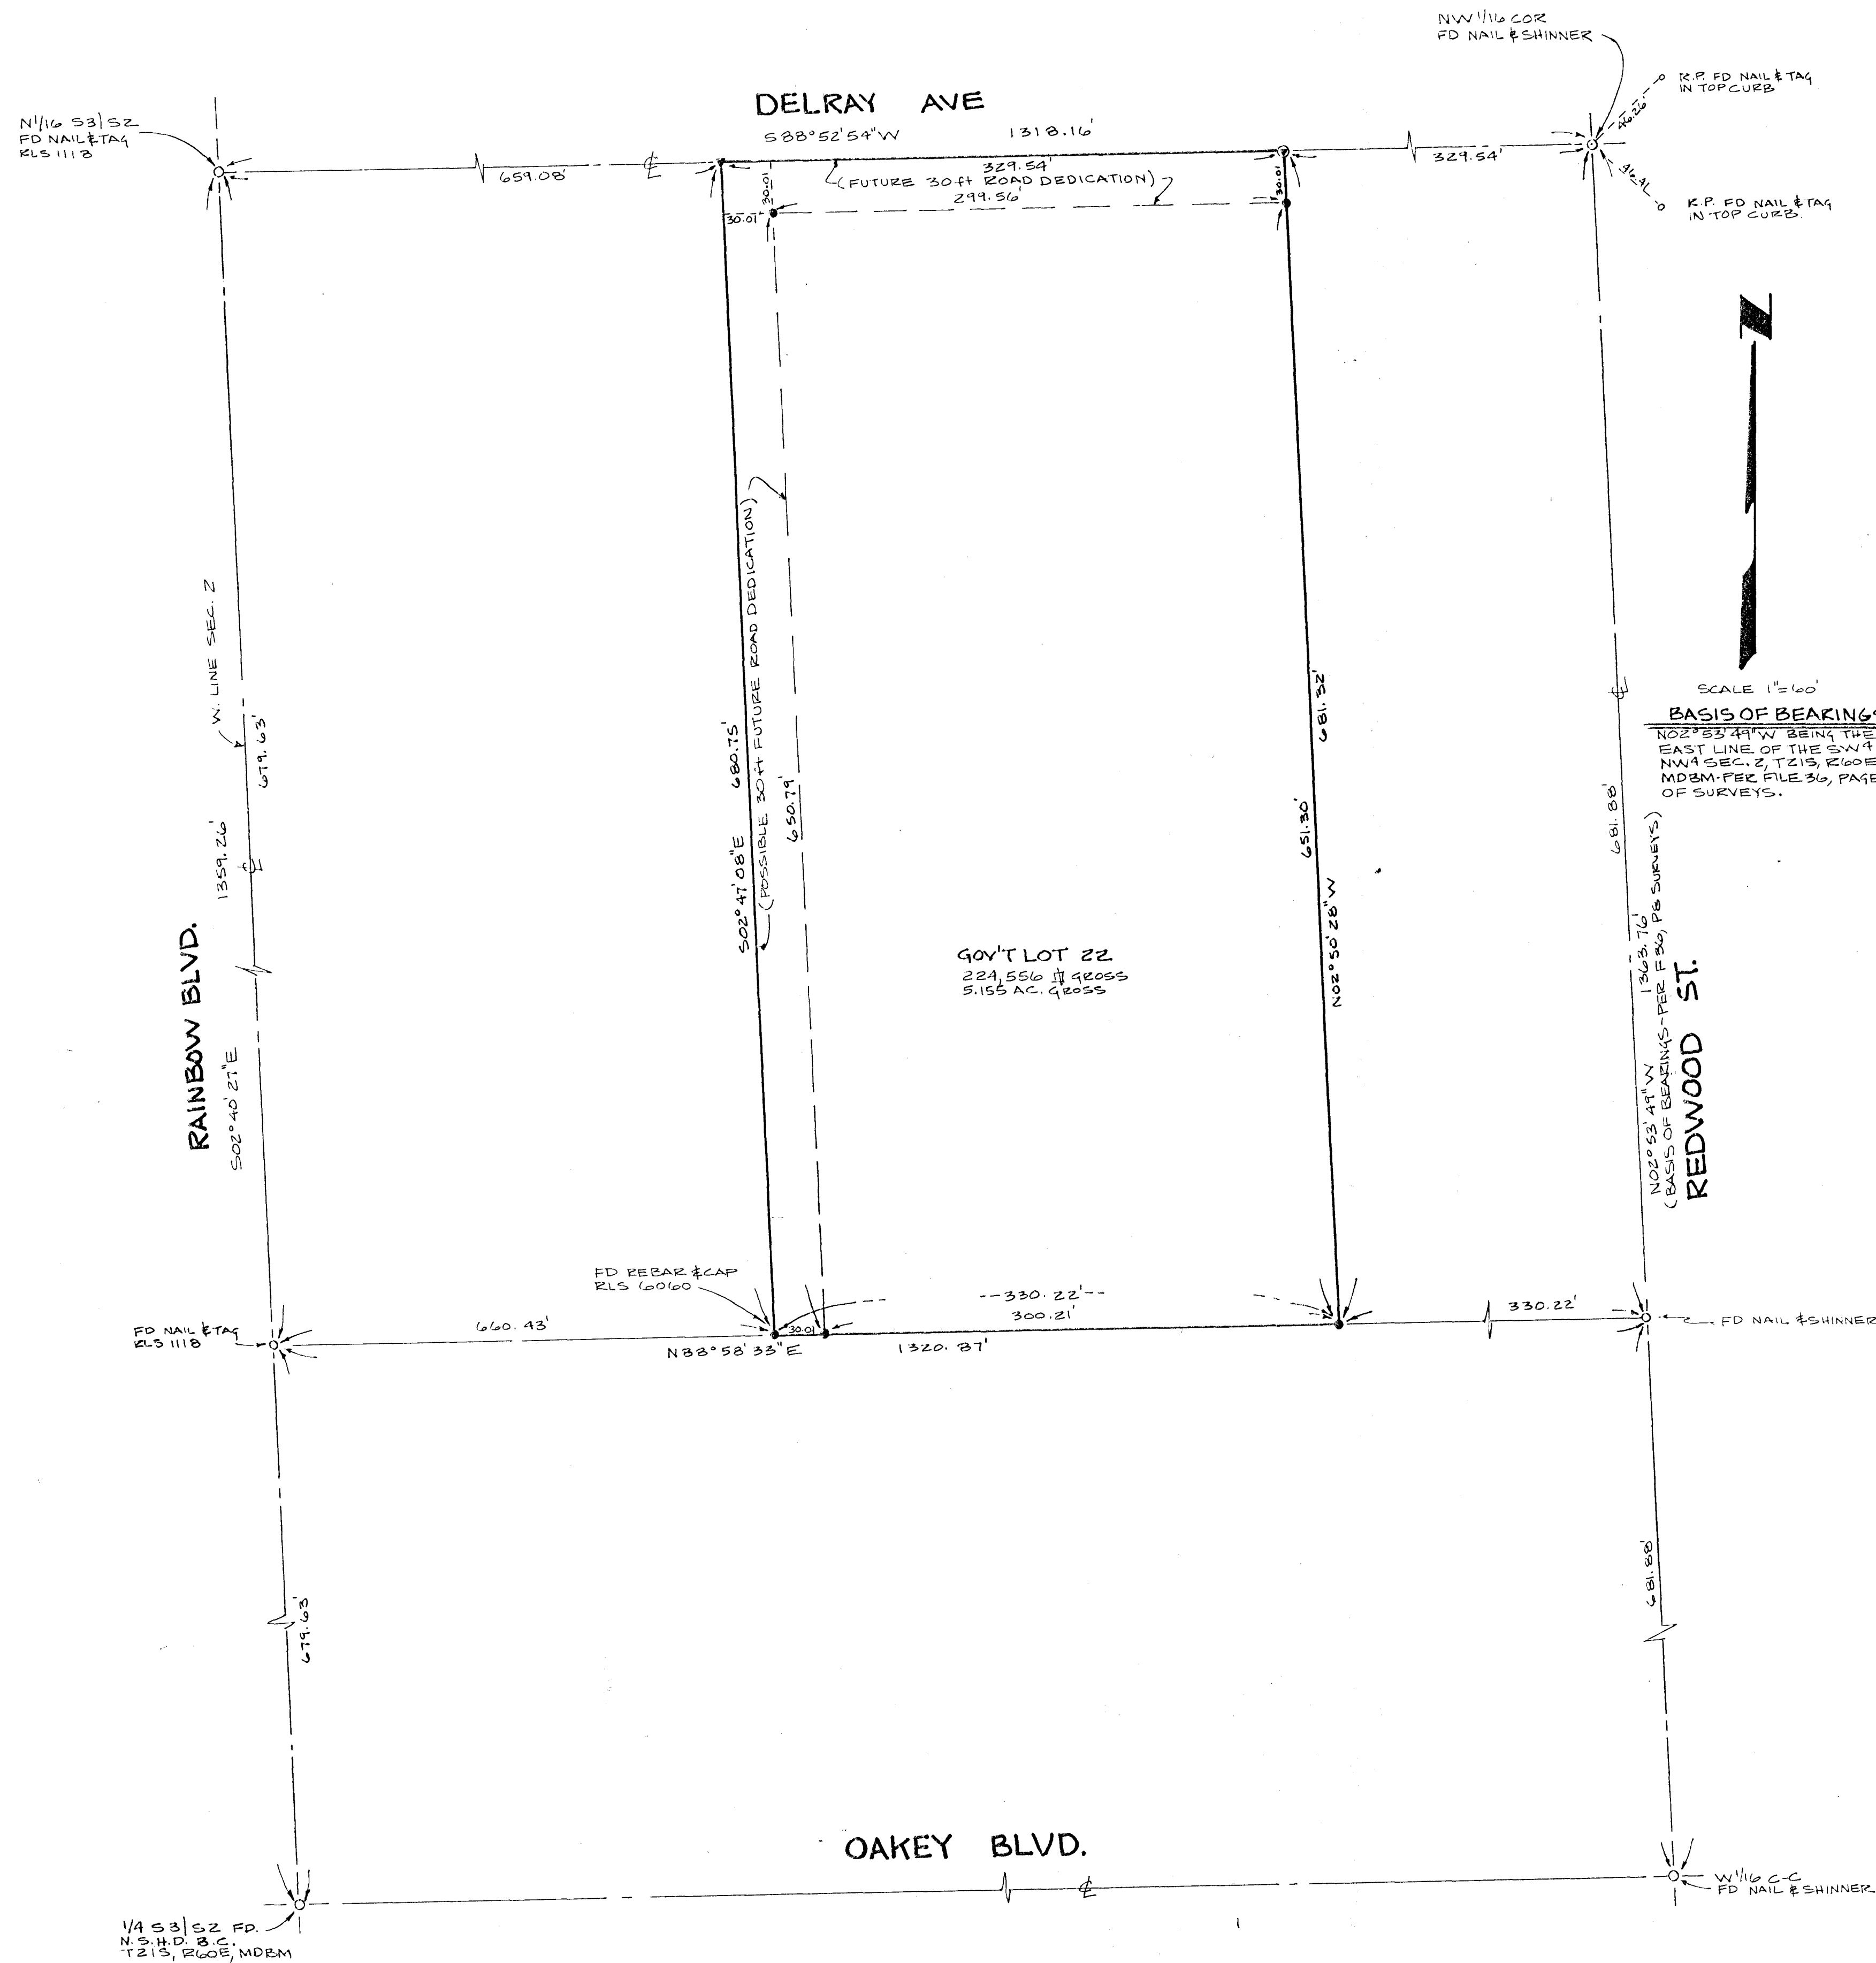

BASIS OF BEARINGS
N02°33'41"W BEING THE EAST LINE OF THE SW 1/4 NW 4 SEC. 2, T21S, R60E, MDBM-REC FILE 36, PAGE 8 OF SURVEYS.
N02°53'41"W BEING THE EAST LINE OF THE SW 1/4 NW 4 SEC. 2, T21S, R60E, MDBM-REC FILE 36, PAGE 8 OF SURVEYS.

LEGEND
○ FOUND MONUMENTS AS SHOWN
● SET REBAR & CAP RLS 5269
● SET P/NAIL & SHINER
▼ SET #600 NAIL

LEGAL
GOV'T LOT 22, PTN NE 4 SW 1/4 NW 4 SEC. 2, T21S, R60E, MDBM.

ANNEXED TO THE CITY OF LAS VEGAS UNDER ORDINANCE NUMBER

RECORD OF SURVEY MAP

GOV'T LOT 22, PTN NE 4 SW 1/4 NW 4 SEC. 2, T21S, R60E, MDBM		NO. FILED AT THE REQUEST OF	
SCALE: 1"=60'	CLARK COUNTY NEVADA	DATE: 4/25/84	AT: _____
DATE: 4/25/84	C.D.S. DEVELOPMENT OF CALIFORNIA, INC. 2850 - 6 TH AVENUE, SUITE 114 SAN DIEGO, CA. 92103	CHK'D BY: _____	PAGE: _____
BY: FULSTONE ENTERPRISES 3855 S HIGHLAND #13 LAS VEGAS, NEVADA 89103 (102) 876-0283	REVISOR DATE: 4/25/84	DATE: _____	OF SURVEYS
	DEPUTY: _____	DATE: _____	OFFICIAL RECORDS BOOK NO. _____
		DATE: _____	CLARK COUNTY, NEVADA, RECORDS
		DATE: _____	JOAN L. SWIFT, RECORDER
		DATE: _____	FEE: _____
		DATE: _____	DEPUTY: _____

A-11-84(A)
APR 30 1984

CHARLESTON

BLIND

A-11-84

