


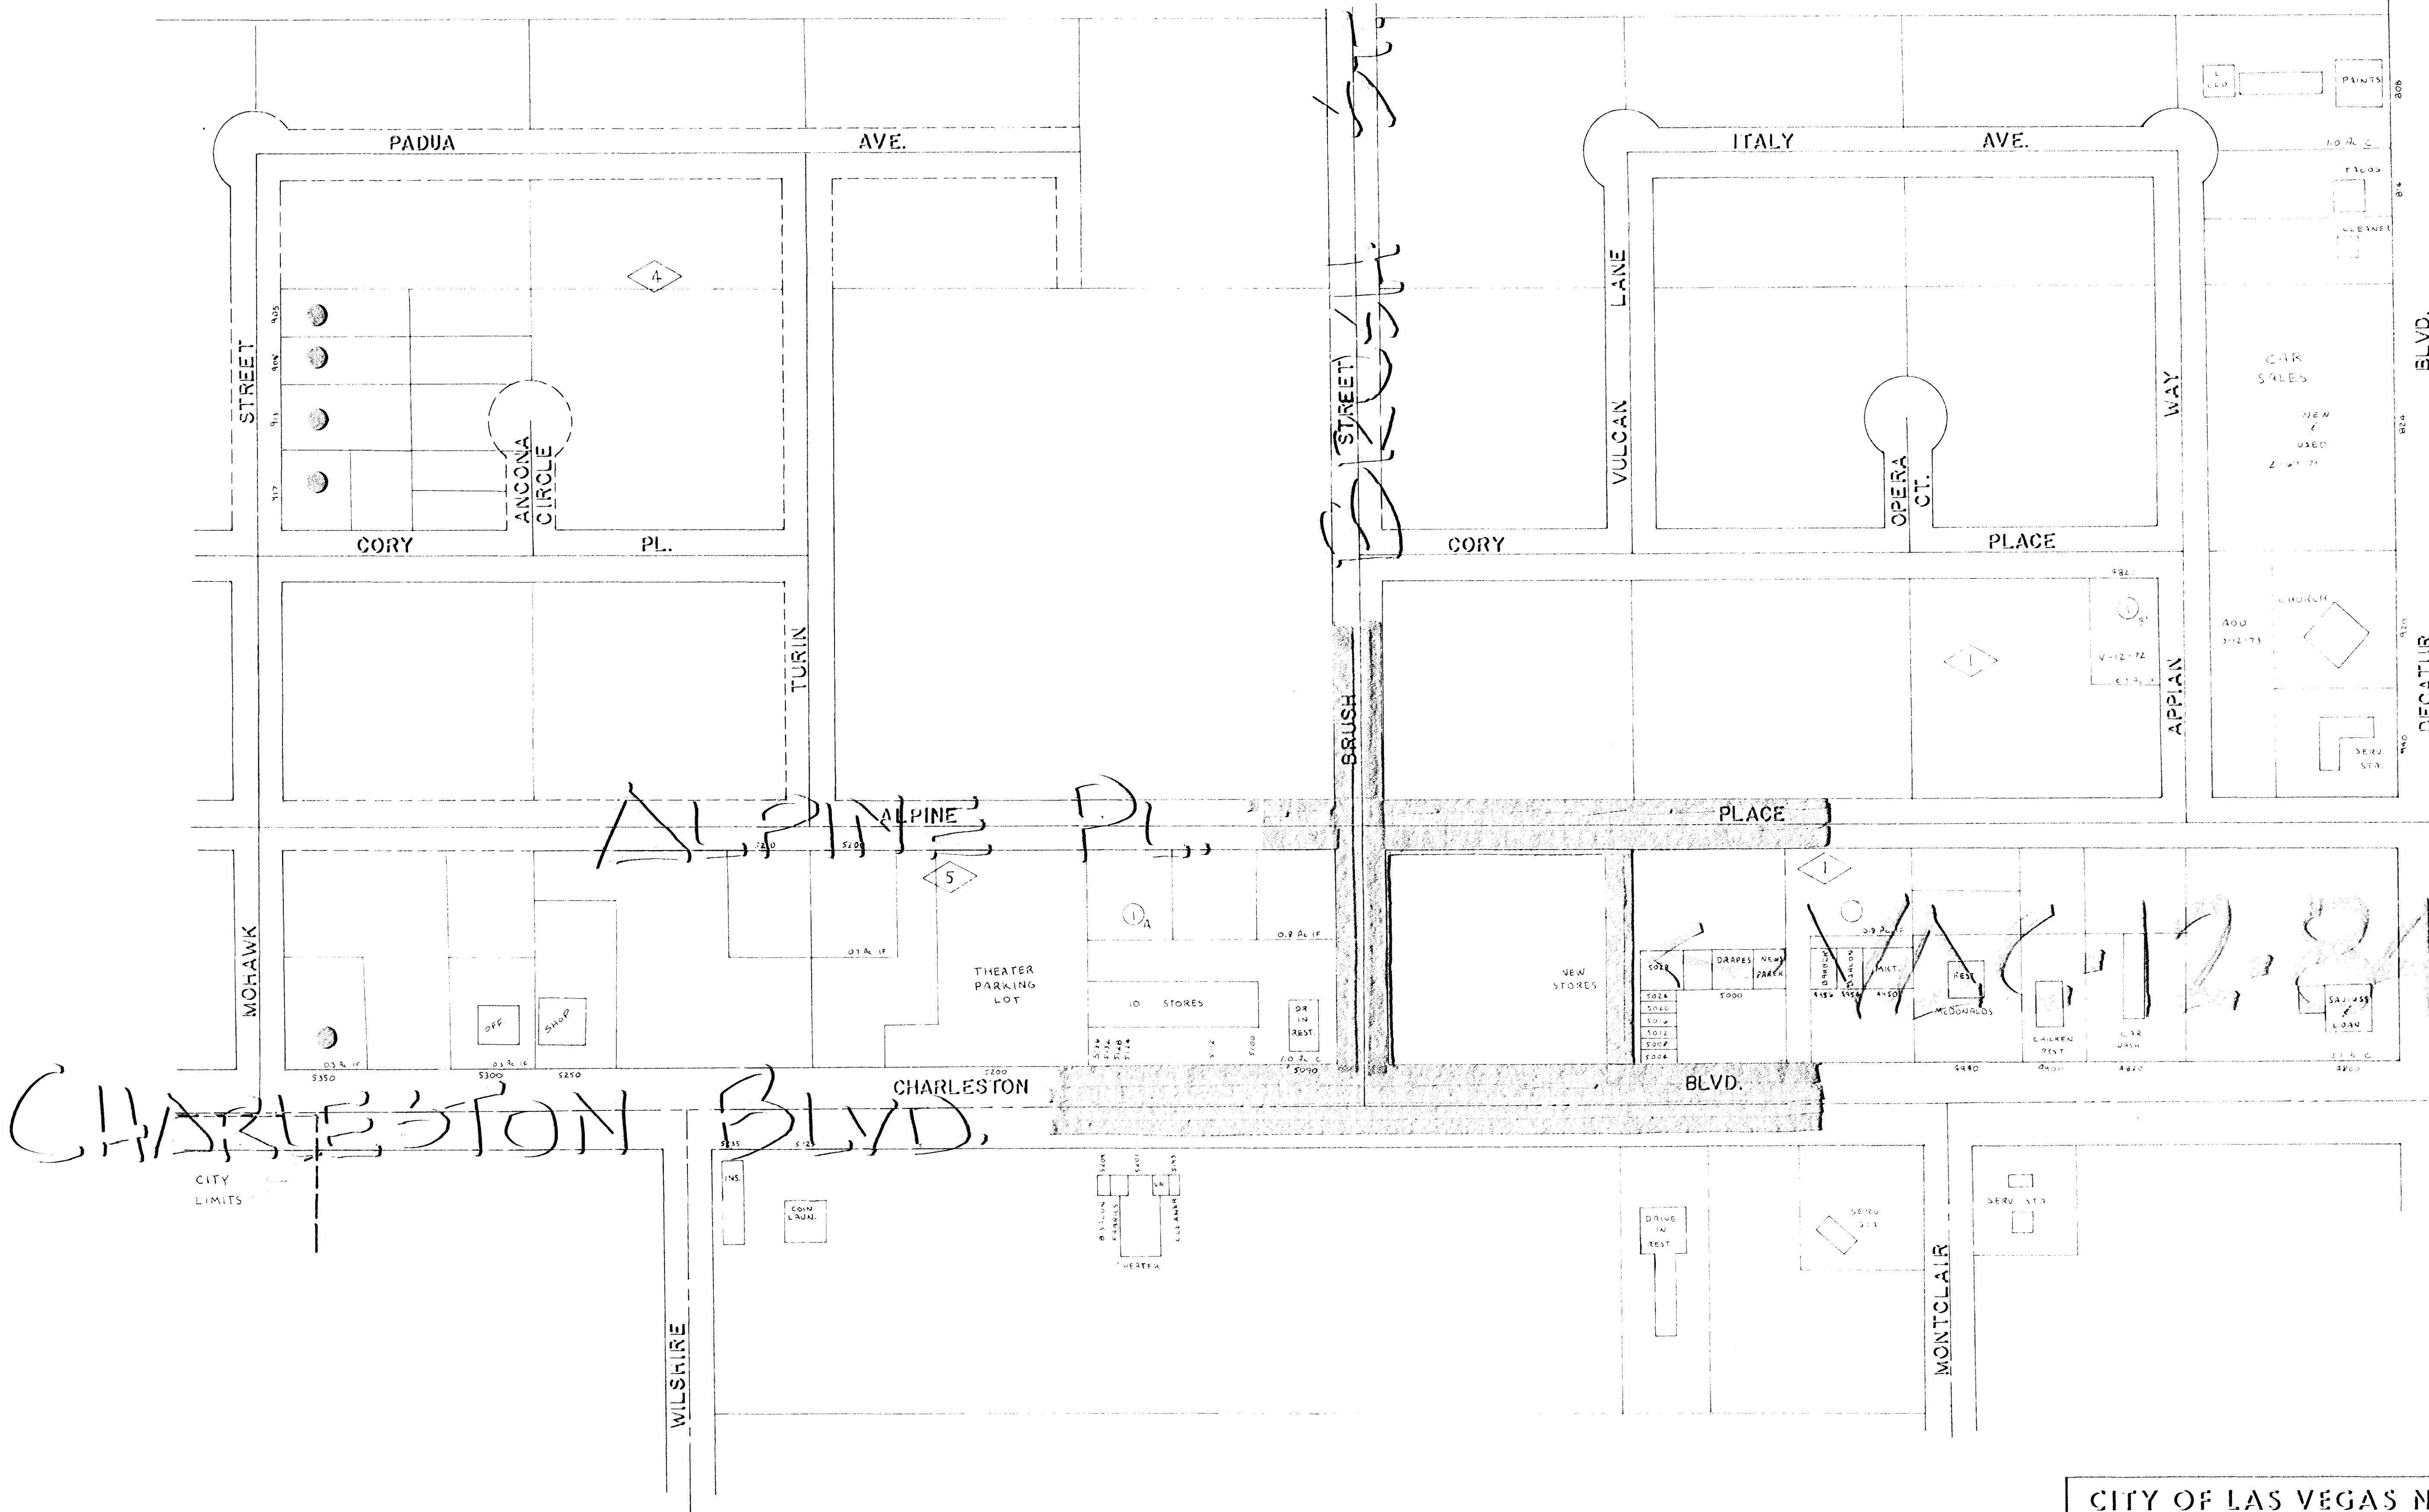

DRAWN	12/20/73	BY	LYG	FILE NO.
CHECKED		BY		1-36-8
REVISED		BY		
REVISED		BY		