



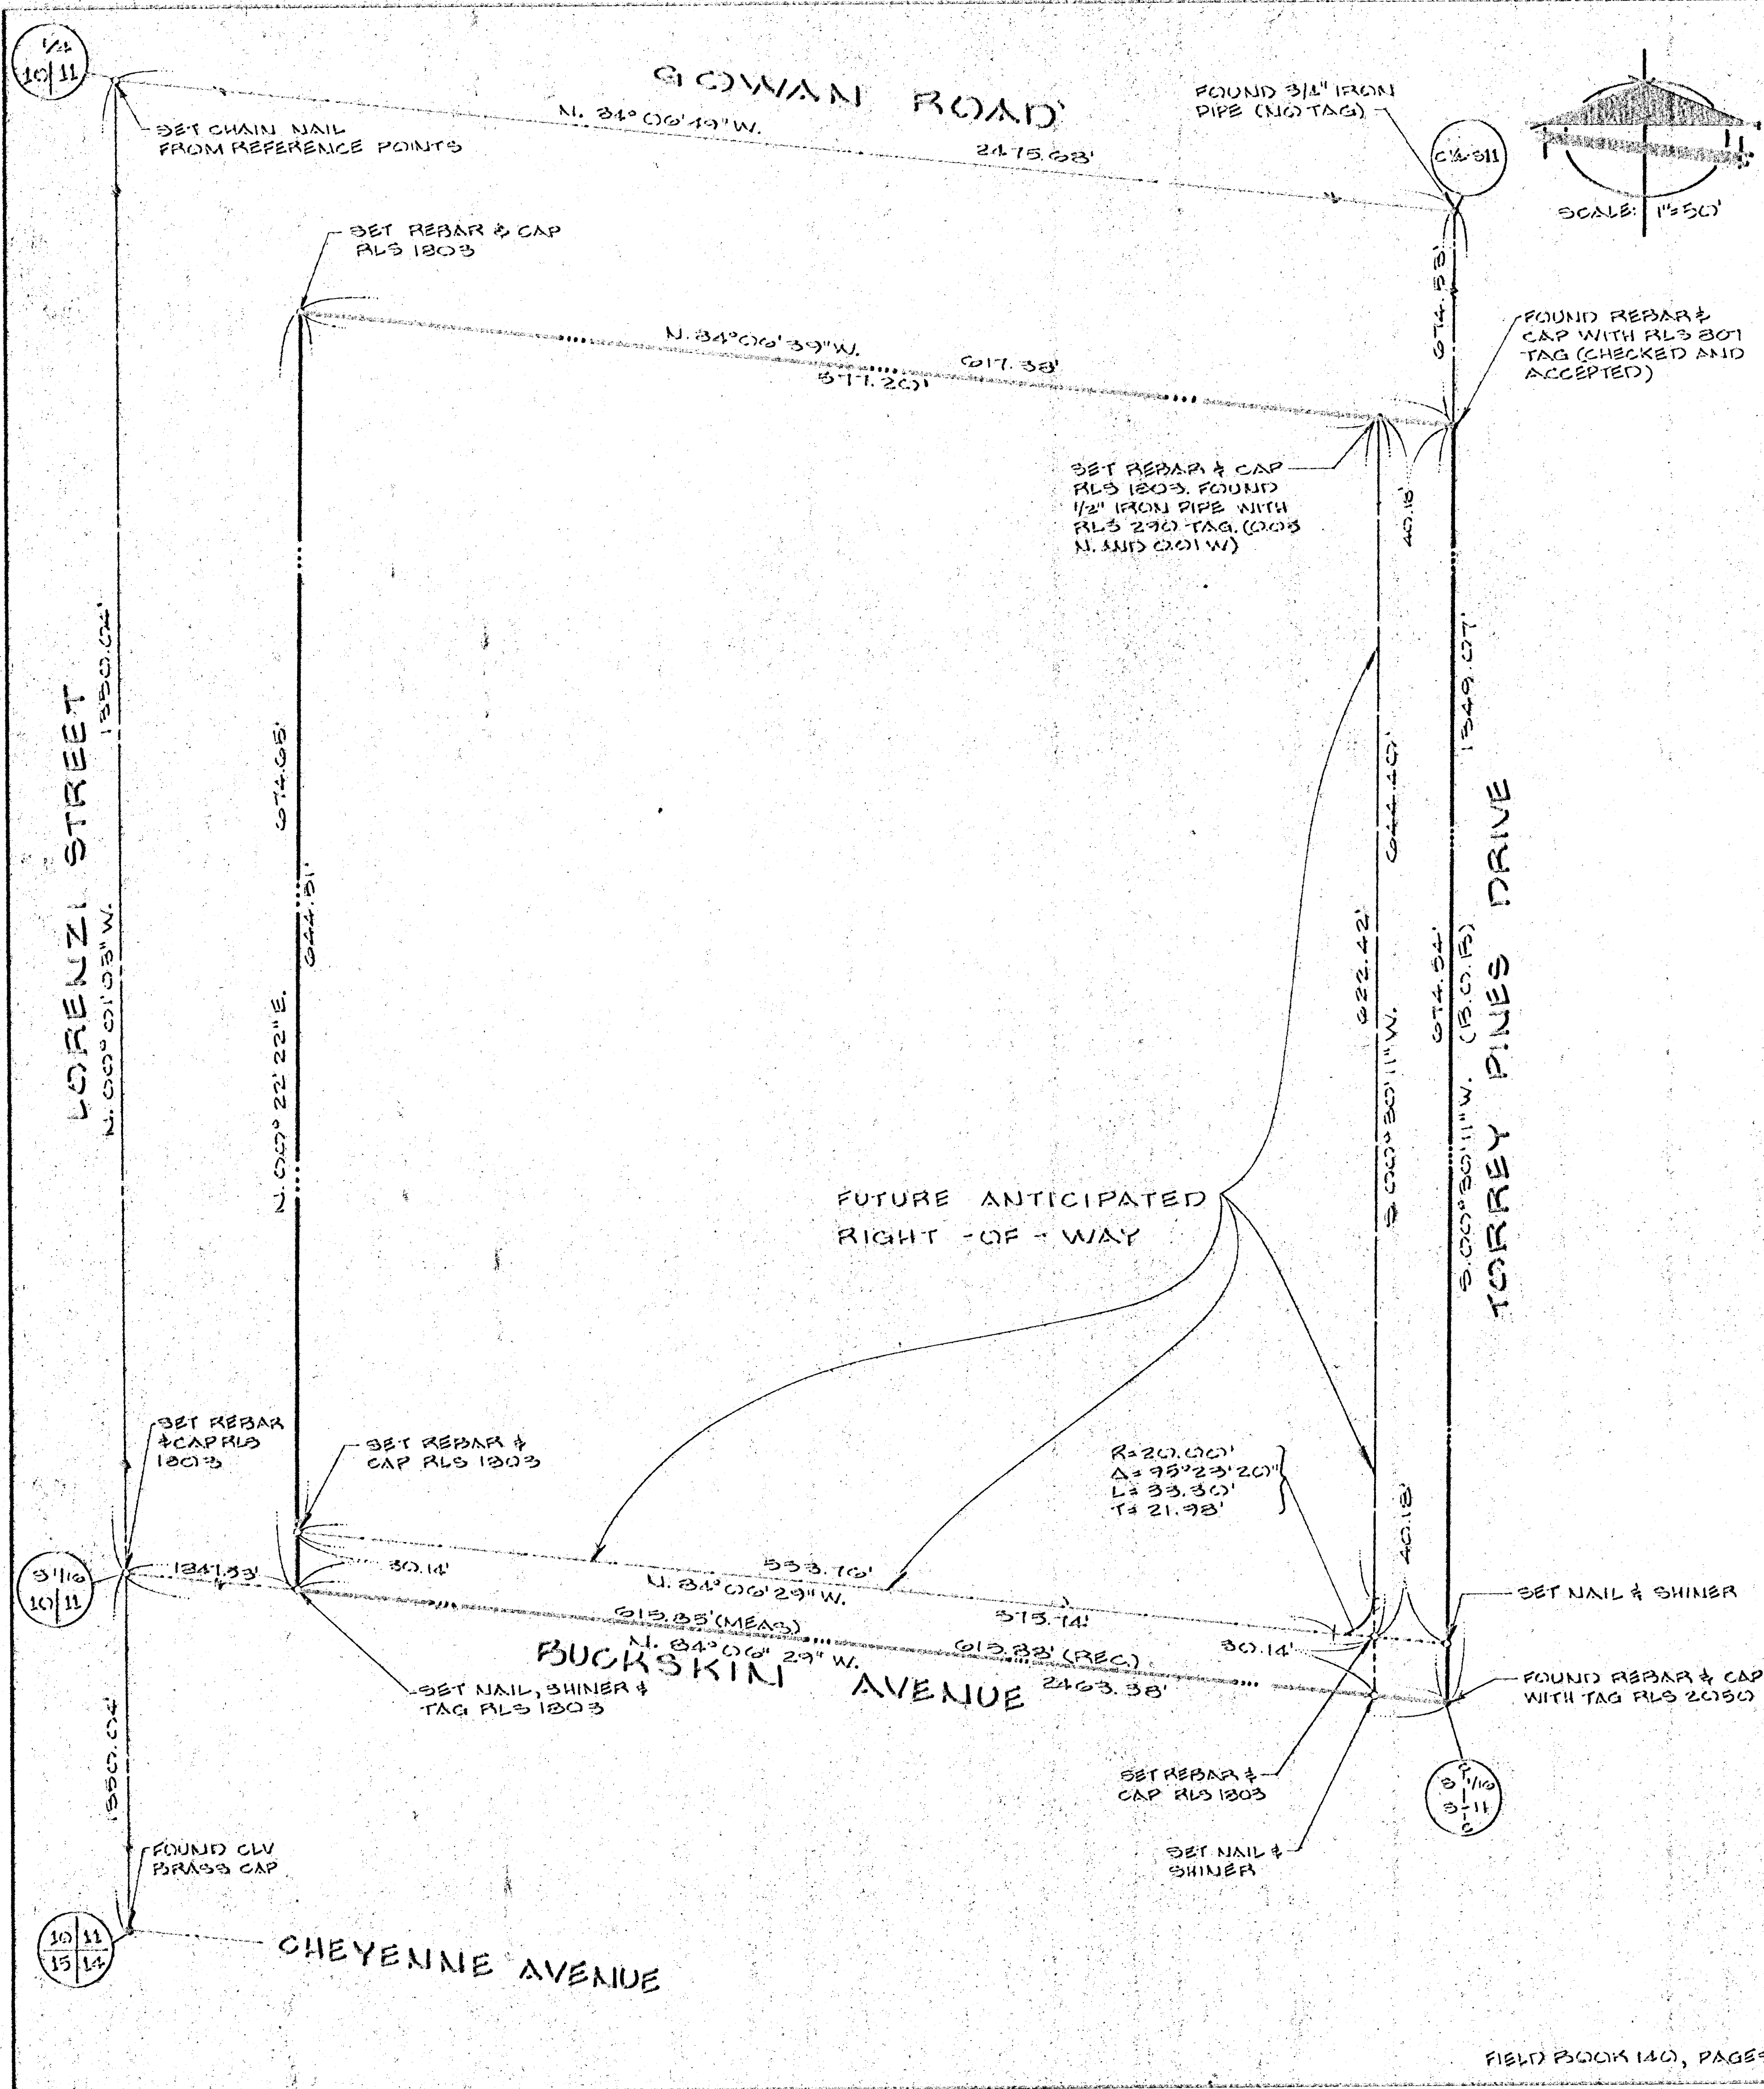

SURVEYOR'S CERTIFICATE

I, STEPHEN F. TURNER, A REGISTERED PROFESSIONAL ENGINEER AND LAND SURVEYOR, DO HEREBY CERTIFY THAT THIS MAP IS A TRUE AND ACCURATE REPRESENTATION OF THE LANDS SHOWN HEREON. ALL POINTS FOUND OR SET ARE CORRECTLY DESIGNATED. THIS SURVEY WAS COMPLETED ON OCTOBER 5, 1981, AT THE INSTANCE OF THE CLARK COUNTY SCHOOL DISTRICT AND DOES NOT CONSTITUTE A SUBDIVISION AS DEFINED BY NEVADA STATE LAW.

Stephen F. Turner
 STEPHEN F. TURNER
 RPE - RLS 1303

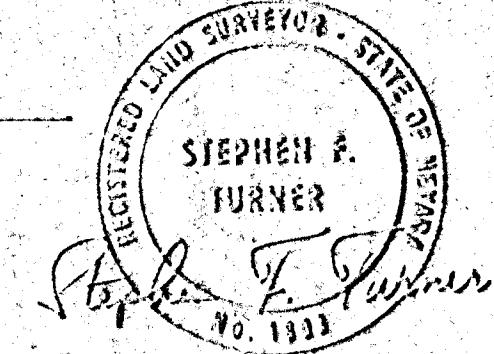

BASIS OF BEARINGS

S. 00° 30' 11\"/>

REFERENCE MAPS

PARCEL MAP	FILE 6	PAGE 15
RECORD OF SURVEY MAP	FILE 2	PAGE 62
RECORD OF SURVEY MAP	FILE 15	PAGE 63
PARCEL MAP	FILE 19	PAGE 53

LEGAL DESCRIPTION

THE SOUTHEAST QUARTER (SE 1/4) OF THE NORTHEAST QUARTER (NE 1/4) OF THE SOUTHWEST QUARTER (SW 1/4) OF SECTION 11, TOWNSHIP 20 SOUTH, RANGE 60 EAST, M.D.B. & M.

LEGEND

○	POINT SET AS NOTED
●	POINT FOUND AS NOTED
—	STREET CENTERLINE
---	PROPERTY LINE

ANNEXED TO THE CITY OF LAS VEGAS ORDINANCE NO. _____	
RECORD MAP OF SURVEY FOR CLARK COUNTY SCHOOL DISTRICT THE SE 1/4 OF THE NE 1/4 OF THE SW 1/4 OF SECTION 11, TOWNSHIP 20 SOUTH, RANGE 60 EAST, M.D.B. & M. CITY OF LAS VEGAS, NEVADA	
NO. _____ FILED AT THE REQUEST OF STEPHEN F. TURNER DATE _____ AT _____ FILE _____ PAGE _____ OF SURVEY MAP OFFICIAL RECORDS BOOK NO. _____ CLARK COUNTY NEVADA RECORDS JOAN L. SWIFT, RECORDER	BAUGHMAN & TURNER CIVIL ENGINEERS MINING ENGINEERS LAND SURVEYORS 1325 WEST CHARLESTON BOULEVARD 702, 870-8771 LAS VEGAS, NEVADA 89102
FIELD BOOK 140, PAGES 1072-114 FEE _____ DEPUTY _____	

A-1381 (A)

