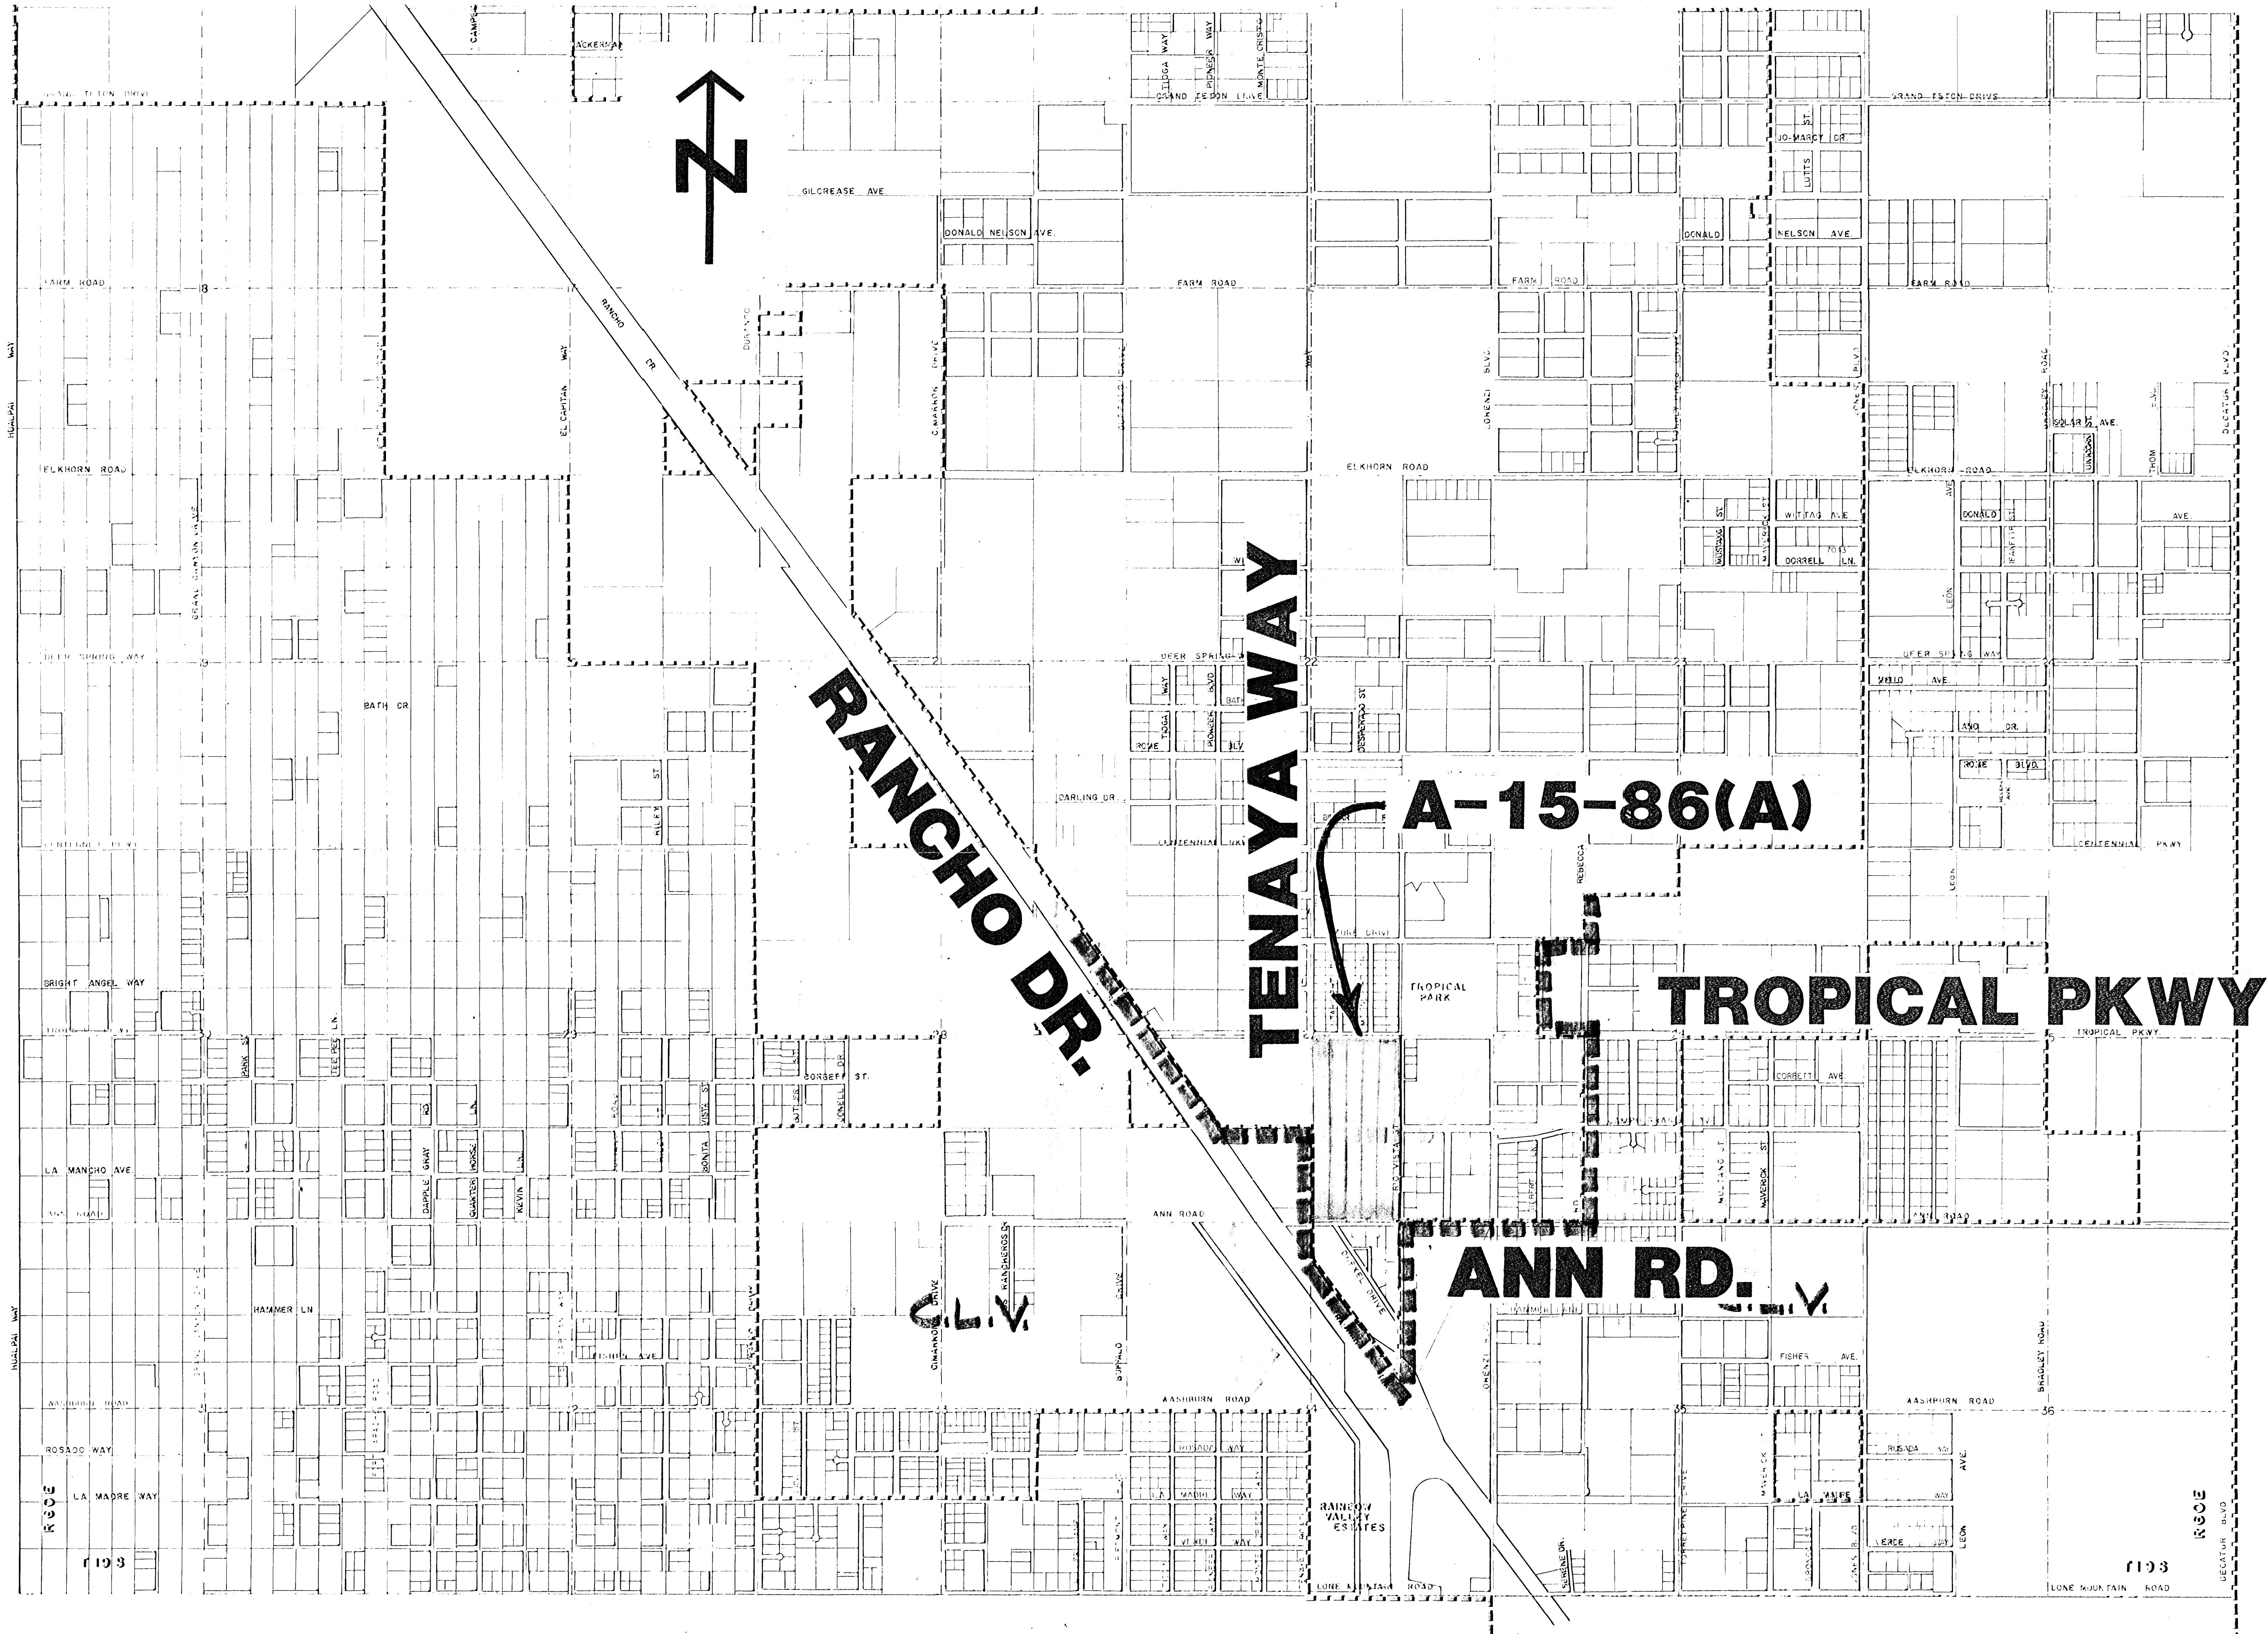


RANCHO DR.

TENAYA WAY

A-15-86(A)


TROPICAL PKWY

ANN RD.

C.L.V.

C.L.V.


1193

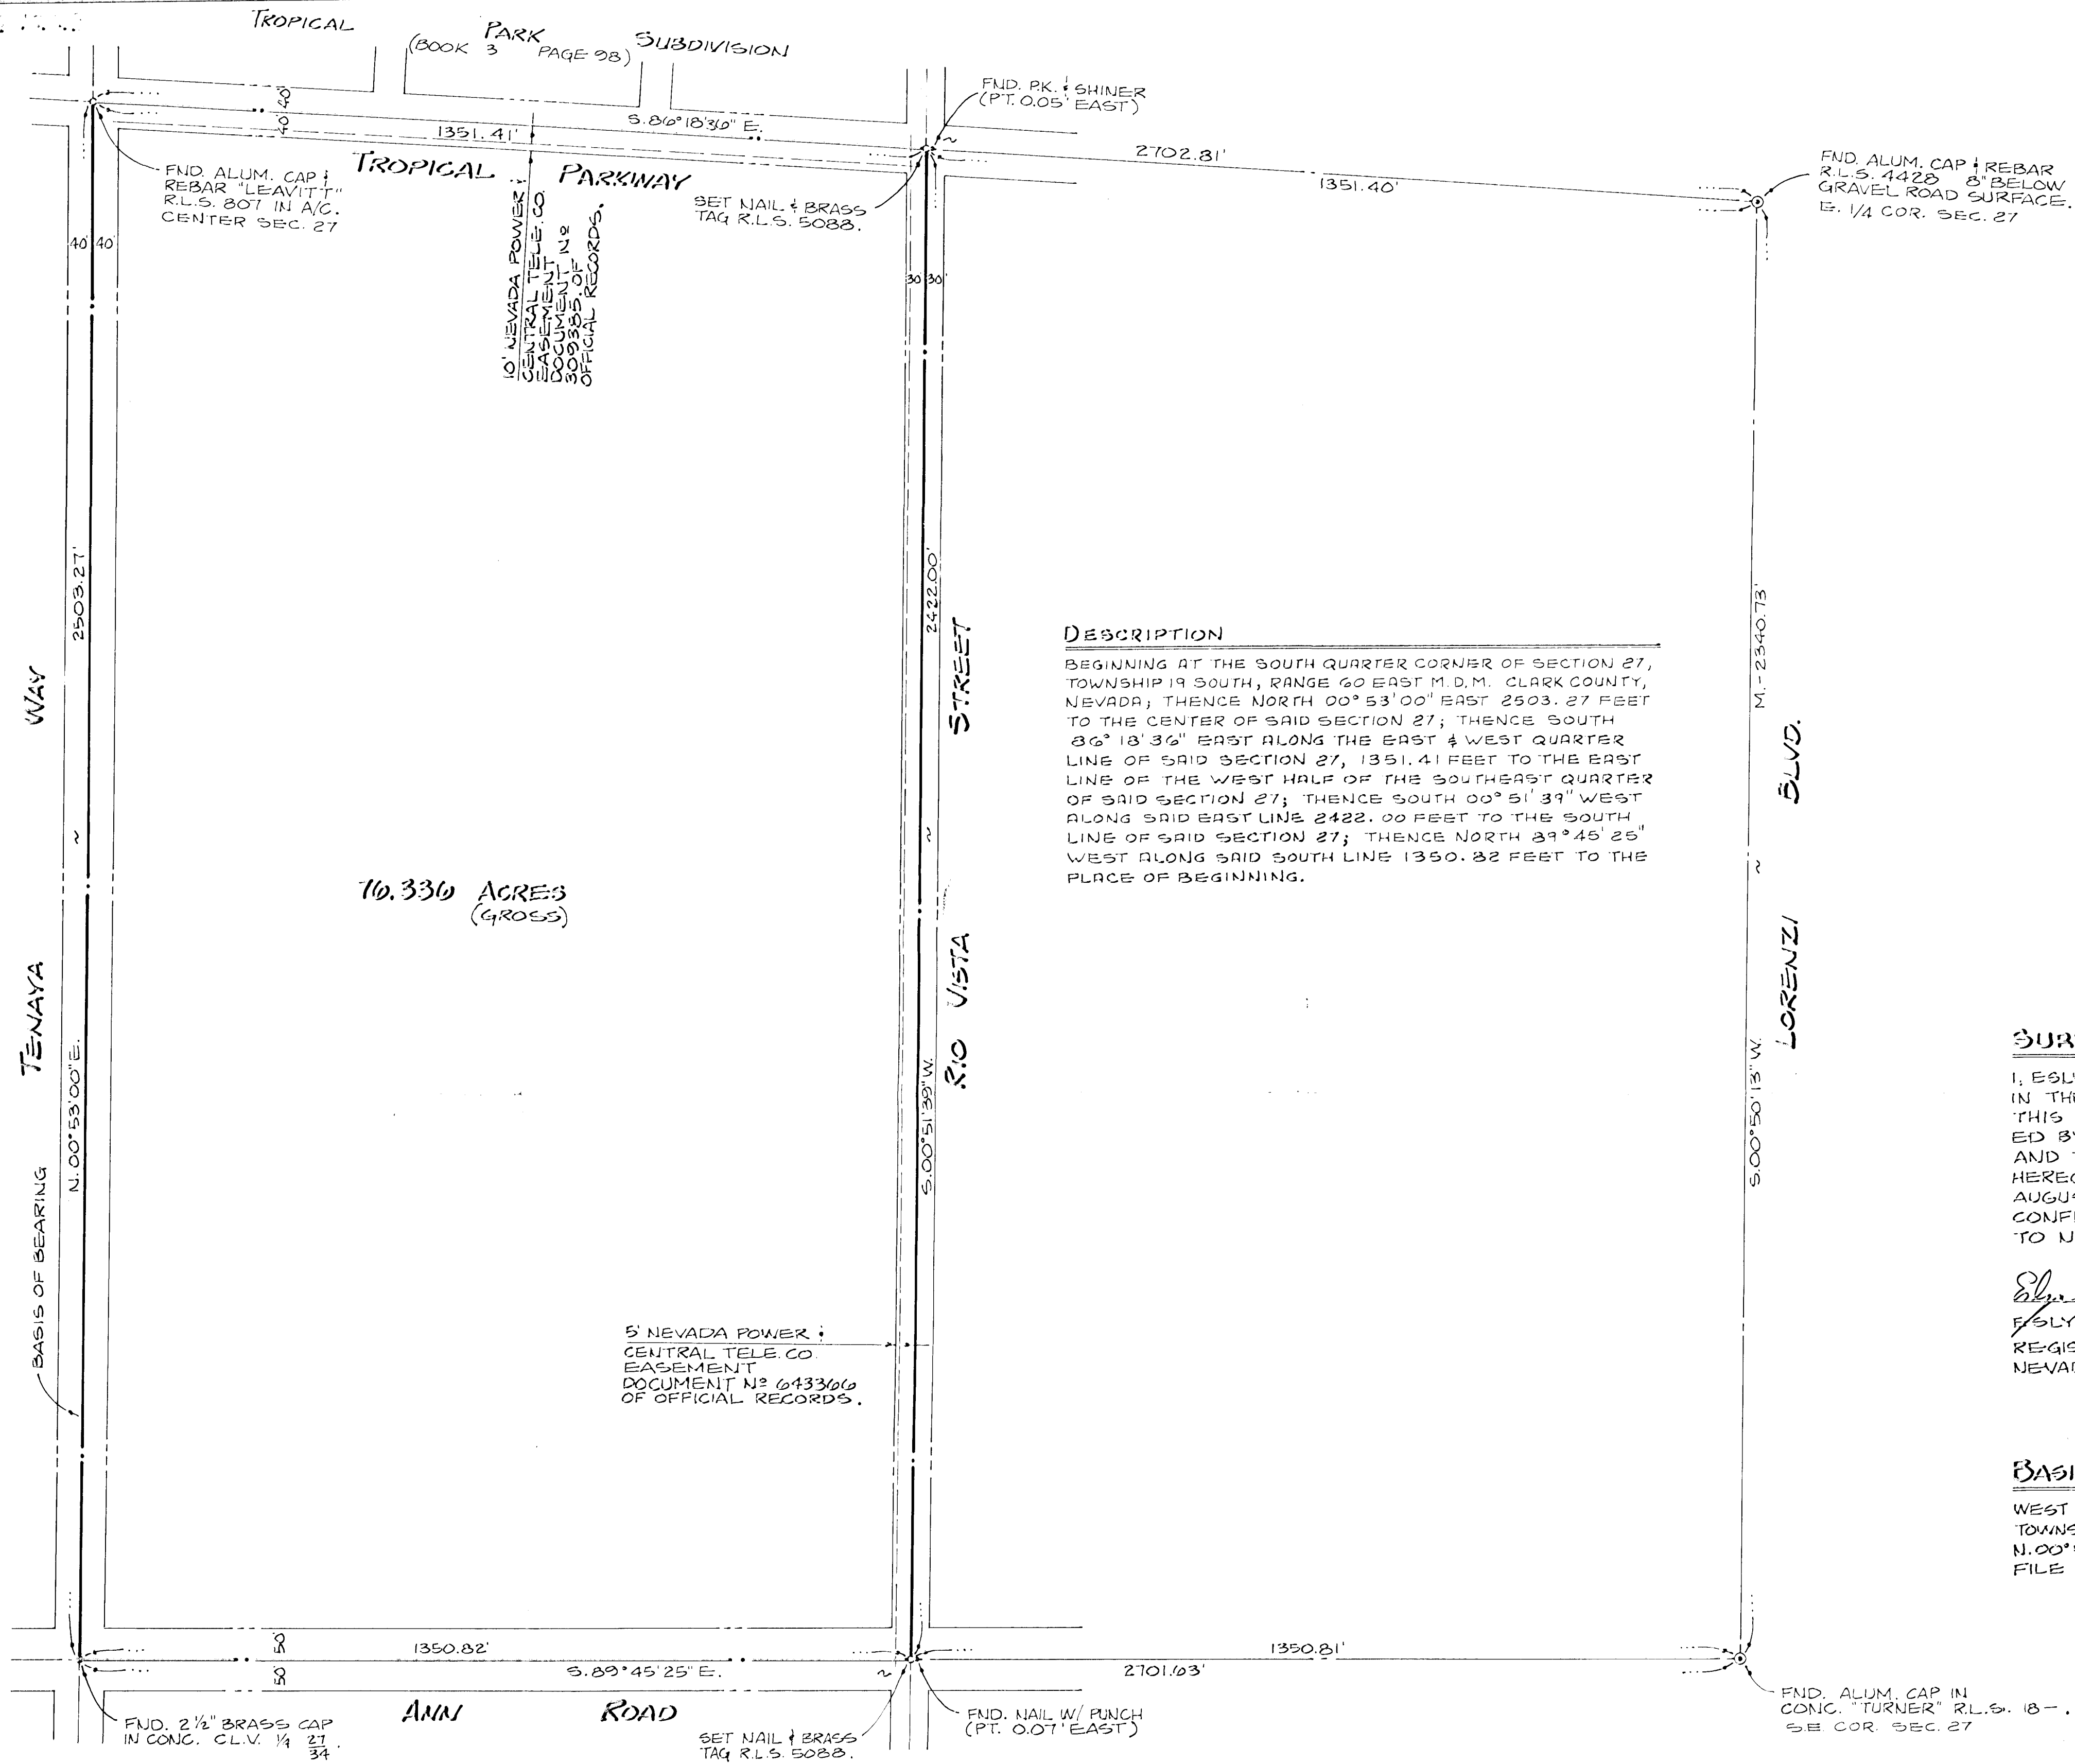

SURVEYOR'S CERTIFICATE:

I, ERLYN BRENNER, A DULY REGISTERED LAND SURVEYOR IN THE STATE OF NEVADA, DO HEREBY CERTIFY THAT THIS MAP ACCURATELY DELINEATES A SURVEY CONDUCTED BY ME AT THE INSTANCE OF R.A. HOMES AND THAT THE POINTS FOUND AND SET ARE AS SHOWN HEREON, THAT THE SURVEY WAS COMPLETED ON AUGUST 13, 1986, AND THAT THE SURVEY IS NOT IN CONFLICT WITH THE REQUIREMENTS OF N.R.S. 278.010 TO N.R.S. 278.630 INCLUSIVE.

Erlyn Brenner
ERLYN BRENNER
REGISTERED LAND SURVEYOR
NEVADA CERTIFICATE N° 5088

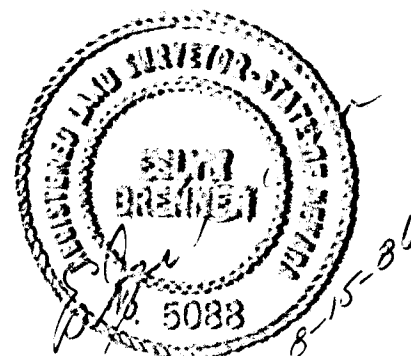

BASIS OF BEARING

WEST LINE OF THE SOUTHEAST 1/4 OF SECTION 27, TOWNSHIP 19 SOUTH, RANGE 60 EAST BEARING N.00°53'00"E. AS SHOWN ON RECORD OF SURVEY MAP FILE 10 PAGE 57.

ANNEXED TO THE CITY OF LAS VEGAS, BY ORDINANCE 3261

REFERENCES

RECORD OF SURVEYS,
FILE 10, PAGE 57,
FILE 18, PAGE 28,
FILE 28, PAGE 22,

LEGEND

ALL POINTS ARE AS SHOWN.
----- PROPOSED DEDICATED R/W
----- DEDICATED R/W
----- PROPERTY LINE

BRENNER & ASSOC., INC.
LAND SURVEYORS
1100 E. SAHARA AVE., LAS VEGAS, NEVADA 89104

RECORD OF SURVEY MAP

BEING THE WEST 1/2, SOUTHEAST 1/4
OF SECTION 27, TOWNSHIP 19 SOUTH,
RANGE 60 EAST, M.D.M., CLARK COUNTY,
NEVADA.

DATE: AUGUST 15, 1986

SCALE: 1" = 160'

N° 10
FILED AT THE REQUEST OF
R.A. HOMES, INC.

DATE 8-15-86 AT 1:00 P.M.
FILE 10 PAGE 57
OF SURVEYS
OFFICIAL RECORDS BOOK 10
CLARK COUNTY NEVADA RECORDS
JOAN L. SWIFT
RECORDER

FEE \$100.00 DEPUTY \$100.00