


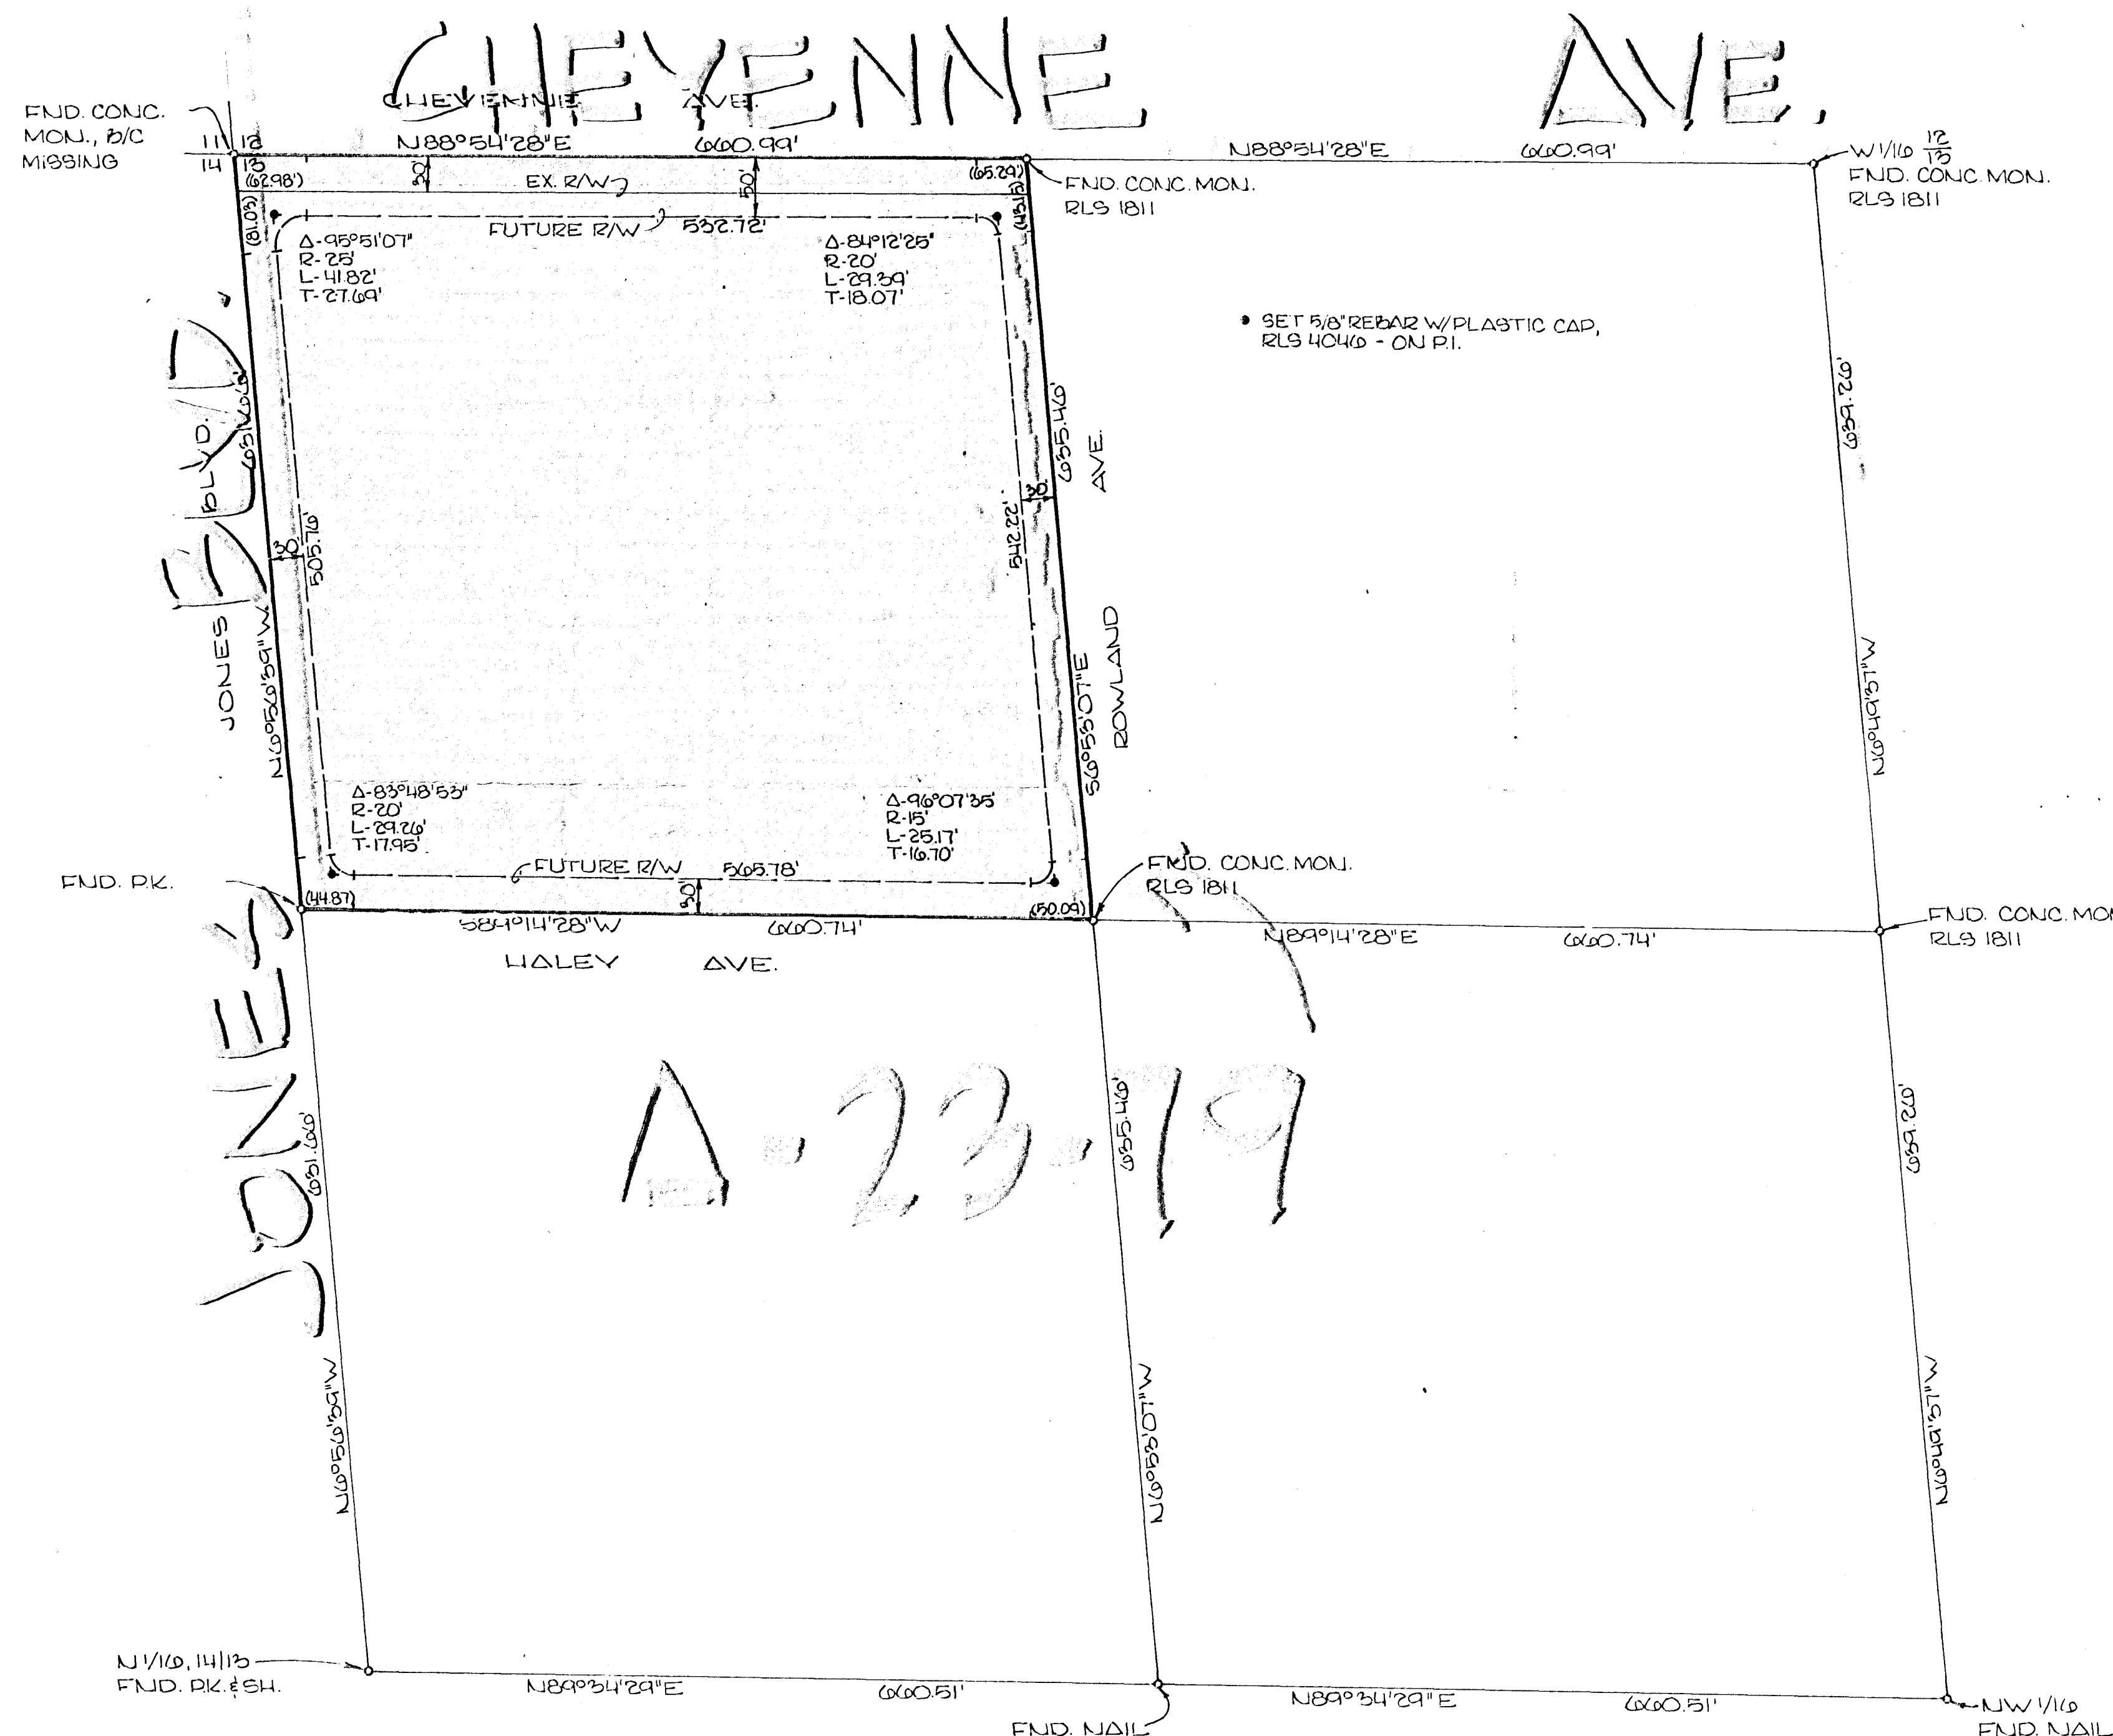

SURVEYOR'S CERTIFICATE
 I, JERRY E. BARNSON, A DULY REGISTERED LAND SURVEYOR
 IN THE STATE OF NEVADA, DO HEREBY CERTIFY THAT
 THE SURVEY OF THE LAND SHOWN HEREON WAS MADE
 UNDER MY DIRECT SUPERVISION AT THE INSTANCE OF
 PHILIP J. COHEN & ANDREW THOMPSON AND THE CITY OF
 LAS VEGAS, THAT THE SURVEY WAS COMPLETED ON
 SEPTEMBER 7, 1979, AND THAT THE POINTS FOUND AND
 SET ARE CORRECTLY SHOWN HEREON. THIS MAP DOES
 NOT CONSTITUTE A SUBDIVISION AS DEFINED BY NEVADA
 STATE LAW.

DATE 9/13/79 Jerry E. Barnson
 JERRY E. BARNSON
 REGISTERED LAND SURVEYOR
 NEVADA CERTIFICATE NO. 4046

BASIS OF BEARING
 BEING THE NORTH LINE OF THE NW 1/4 OF THE
 NW 1/4 OF SEC. 13, T20S, R20E, MDM, CLARK CO., NEV., AS SHOWN
 BY A MAP ON FILE IN THE COUNTY RECORDER'S OFFICE IN
 FILE 8 OF PARCEL MAPS, PAGE 93.


LEGAL DESCRIPTION
 BEING THE NW 1/4 OF THE NW 1/4 OF THE NW 1/4 OF SECTION
 13, T20S, R20E, MDM, CLARK COUNTY, NEVADA, FURTHER
 DESCRIBED AS FOLLOWS:
 BEGINNING AT THE NW CORNER OF SAID NW 1/4 OF THE
 NW 1/4 OF THE NW 1/4; THENCE N88°54'28"E ALONG THE
 NORTH LINE THEREOF, 660.99 FEET; THENCE S6°53'
 07"E ALONG THE EAST LINE THEREOF, 635.46 FEET;
 THENCE S89°14'28"W ALONG THE SOUTH LINE THEREOF,
 660.74 FEET; THENCE N6°56'39"W ALONG THE WEST
 LINE THEREOF, 631.66 FEET TO THE POINT OF BEGIN-
 NING; CONTAINING 9.5595 ACRES, MORE OR LESS.

ANNEXED TO THE CITY OF LAS VEGAS UNDER ORDIN-
 ANCE NO. _____

**RECORD OF SURVEY OF THE NW 1/4 OF
 THE NW 1/4 OF SECTION 13, T20S, R20E,
 M.D.M.**

1"=100'
 NORTH

NO. _____
 FILED AT THE REQUEST OF: _____
 DATED _____ AT _____ M.
 FILE _____ PAGE _____
 OF SURVEYS
 OFFICIAL RECORDS BOOK NO. _____
 CLARK COUNTY, NEVADA RECORDS
 JOAN L. SWIFT, RECORDER
 FEE \$ _____ DEPUTY _____

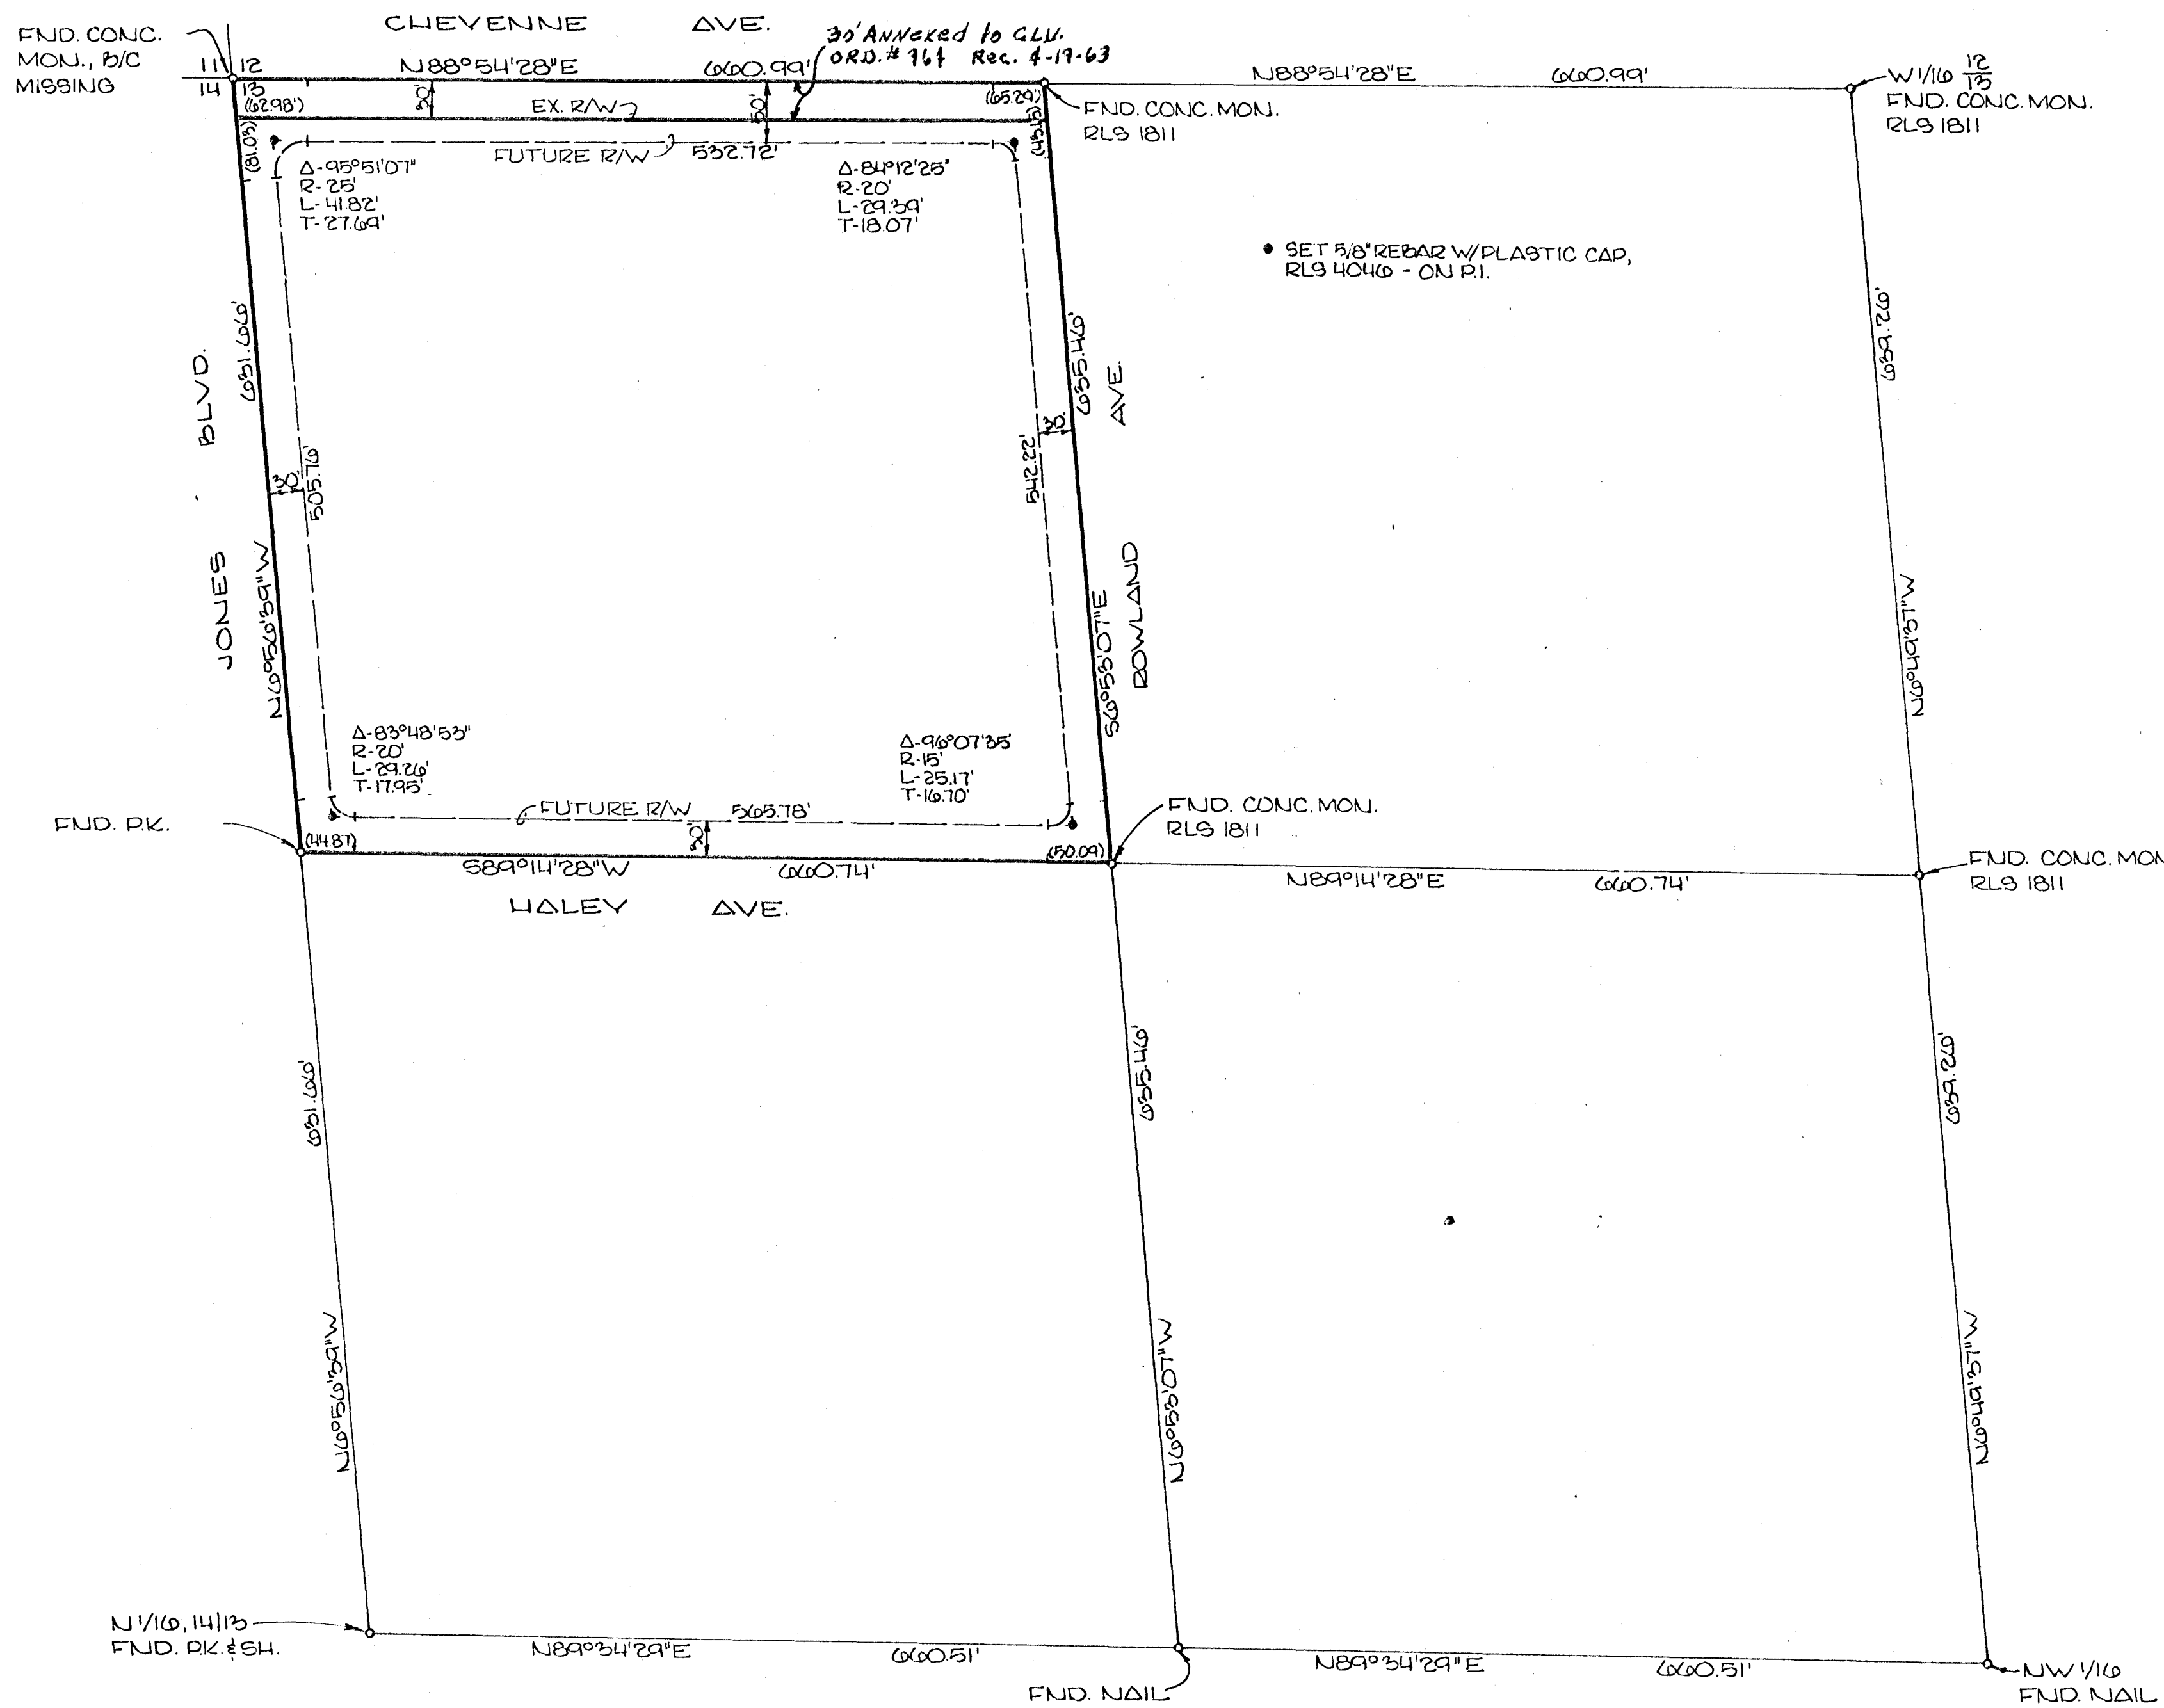

SURVEYOR'S CERTIFICATE
I, JERRY E. BARNSON, A DULY REGISTERED LAND SURVEYOR IN THE STATE OF NEVADA, DO HEREBY CERTIFY THAT THE SURVEY OF THE LAND SHOWN HEREON WAS MADE UNDER MY DIRECT SUPERVISION AT THE INSTANCE OF PHILIP J. COHEN & ANDREW THOMPkins AND THE CITY OF LAS VEGAS, THAT THE SURVEY WAS COMPLETED ON SEPTEMBER 7, 1979, AND THAT THE POINTS FOUND AND SET ARE CORRECTLY SHOWN HEREON. THIS MAP DOES NOT CONSTITUTE A SUBDIVISION AS DEFINED BY NEVADA STATE LAW.

9/18/79
DATE
Jerry E. Barnson
JERRY E. BARNSON
REGISTERED LAND SURVEYOR
NEVADA CERTIFICATE NO. 4046

BASIS OF BEARING
N88°54'28"E, BEING THE NORTH LINE OF THE NW 1/4 OF THE NW 1/4 OF SEC. 13, T20S, R60E, MDM, CLARK CO., NEV. AS SHOWN BY A MAP ON FILE IN THE COUNTY RECORDER'S OFFICE IN FILE 8 OF PARCEL MAPS, PAGE 93.


LEGAL DESCRIPTION
BEING THE NW 1/4 OF THE NW 1/4 OF THE NW 1/4 OF SECTION 13, T20S, R60E, MDM, CLARK COUNTY, NEVADA.

ANNEXED TO THE CITY OF LAS VEGAS UNDER ORDINANCE NO. _____

RECORD OF SURVEY OF THE NW 1/4 OF THE NW 1/4 OF SECTION 13, T20S, R60E, M.D.M.

NORTH
1"=100'

NO. _____	
FILED AT THE REQUEST OF: _____	
DATED _____ AT _____ M.	
FILE _____ PAGE _____	
OF SURVEYS	
OFFICIAL RECORDS BOOK NO. _____	
CLARK COUNTY, NEVADA RECORDS	
JOAN L. SWIFT, RECORDER	
FEE \$ _____	DEPUTY _____

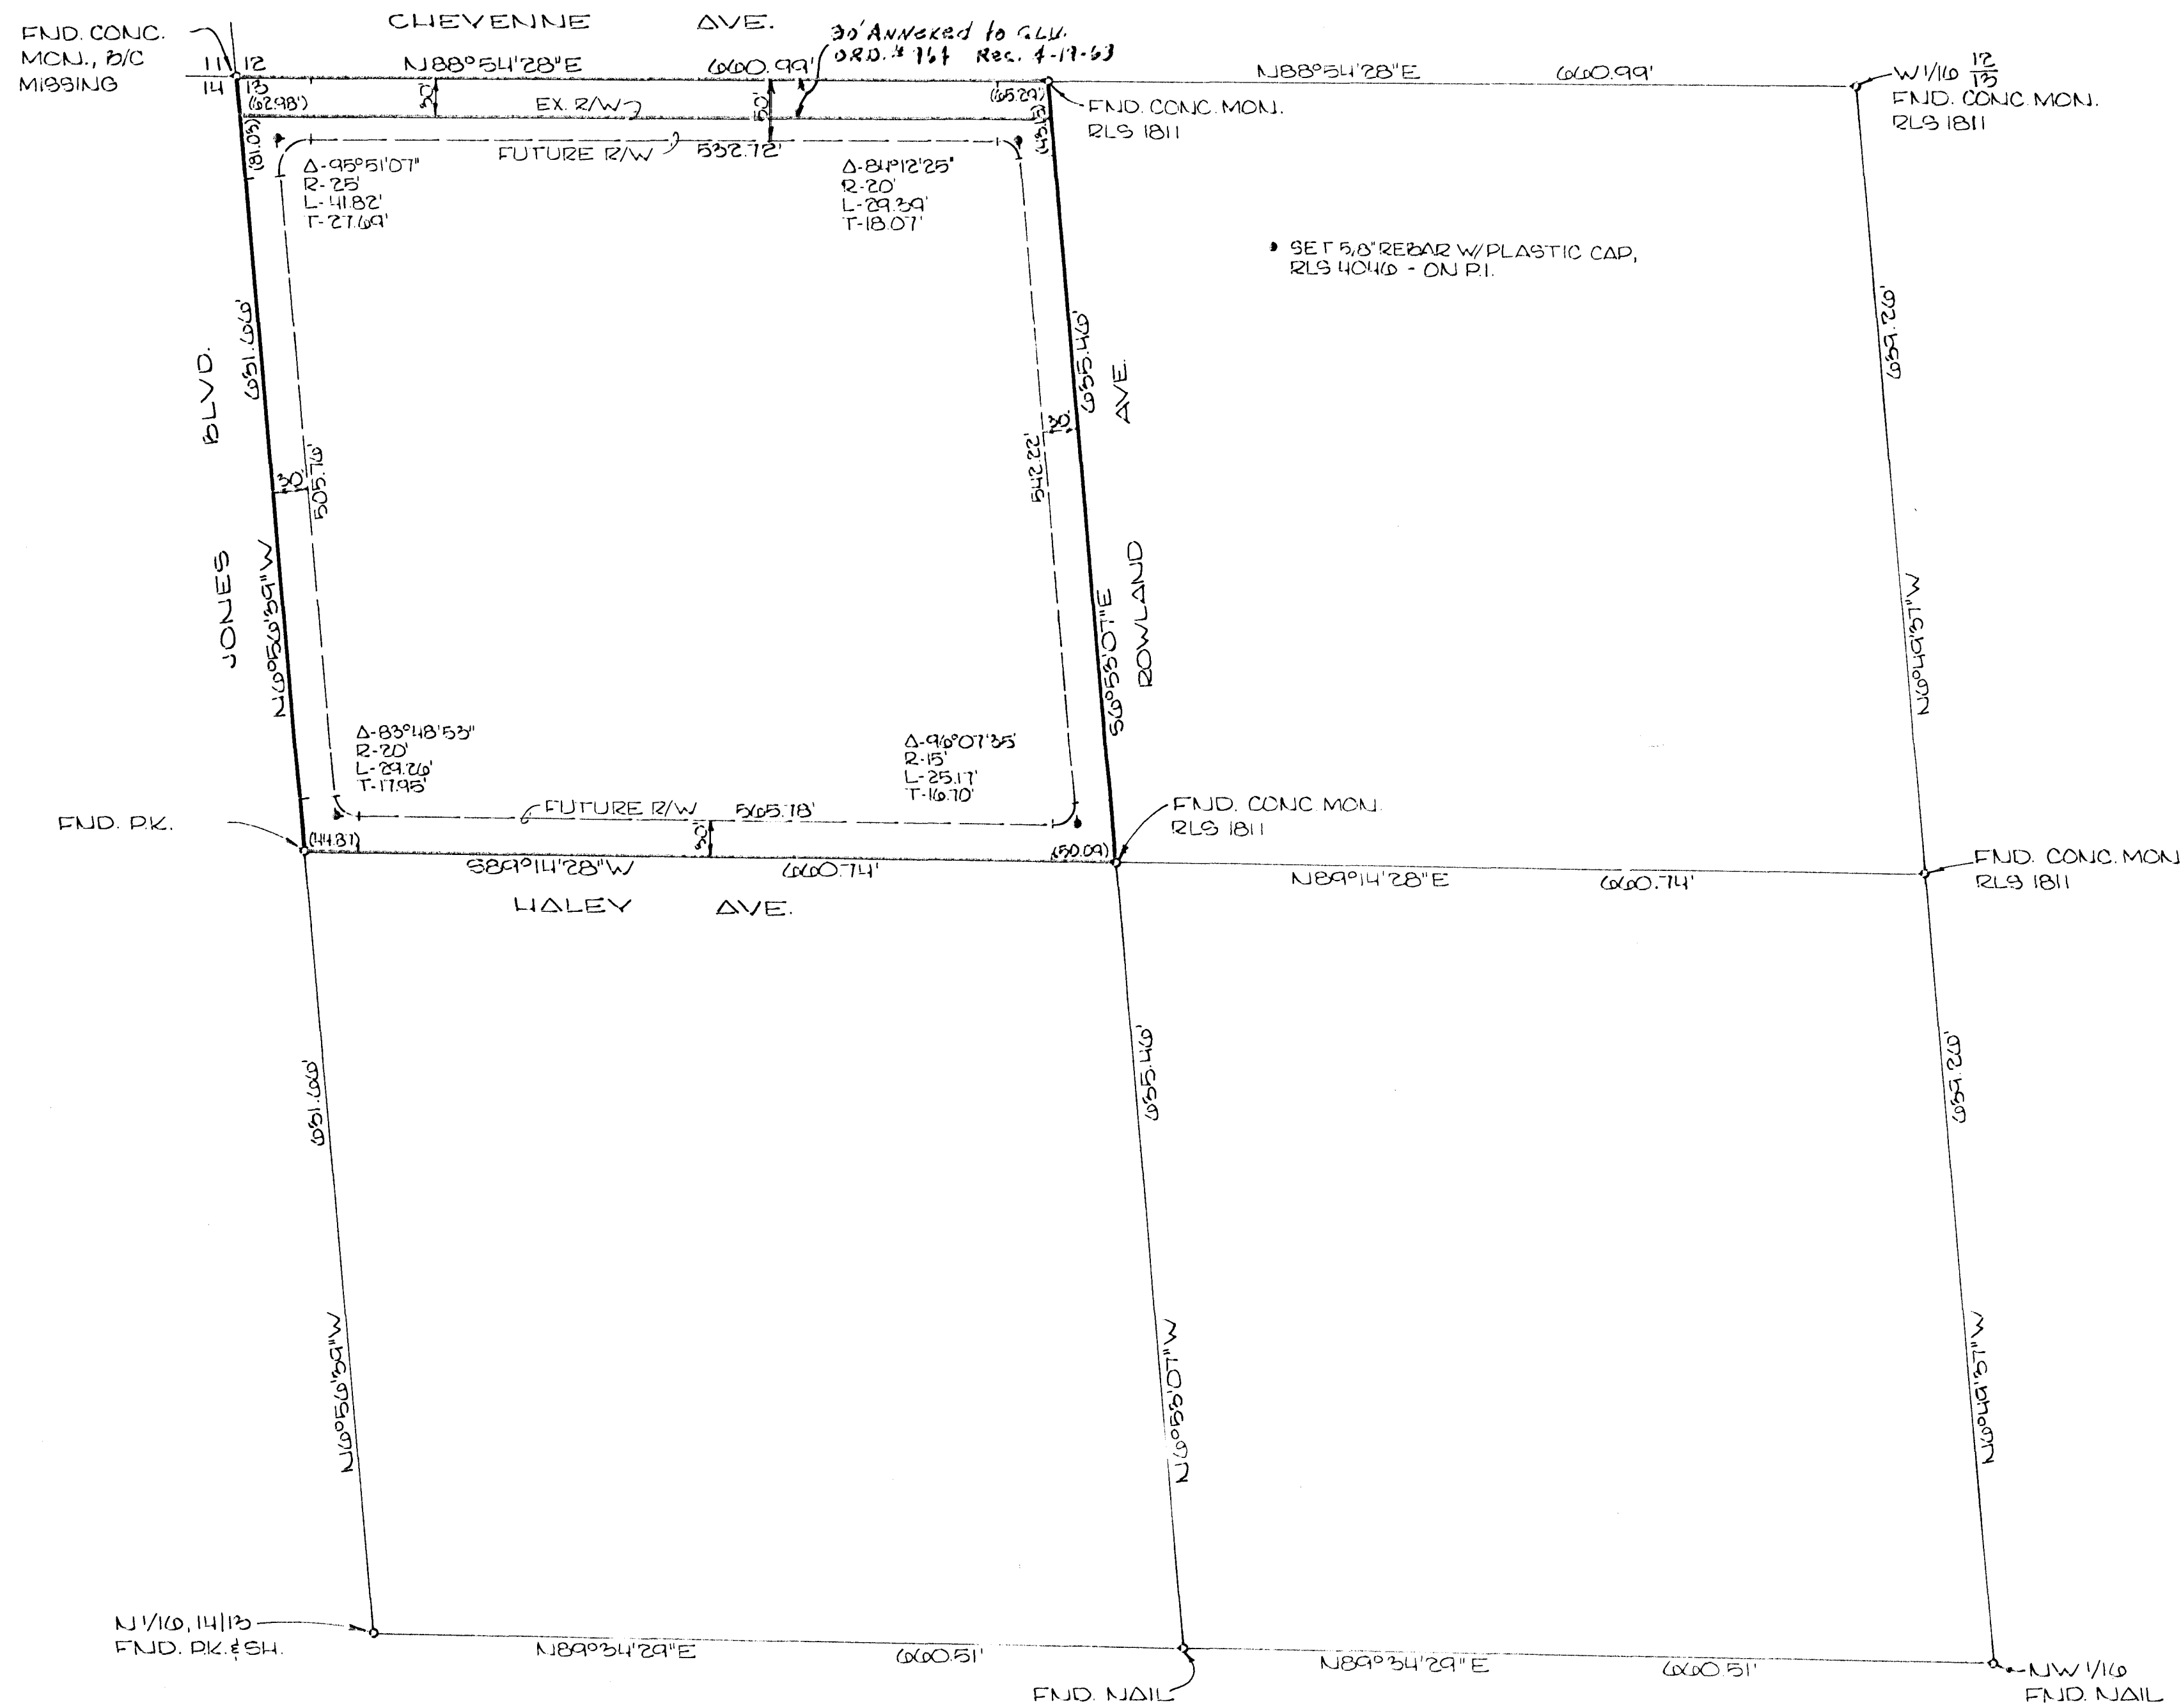

SURVEYOR'S CERTIFICATE
 I, JERRY E. BARNSON, A DULY REGISTERED LAND SURVEYOR IN THE STATE OF NEVADA, DO HEREBY CERTIFY THAT THE SURVEY OF THE LAND SHOWN HEREON WAS MADE UNDER MY DIRECT SUPERVISION AT THE INSTANCE OF PHILIP J. COHEN & ANDREW THOMPSON AND THE CITY OF LAS VEGAS, THAT THE SURVEY WAS COMPLETED ON SEPTEMBER 7, 1979, AND THAT THE POINTS FOUND AND SET ARE CORRECTLY SHOWN HEREON. THIS MAP DOES NOT CONSTITUTE A SUBDIVISION AS DEFINED BY NEVADA STATE LAW.

9/13/79
 DATE
 Jerry E. Barnson
 JERRY E. BARNSON
 REGISTERED LAND SURVEYOR
 NEVADA CERTIFICATE NO. 14046

BASIS OF BEARING
 N88°54'28"E, BEING THE NORTH LINE OF THE NW 1/4 OF THE NW 1/4 OF SEC. 13, T20S, R100E, MDM, CLARK CO., NEV. AS SHOWN BY A MAP ON FILE IN THE COUNTY RECORDER'S OFFICE IN FILE 8 OF PARCEL MAPS, PAGE 93.


LEGAL DESCRIPTION
 BEING THE NW 1/4 OF THE NW 1/4 OF THE NW 1/4 OF SECTION 13, T20S, R100E, MDM, CLARK COUNTY, NEVADA

ANNEXED TO THE CITY OF LAS VEGAS UNDER ORDINANCE NO. 2072

RECORD OF SURVEY OF THE NW 1/4 OF THE NW 1/4 OF SECTION 13, T20S, R100E, M.D.M.

NORTH
 1"=100'

NO.	1151040
FILED AT THE REQUEST OF:	CITY OF LAS VEGAS
DATED	2-21-80 AT 2:37 P.M.
FILE	35 PAGE 66
OF SURVEYS	
OFFICIAL RECORDS BOOK NO.	
CLARK COUNTY, NEVADA RECORDS	
JOAN L. SWIFT, RECORDER	
FEE \$ 5.00	DEPUTY BY 6

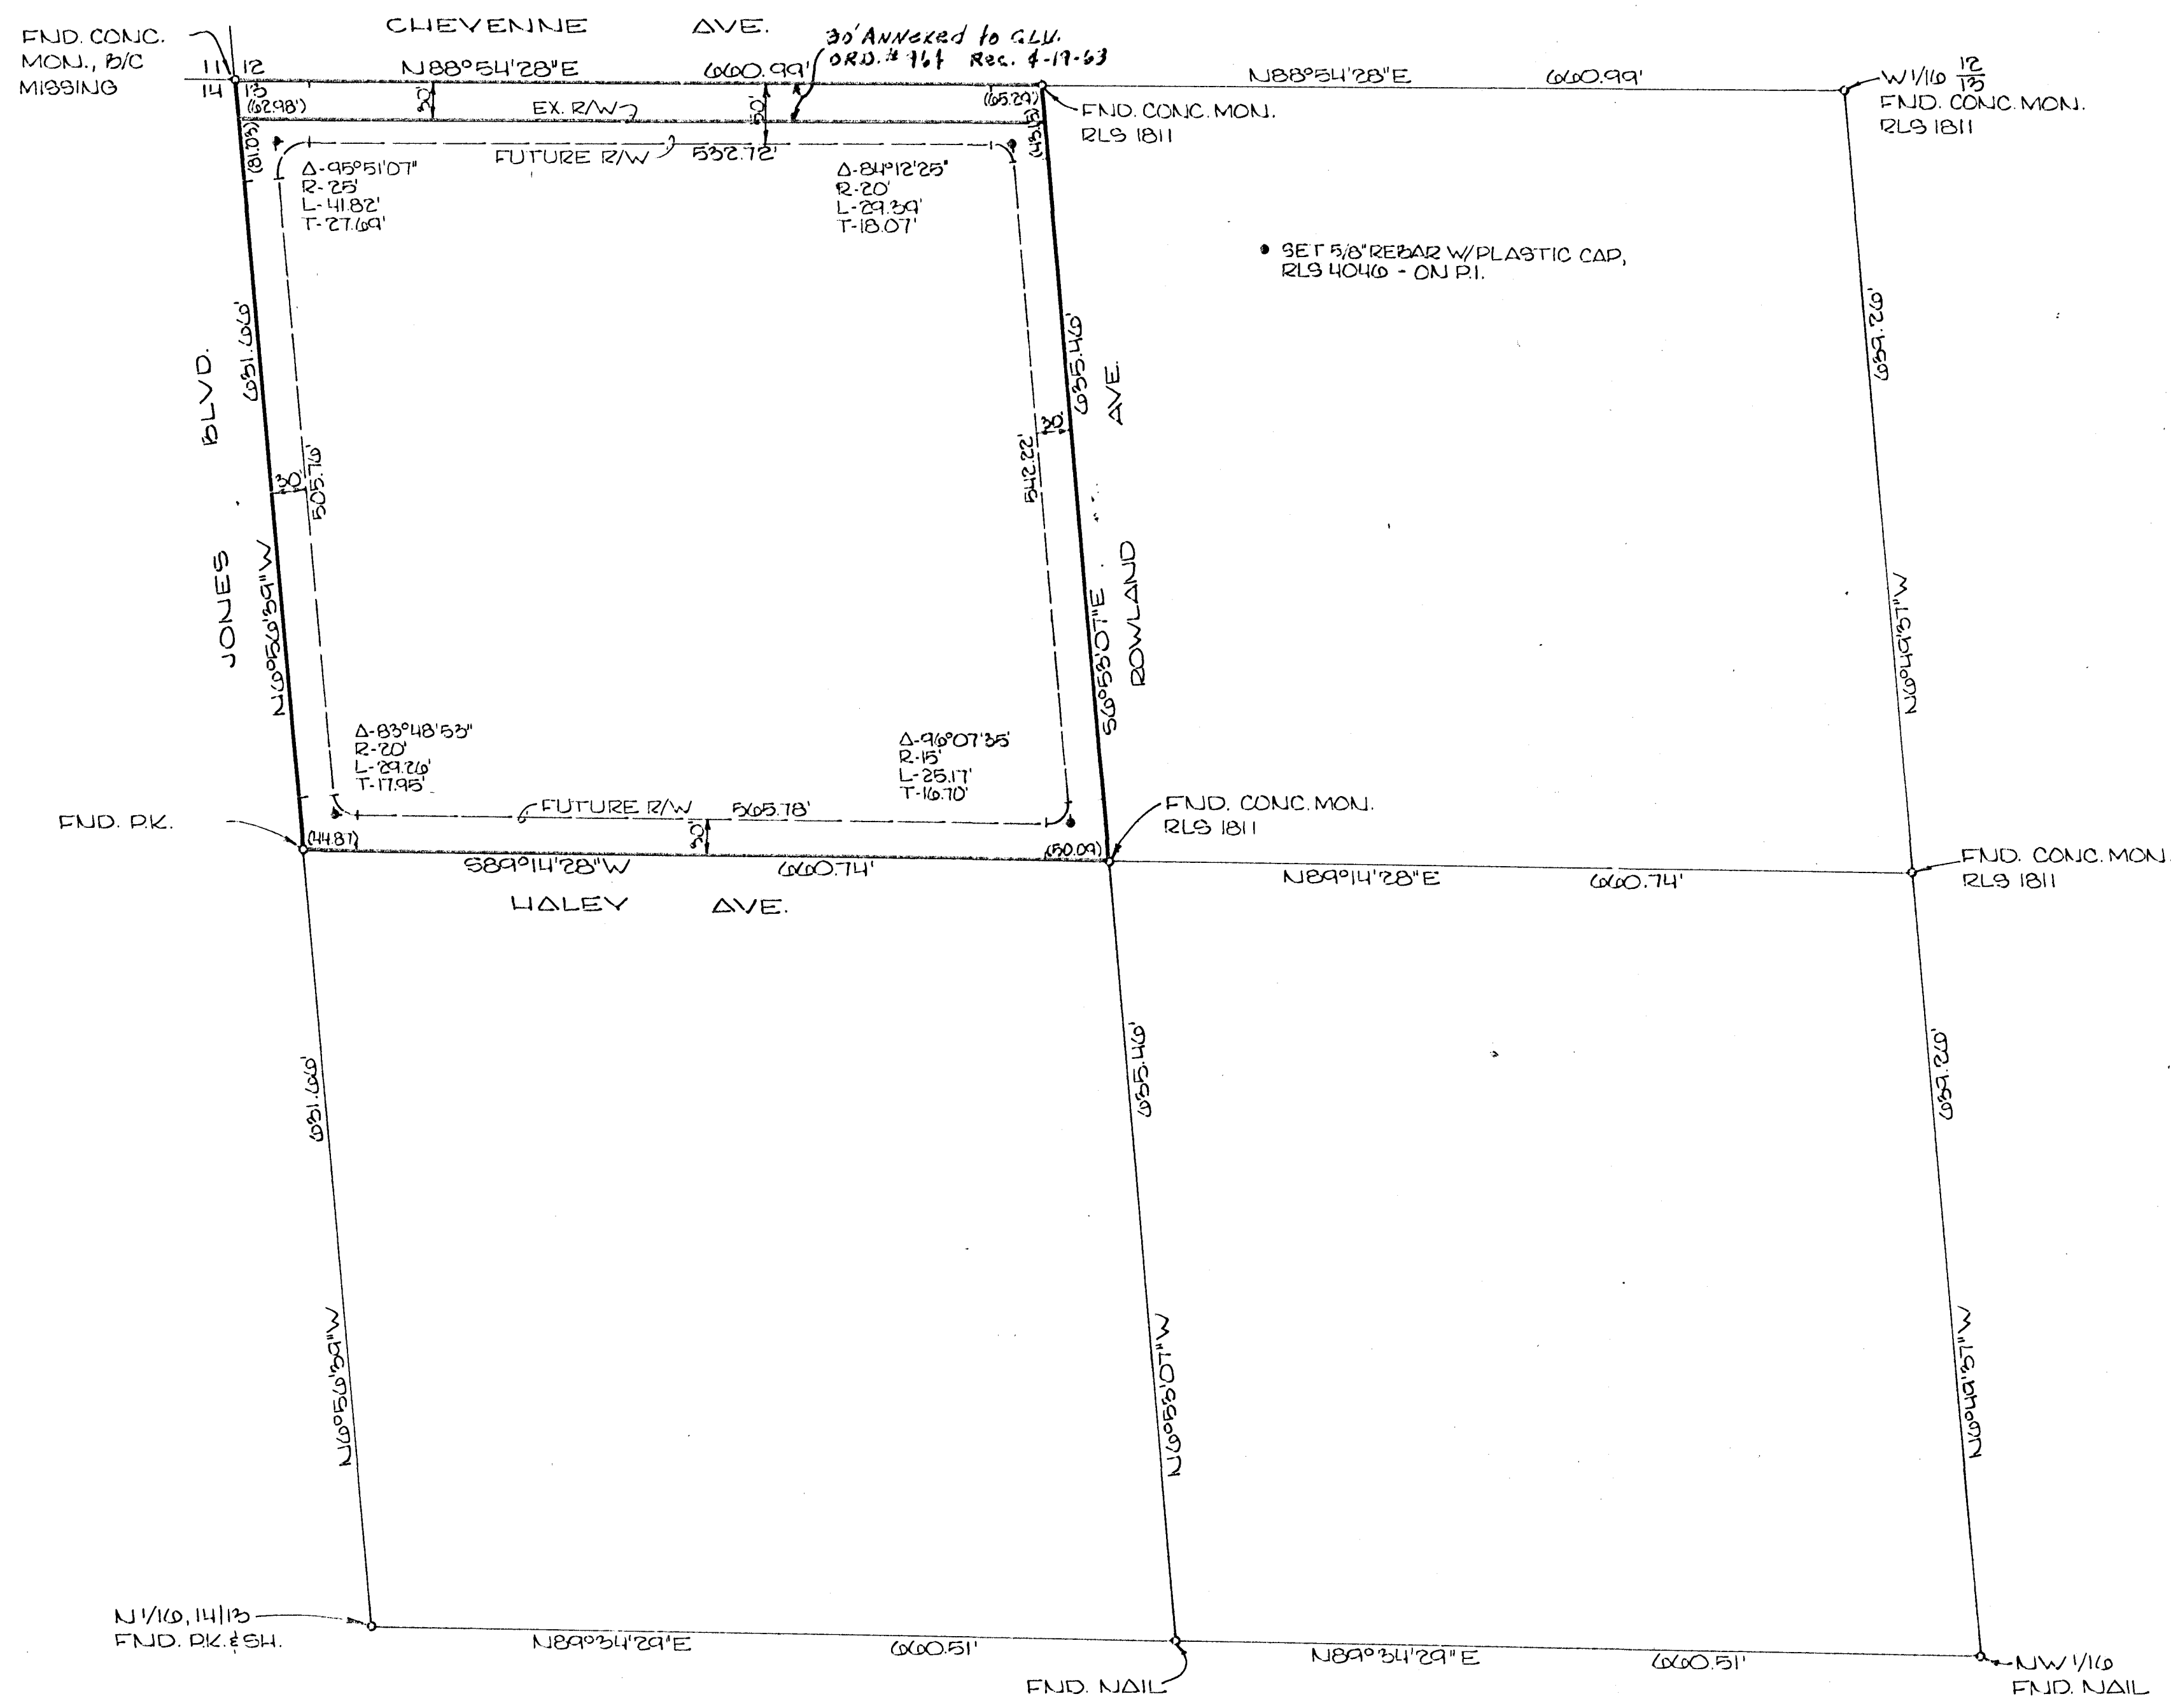

SURVEYOR'S CERTIFICATE
 I, JERRY E. BARNSON, A DULY REGISTERED LAND SURVEYOR IN THE STATE OF NEVADA, DO HEREBY CERTIFY THAT THE SURVEY OF THE LAND SHOWN HEREON WAS MADE UNDER MY DIRECT SUPERVISION AT THE INSTANCE OF PHILIP J. COHEN & ANDREW THOMPSON AND THE CITY OF LAS VEGAS, THAT THE SURVEY WAS COMPLETED ON SEPTEMBER 7, 1979, AND THAT THE POINTS FOUND AND SET ARE CORRECTLY SHOWN HEREON. THIS MAP DOES NOT CONSTITUTE A SUBDIVISION AS DEFINED BY NEVADA STATE LAW.

DATE 9/18/79
Jerry E. Barnson
 JERRY E. BARNSON
 REGISTERED LAND SURVEYOR
 NEVADA CERTIFICATE NO. 14046

BASIS OF BEARING
 N88°54'28"E, BEING THE NORTH LINE OF THE NW 1/4 OF THE NW 1/4 OF SEC. 13, T20S, R20E, MDM, CLARK CO, NEV, AS SHOWN BY A MAP ON FILE IN THE COUNTY RECORDER'S OFFICE IN FILE 8 OF PARCEL MAPS, PAGE 93.

LEGAL DESCRIPTION
 BEING THE NW 1/4 OF THE NW 1/4 OF THE NW 1/4 OF SECTION 13, T20S, R20E, MDM, CLARK COUNTY, NEVADA.

ANNEXED TO THE CITY OF LAS VEGAS UNDER ORDINANCE NO. _____

RECORD OF SURVEY OF THE NW 1/4 OF THE NW 1/4 OF SECTION 13, T20S, R20E, M.D.M.

NORTH 1"=100'

NO. _____
FILED AT THE REQUEST OF: _____
DATED _____ AT _____, M.
FILE _____ PAGE _____
OF SURVEYS _____
OFFICIAL RECORDS BOOK NO. _____
CLARK COUNTY, NEVADA RECORDS
JOAN L. SWIFT, RECORDER
FEE \$ _____ DEPUTY _____