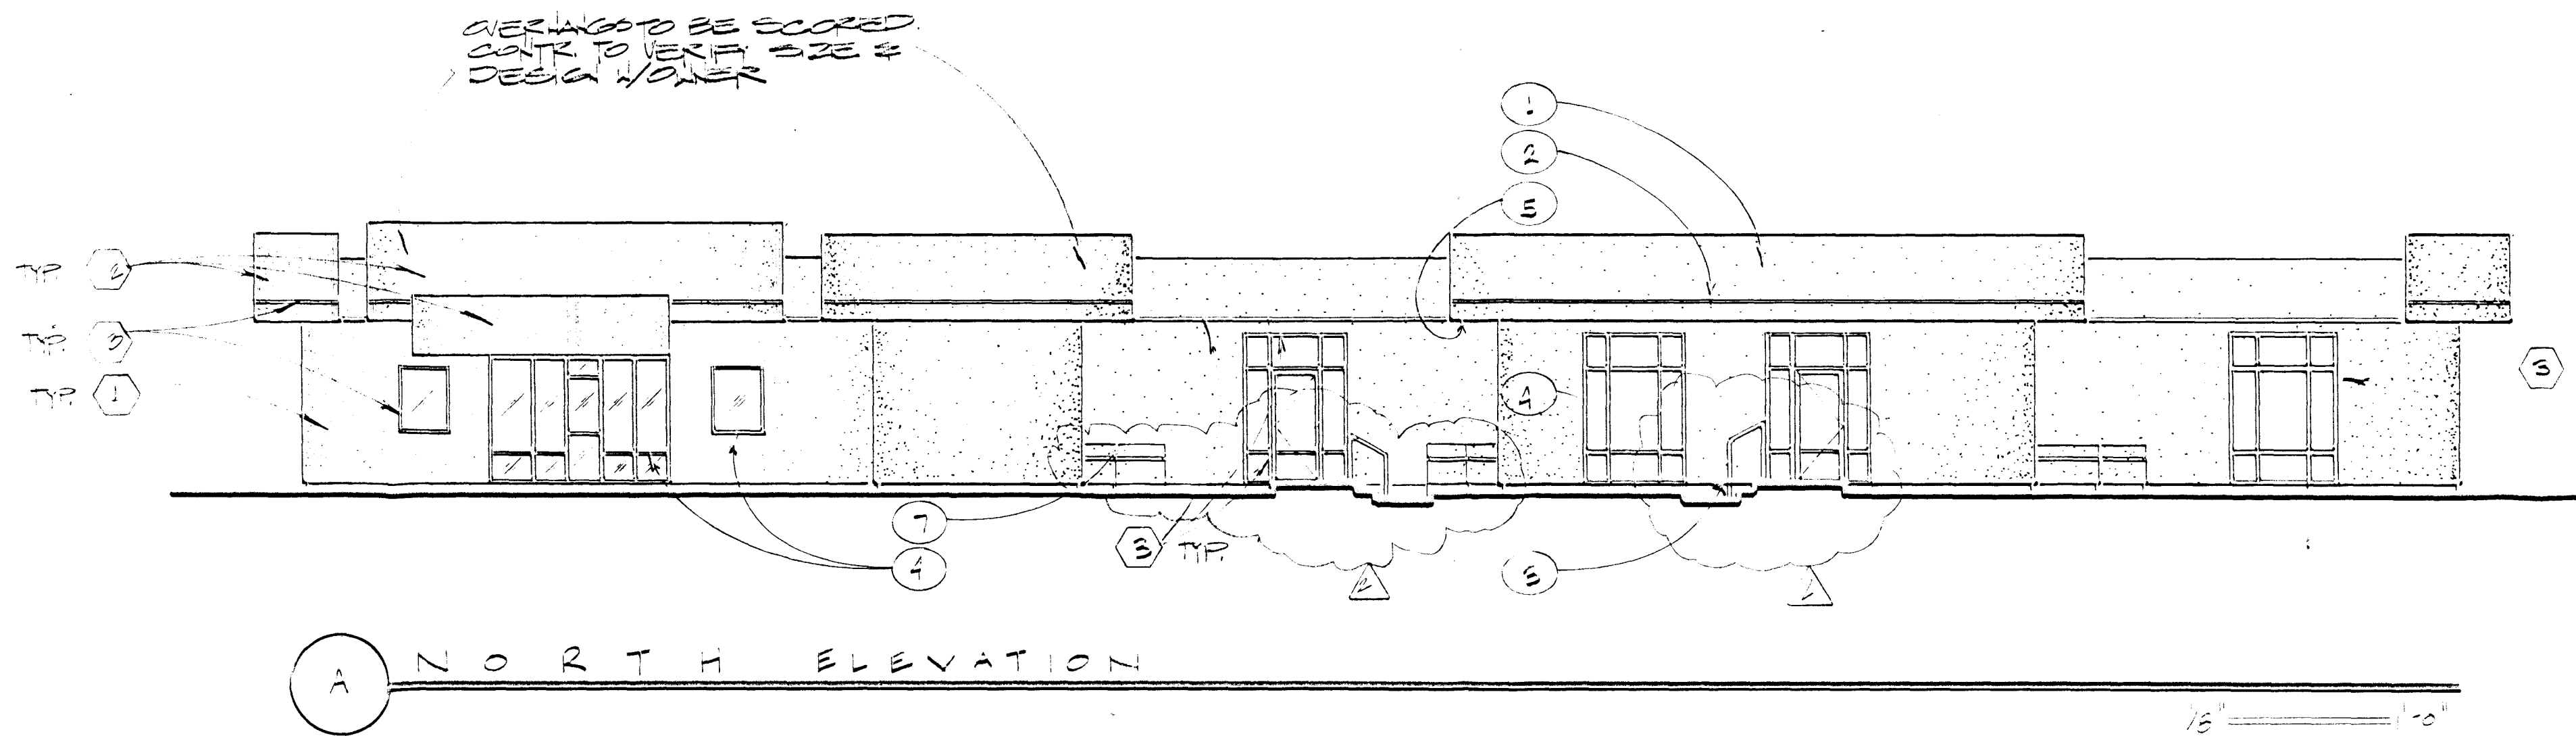


NOTE: (THIS SHEET ONLY)


1. STUCCO (TYPICAL)
2. PLASTER CHANNEL SCORED MODEL
WPCS-75-200 PAINTED
3. STUCCO SCORED CONT. (TYP.)
4. ALUM. WDW. UNIT SEE 19/A-1
5. STUCCO SOFFIT SEE 7.09/A-1
6. DIAPER WASTE CABINET SEE DET. 13/A-2
7. 2'-6" HIGH STUCCO PLANTER SEE 12/A-2
8. 42" HIGH STUCCO WALL
9. 1 1/2" Ø METAL HANDRAIL

EXTERIOR FINISHES
(BY PITCHER & PATE)

- 1 = 100% BRONZE WHITE
- 2 = 25% OLD LIME
- 3 = 70% DEEP MARINE

CONTR. TO VERT. LINE # COORDINATE
BY EXTER. FINISHES
DESIGNER

CITY BANK PARK
3900 paradise road
suite 165
las vegas, nv 89109
(702) 737-8049

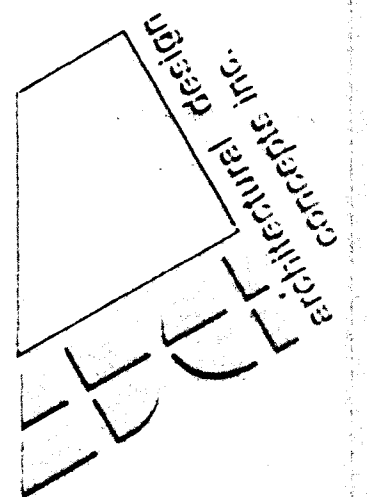

CREATIVE KIDS
LAS VEGAS, NV 89109

EXTERIOR ELEVATION

SHEET TITLE

REVISION

DRAWN BY

CHECKED BY

DATE

JOB #


SHEET #

CF

DO NOT SCALE DRAWING
ALL DIMENSIONS SHOWN ON THIS DRAWING ARE TO BE USED TO VERIFY
ALL DIMENSIONS AND FINISHES BEFORE CONSTRUCTION
ALL DIMENSIONS ARE TO BE USED TO VERIFY
ALL DIMENSIONS AND FINISHES BEFORE CONSTRUCTION

CC-7/5/89-APP
PC-6/8/89-APP

Z-53-89

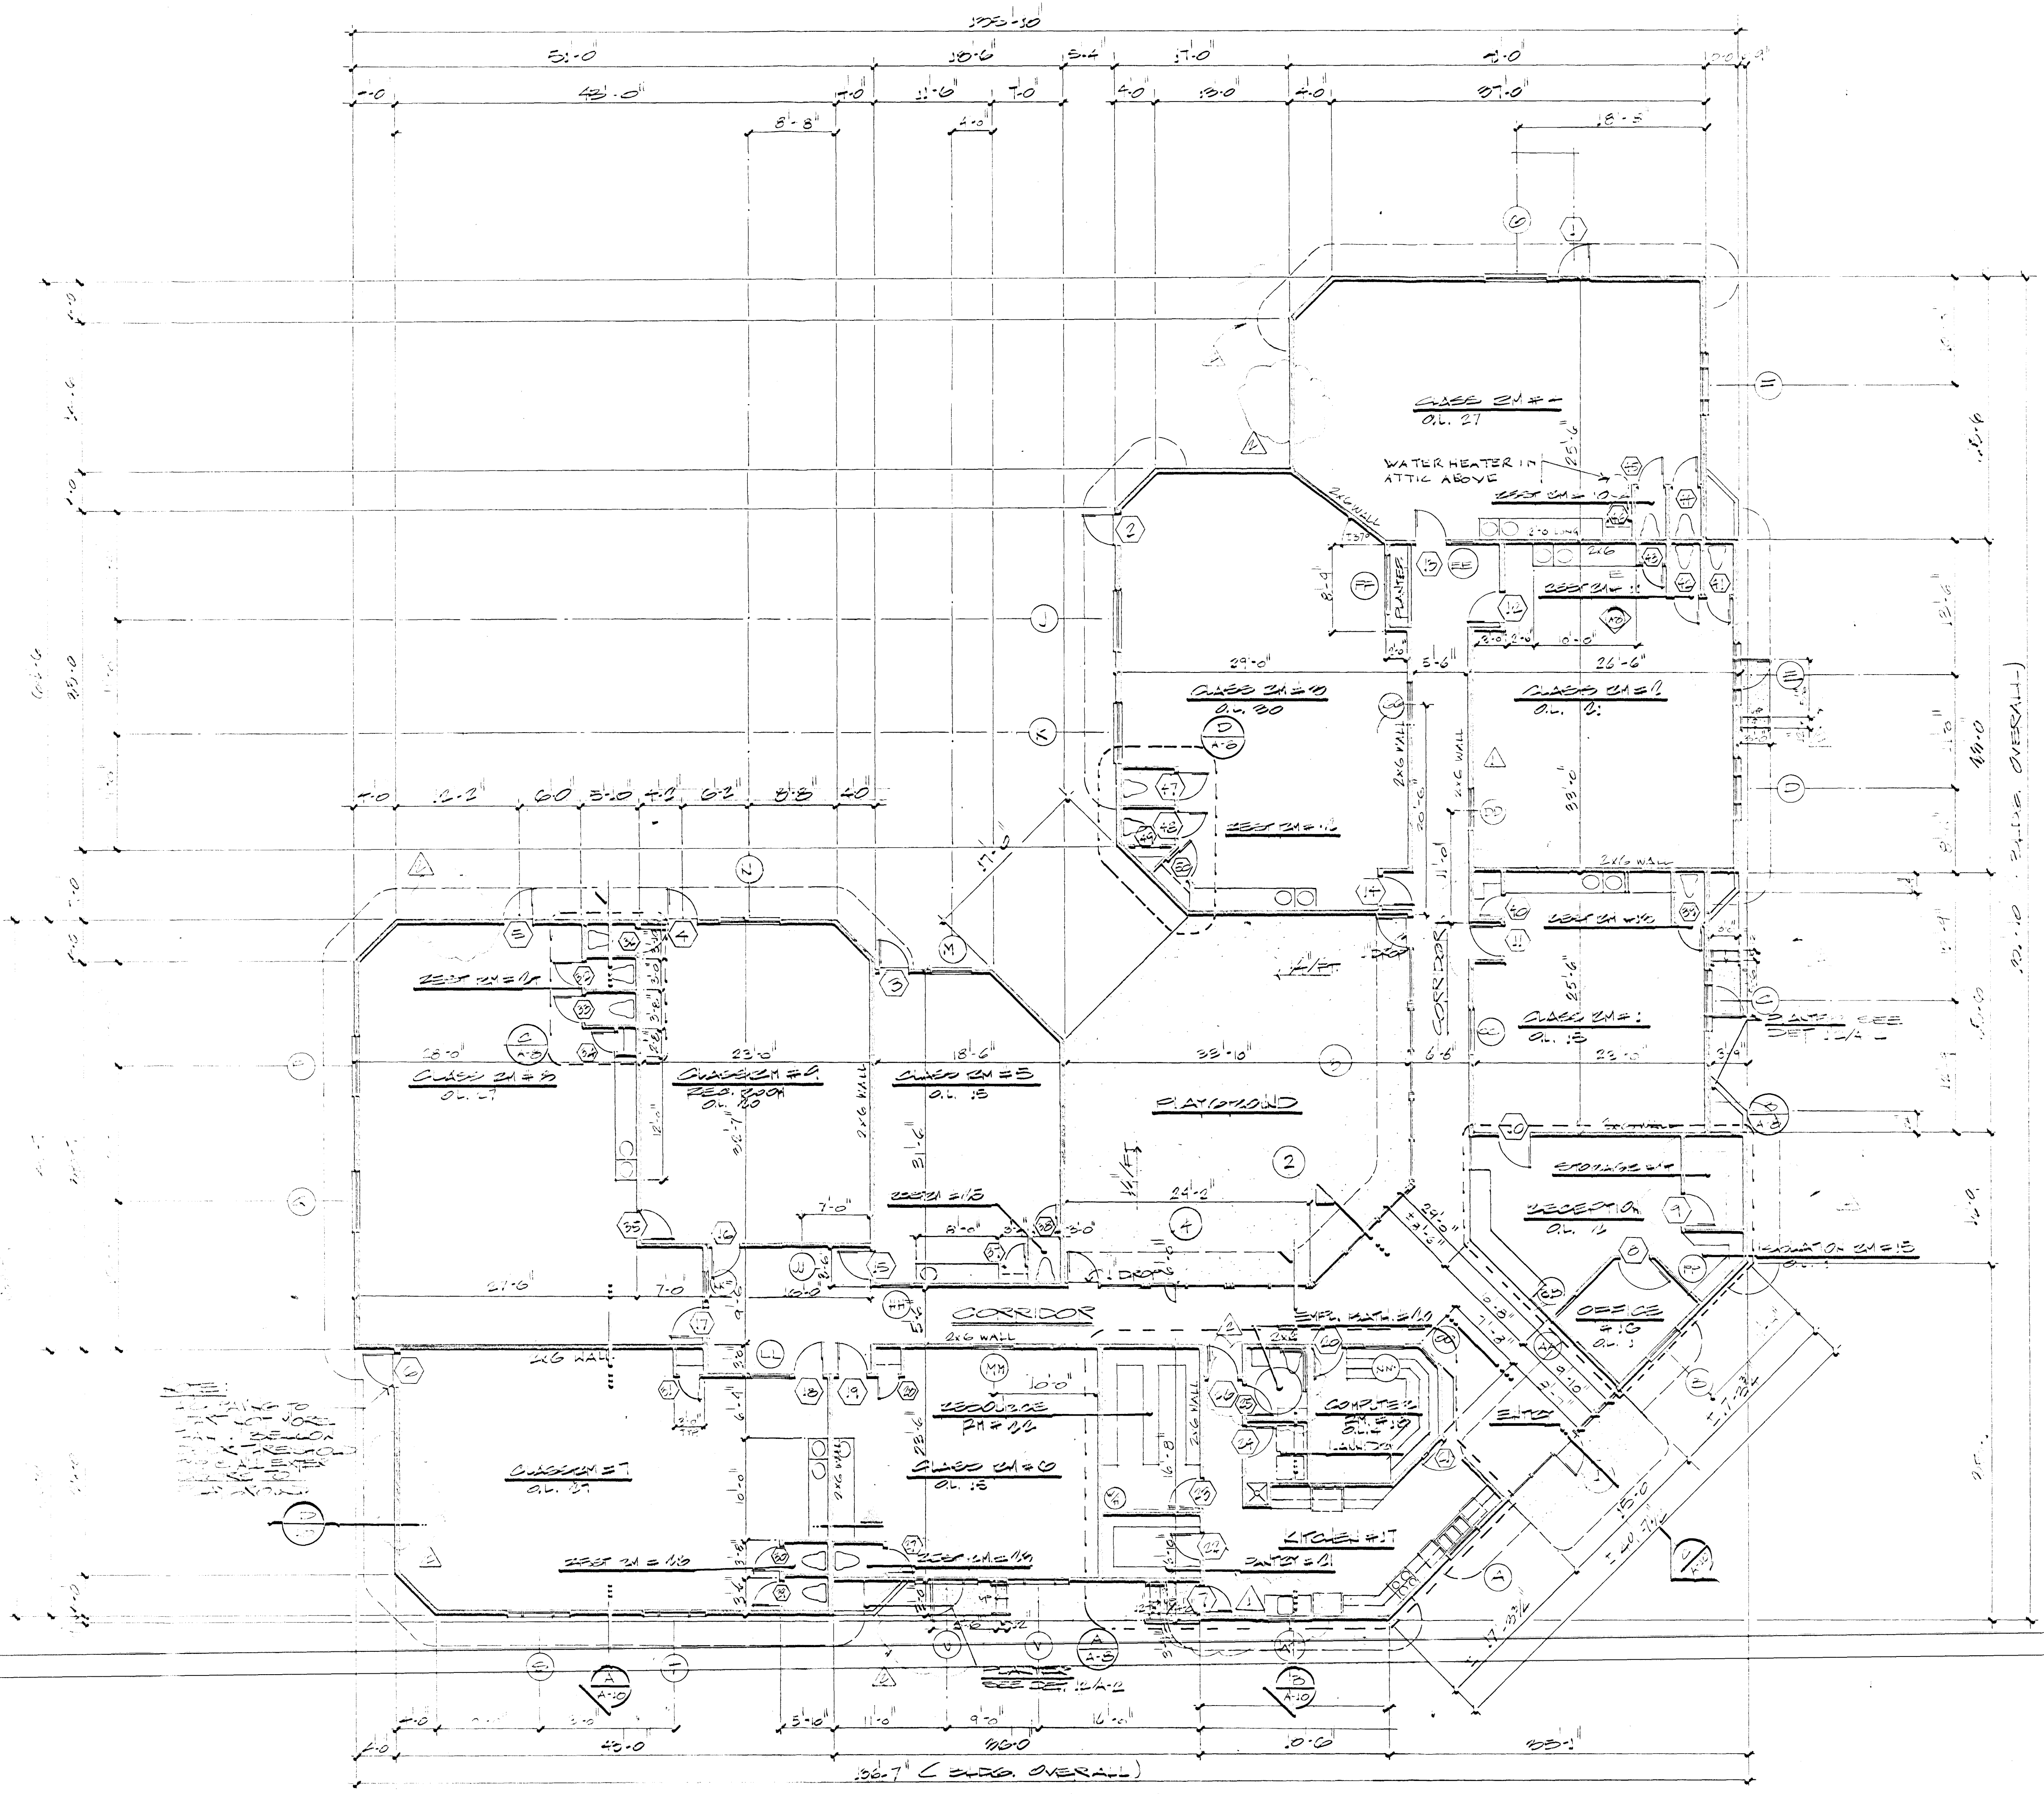


FLOOR PLAN

10' = 1" SCALE

Z-53-89 RC 6/8/89

STAFF COPY

CITY FRANK PARK
3800 Paradise Road
Suite 105
Las Vegas, NV 89109
(702) 731-8049

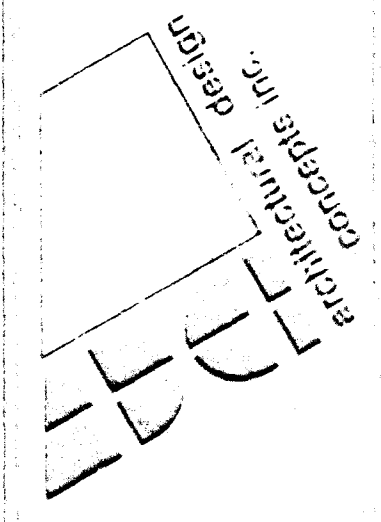

CREATIVE KIDS
145 VI CAS, RIVADA

REVISION PLAN
DO NOT SCALE DRAWING.
ALL DIMENSIONS ARE TO FACE UNLESS NOTED OTHERWISE.
ALL DIMENSIONS ARE TO FACE UNLESS NOTED OTHERWISE.

REVISION	DATE	BY
1	5-8-89	60011A
2		
3		
4		
5		
6		
7		
8		
9		
10		

This architectural drawing shows a long, low building facade. On the left side, there is a small square window and a door. The central part of the facade features a large, rectangular window. To the right of this window is a door, followed by another large rectangular window. The building has a flat roof and a simple, modern design. The drawing is rendered in black lines on a white background, with a stippled texture used for shading.

[illegible]

Architectural elevation drawing of a building facade. The drawing shows a long, low structure with several windows and doors. The windows are arranged in a row, with some having multiple panes. The doors are located towards the right side of the facade. The drawing includes handwritten notes and dimensions, such as "10' 0\"/>

1. STUCCO (TYPICAL)
2. PLASTER CHANNEL SCREEN MODEL
#PCS-75-200 PAINTED
3. STUCCO SCREEN CONT. (TYP.)
4. ALUM. WDW. UNIT 12" X 12" X 1/2"
5. STUCCO SOFFIT 1/2" X 1/2" X 1/2"
6. DIAPER WASTE CABINET 12" X 12" X 12"
7. 2'-6" HIGH STUCCO PLANTER 12" X 12" X 12"
8. 42" HIGH STUCCO WALL
9. 1 1/2" Ø METAL HANDRAIL

EXTENDED RANGE

(EXTENDED RANGE)

① = 1000 - 2000 - 4000

② = 1000 - 2000 - 4000

③ = 1000 - 2000 - 4000

2020年11月11日
 2020年11月11日
 2020年11月11日

CFT BANK PARK
3900 paradise road
suite 165
las vegas, nv 89109
(702) 737-8049

architectural design
concept inc.

CRITICAL KIDS

178 VICTOR, REYNOLDS

EXTERIOR ELEVATION

DO NOT SCALE DRAWINGS
WHEN DIMENSIONS PRECEDE OVER SIZE DIMENSIONS, CONTRACTOR TO FIELD VERIFY
ALL EXISTING CONDITIONS DURING AND PRIOR TO START OF CONSTRUCTION
IN ORDER TO AVOID ANY DISCREPANCIES BEFORE PROCEEDING
ALL RIGHTS RESERVED BY ARCHITECT

SHEET TITLE _____

REVISION _____

DRAWN BY _____

CHECKED BY _____

DATE 06-08-08

JOB # 000174

SHEET # 1-1

OF 1

STAFF
COPY

Z-53-89

PC 6/8/89