


36-4

C.T. 1.04

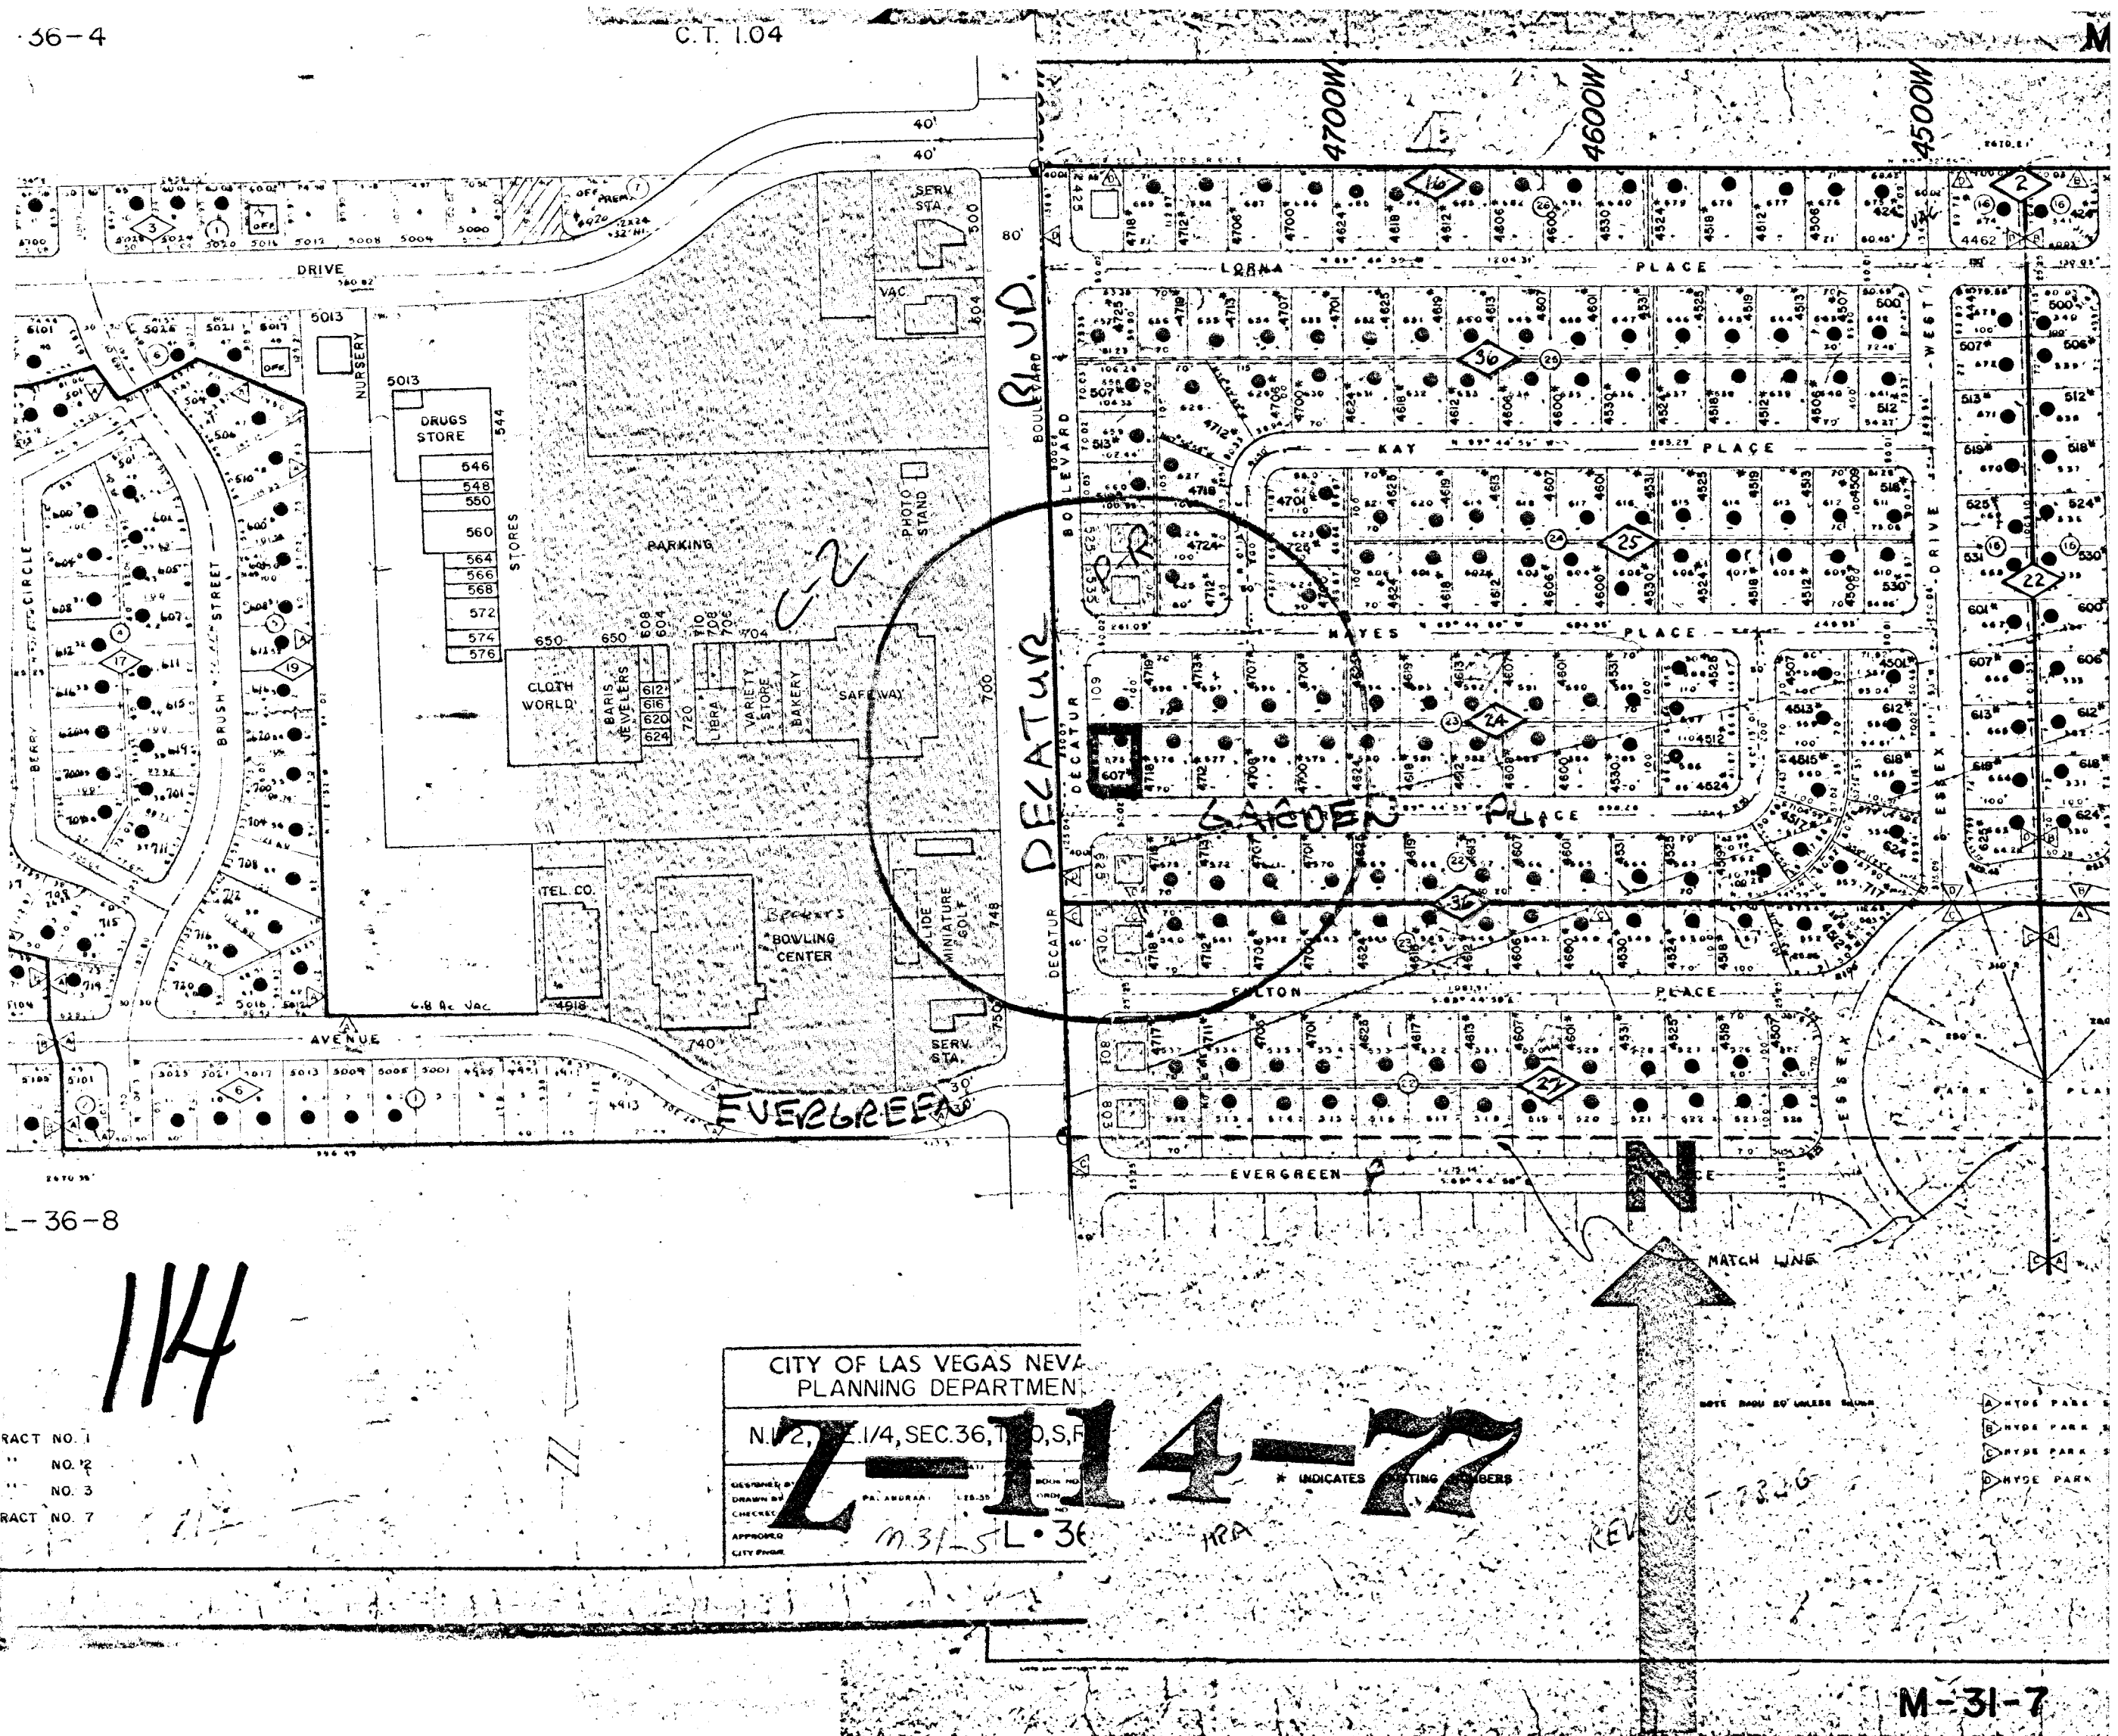

Z-114-77