


← Z

REVISIONS	BY


as 12/17/87 appd
PC 12/24/87 appd

Z-114-87

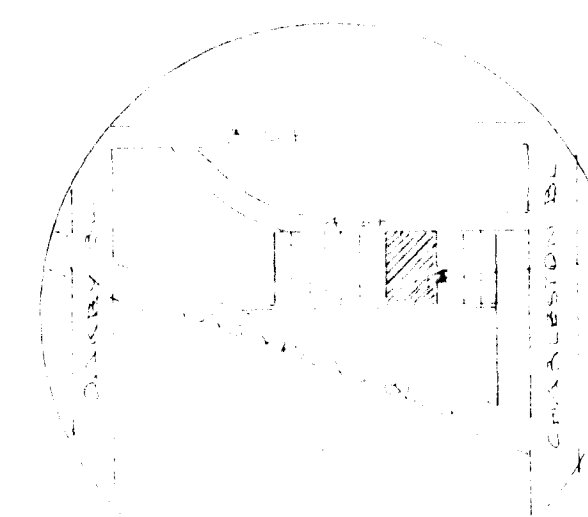

VICINITY MAP

ALLEY

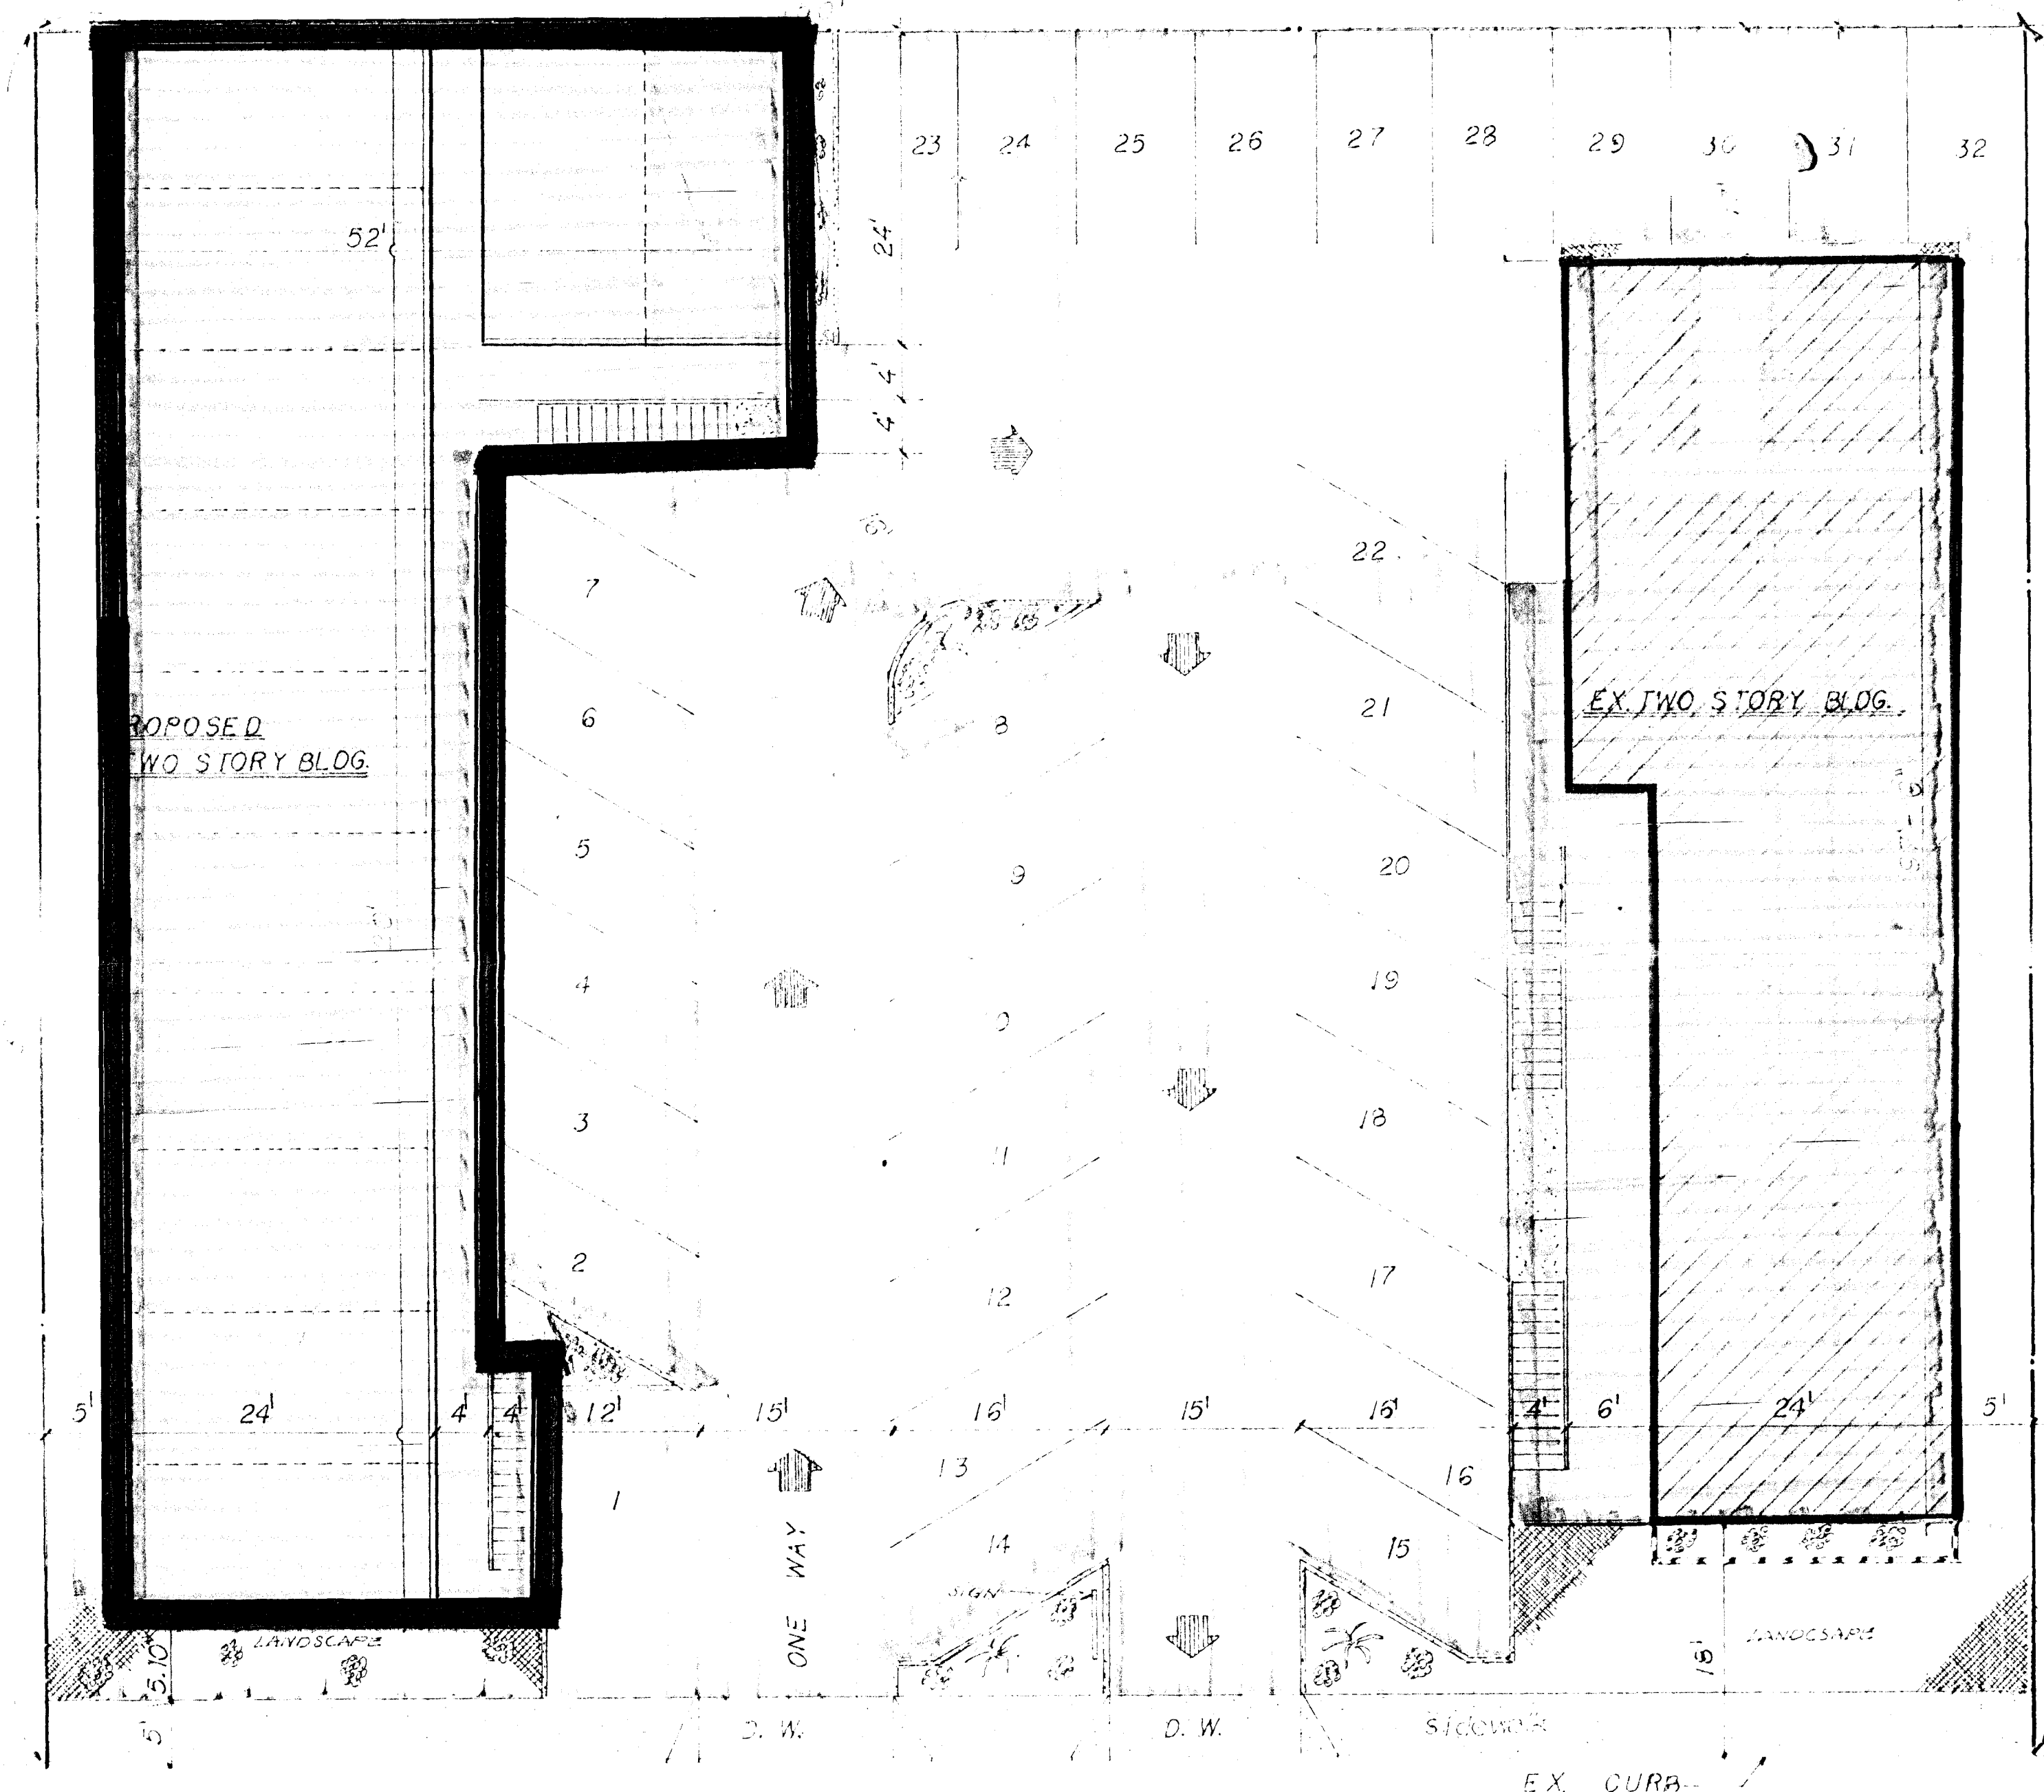

4TH ST.

HIGH HAT REGENCY MOTEL
ROOM ADDITION (24)

S I T E P L A N SCALE: 1" = 10'


TOTAL PARKING	32
REQ.	32

Date:	12/19/87
Scale:	1" = 10'
Drawn:	A.S.
Job:	
Sheet:	S
Of:	1 Sheets


REVISIONS	BY

Date	10-30-87
Scale	1/8" = 1'-0"
Drawn	JAC
Job	
Sheet	
Of	Sheets


10-11-87

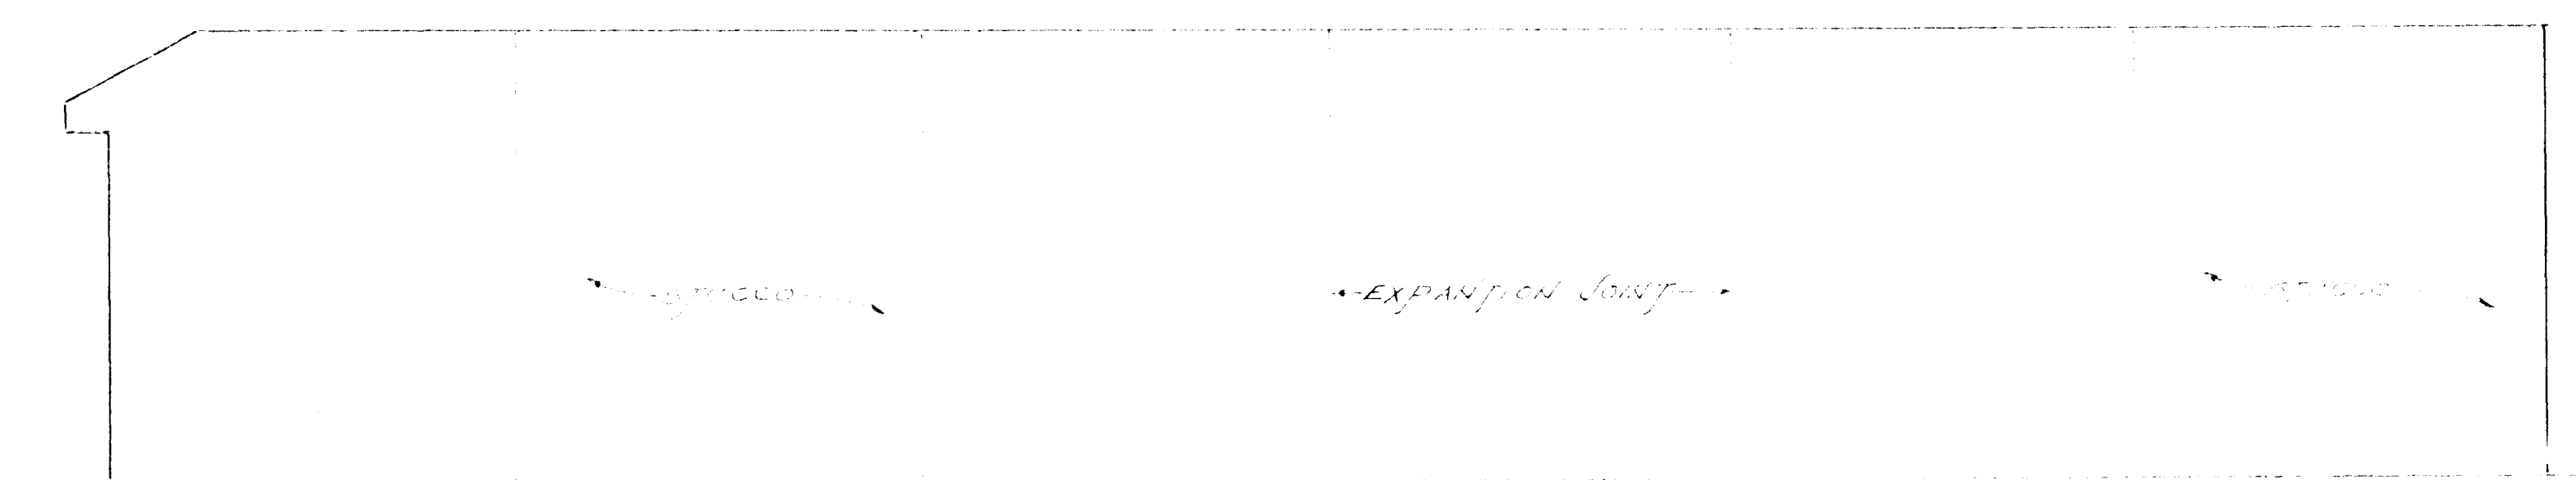


NORTH SIDE

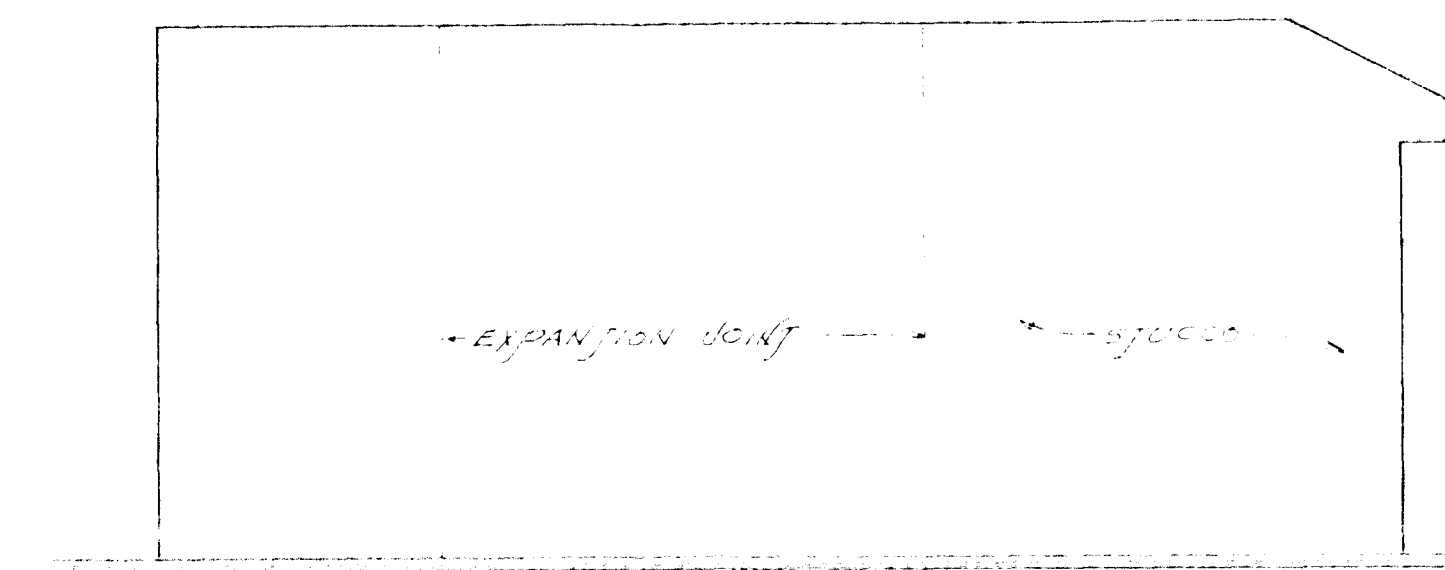

WEST SIDE

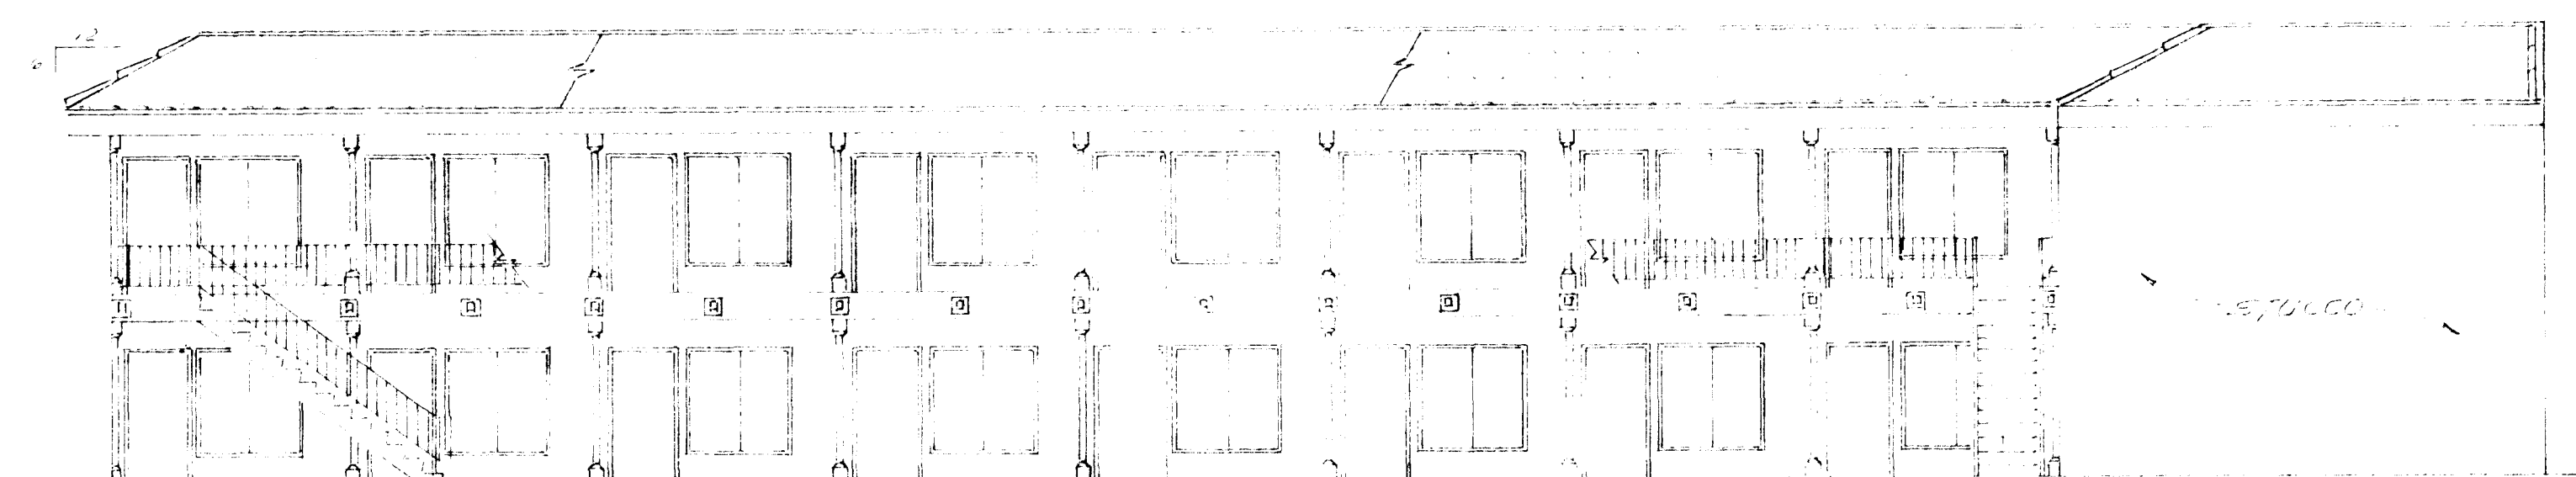

SOUTH SIDE


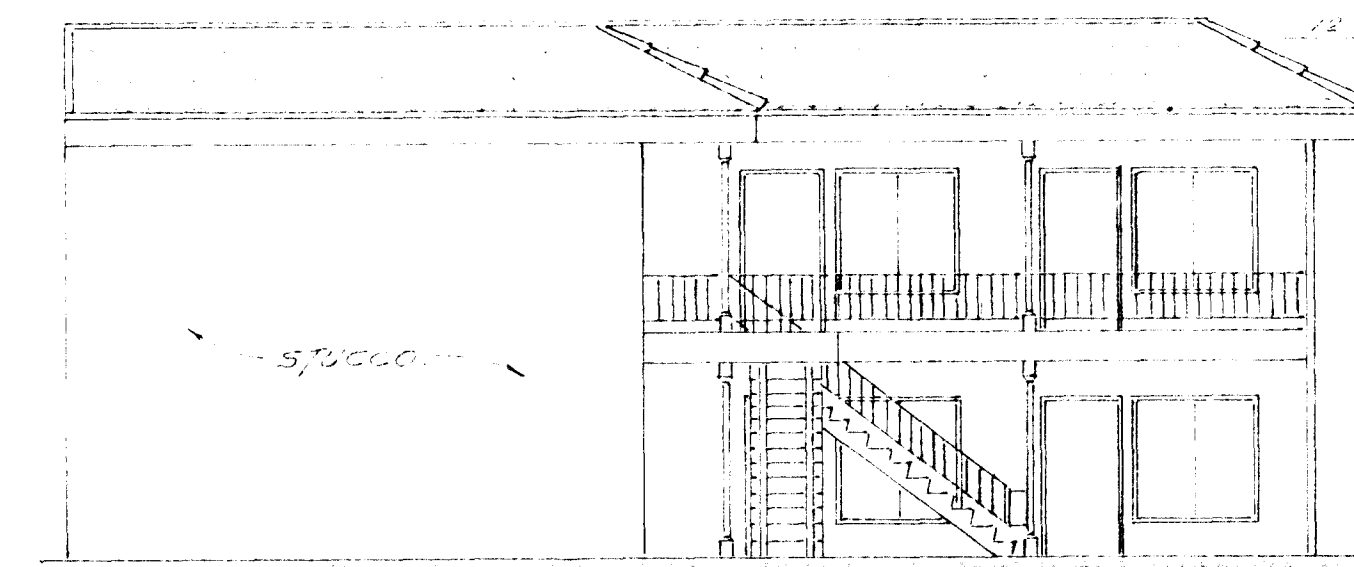


EAST SIDE


W. BAL. BALUSTERS @ 6" O.C.

cc 12/17/87 appd.
P.C. 11/24/87 appd.

Z-114-87

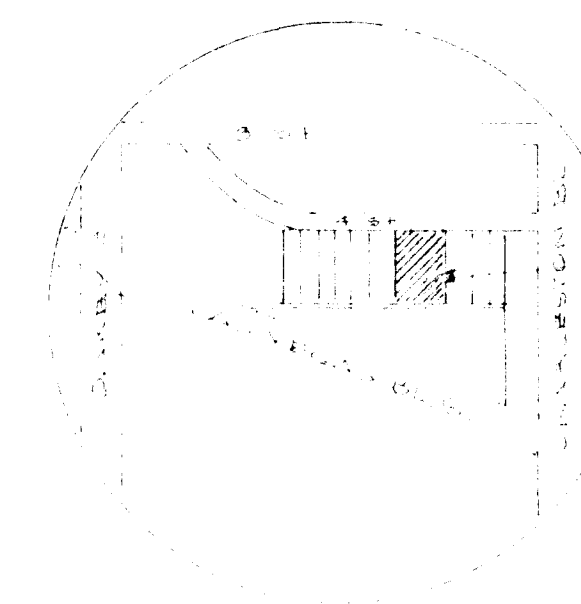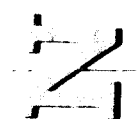


VICINITY MAP

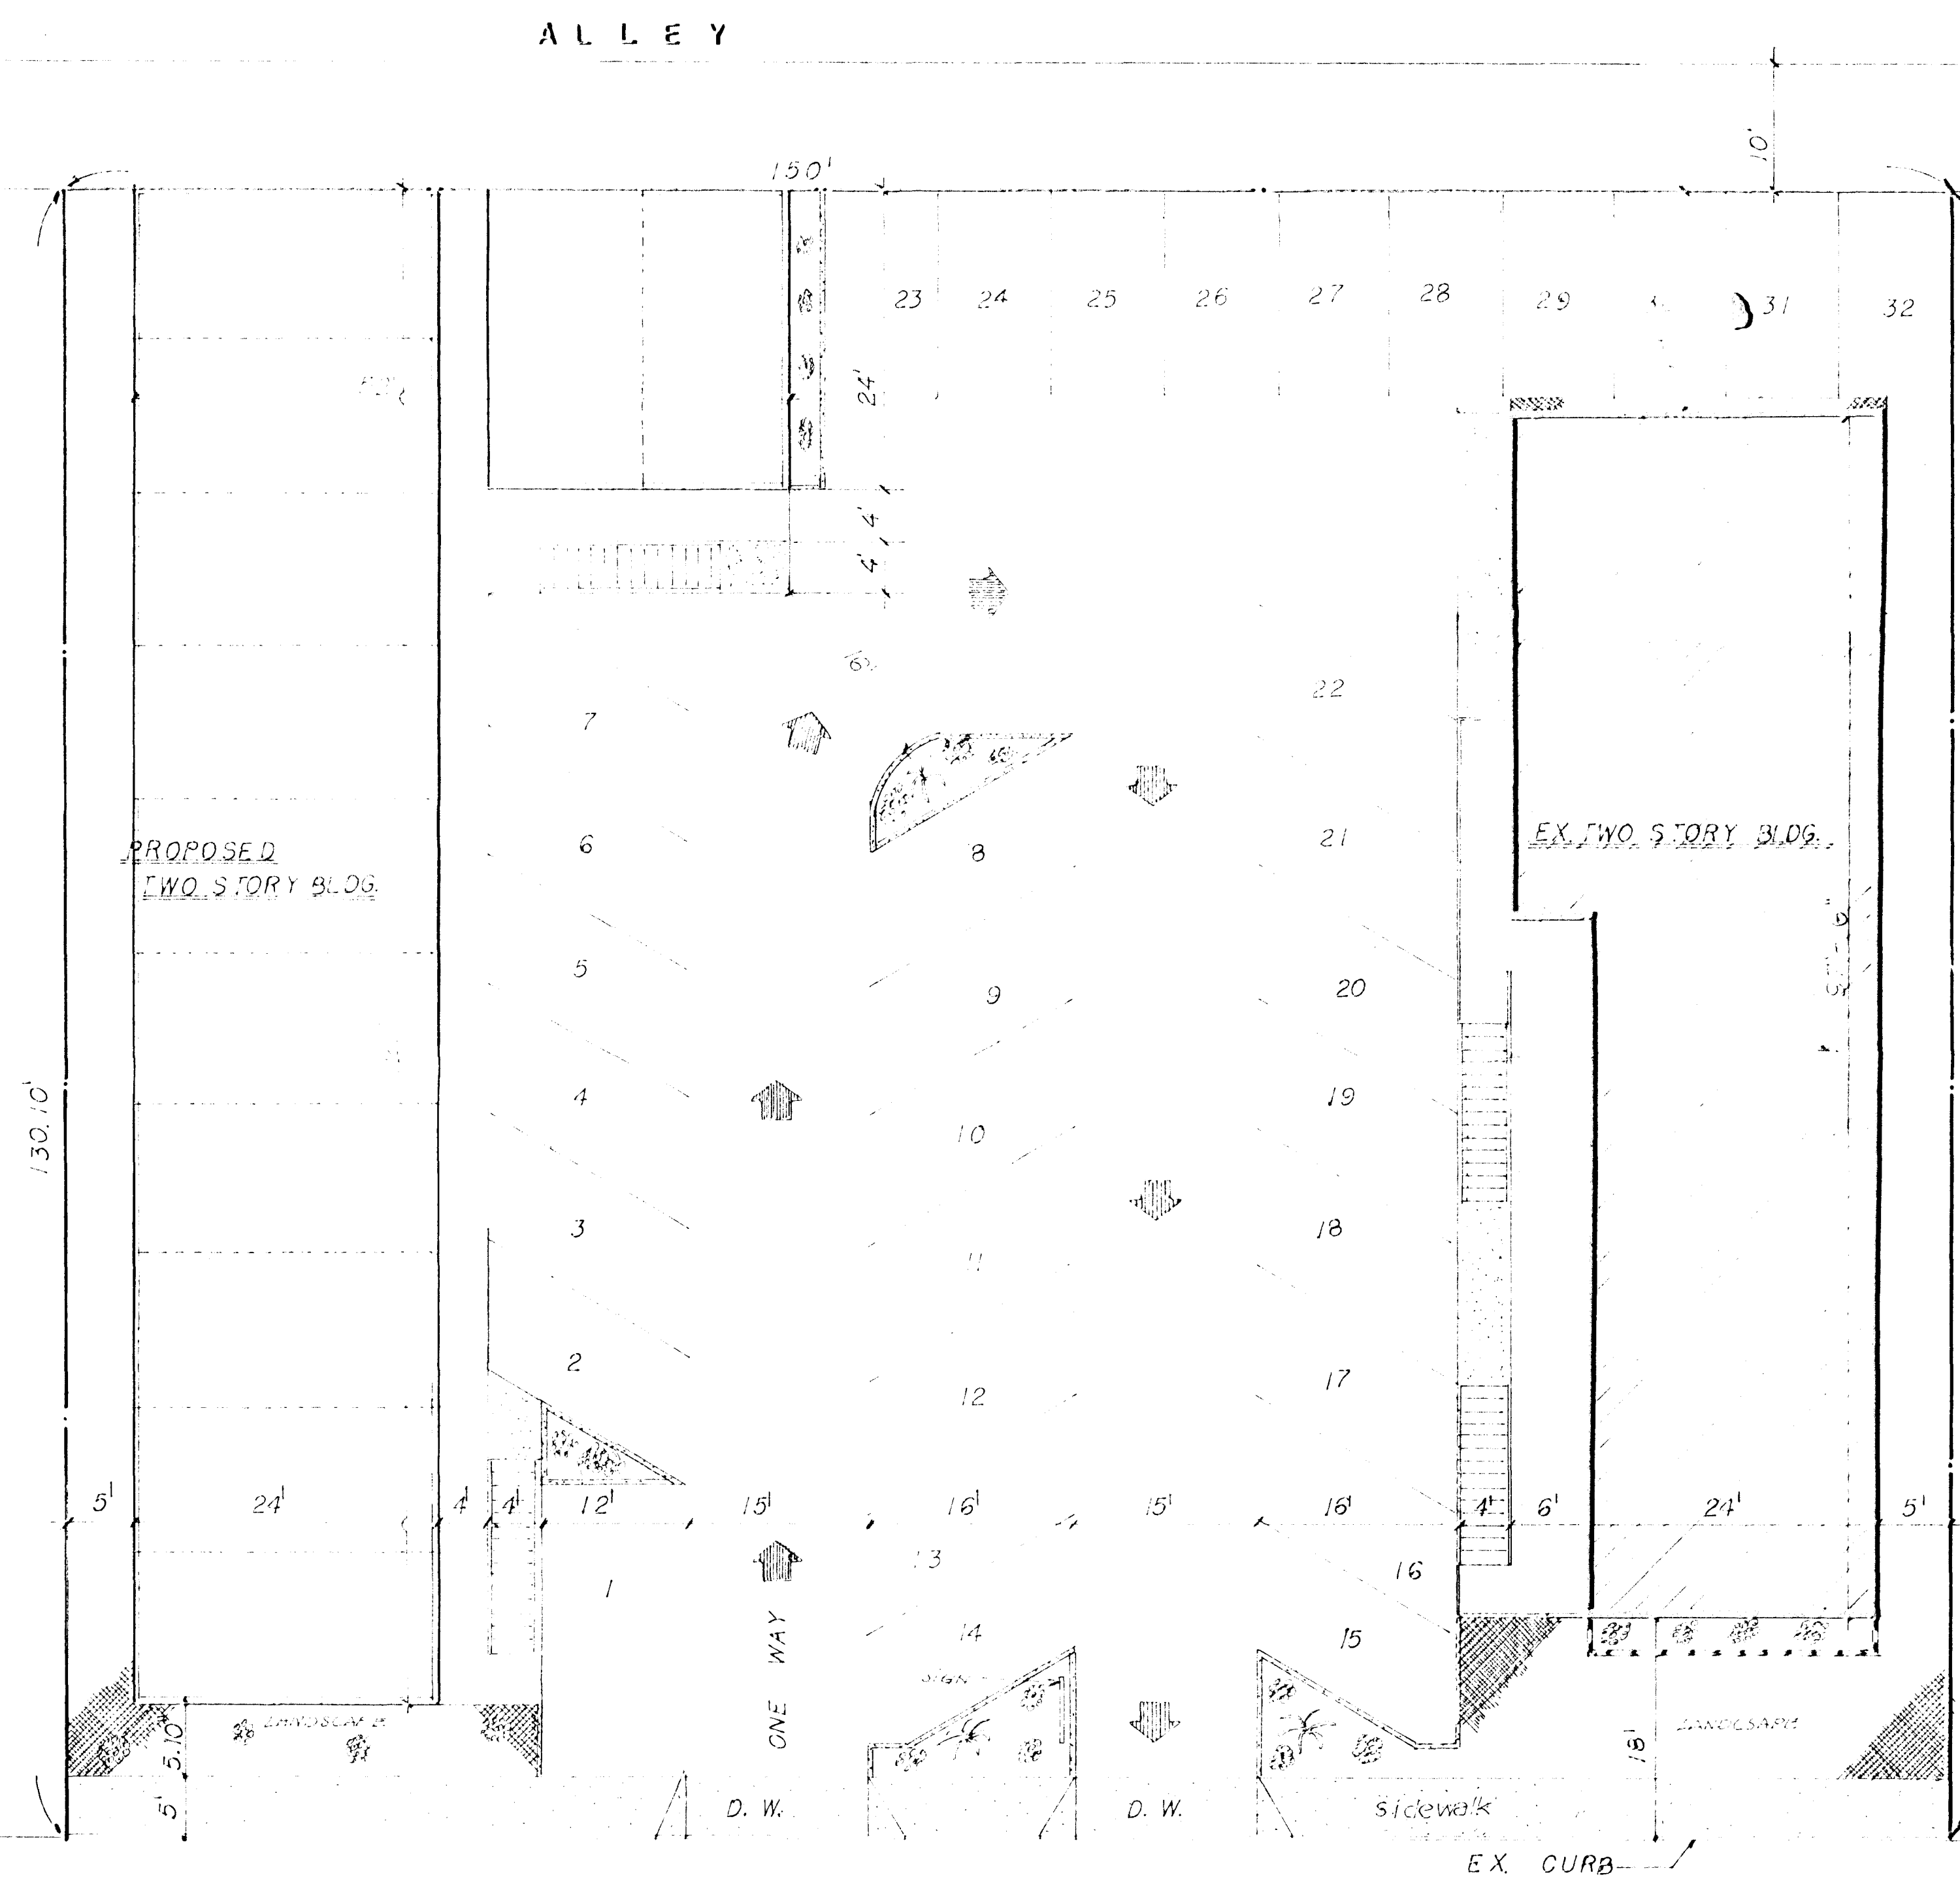




HIGH HAT REGENCY MOTEL
ROOM ADDITION (24)

S I T E P L A N SCALE: 1" = 10'


TOTAL PARKING	32
REQ.	32

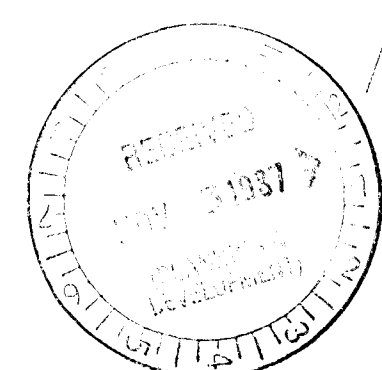


STAFF

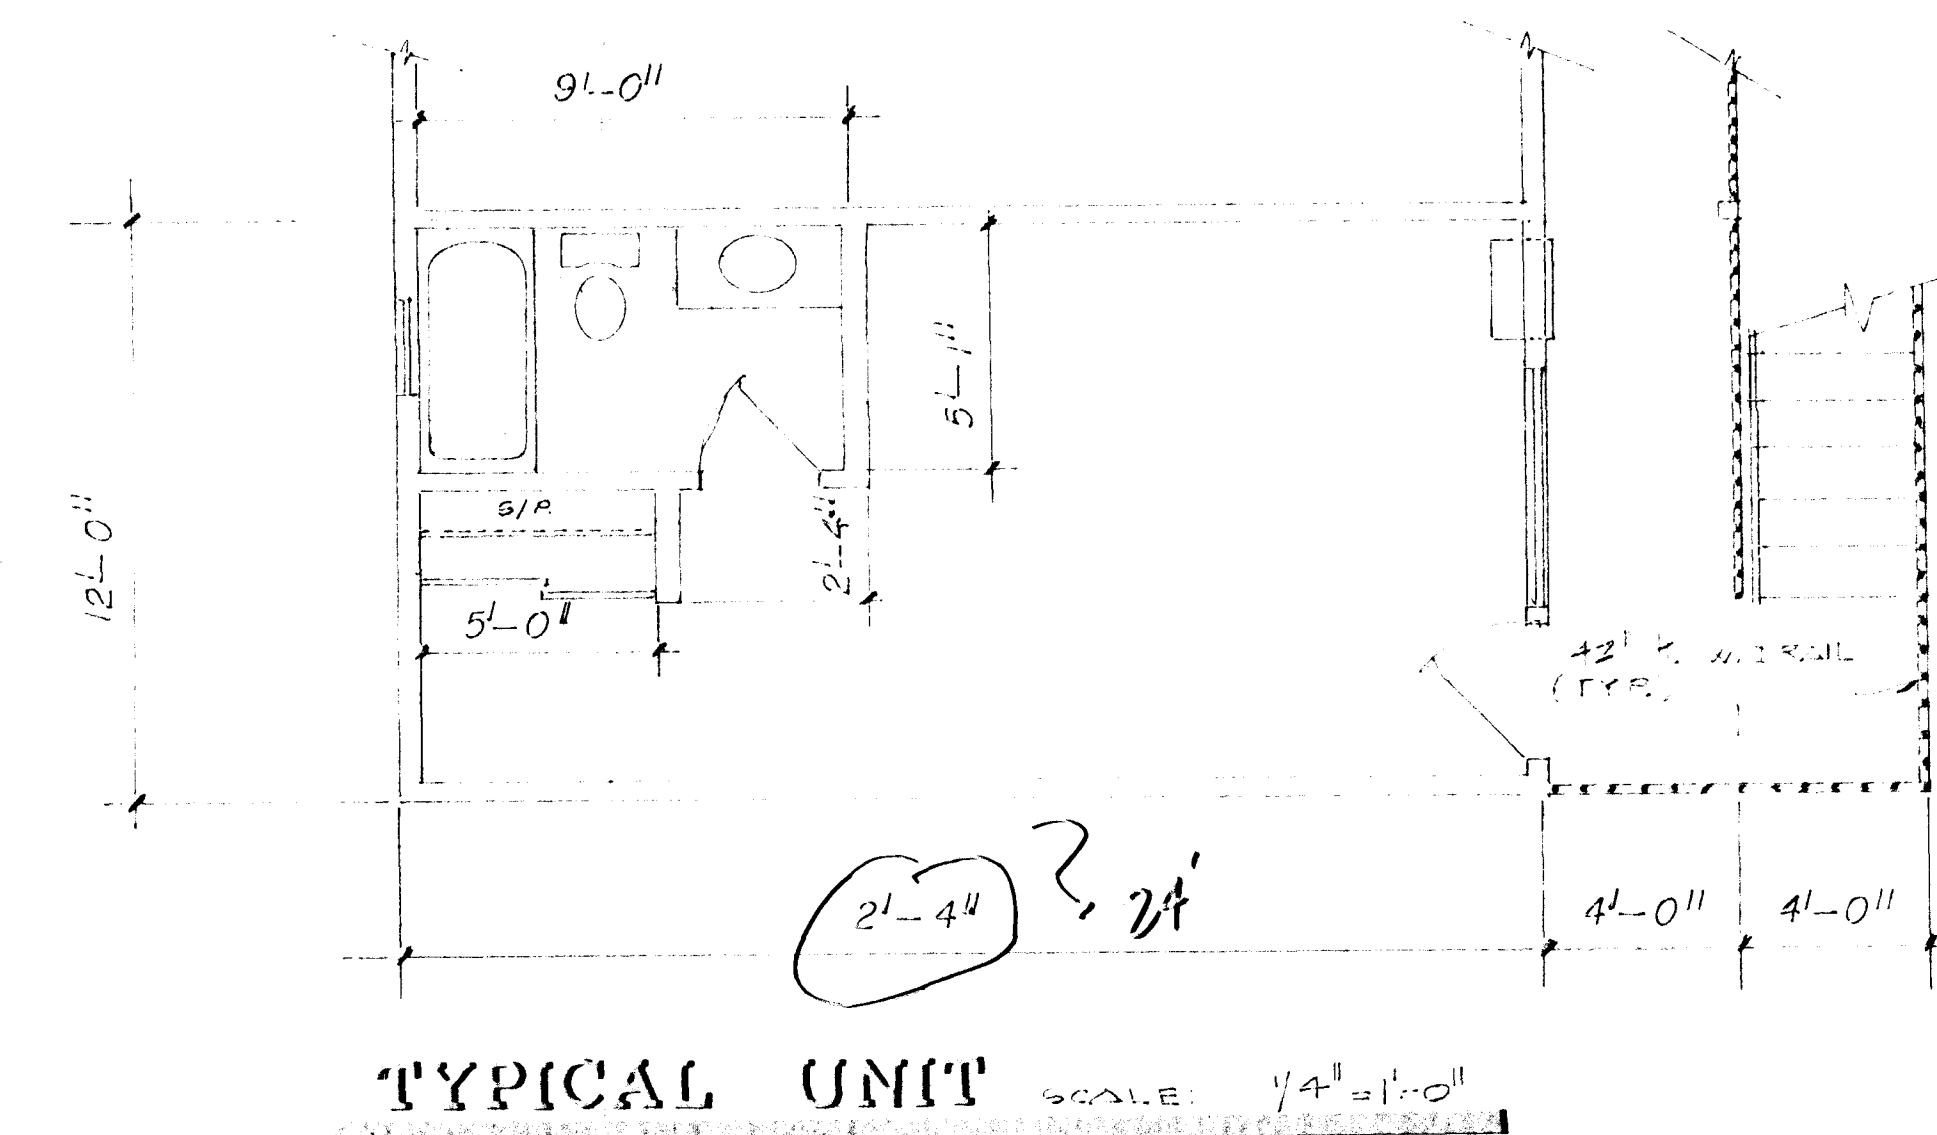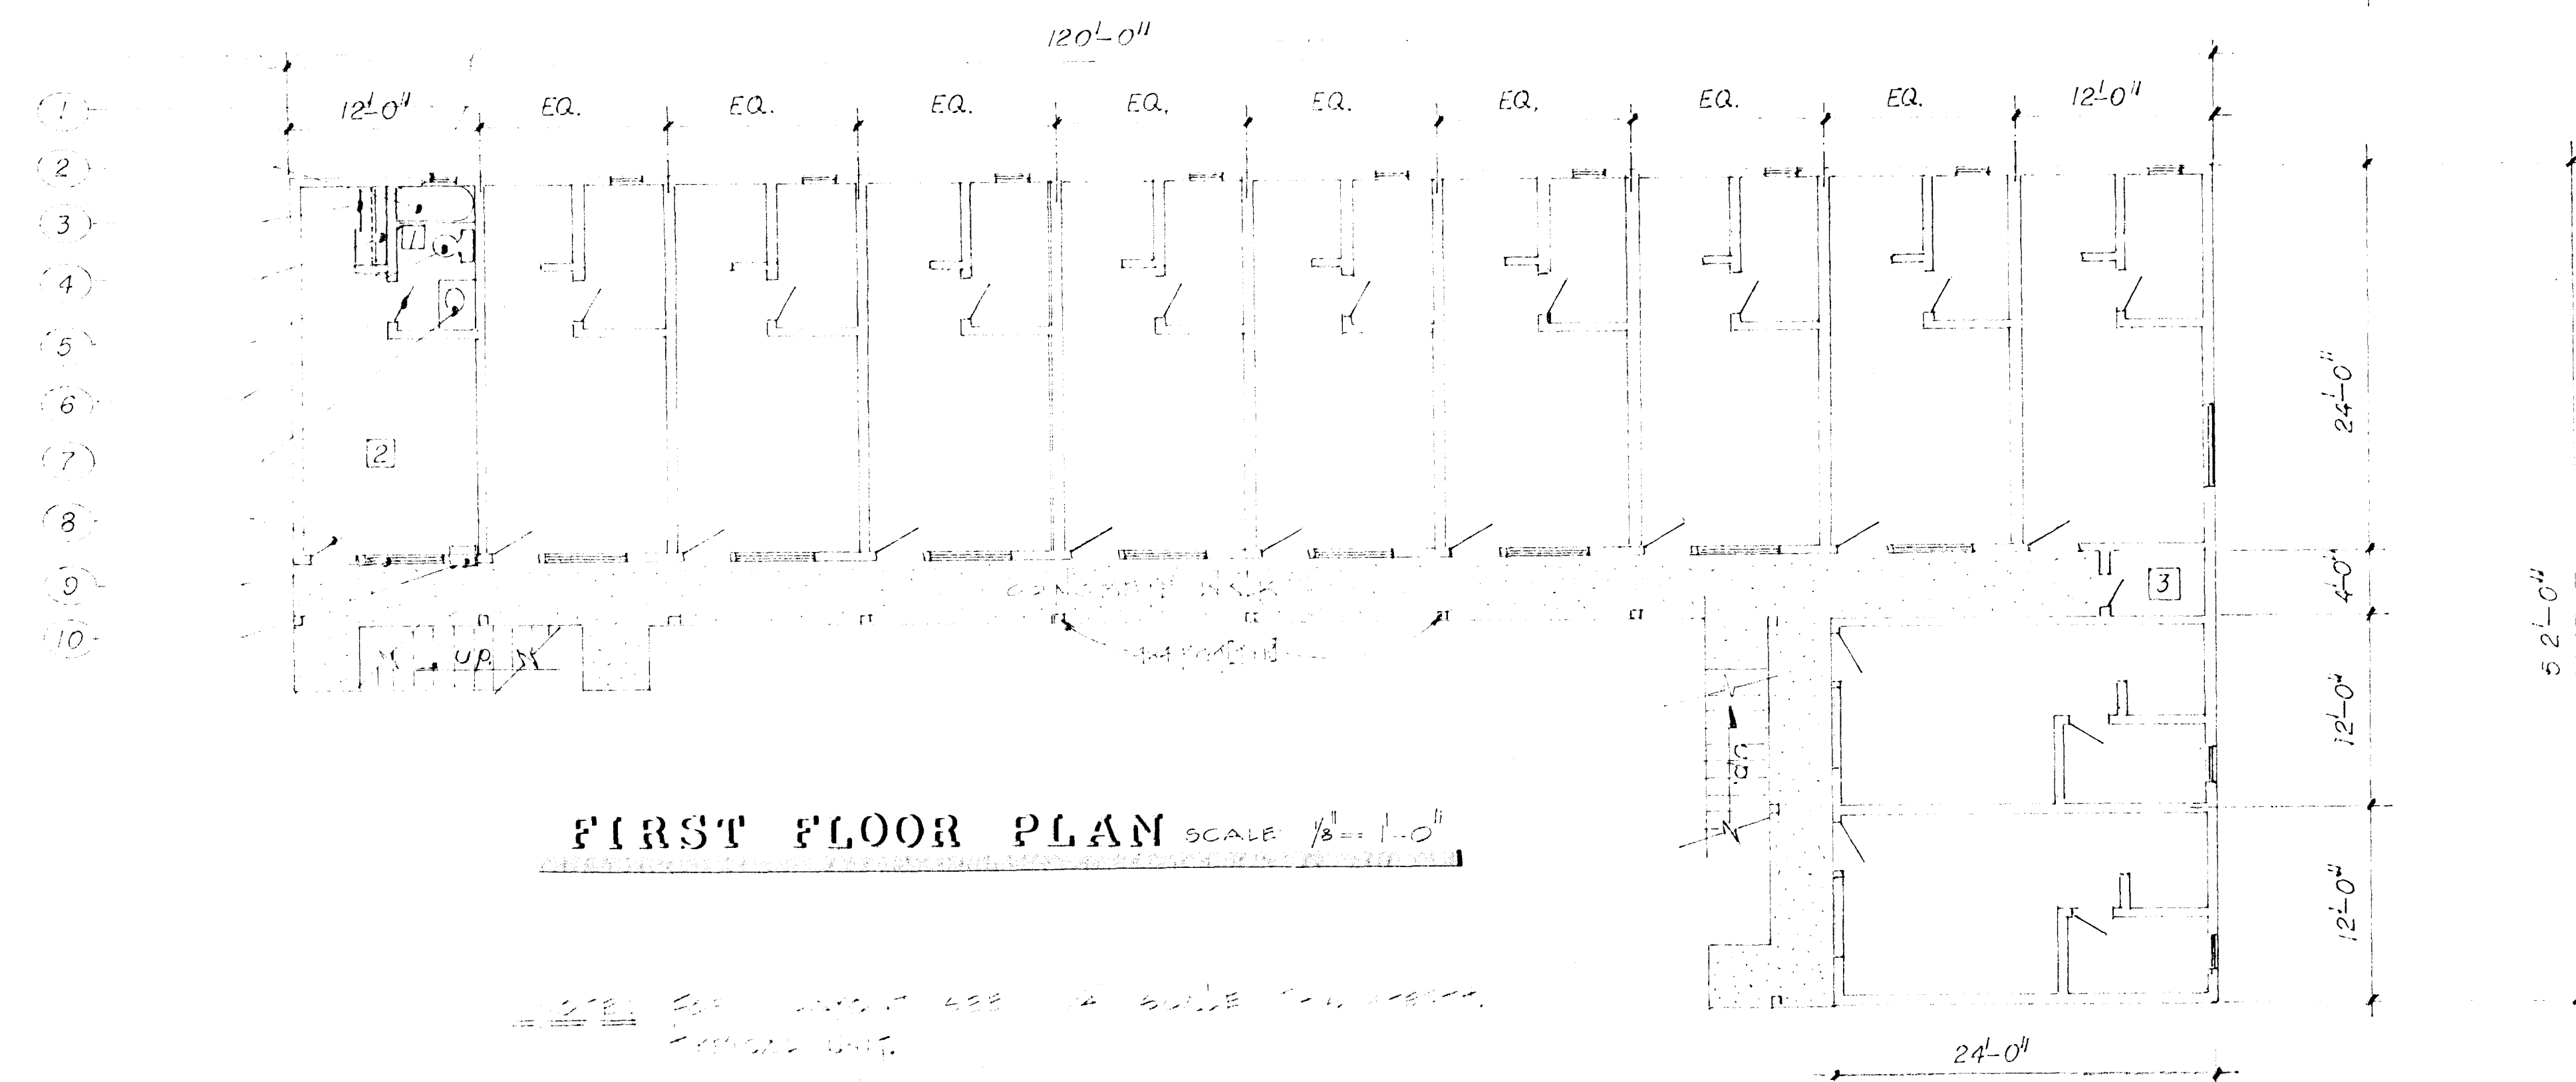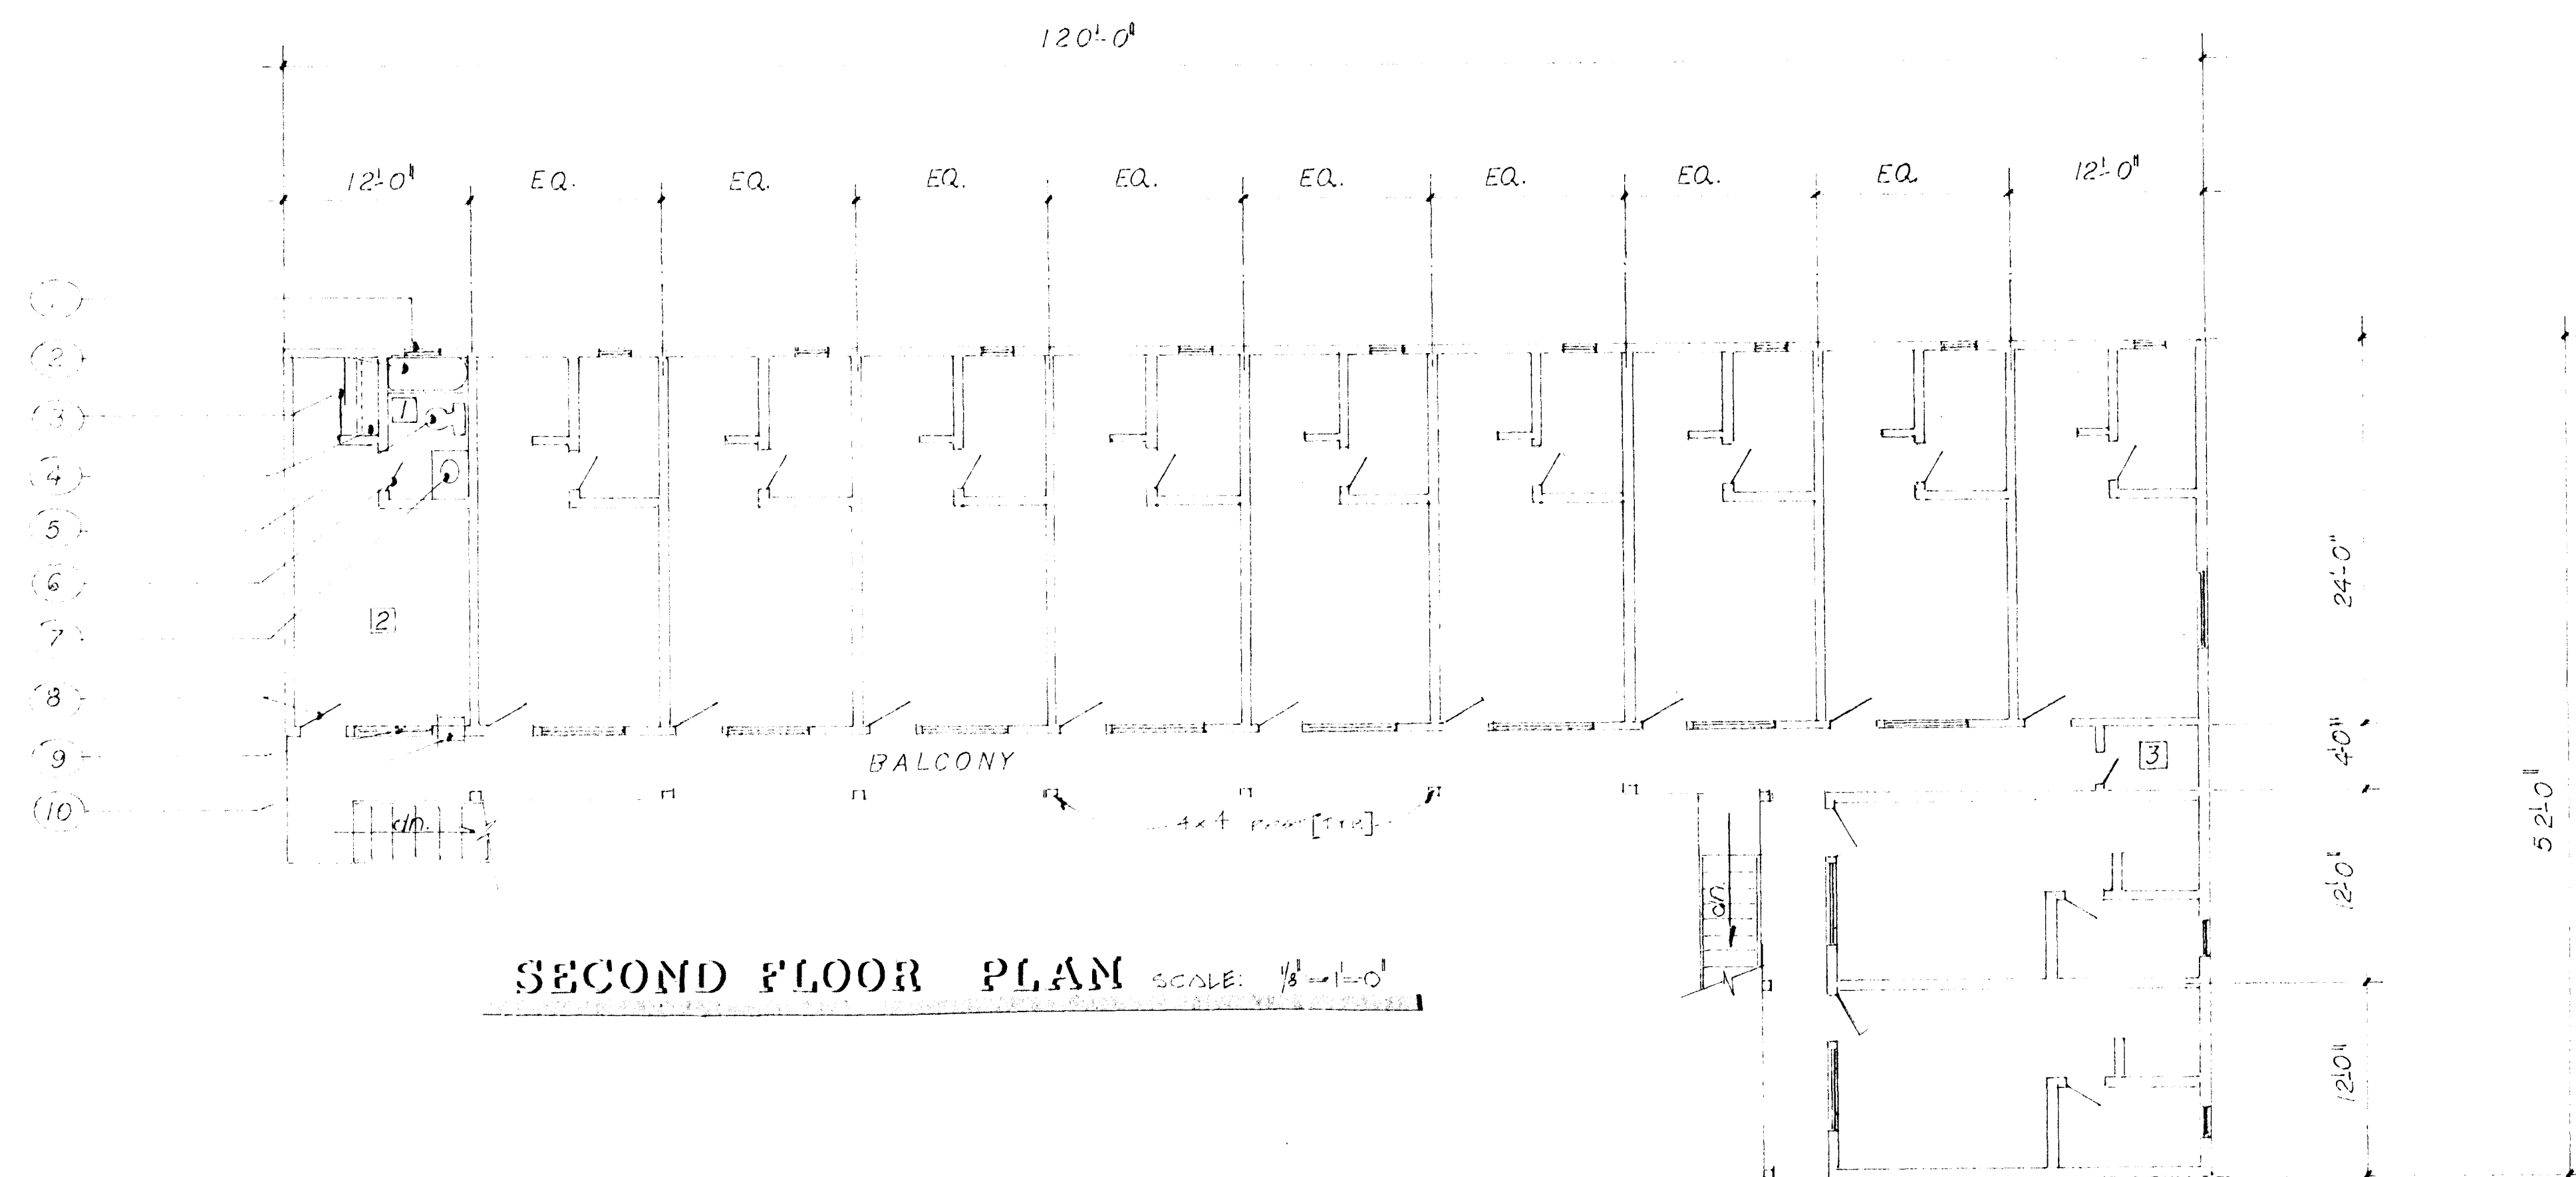

LEGEND	
1	2" x 2" AL. GL. WINDOW (INS.)
2	DOOR TIE
3	2" x 4" AL. GL. WINDOW (INS.)
4	WRE-VAL & POLE
5	W.C.
6	2" x 6" x 1/2" AL. DOOR (INS.)
7	W.C. W/ SINK
8	2" x 6" x 1/2" AL. DOOR
9	2" x 4" AL. GL. WINDOW (INS.)
10	W.C. UNIT
11	BATH ROOM
12	WRE-VAL & POLE

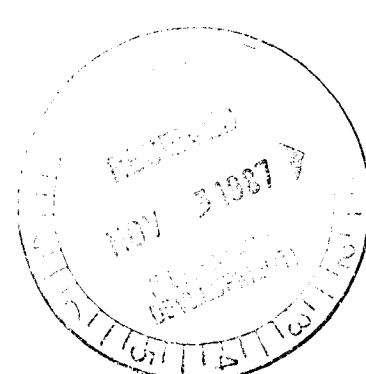

STAFF

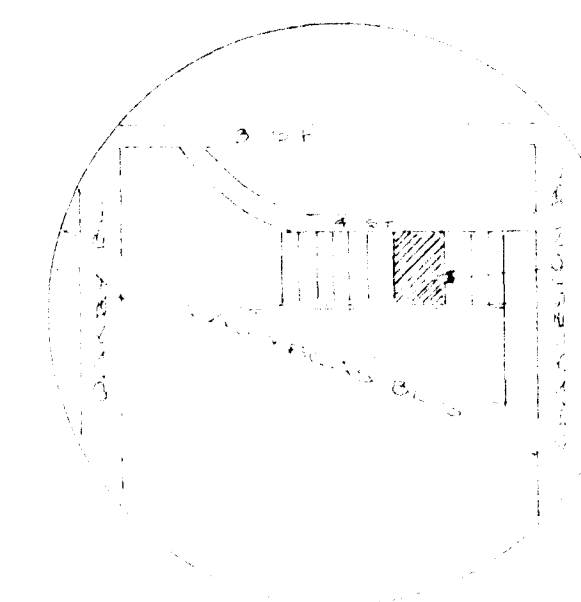

VICINITY MAP



HIGH HAT REGENCY MOTEL,
ROOM ADDITION (24)

SITE PLANN SCALE: 1"=10'

TOTAL PARKING	32
REQ.	32

S FOURTH ST.

RECEIVED
NOV 3 1987