


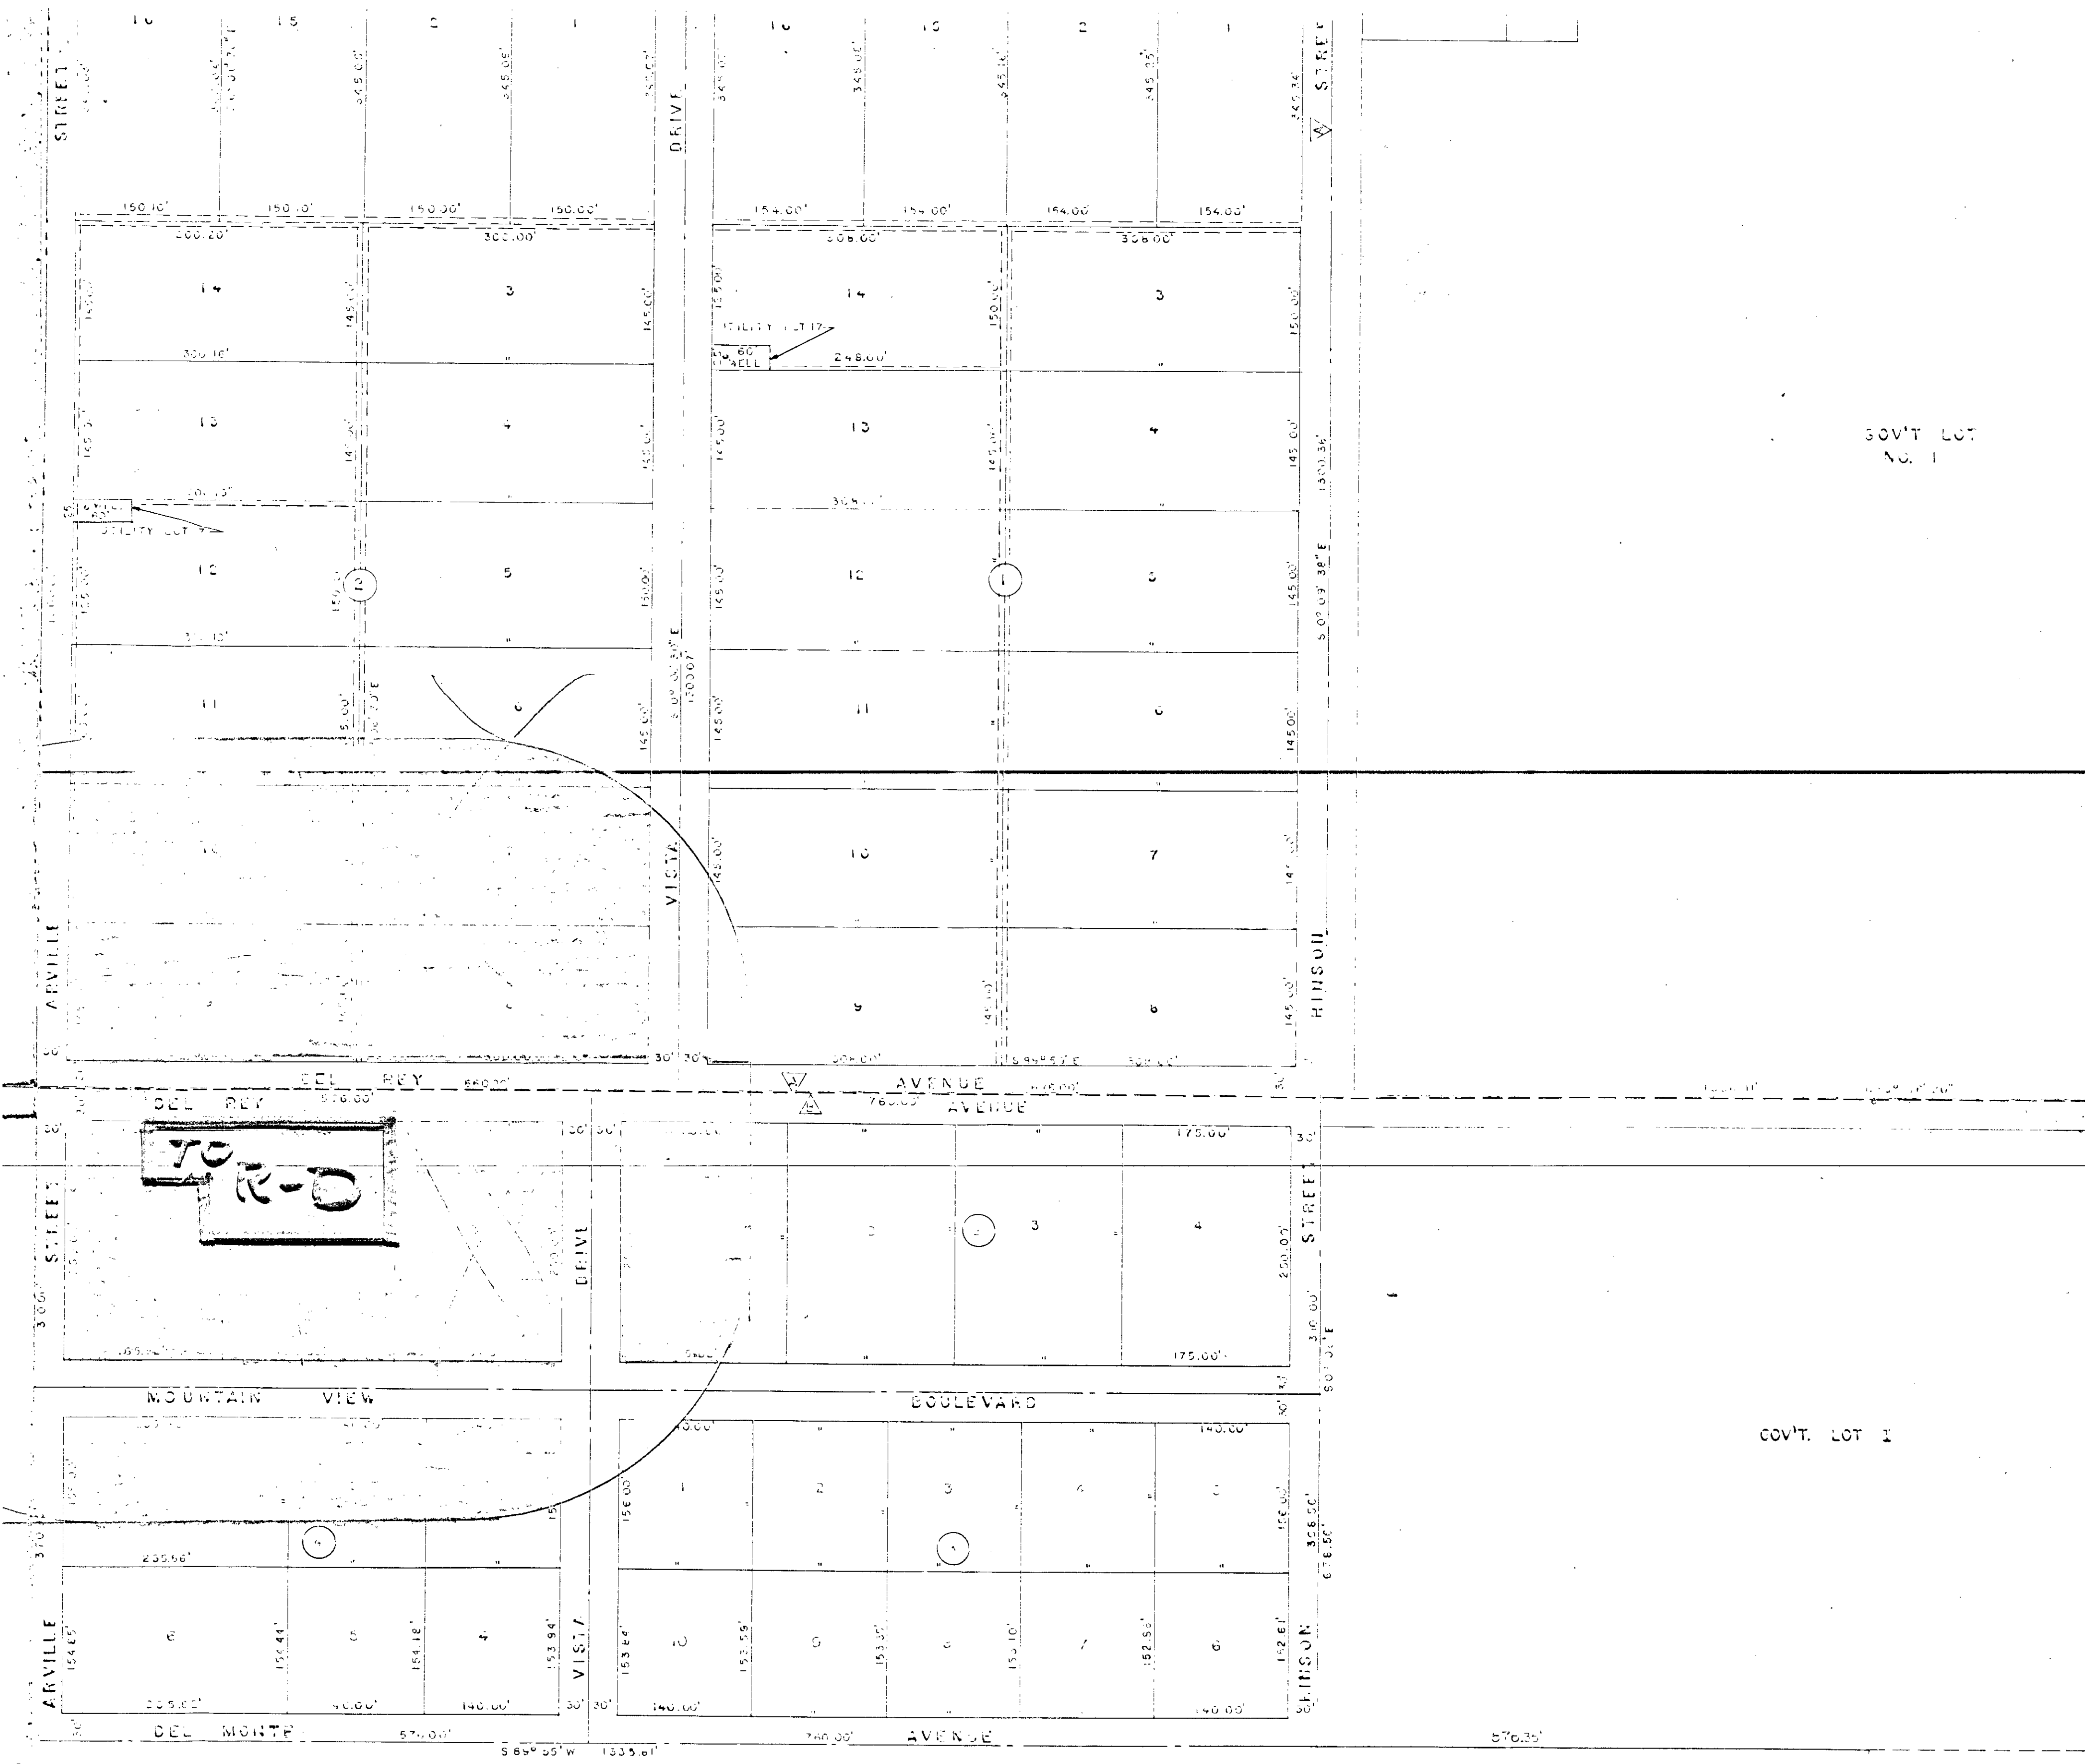

GOV'T LOT NO. 1

GOV'T. LOT 1

Z-141-62

Z-141-62

HOUSEHOLD
R-E TO R-D

Denied 1/10/63 RC

X