

146



_____ TO BE REMOVED


○ TREE - " " "

NO OFF PREMISE SIGN
_____ EXISTING

~~PROPOSED~~ PROPOSED WORK


N

STAFF

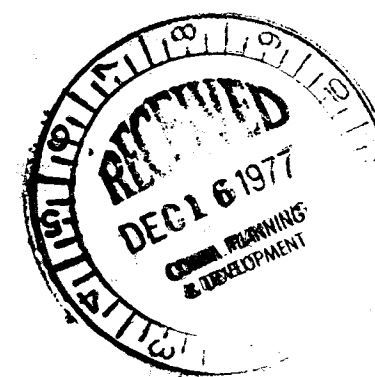[illegible]


2-146-77

146

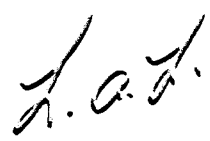

UNDERGROUND SPRINKLING
SYSTEM REQUIRED IN ALL
LANDSCAPED AREAS


Don F... 4-27-78
Department of Community Planning & Development

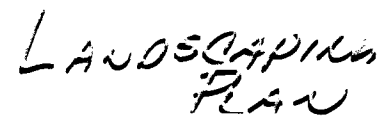

2-146-77

54

DATE 04/13/78
SCALE $\frac{1}{8}" = 1' - 0"$
DRAWN W.S. HUANG
JOB OWNER
SHEET
OF SHEETS

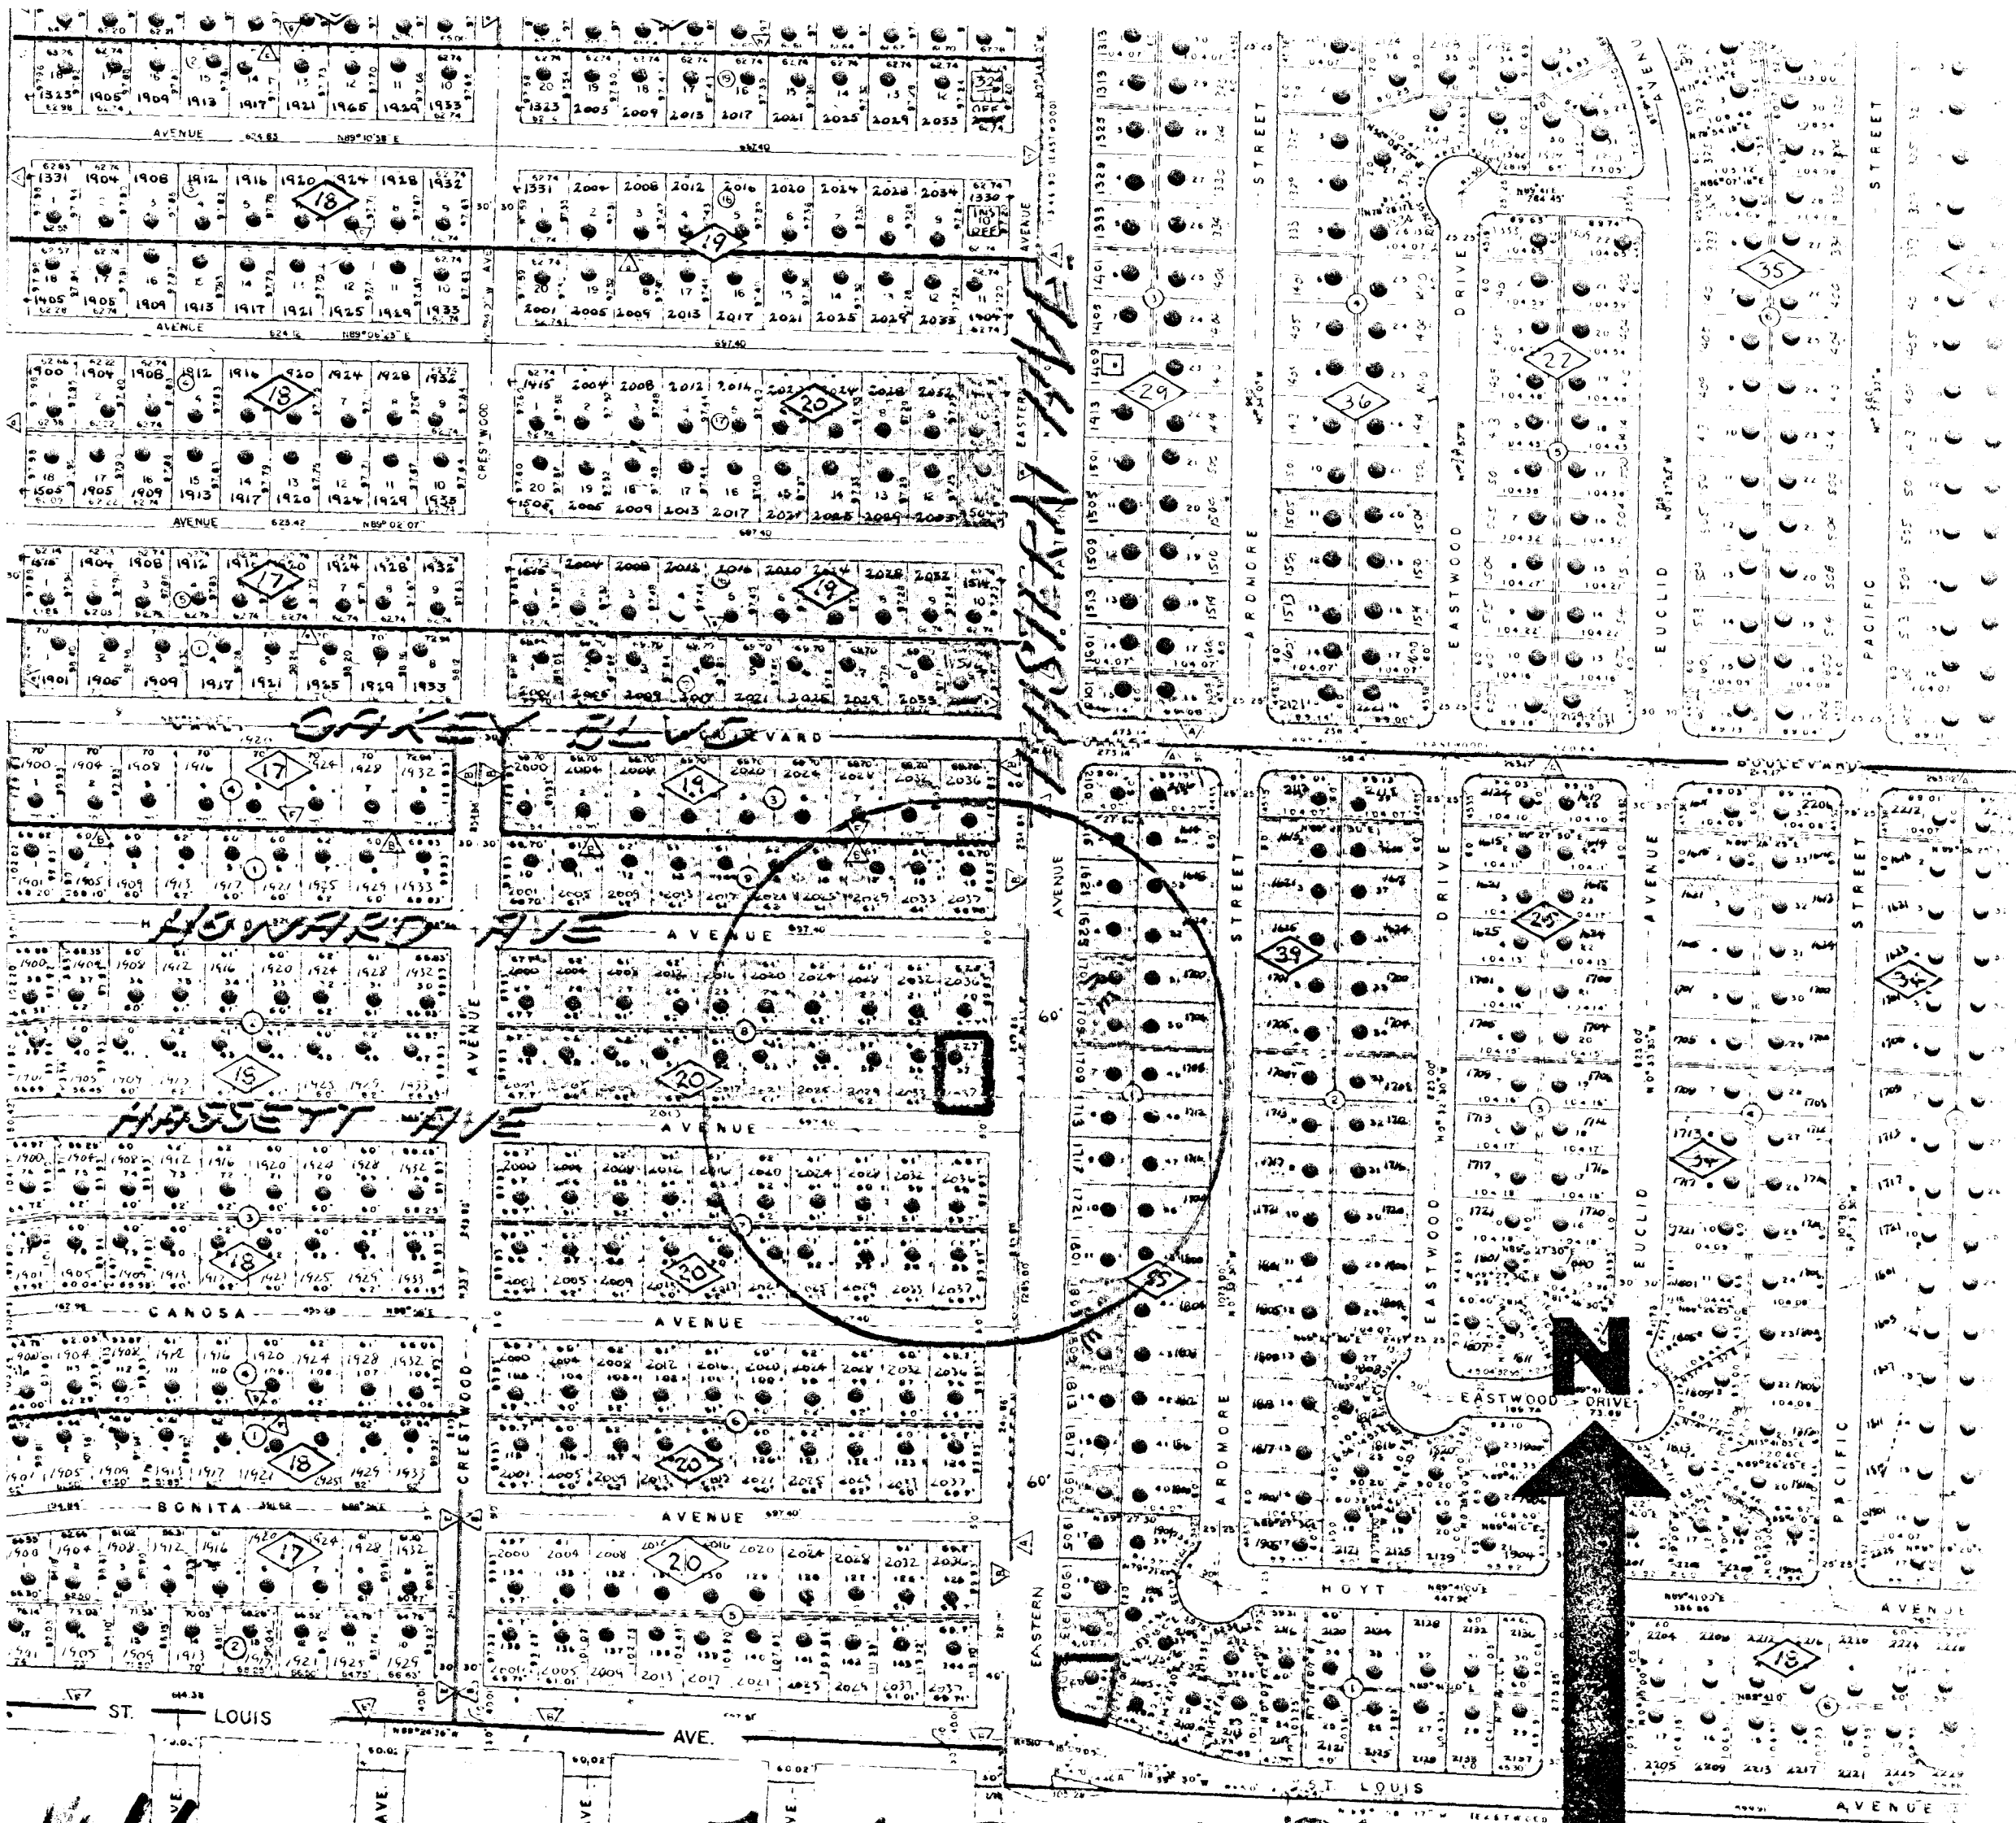


146 Z-146-77

REVISED
OCT. 72 US
MAY '75 D.C.W.

CITY OF LAS VEGAS NE PLANNING DEPT.	
DISTRICT MAP - SHEET	
DESIGNED BY	DATE
DRAWN BY	SCALE
CHECKED BY	FIELD NO.
	WORKING
	SHAWING

EASTWOOD TRACT NO.
DAWSON PARK TRACT
DAWSON PARK TRACT
DAWSON PARK TRACT
DAWSON PARK TRACT

CHARLESTON PK.
SEC- 342

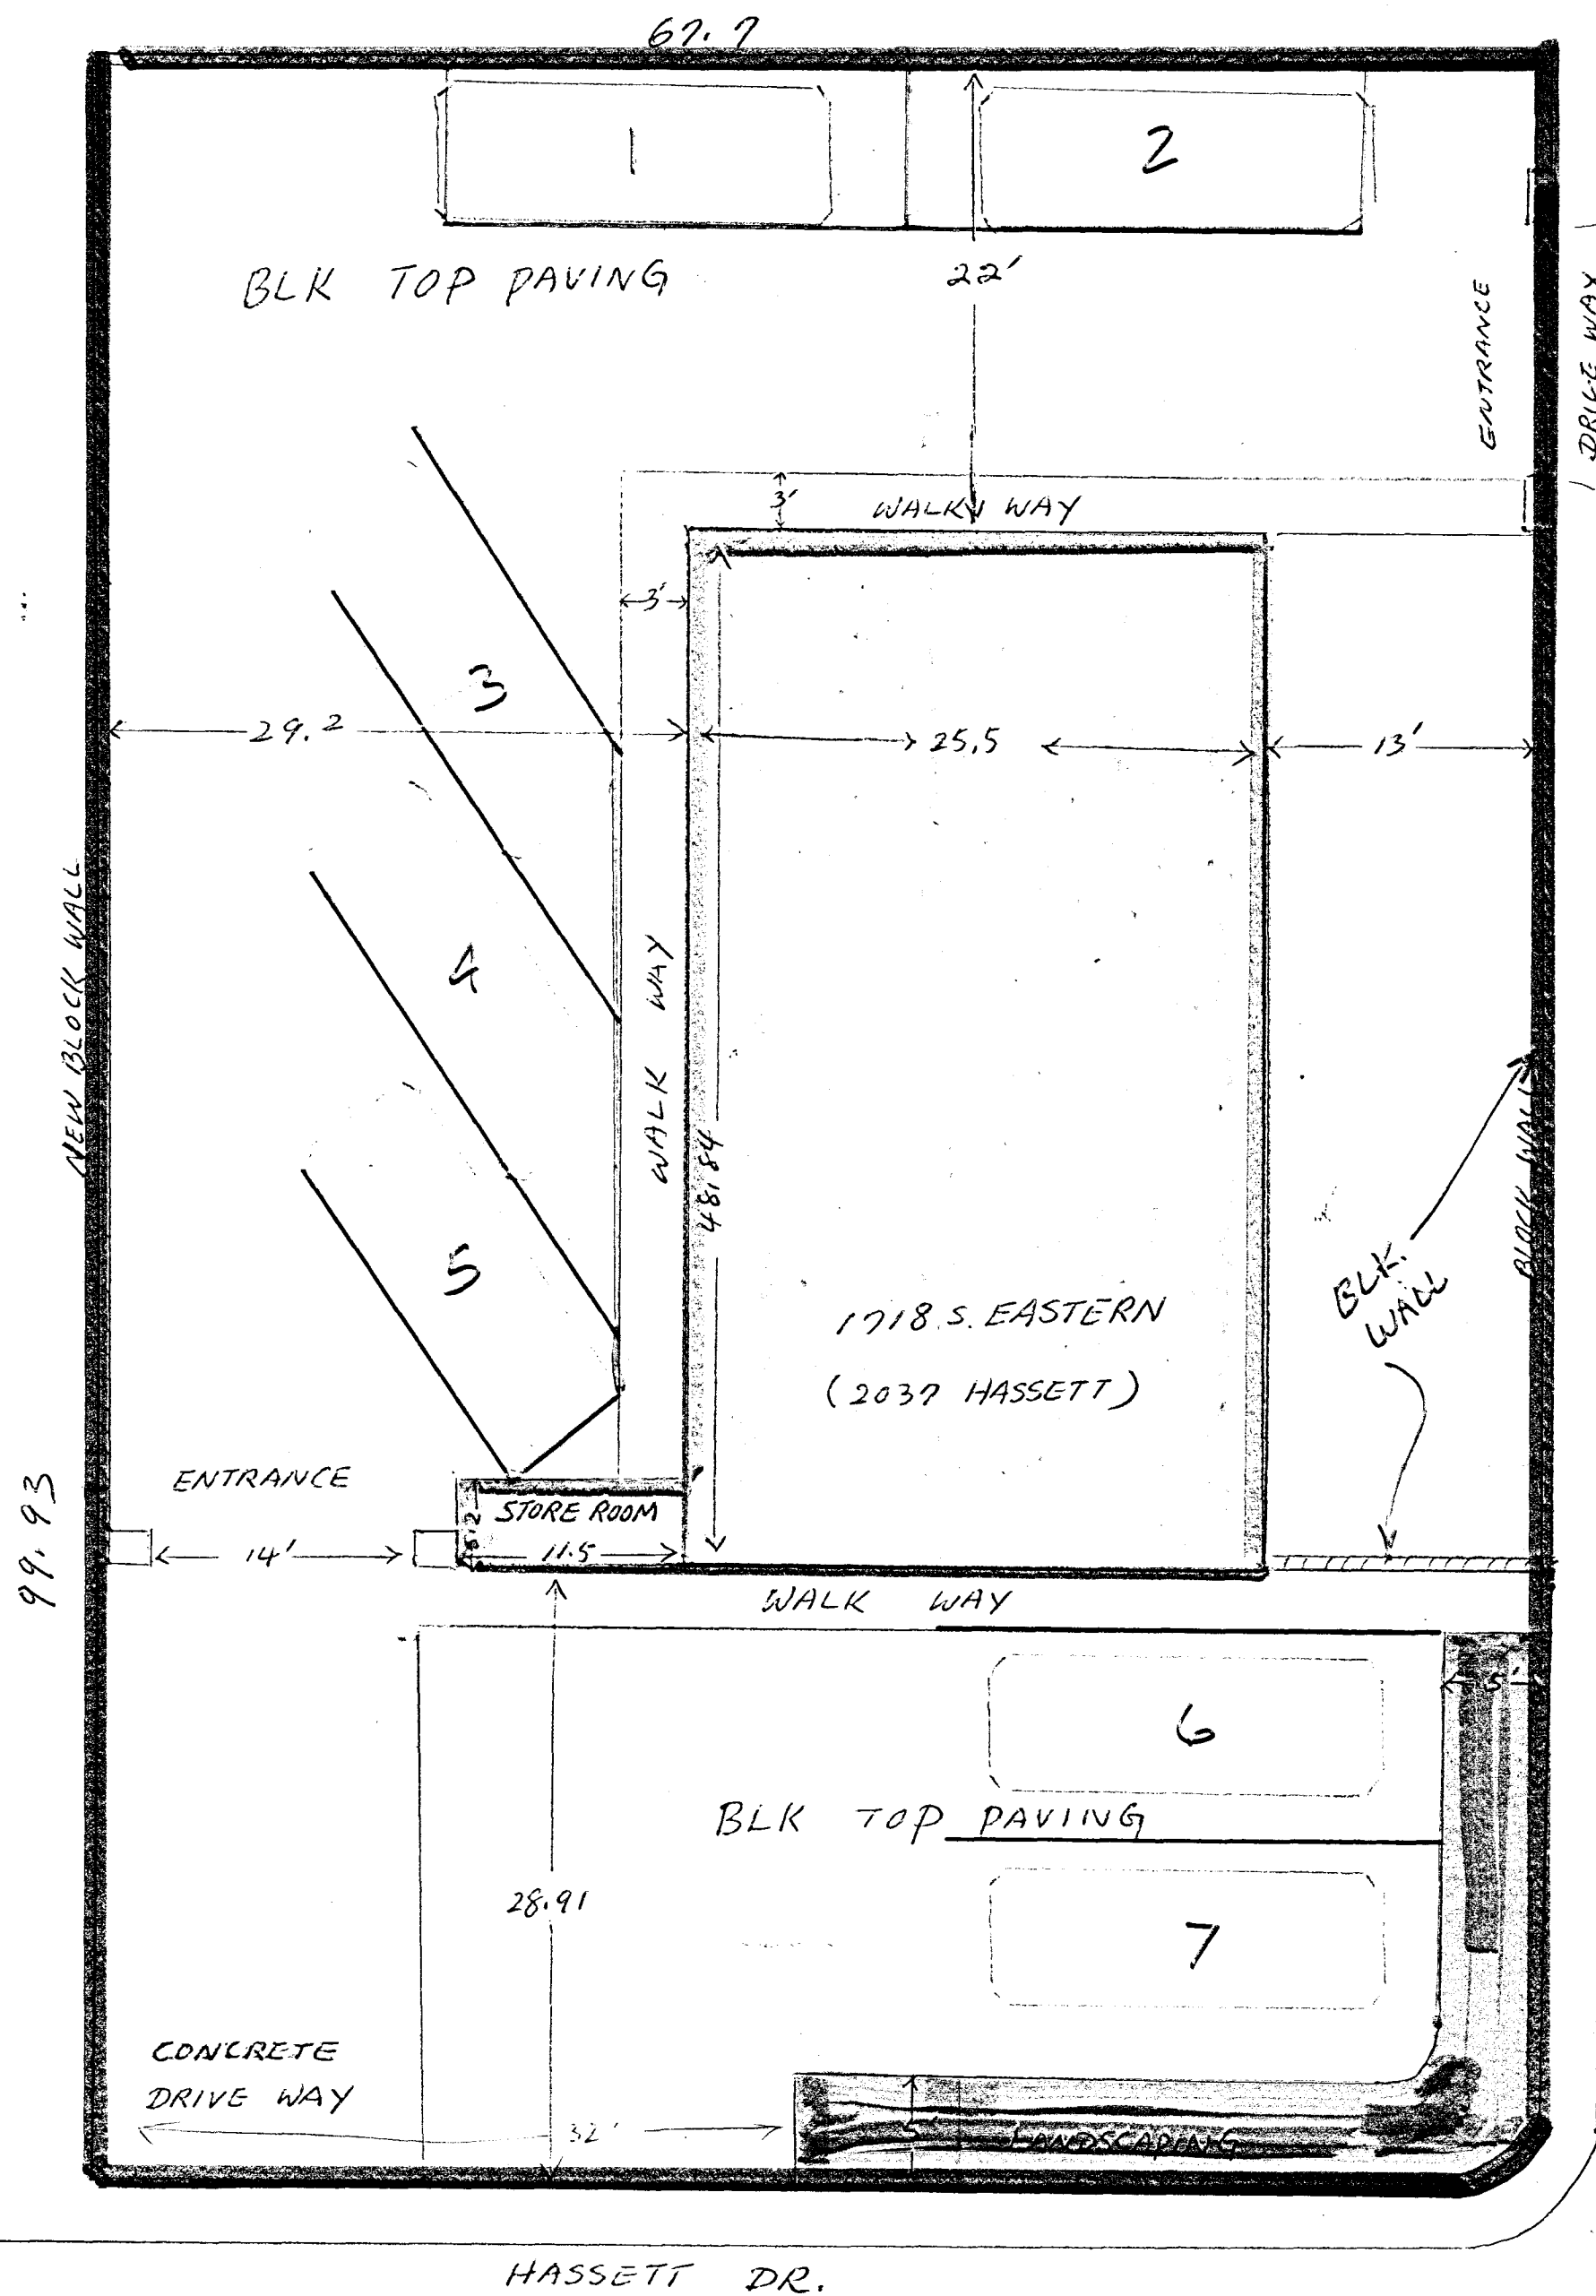

HASSETT AVE.

146

PC
4/25/77

7-146-77