


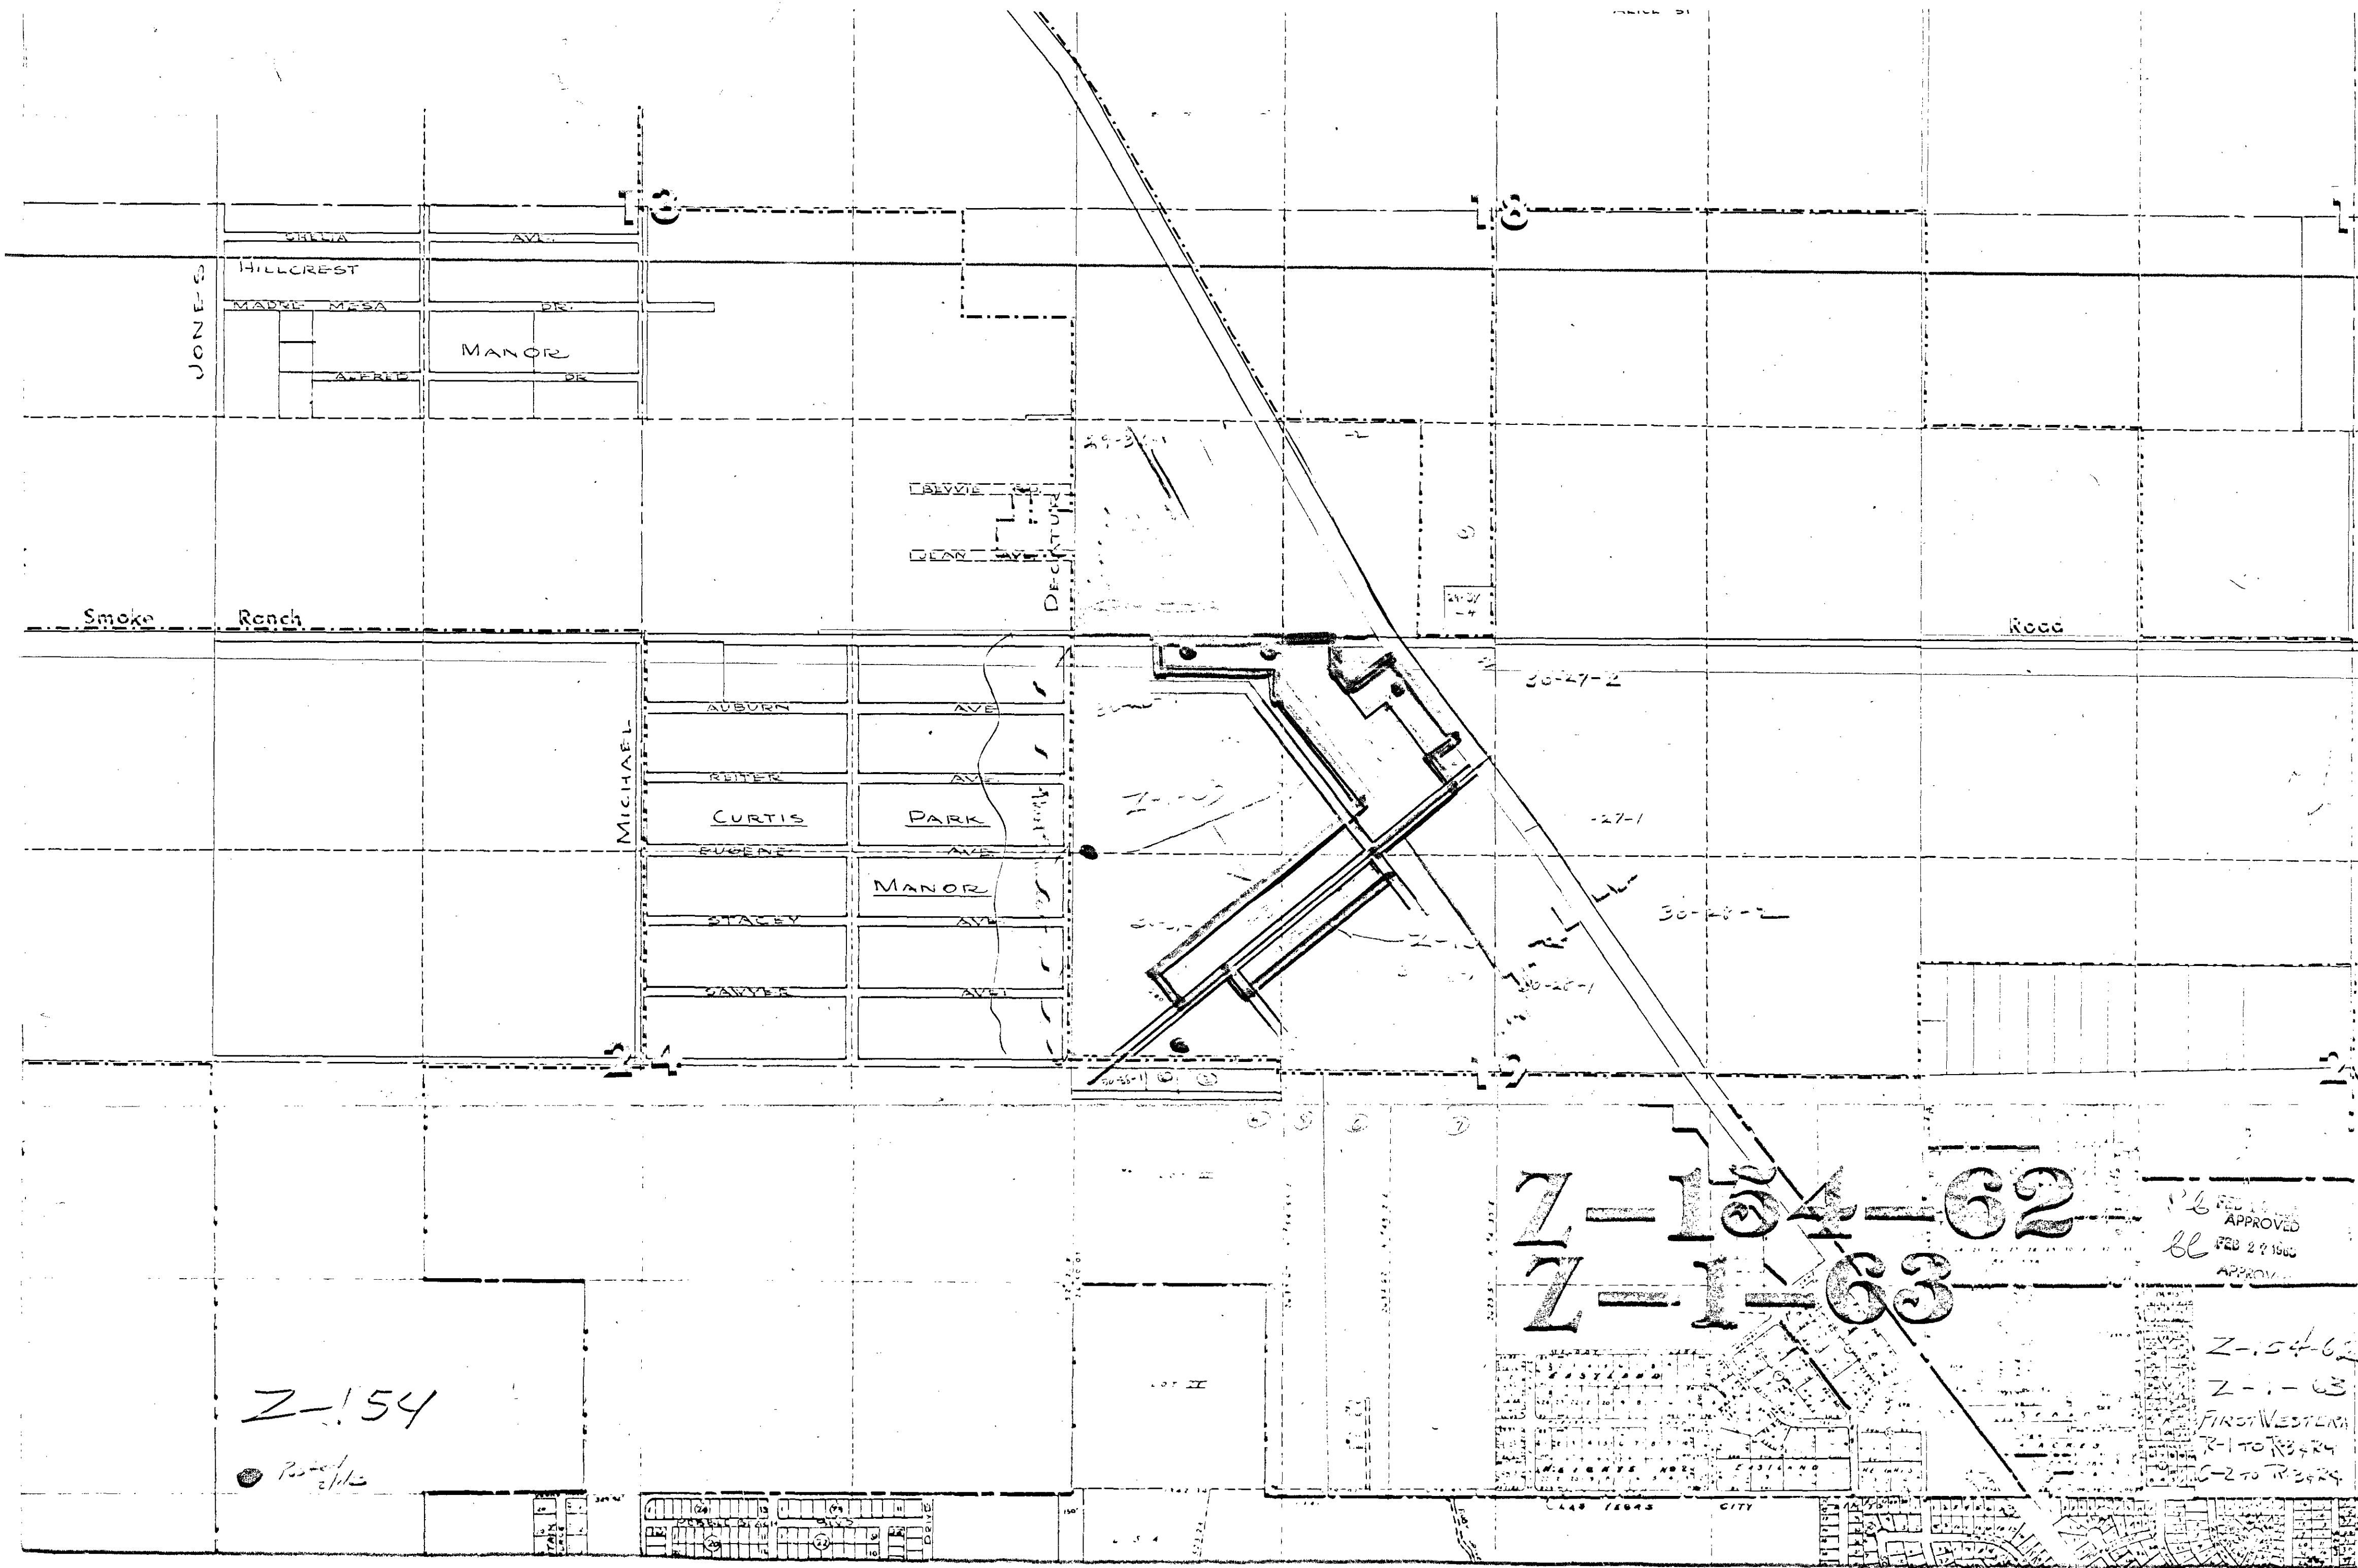

Z-154

Post 2/1/62

Z-154-62
Z-1-63

PL
APPROVED
FEB 27 1962
bl
APPROVED

Z-154-62
Z-1-63
FIRST WESTERN
X-1 TO R3424
C-2 TO R3424

1645 CITY