

LOT PLAN SCALE 1" = 20'-0"
MEDICAL BUILDING FOR:
E. J. SORENSON

6' HIGH BLOCK WALL
 TRASH AREA
 PARKING - 25 SPACES
 6' HIGH BLOCK WALL
 SET BACK LINE
 50'-0"
 Res.
 Ash Conc. IN ONLY
 OUT ONLY
 Res.
 6' HIGH BLOCK WALL
 STAFF PARKING - 18 SPACES
 MEDICAL CENTER
 120'-0"
 300'-0"
 Res.

Please remove Dr. Office - 11/14/44
 Block wall should extend to street line
 Investigate dimensions to determine
 parking spaces (Scale indicated
 as accurate with reference
 to ground as shown)


165

**STAFF
 COPY**

WALTER ZICK & HARRIS SHARP
 ARCHITECTS
 1000 N. 10th St. - Seattle, Wash.

SHEET 100

SHEET 102

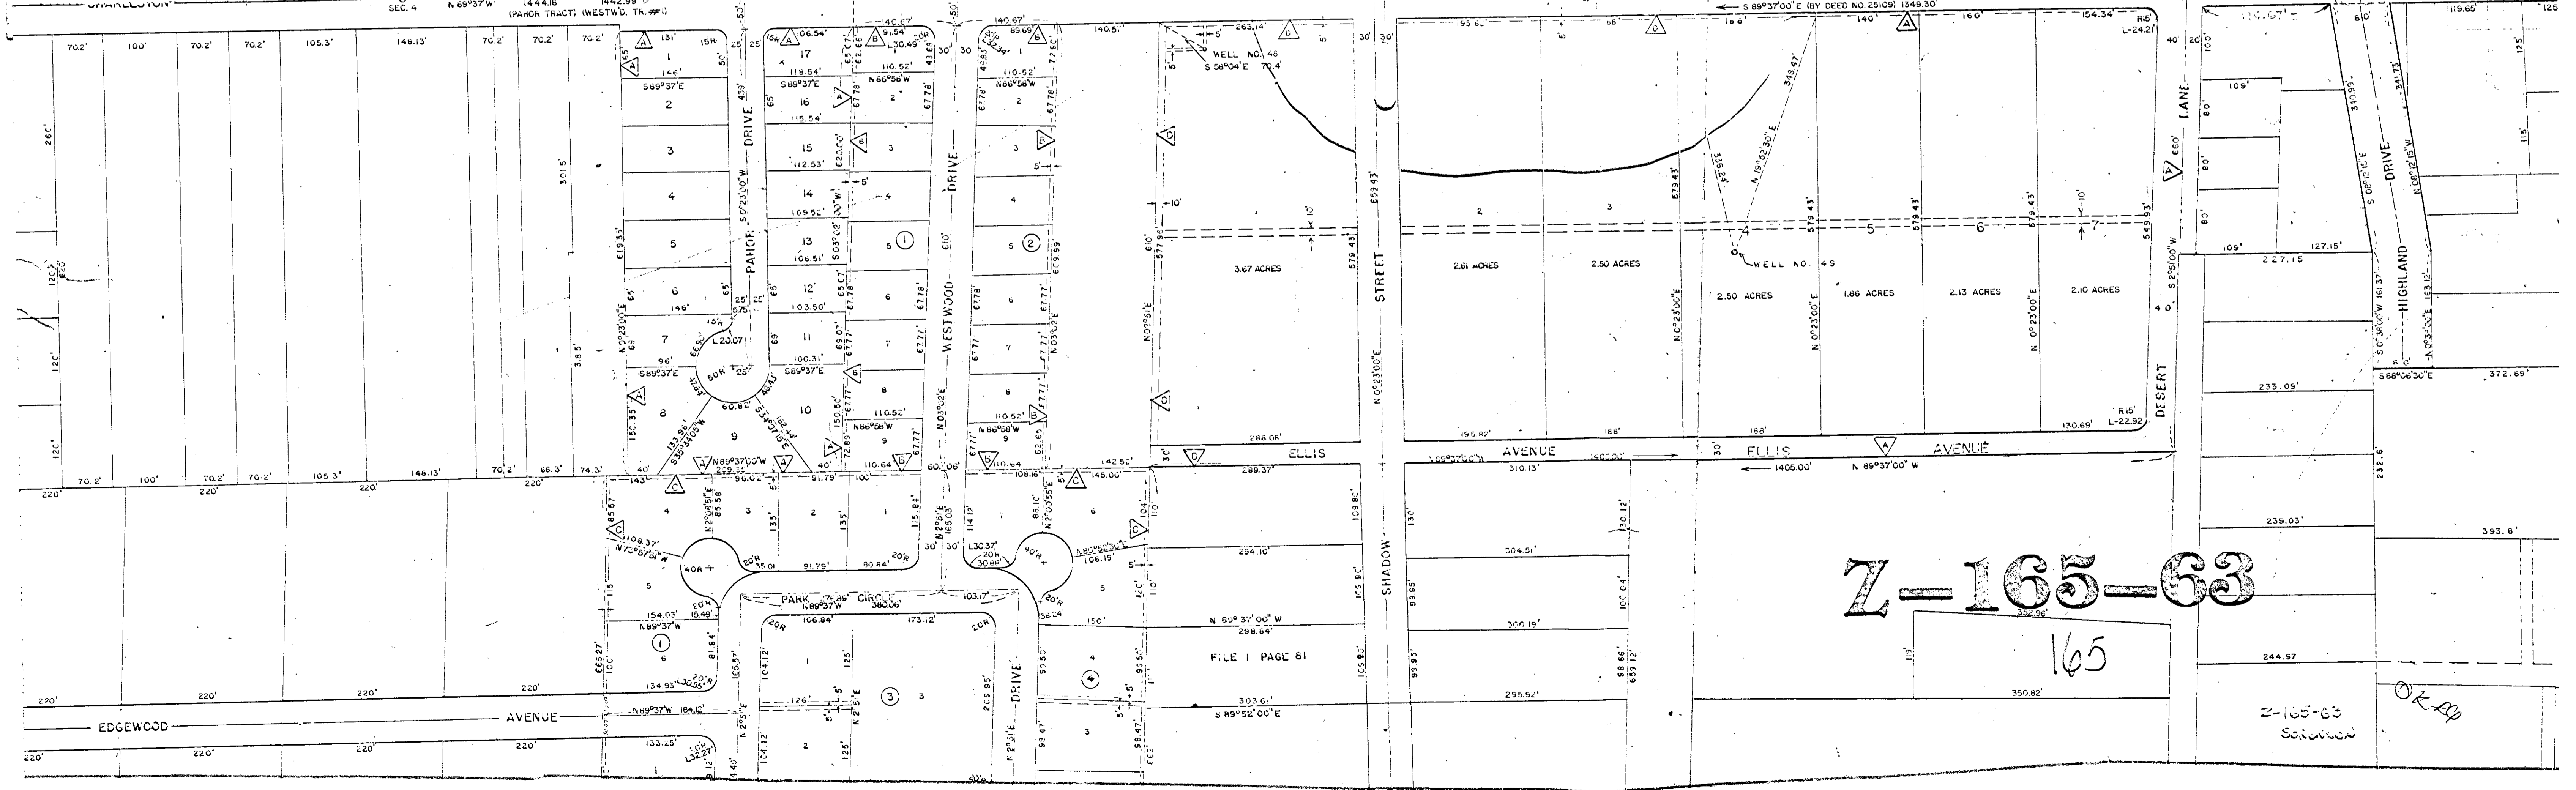

Z-165-63

165

Z-165-63

OK AD

FILE 1 PAGE 81