

NOTE: ALL STREETS 20' WIDE  
 ALL ALLEYS 20' WIDE  
 ALL BLOCKS 100' X 100'  
 ALL LOTS 25' WIDE  
 UNLESS OTHERWISE SPECIFIED

N 1/2 SW 1/4 SEC. 27 T20S. R1  
 CITY OF LAS VEGAS  
 ENGINEERING DEPARTMENT


DISTRICT MAP SHEET

DESIGNED BY  
 DRAWN BY E.P.  
 CHECKED BY  
 APPROVED  
 CITY ENGR.

**Z-73-66**


▲ BILTMORE AD  
 ▲ BILTMORE AC  
 ▲ BILTMORE AI  
 ▲ BILTMORE AJ  
 ▲ MOUNT VERN

73

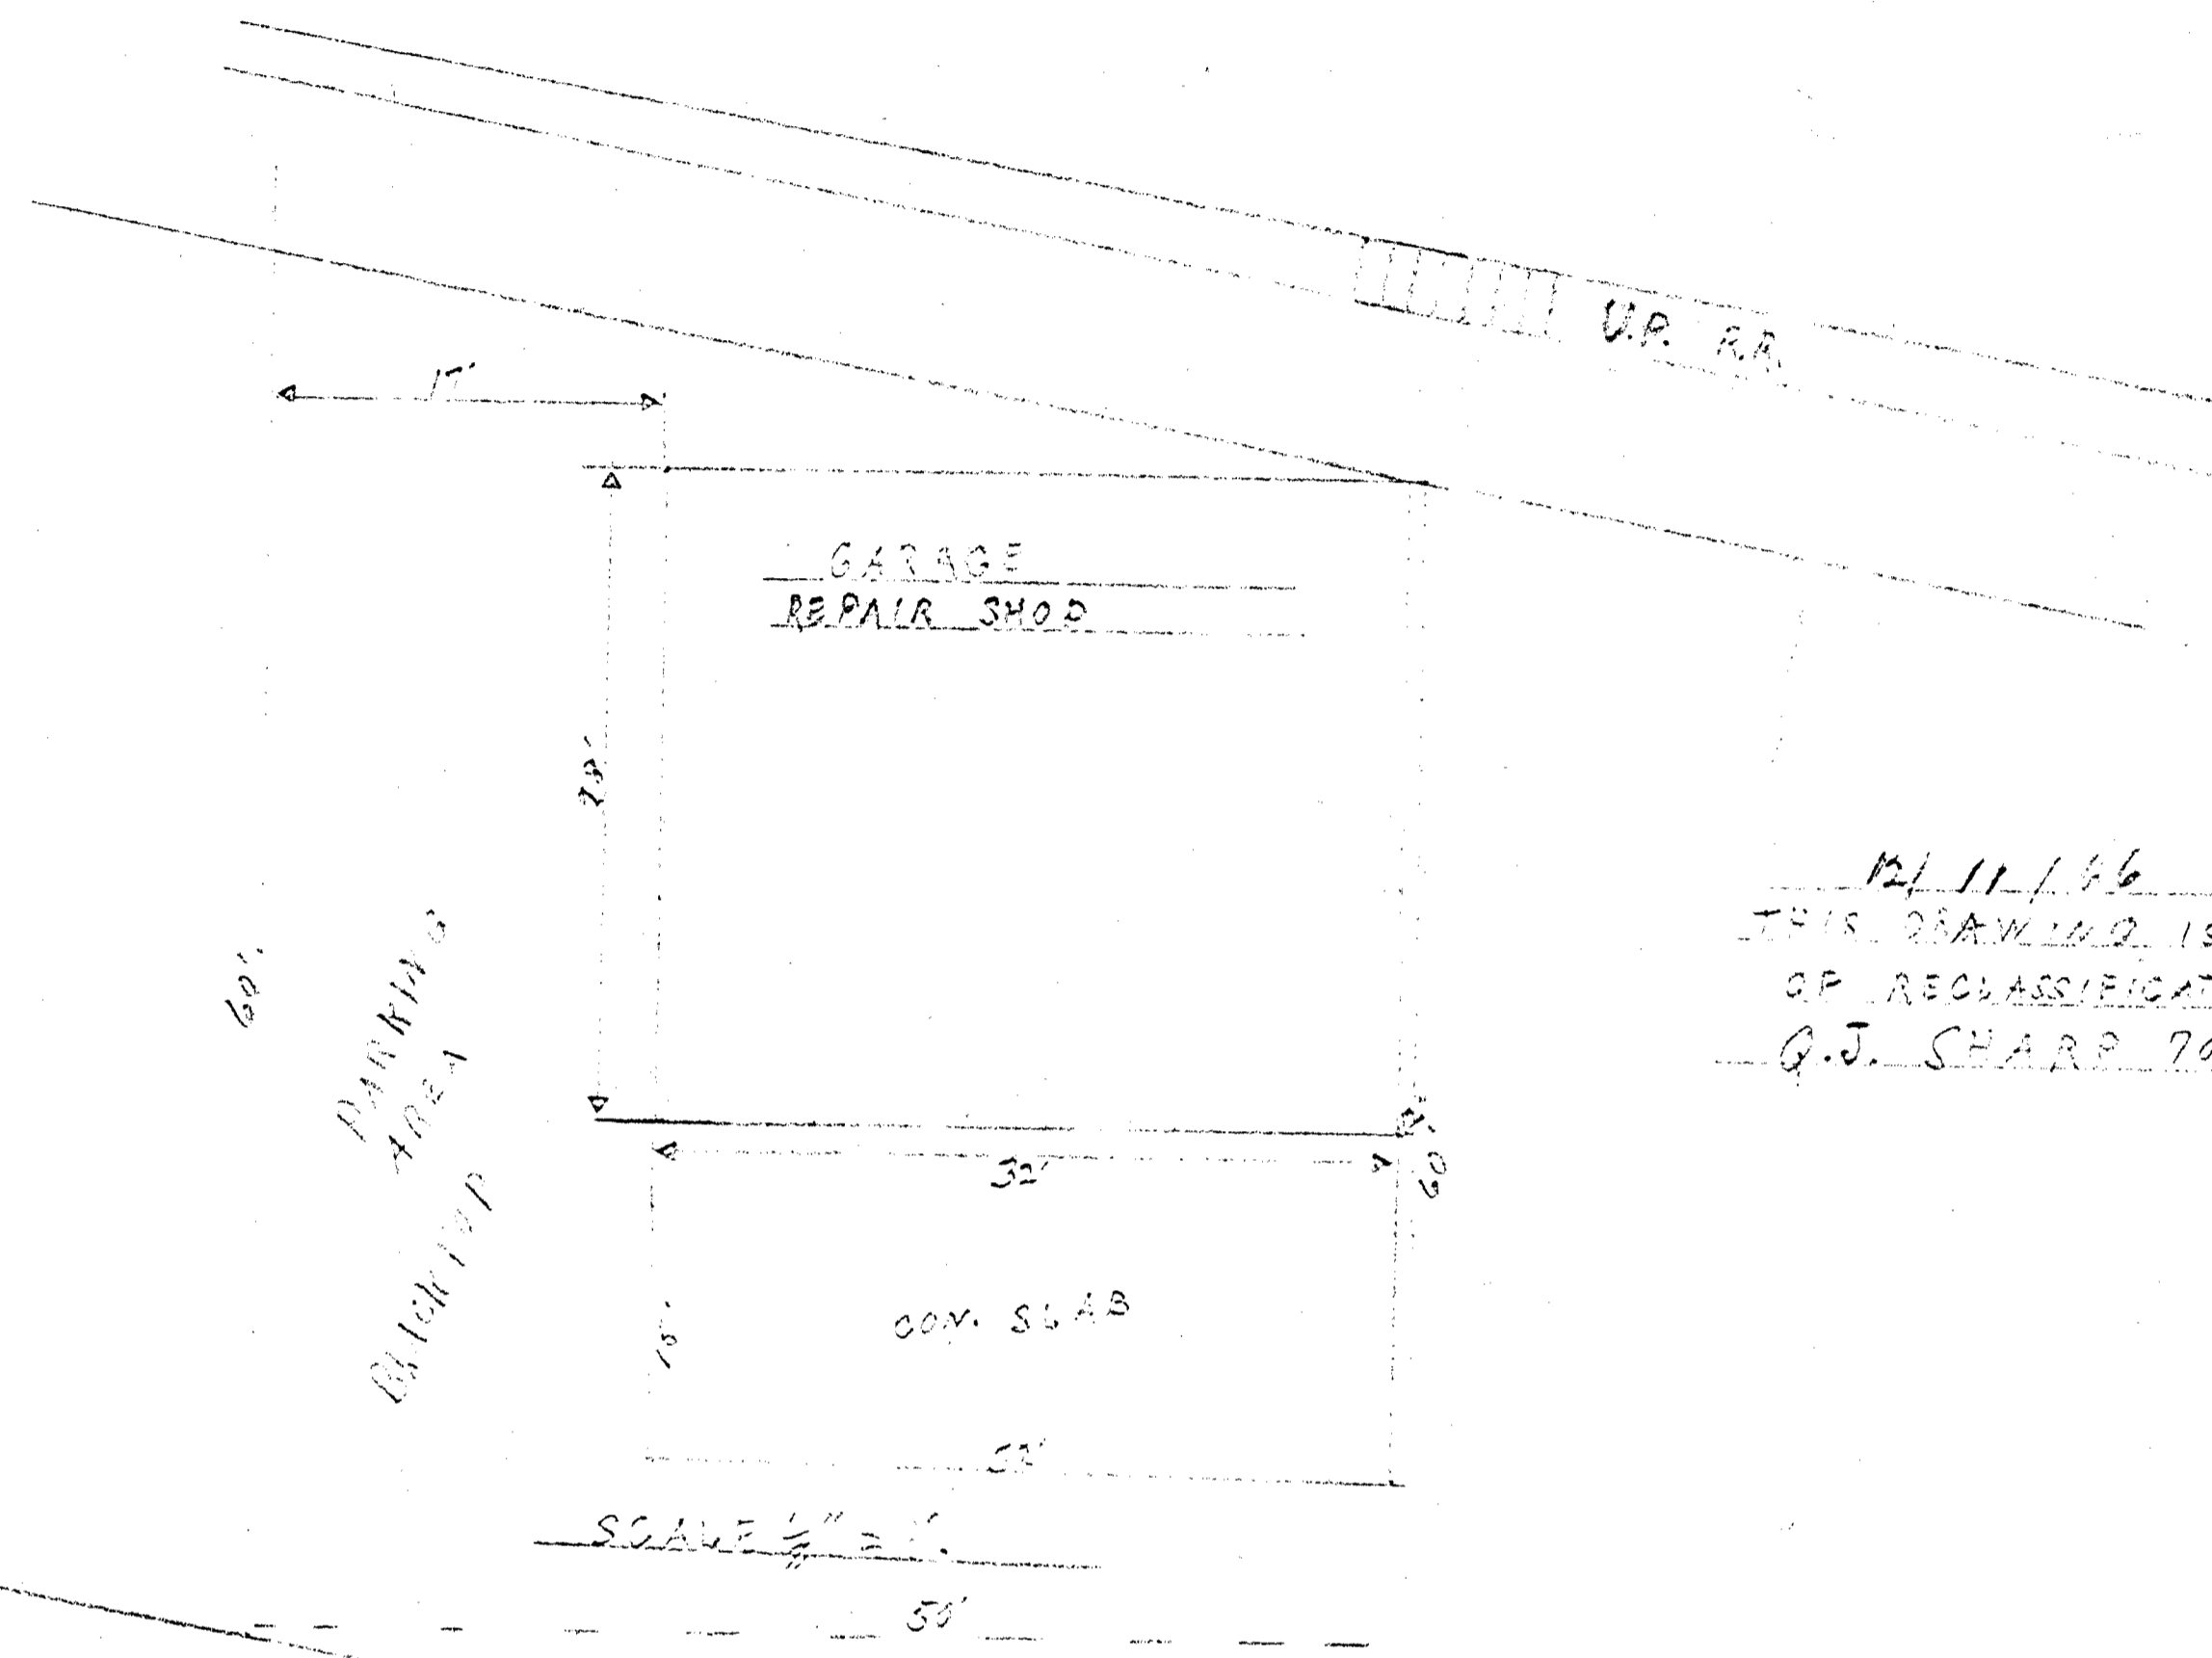


12/11/16  
 THIS DRAWING IS FOR THE PURPOSE  
 OF RECLASSIFICATION OF PROPERTY  
 G.J. SHARP 702 No. 1 St

NO SCALE

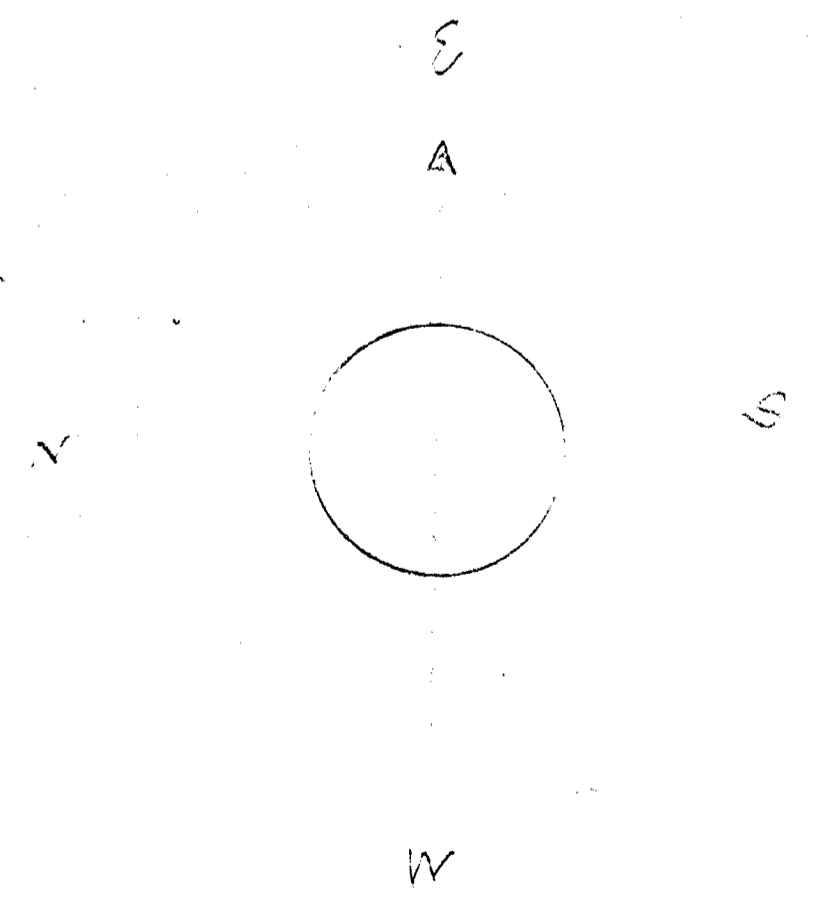

WILSON ST.

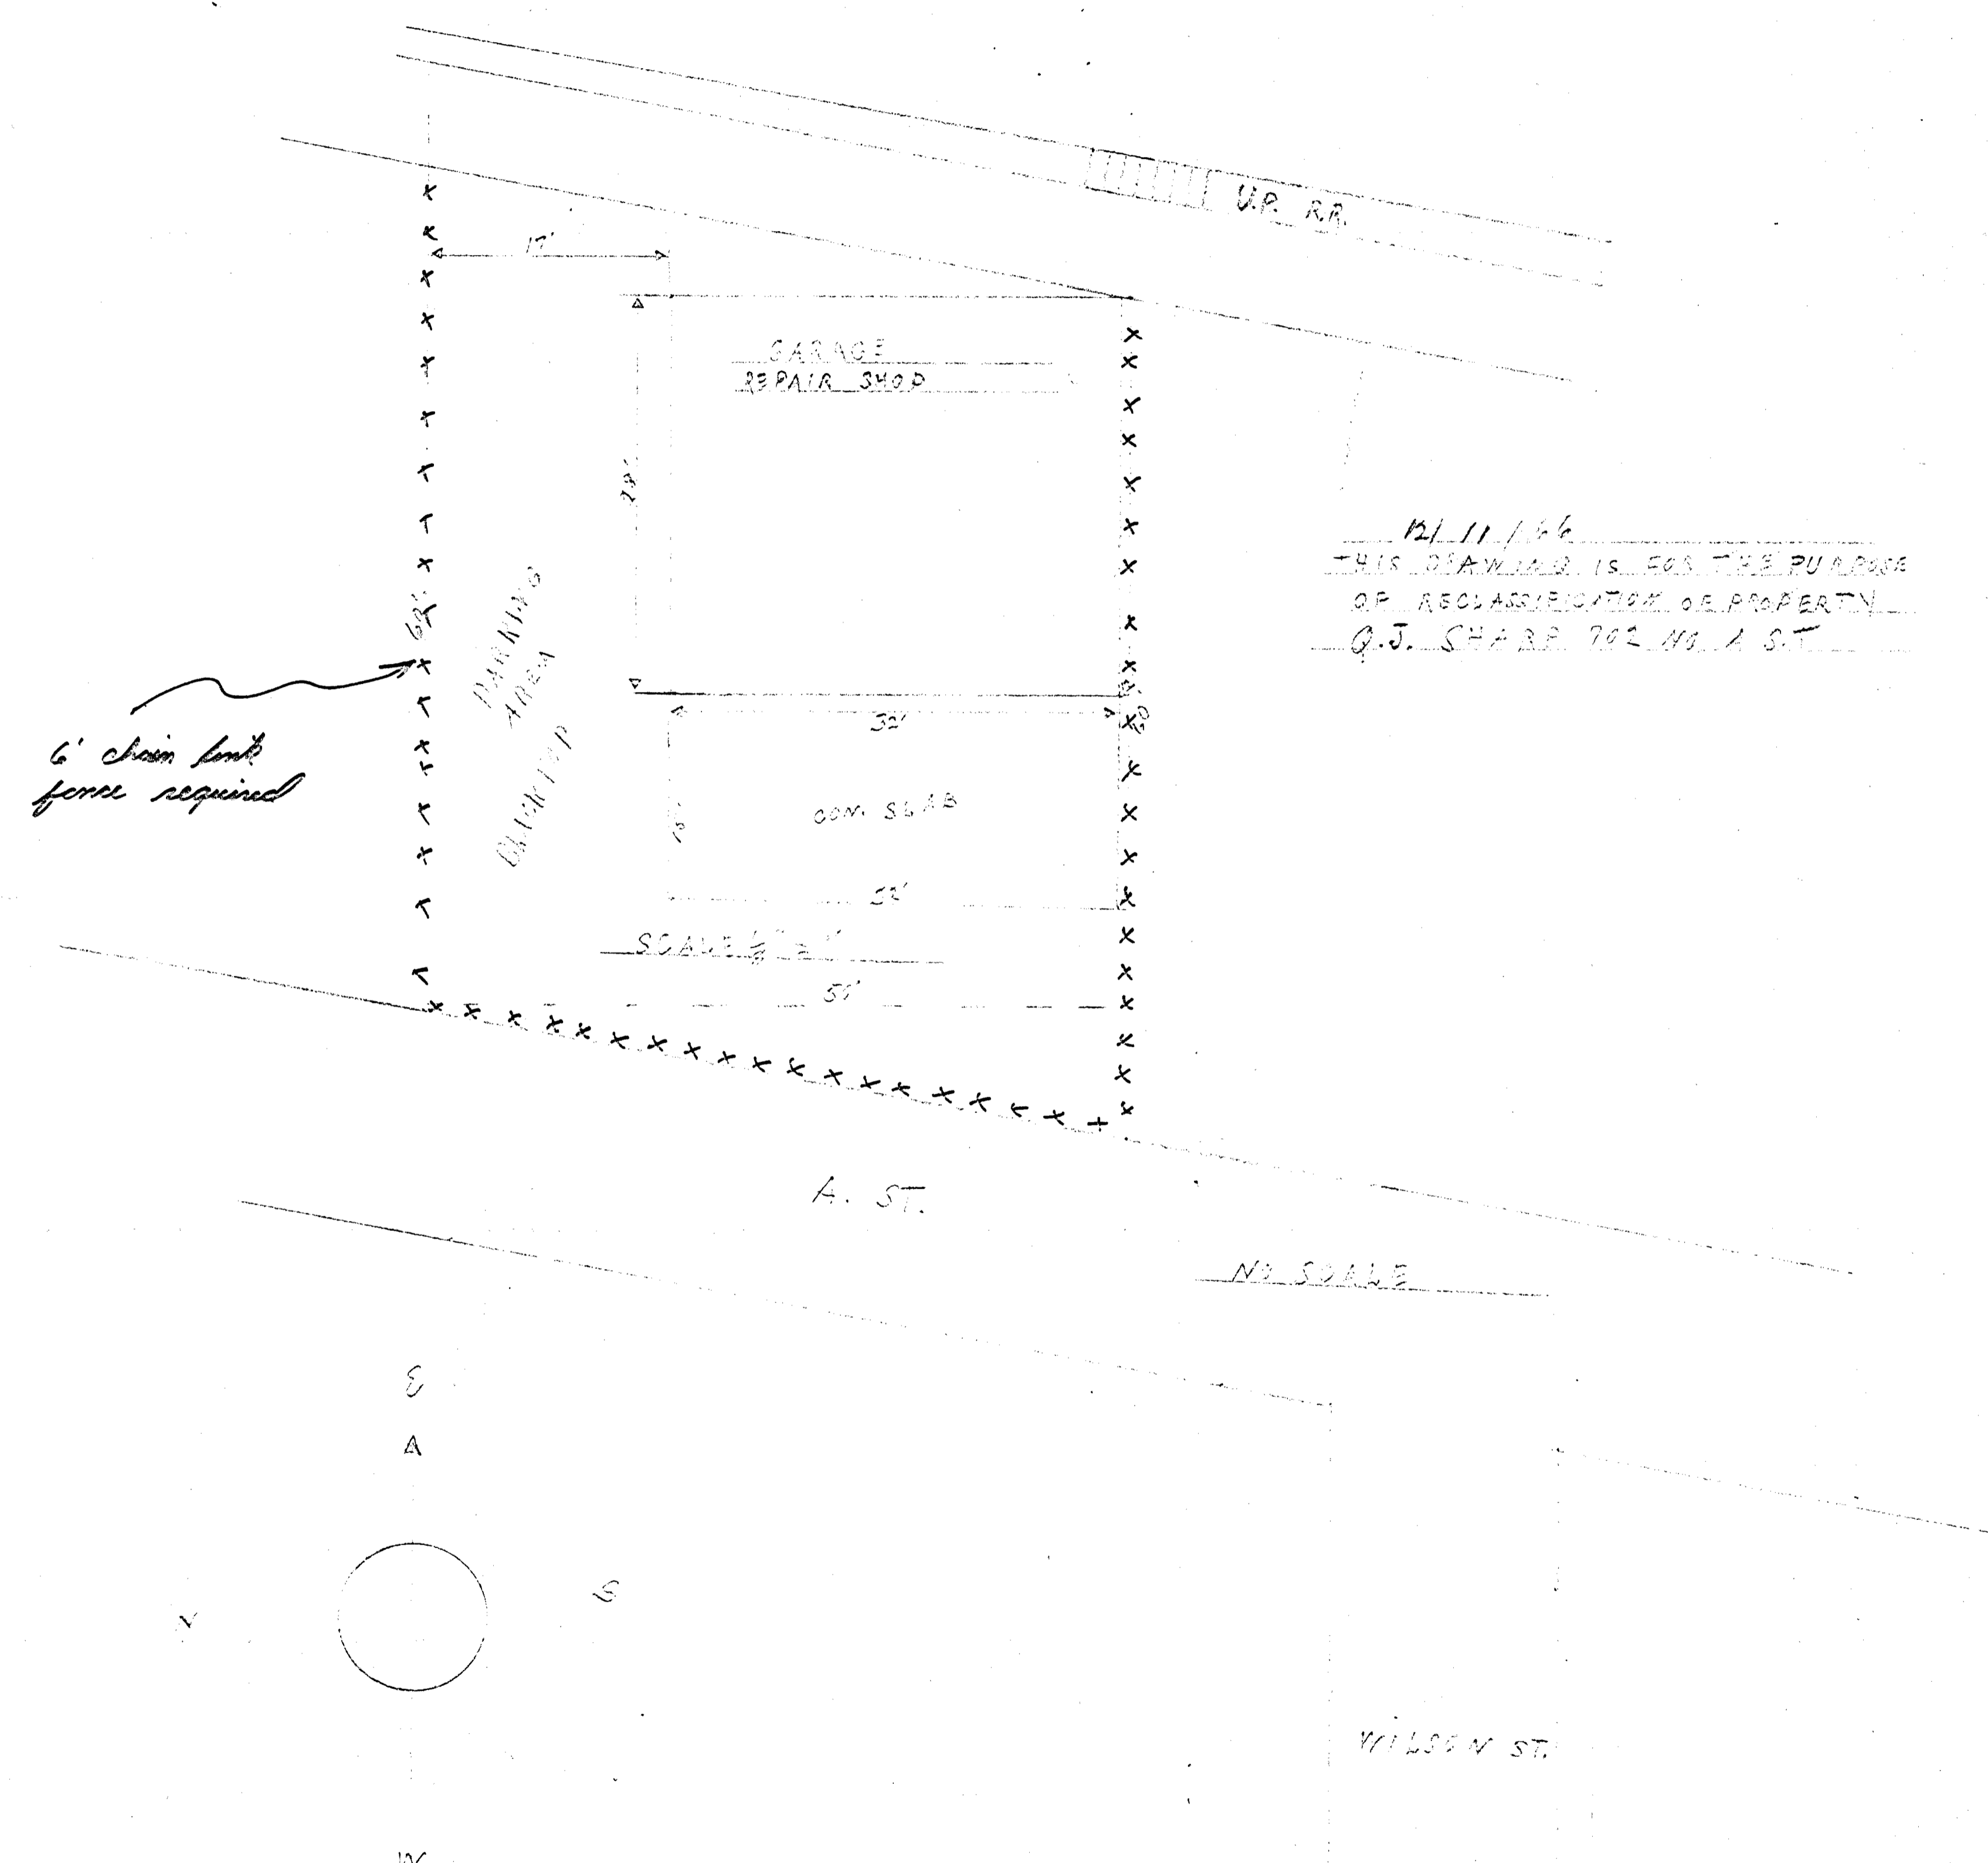

12/11/66  
 THIS DRAWING IS FOR THE PURPOSE  
 OF RECLASSIFICATION OF PROPERTY  
 O.J. SHARP 702 W. A ST.

73

Approved as indicated  
 Displayed P.C. 1/14/67  
 Approved C.C. 1/18/67

Z-73-66