


**EXISTING LANDSCAPING LEGEND**

[Symbol]	PLANTING
[Symbol]	LANDSCAPING
[Symbol]	LANDSCAPING
[Symbol]	LANDSCAPING
[Symbol]	LANDSCAPING

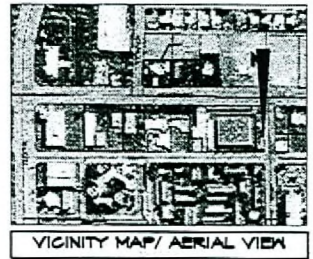

**JOHN VIVIAN**  
ARCHITECT  
P.L.L.C.

225 E. 10th Street, Suite 200  
Charleston, WV 25301  
Tel: (304) 785-1111  
Fax: (304) 785-1112  
www.johnvivian.com

**FAMILY AUTO CARE**

1014 CHARLESTON BLVD  
CHARLESTON, WV

**SITE PLAN REVISED**  
SEPT. 2006

NO. OF SHEETS	1
SHEET NO.	1
DATE	10/05/06
PROJECT	FAMILY AUTO CARE
OWNER	1014 CHARLESTON BLVD
DESIGNED BY	JOHN VIVIAN
DRAWN BY	JOHN VIVIAN
CHECKED BY	JOHN VIVIAN
APPROVED BY	JOHN VIVIAN

**GPA-16201 ZON-16196**  
**SUP-16198 SUP-16200**  
**SDR-16197**  
**REVISED 10/05/06 PC**

**RECEIVED**  
**SEP 07 2006**