


1	2	3	4	5	6
1	2	3	4	5	6

FLOOR PLAN 1145-1150	
UNIT 1	848 S.F.
UNIT 2	848 S.F.
TOTAL	1696 S.F.

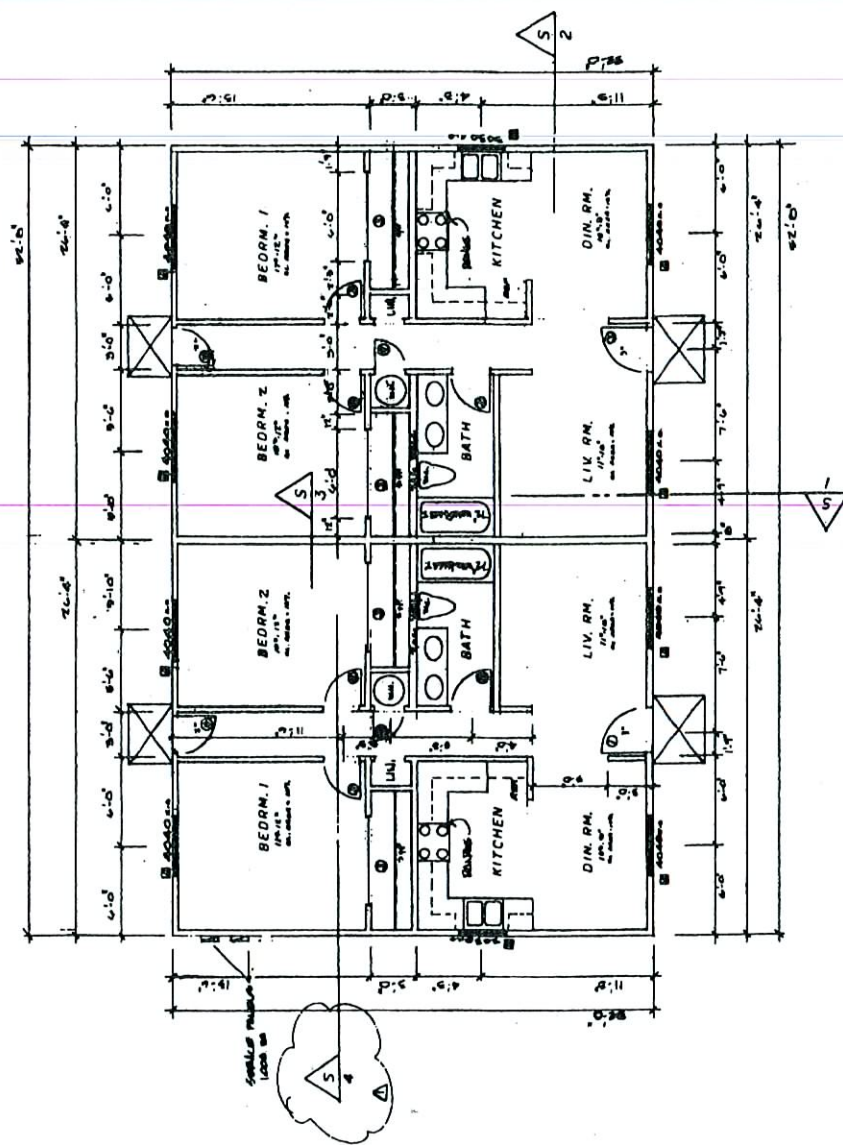

DATE	TIME	TYPE	DATE
1	2	WFL	WFL
2	3	WFL	WFL
3	4	WFL	WFL
4	5	WFL	WFL
5	6	WFL	WFL
6	7	WFL	WFL
7	8	WFL	WFL
8	9	WFL	WFL
9	10	WFL	WFL
10	11	WFL	WFL
11	12	WFL	WFL
12	13	WFL	WFL
13	14	WFL	WFL
14	15	WFL	WFL
15	16	WFL	WFL
16	17	WFL	WFL
17	18	WFL	WFL
18	19	WFL	WFL
19	20	WFL	WFL
20	21	WFL	WFL
21	22	WFL	WFL
22	23	WFL	WFL
23	24	WFL	WFL
24	25	WFL	WFL
25	26	WFL	WFL
26	27	WFL	WFL
27	28	WFL	WFL
28	29	WFL	WFL
29	30	WFL	WFL
30	31	WFL	WFL

RECEIVED
JUL 16 2007

EOT-23240
09-05-07 CC

