

**PLANNING & DEVELOPMENT DEPARTMENT**

**STATEMENT OF FINANCIAL INTEREST**

Case Number: **VAR-29242** APN: **139.25-215.079.**

Name of Property Owner: **FRANK SWEENEY.**

Name of Applicant: **FRANK SWEENEY.**

Name of Representative: **PETER STROTHER.**

To the best of your knowledge, does the Mayor or any member of the City Council or Planning Commission have any financial interest in this or any other property with the property owner, applicant, the property owner or applicant's general or limited partners, or an officer of their corporation or limited liability company?

Yes  No

If yes, please indicate the member of the City Council or Planning Commission who is involved and list the name(s) of the person or persons with whom the City Official holds an interest. Also list the Assessor's Parcel Number if the property in which the interest is held is different from the case parcel.

City Official: \_\_\_\_\_

Partner(s): \_\_\_\_\_

APN: \_\_\_\_\_  
*Frank Sweeney*


Signature of Property Owner: \_\_\_\_\_


Print Name: **FRANK SWEENEY.**

Subscribed and sworn before me

This **29th** day of **July**, 20**08**  
*K. Bunch*

Notary Public in and for said County and State

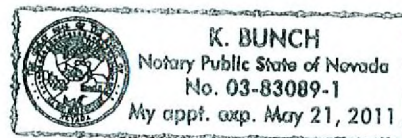

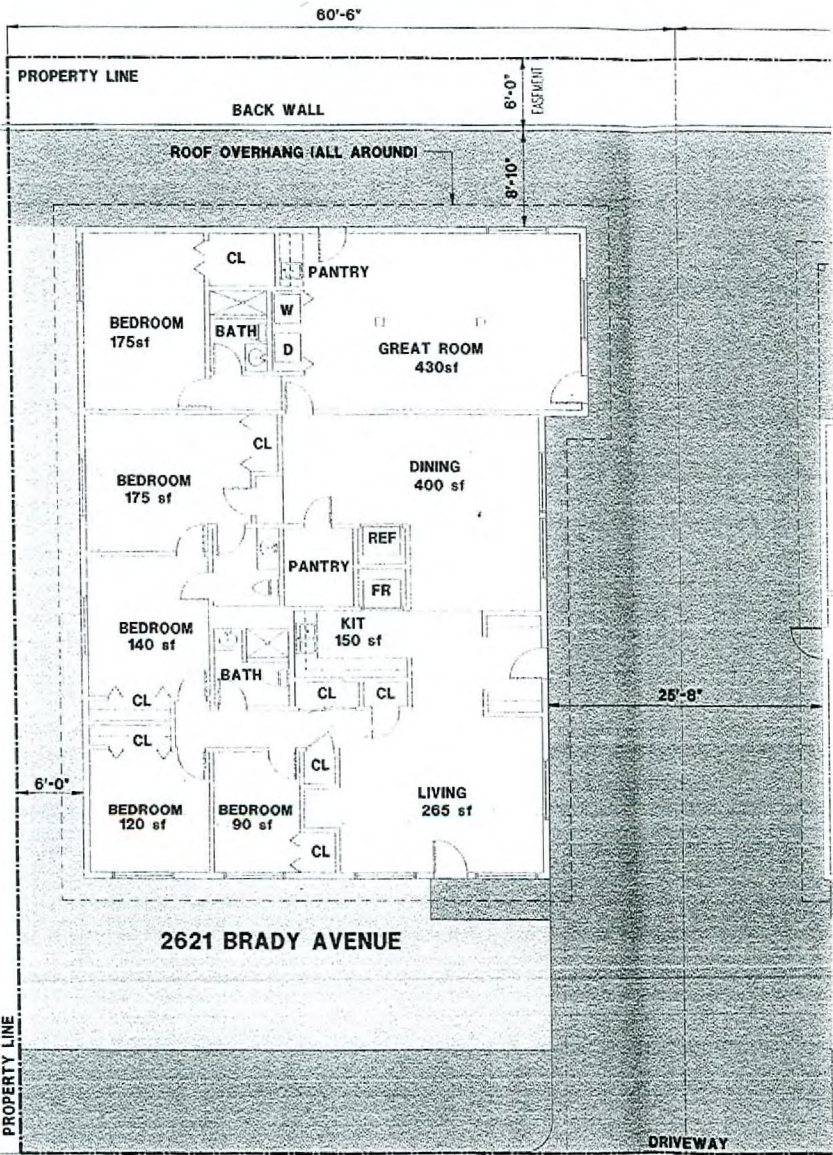

QUEST HOUSE  
RESIDENCE  
LAS VEGAS  
NEVADA

RECEIVED  
JUL 29 2008

EXISTING FLOOR PLAN  
2621 BRADY AVENUE

DATE	
OWNER	
SCALE	
AS-BUILT	
SHEET	A-1

VAR-29242  
08/28/08 PC

PROJECT NO. 08-1  
DATE 08/28/08  
BY PC  
CHECKED PC