



PLANNING & DEVELOPMENT DEPARTMENT

STATEMENT OF FINANCIAL INTEREST

Case Number: **SUP-28990** APN: 126-24-517-001

Name of Property Owner: Providence Village, LLC

Name of Applicant: Providence Village, LLC

Name of Representative: Jones Vargas -- Katie Fellows

To the best of your knowledge, does the Mayor or any member of the City Council or Planning Commission have any financial interest in this or any other property with the property owner, applicant, the property owner or applicant's general or limited partners, or an officer of their corporation or limited liability company?

☐ Yes

☒ No

If yes, please indicate the member of the City Council or Planning Commission who is involved and list the name(s) of the person or persons with whom the City Official holds an interest. Also list the Assessor's Parcel Number if the property in which the interest is held is different from the case parcel.

City Official: _____

Partner(s): _____

APN: _____

Signature of Property Owner: 


Print Name: Manager, Greenstreet Properties (its manager)


Subscribed and sworn before me

This 3rd day of July, 2008

Carole A. Willard

Notary Public in and for said County and State

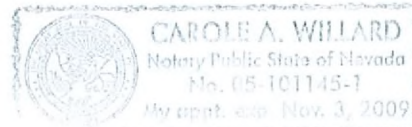

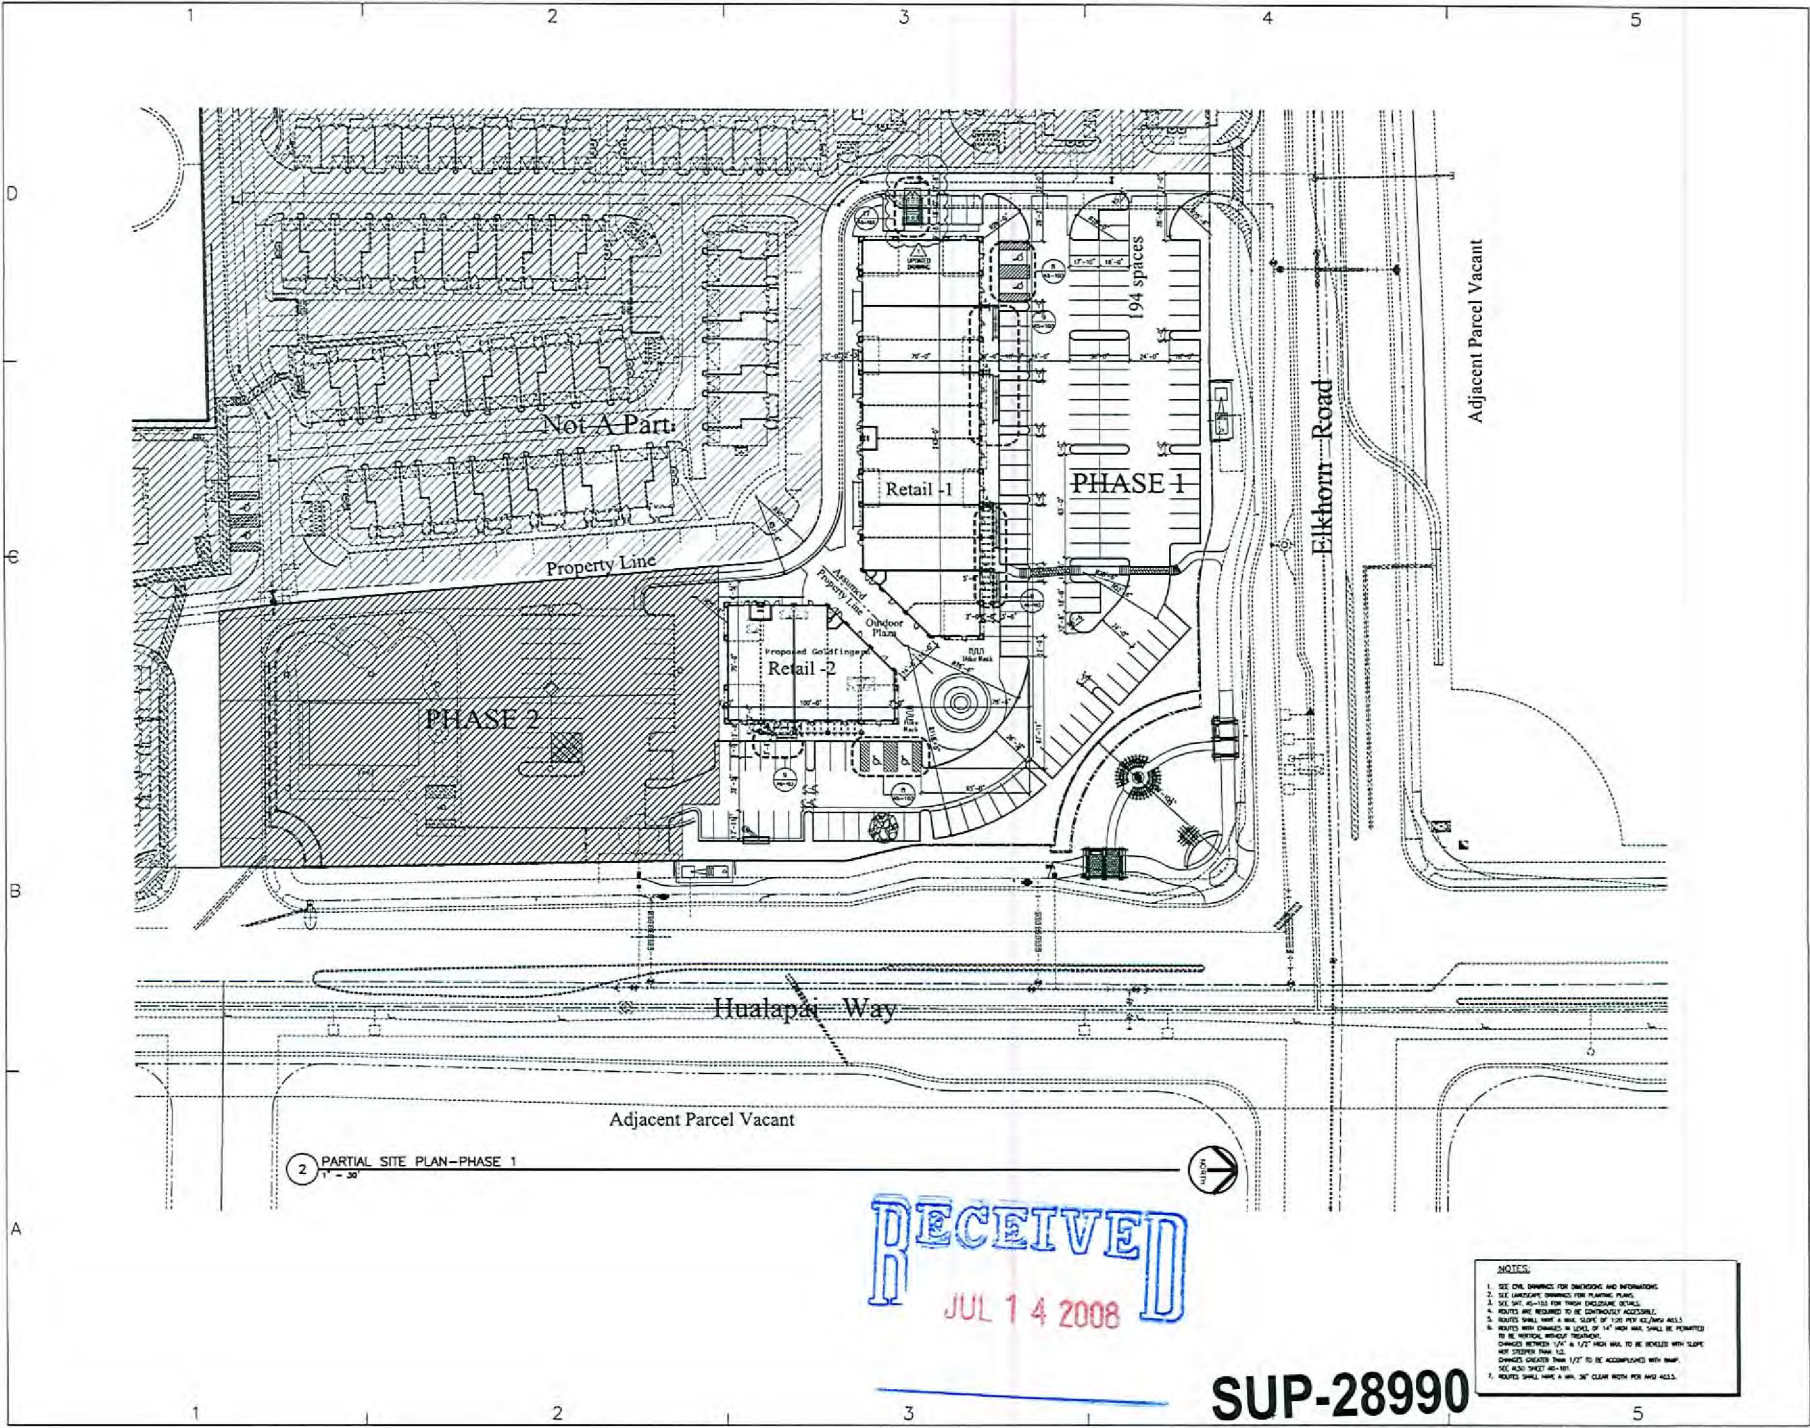

RECEIVED

JUL 14 2008

- NOTES**
1. SEE THE DRAWING FOR DIMENSIONS AND INFORMATION.
 2. SEE LANDSCAPE DRAWING FOR PLANTING PLANS.
 3. SEE S&P 40-113 FOR TRASH ENCLOSURE DETAILS.
 4. ROUTES ARE REQUIRED TO BE CONTINUOUSLY ACCESSIBLE.
 5. RAISED WALKWAYS SHALL HAVE A MIN. SLOPE OF 1/8" PER FOOT AND SHALL BE FINISHED TO BE MAINTAINED WITHOUT REPAIRS.
 6. RAISED WALKWAYS SHALL HAVE A 1/4" HIGH CURB TO BE FINISHED WITH SLOPE NOT GREATER THAN 1/2" TO BE ACCOMMODATED WITH WALK.
 7. SEE ALSO SHEET 40-111.
 8. RAISED WALKWAYS SHALL HAVE A MIN. 30" CLEAR WIDTH FOR ADA ACCESS.

SUP-28990

08/28/08 PC

707036
PROVIDENCE MIXED-USE

Perlman

710 Las Vegas, LLC
A Partner Design Group Company
2235 CORPORATE CIRCLE
SUITE 200
HENDERSON, NEVADA 89074
702.900.9900 702.933.3222 fax



Rev.	Date	By	Description
1	12/13/07	P1	PLAN CHECK COMMENTS / N-HOUSE COORDINATION
2	12/17/07	P1	PLAN CHECK COMMENTS / N-HOUSE COORDINATION

Providence Mixed-Use

Retail 1, 2 & 3

PROJECT STREET
Las Vegas, NV 89000

GREEN STREET PROPERTIES

Chief Street, NV, 89000


Drawn/Checked By: WHP/T

Date: 12/17/07

Project Number: 707036

Sheet Number: PARTIAL SITE PLAN PHASE 1

AS-102

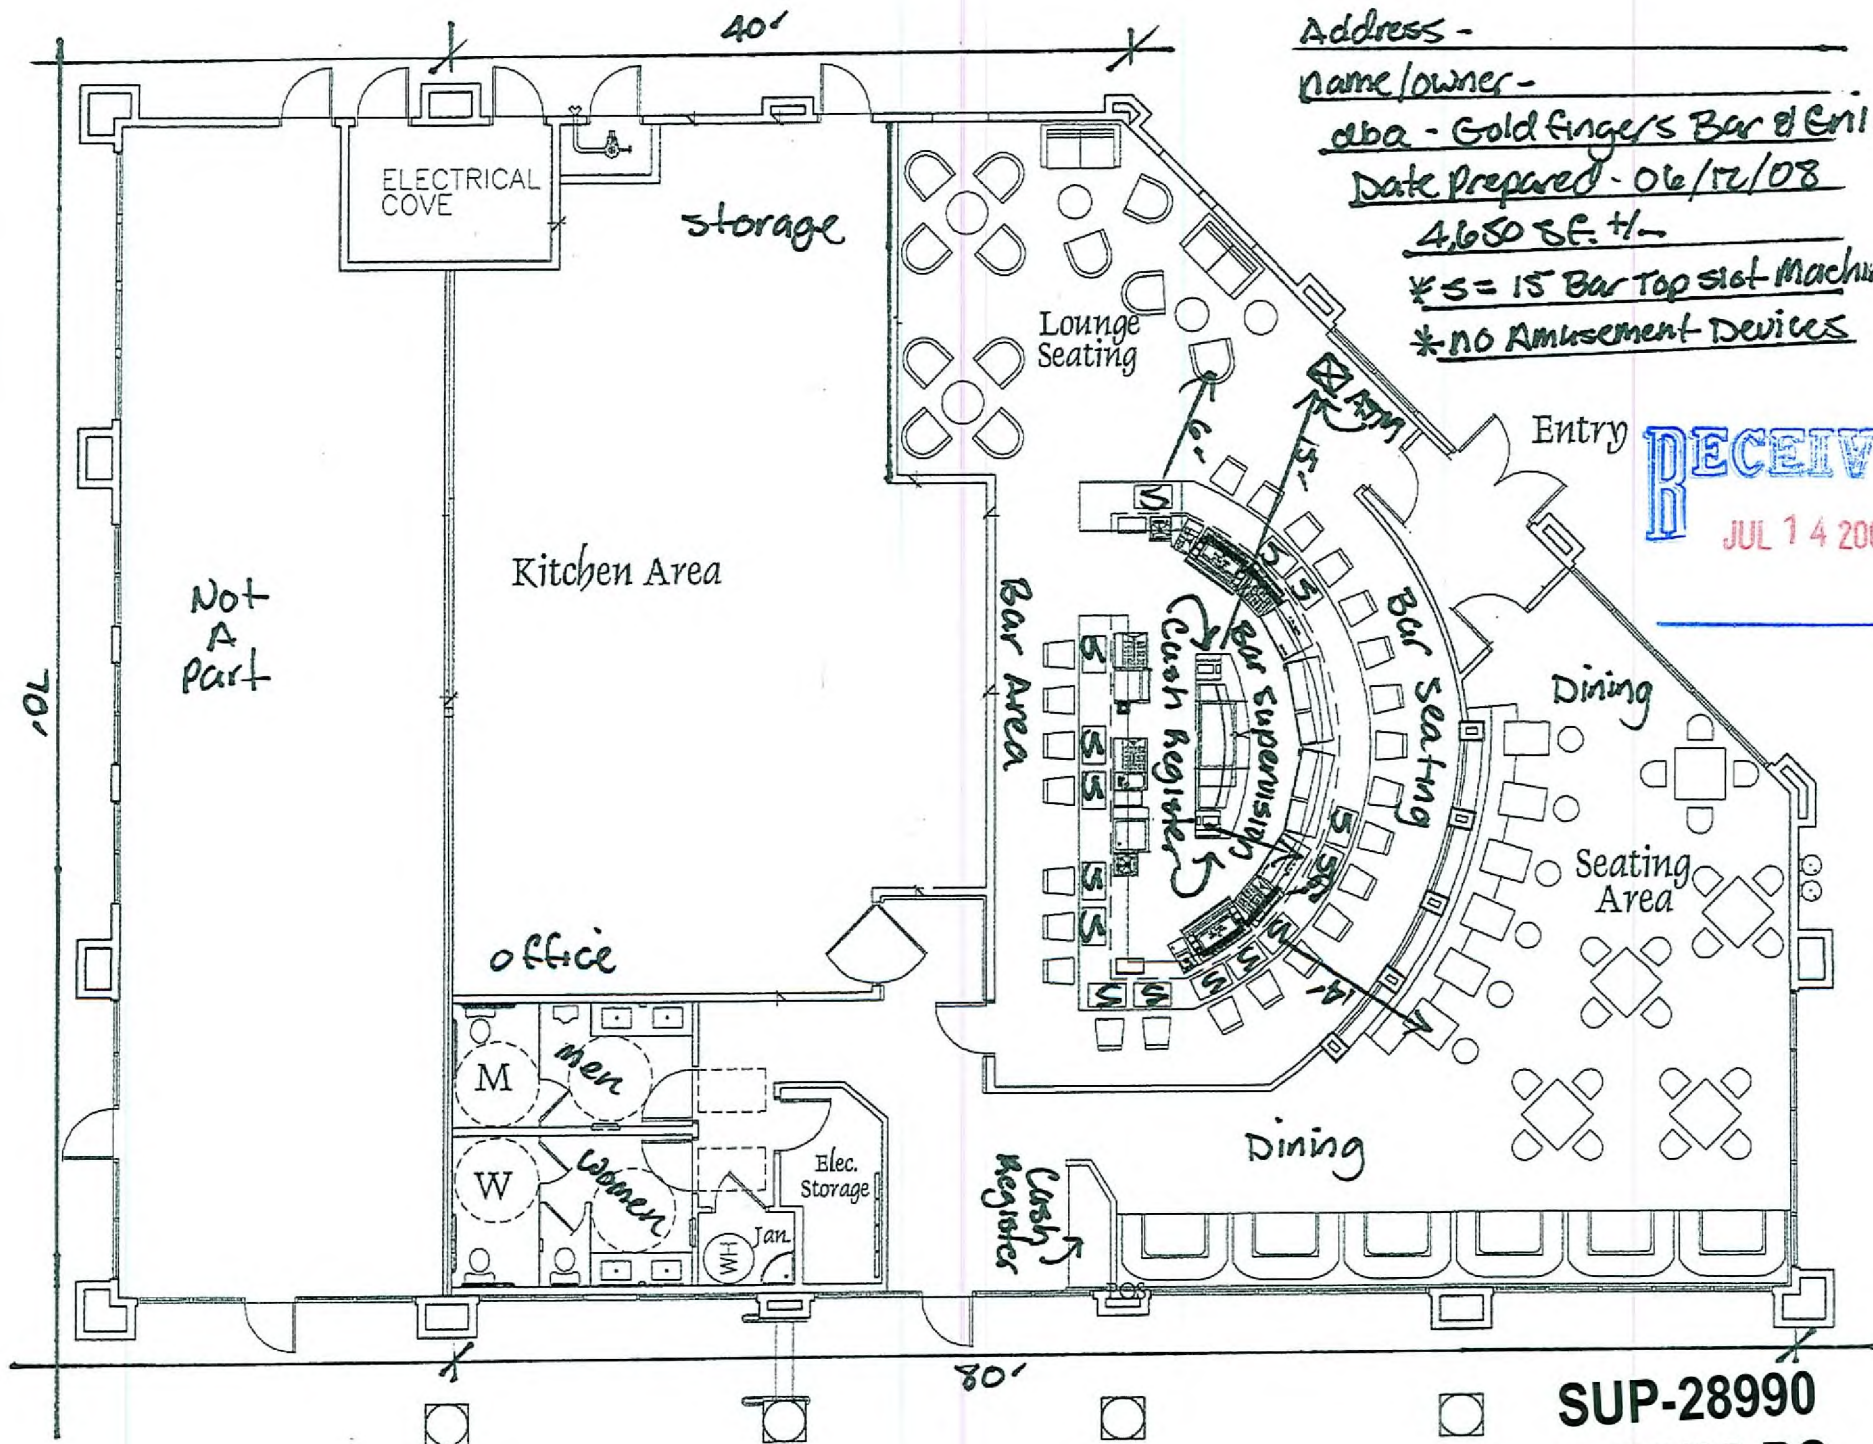

Address -
Name/owner -
dba - Gold Finger's Bar & Grill
Date Prepared - 06/12/08
4,650 SF. +/-
* 5 = 15 Bar Top slot machines
* NO Amusement Devices

RECEIVED
JUL 14 2008

SUP-28990
08/28/08 PC