

GROUND FLOOR PLAN-RENOVATION
1/2" = 1'-0"

EOT-29688
10-15-08 CC

RECEIVED
AUG 27 2008

Pawn Plus
Construction Documents
212 S. Las Vegas Blvd.
Las Vegas, Nevada 89101

APTUS Architecture

1300 South 4th Street
Suite 204
Las Vegas, Nevada 89104
P 702.899.1300
F 702.899.1311

APTUS PROJECT NO. 07.151

ARCHITECT

ENGINEER

NOTES

COPYRIGHT 2008 © BY APTUS ARCHITECTURE

City of Las Vegas	7.10.08
Planbook Response	
City of Las Vegas Plan Check	4.20.08
Owner Approval	4.17.08
NO. DESCRIPTION	DATE

ISSUED

THE GROUND FLOOR PLAN


DRAWING NO.
A100
Pawn Plus

C:\Documents and Settings\jgallagher\My Documents\212 S. Las Vegas Blvd\212 S. Las Vegas Blvd\10-15-08\10-15-08.dwg

REFER TO
CONSTRUCTION
DOCUMENTS
FOR ALL
DETAILS
NOT SHOWN
HEREIN

NO FINE
SAY WORK TO
EXISTING
FLOOR
EXISTING
FLOOR

DEMO PLAN
1/4" = 1'-0"

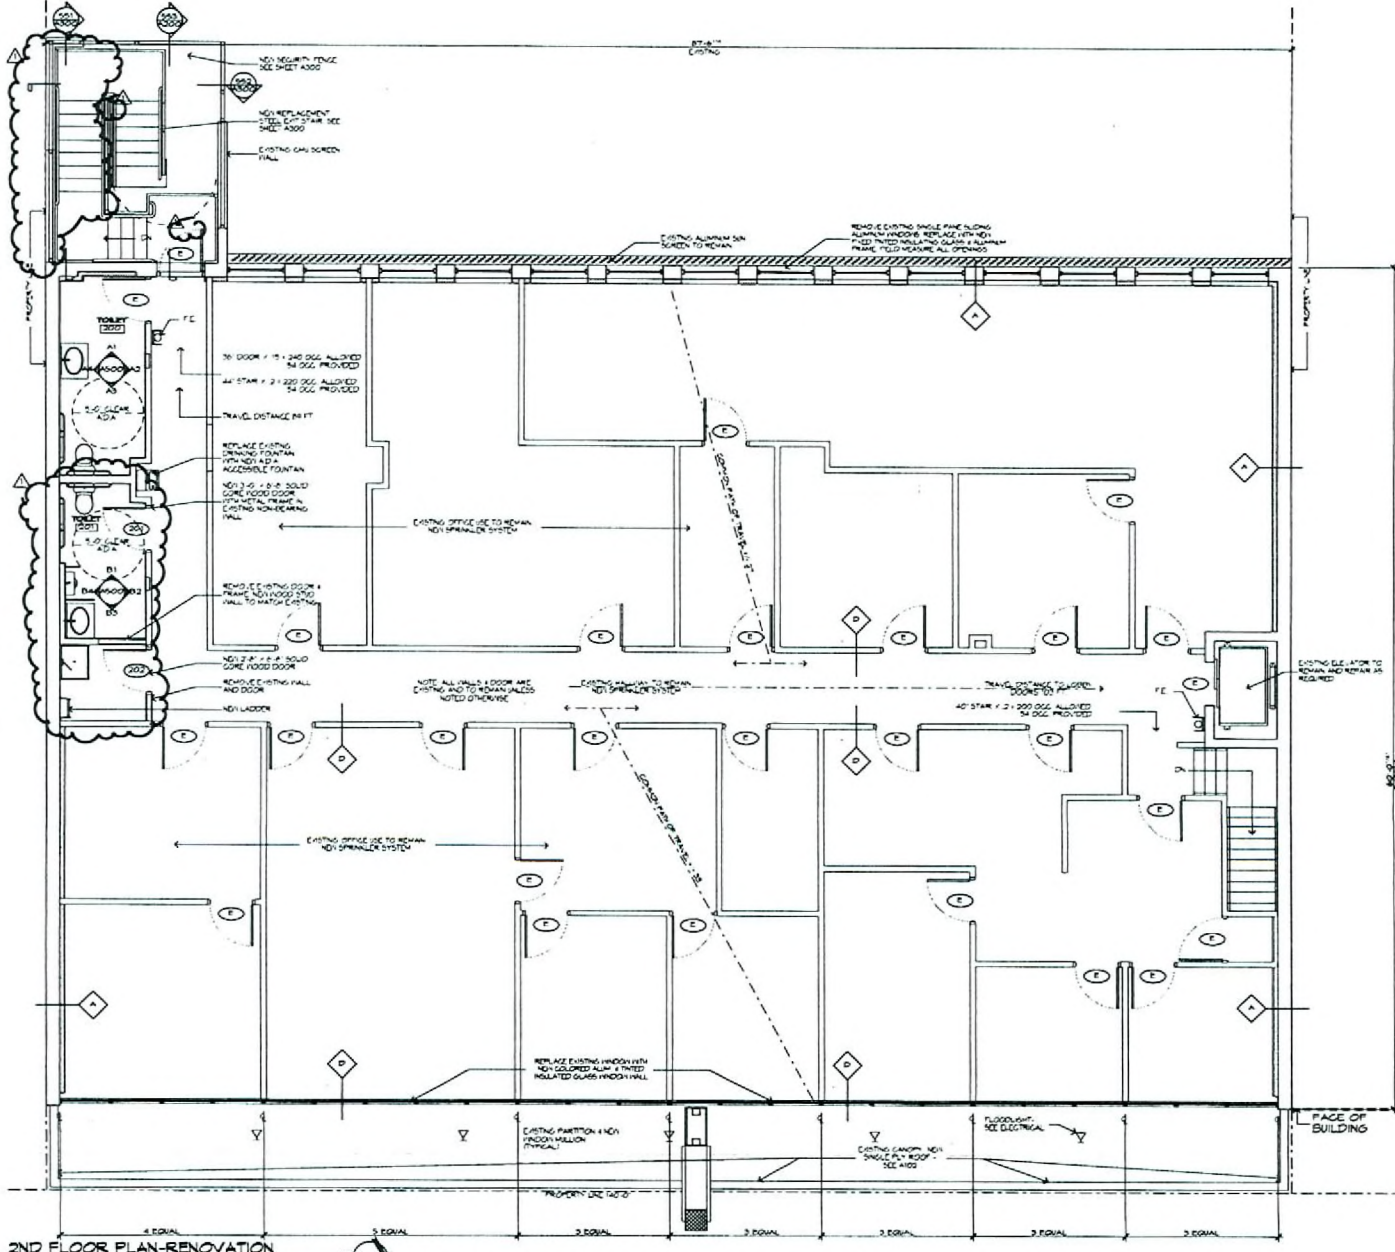

2ND FLOOR PLAN-RENOVATION
1/4" = 1'-0"

EOT-29688
10-15-08 CC

RECEIVED

AUG 27 2008

Pawn Plus
Construction Documents
212 S. Las Vegas Blvd.
Las Vegas, Nevada 89101

APTUS Architecture

1700 South 4th Street
Suite 200
Las Vegas, Nevada 89104
P 702.491.1200
F 702.491.1211

APTUS PROJECT NO. 07.151
ARCHITECT

ENGINEER

NOTES

COPYRIGHT 2008 BY APTUS ARCHITECTURE

City of Las Vegas Mechanical Approver	7.18.08
City of Las Vegas Plan Check	8.20.08
Owner Approval	8.17.08
NO. DESCRIPTION	DATE


ISSUED

TITLE
2ND FLOOR PLAN


DRAWING NO.

A101
Prawn Plus

C:\Documents and Settings\apawn\My Documents\2008\10-15-08\29688\29688.dwg 11/18/08 11:08:11 AM

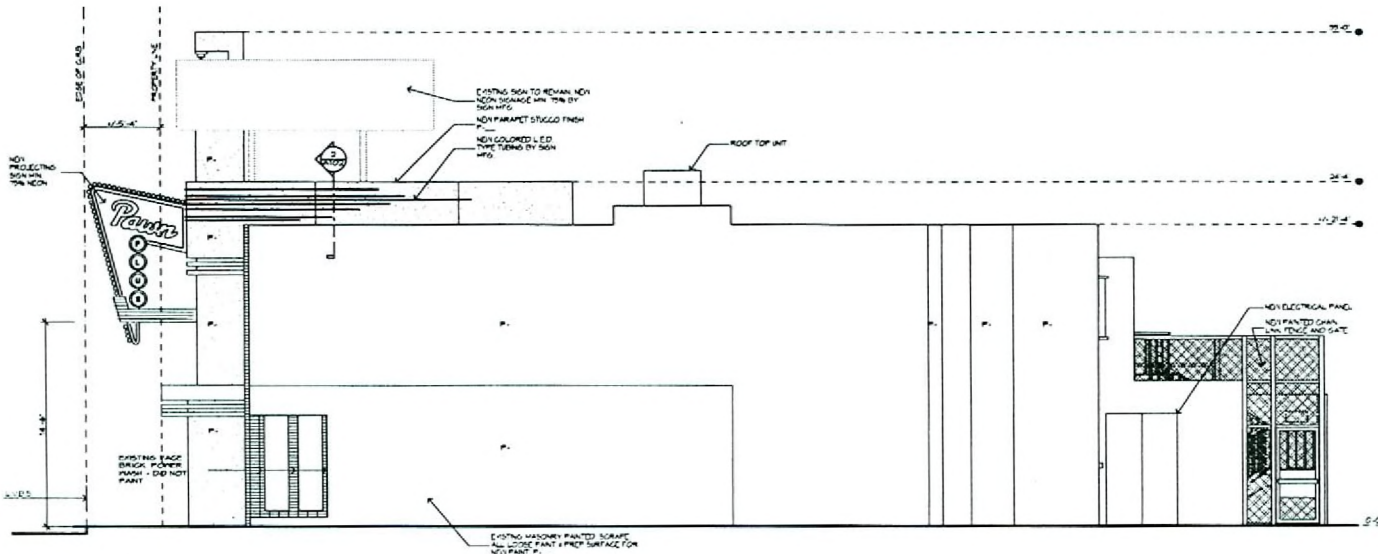

NORTH ELEVATION (SIDE)

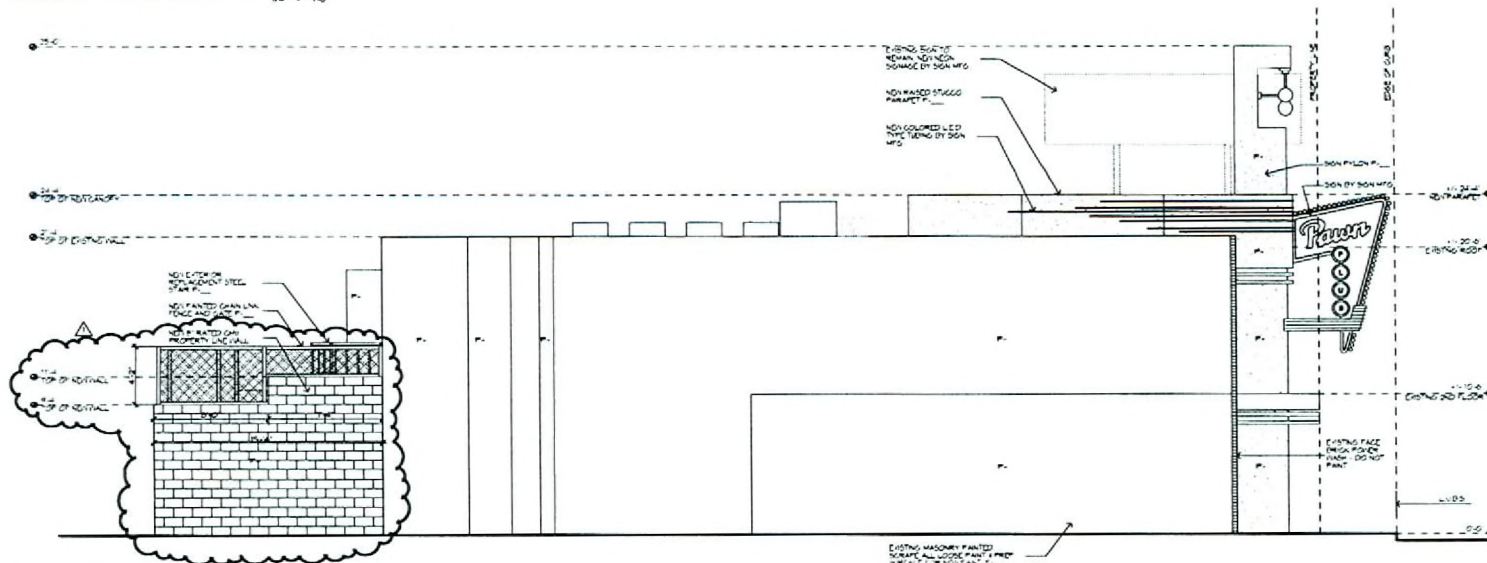

SOUTH ELEVATION (SIDE)

EOT-29688
10-15-08 CC

RECEIVED

AUG 27 2008

Pawn Plus
 Construction Documents
 212 S. Las Vegas Blvd.
 Las Vegas, Nevada 89101

APTUS Architecture

1200 South Ash Street
 Suite 200
 Las Vegas, Nevada 89104
 P 702.899.1000
 F 702.899.1212

APTUS PROJECT NO. 07.151
 ARCHITECT

ENGINEER

NOTES

COPYRIGHT 2008 © BY APTUS ARCHITECTURE

City of Las Vegas	7.10.08
Plancheck Response	8.20.08
City of Las Vegas Plan Check	8.17.08
Owner Approval	

ISSUED

NO.	DESCRIPTION	DATE

TITLE
NORTH & SOUTH ELEVATIONS

DRAWING NO.
A201
 Plan Set

