

PLANNING & DEVELOPMENT DEPARTMENT

STATEMENT OF FINANCIAL INTEREST

Case Number: **SUP-34765** APN: 126-24-517-001

Name of Property Owner: **Providence Village, LLC**

Name of Applicant: **House of Vino LLC**

To the best of your knowledge, does the Mayor or any member of the City Council, Planning Commission, or a Hearings Officer have any financial interest in this or any other property with the property owner, applicant, the property owner or applicant's general or limited partners, or an officer of their corporation or limited liability company?

 
Yes X No

If yes, please indicate the member of the City Council, Planning Commission or Hearings Officer who is involved and list the name(s) of the person or persons with whom the City Official holds an interest. Also list the Assessor's Parcel Number if the property in which the interest is held is different from the case parcel.

City Official: _____

Partner(s): _____


APN: _____

Signature of Property Owner/Authorized Agent: 

Subscribed and sworn before me

This 20 day of May, 2009

Notary Public in and for said County and State

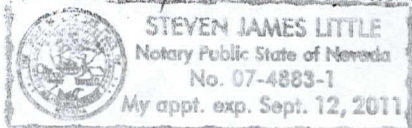


RECEIVED

JUN 05 2009

EXHIBIT "A"

SITE PLAN

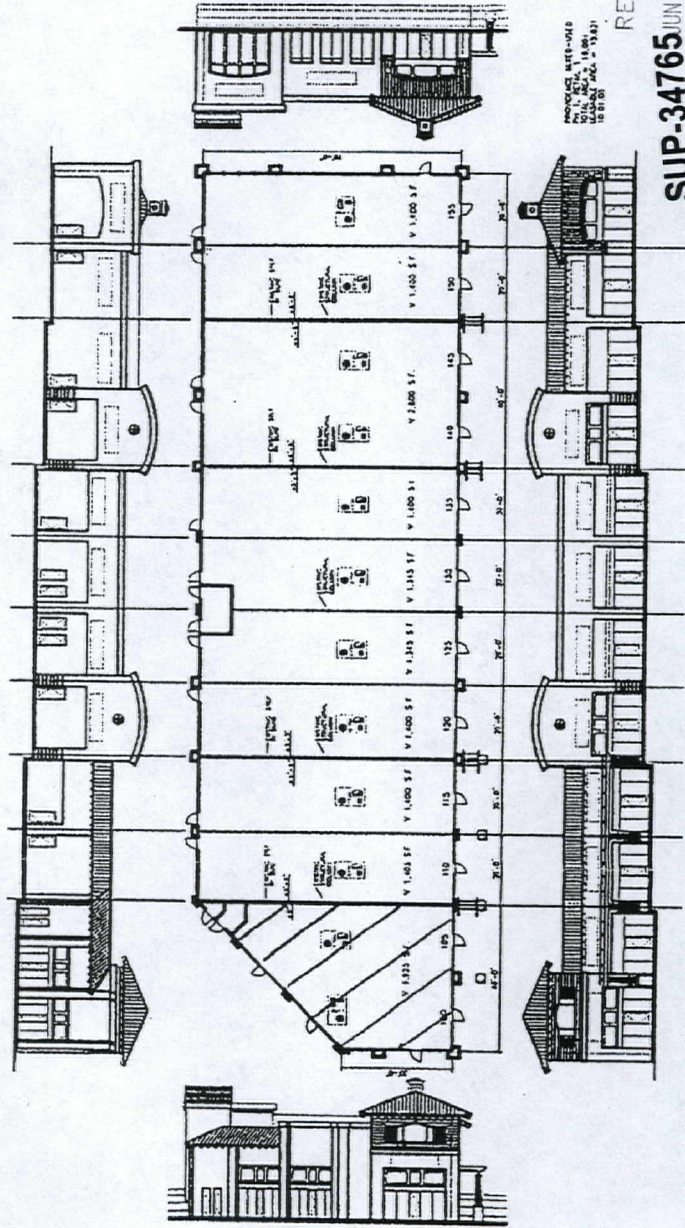

PROJECT: SUP-018
 DATE: 05/18/09
 BY: [Signature]
 10/10/09

RECEIVED

SUP-34765 JUN 05 2009

07/23/09 PC

PROVIDENCE MIXED-USE

Perleman




707036 RECEIVED
707036 RECEIVED
RETAIL 2 BUILDING
ELEVATION
JUN 05 2009
A-202



Rev	Date	By	Description
1	10/17/09	PAJ	PLAN CHECK SUBMITTAL
2	10/17/09	PAJ	PLAN CHECK COMMENTS / M-HOUSE COORDINATION


PROVIDENCE MIXED-USE
Retail 1, 2 & 3
Las Vegas, Nevada 89178
GREENSTREET PROPERTIES
2320 PARKER DR PHASE 2, SUITE 300
LAS VEGAS, NV 89102

Drawn/Checked By: JPD
Date: 12/17/07
Project Number: 707036
Sheet Number: RETAIL 2 BUILDING ELEVATION
JUN 05 2009
A-202

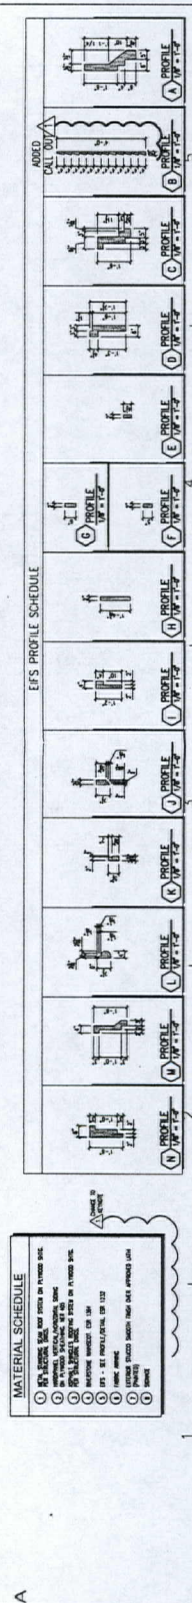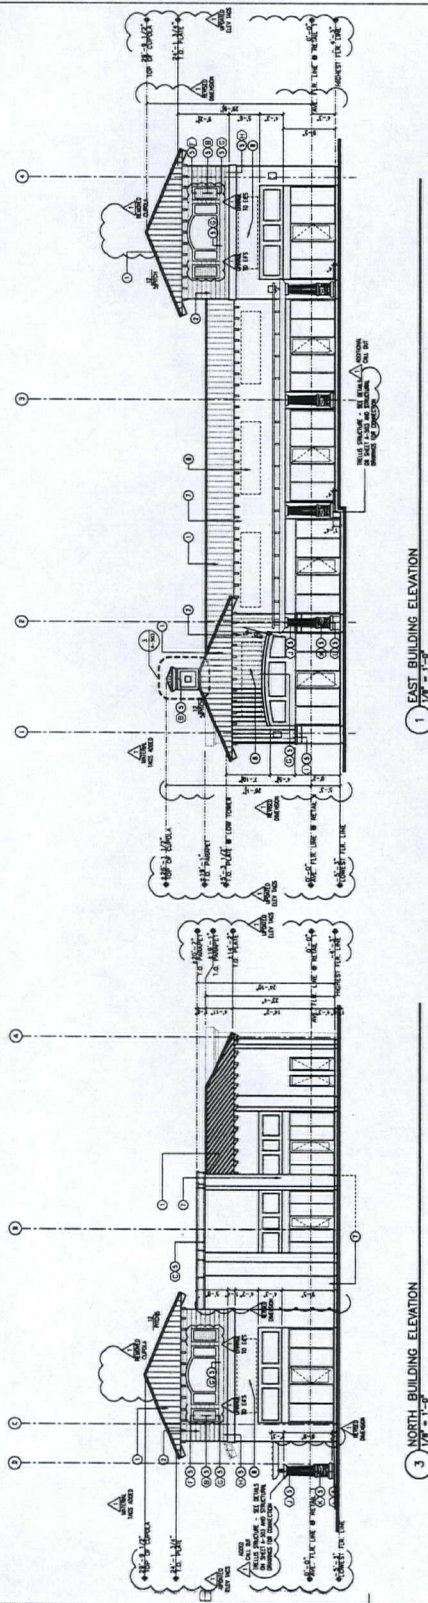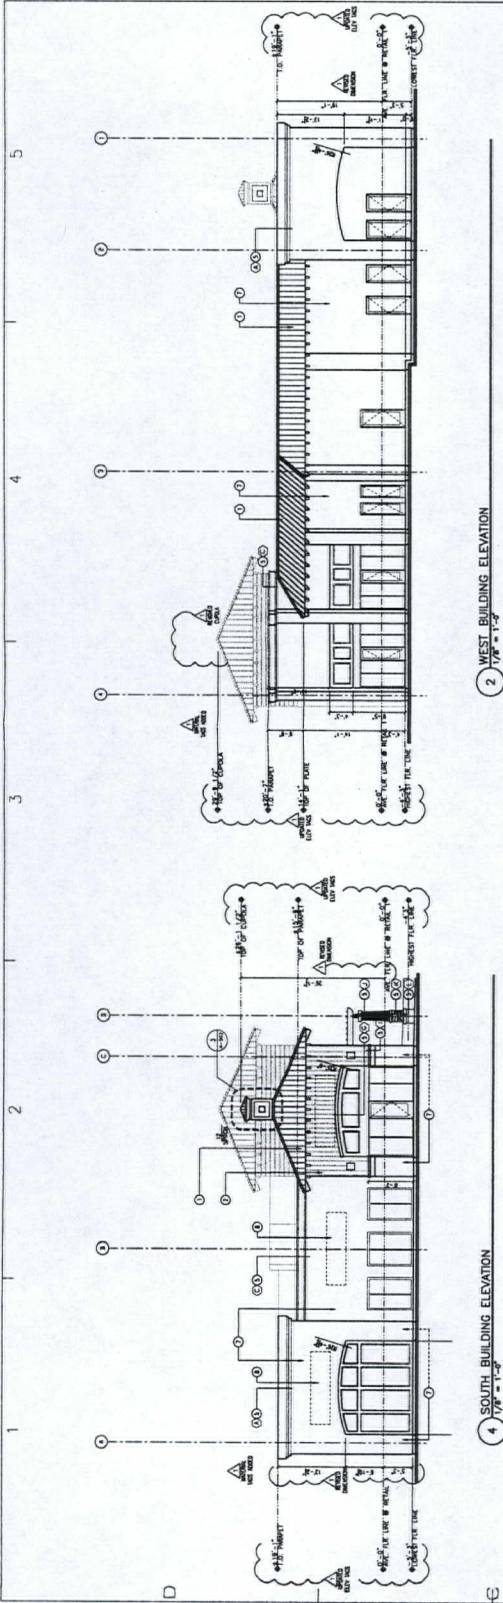

MATERIAL SCHEDULE

1	STAINLESS STEEL	SEE SPEC FOR FINISH AND HATCH
2	BRASS	SEE SPEC FOR FINISH AND HATCH
3	ALUMINUM	SEE SPEC FOR FINISH AND HATCH
4	GLASS	SEE SPEC FOR FINISH AND HATCH
5	PAINT	SEE SPEC FOR FINISH AND HATCH
6	ROOFING	SEE SPEC FOR FINISH AND HATCH
7	LANDSCAPE	SEE SPEC FOR FINISH AND HATCH
8	MECHANICAL	SEE SPEC FOR FINISH AND HATCH
9	ELECTRICAL	SEE SPEC FOR FINISH AND HATCH
10	PLUMBING	SEE SPEC FOR FINISH AND HATCH
11	HEATING	SEE SPEC FOR FINISH AND HATCH
12	Cooling	SEE SPEC FOR FINISH AND HATCH
13	Structural	SEE SPEC FOR FINISH AND HATCH
14	Other	SEE SPEC FOR FINISH AND HATCH

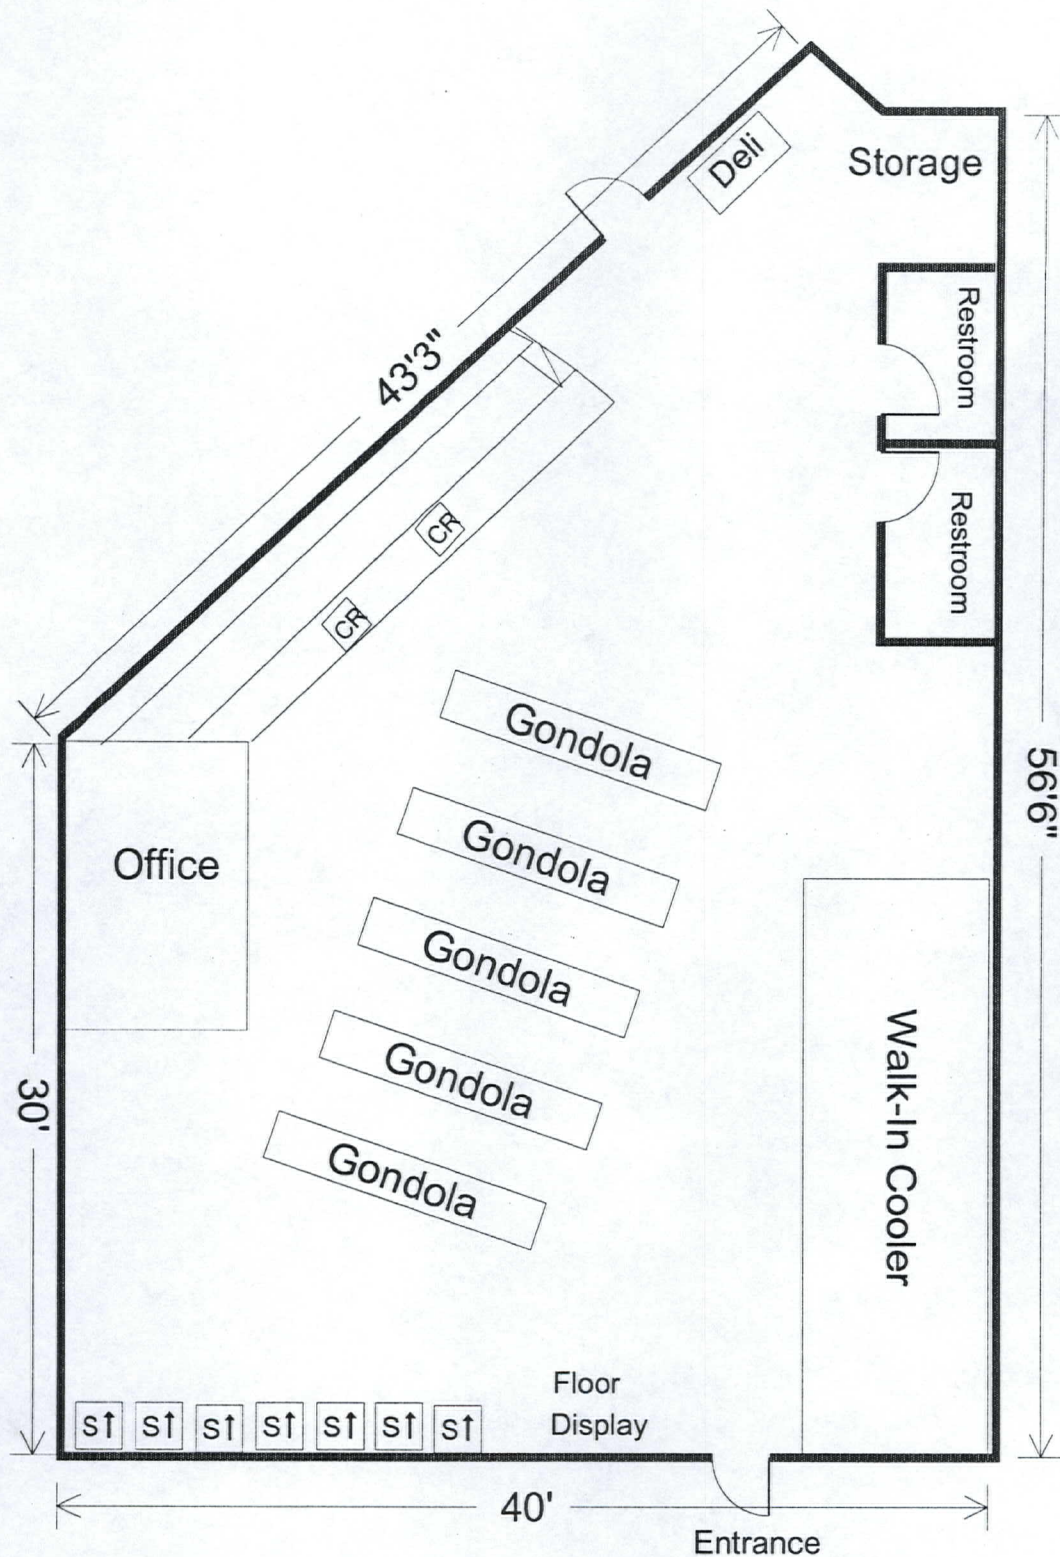

House of Vino
7181 N. Hualapai, Suite 100
Las Vegas, NV 89147

Proposed - Not yet built out

Total Sq. Ft: 1,925
48 Sq. ft of Walk-in Cooler
dedicated to Beer & Wine

125 Sq. ft of Liquor on shelves
behind counter/registers

Total Sq.Ft for Beer/Wine/Liquor: 173

RECEIVED

SUP-34765
07/23/09 PC

JUN 05 2009