

**Before Photos – Peter Pan Motel
(110 North 13th Street)**




**Before Photos – Peter Pan Motel
(110 North 13th Street)**



**Before Photos – Peter Pan Motel
(110 North 13th Street)**



After Rendering – Peter Pan Motel (110 North 13th Street)

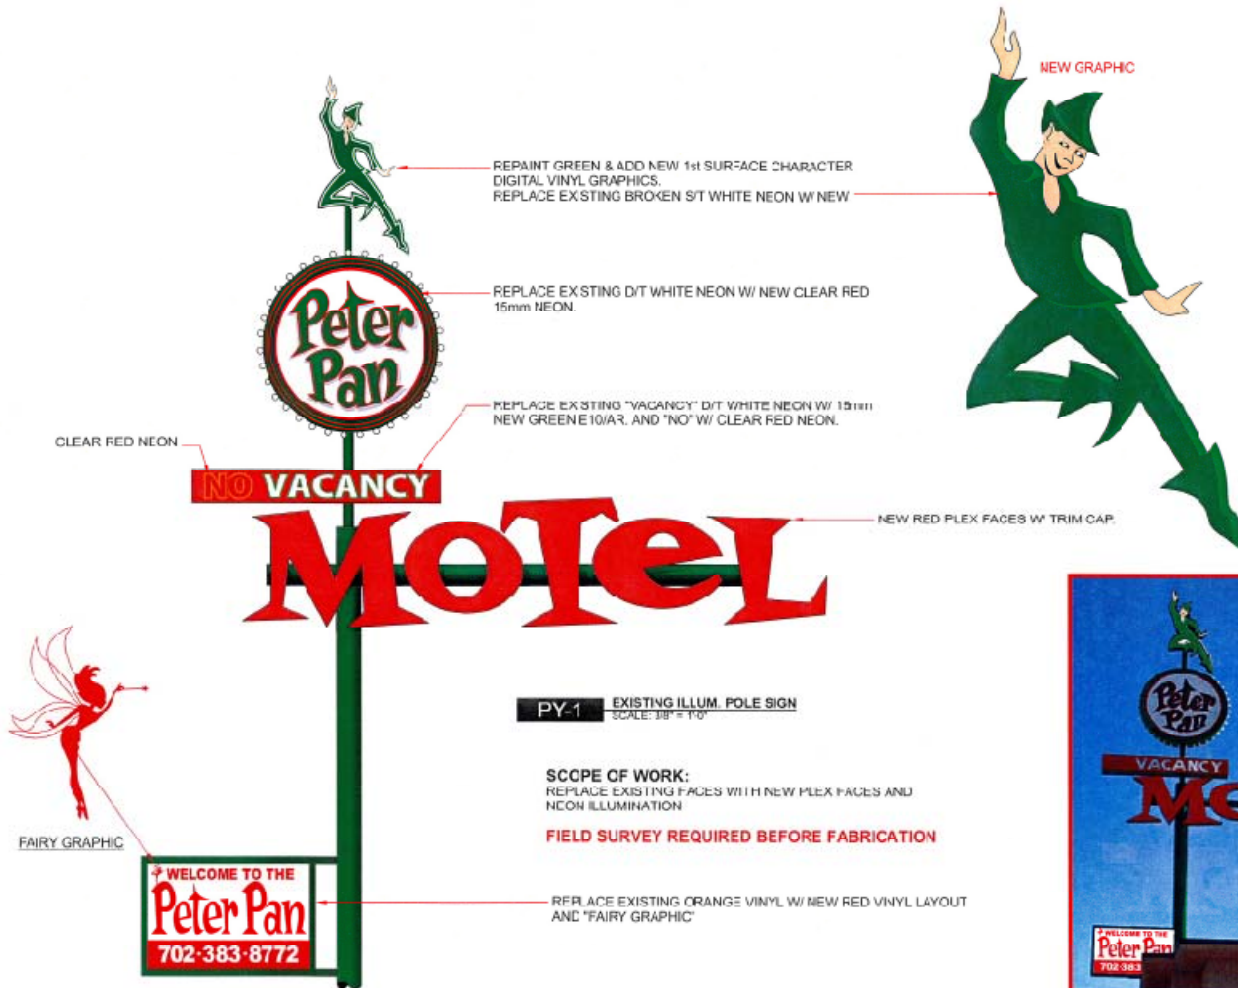

BY ADDING FAIRY GRAPHIC AND CHANGED NEON COLORS

PY-1 EXISTING ILLUM. POLE SIGN
SCALE: 3/8" = 1'-0"

SCOPE OF WORK:

REPLACE EXSTING FACES WITH NEW PLEX FACES AND
NEON ILLUMINATION

FIELD SURVEY REQUIRED BEFORE FABRICATION



EXISTING POLE SIGN N.T.S.



PROPOSED POLE SIGN N.T.S.