




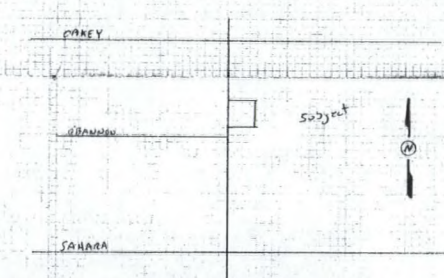

## STATEMENT OF FINANCIAL INTEREST

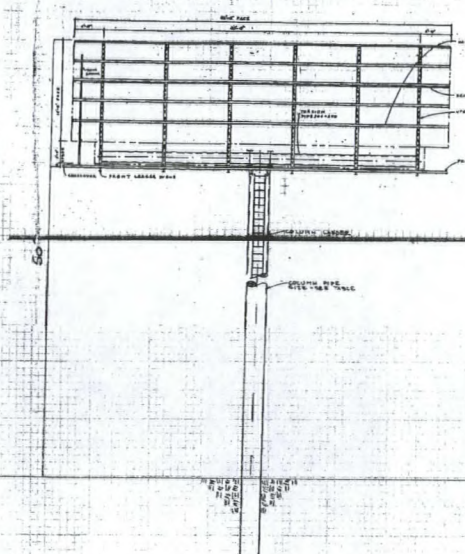

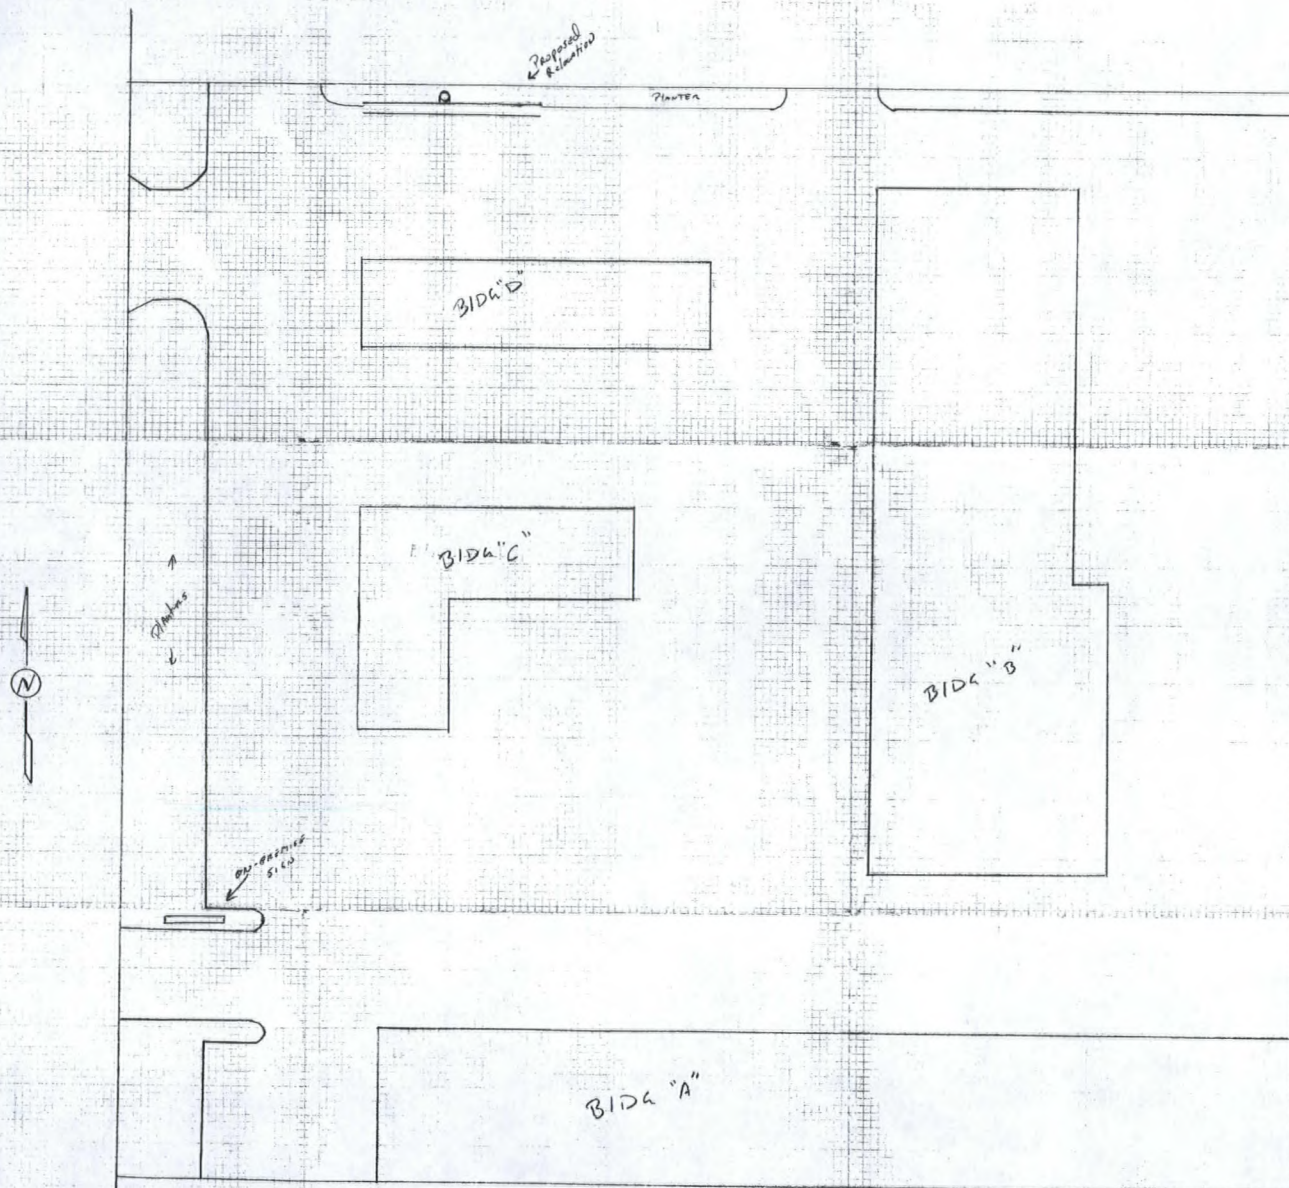

|                                                        |                                      |
|--------------------------------------------------------|--------------------------------------|
| <b>ch DONREY ch</b>                                    |                                      |
| SCALE 1" = 1'                                          | DRAWING NUMBER 1                     |
| DATE 12-9-90                                           | 1401 So. Decatur<br>Denton, TX 76205 |
| 1211 West Bonanza Road Denton, TX 76205 Phone 382-5020 |                                      |

**RQR-32951**  
**04/23/09 PC**

**FEB 20 2009**