

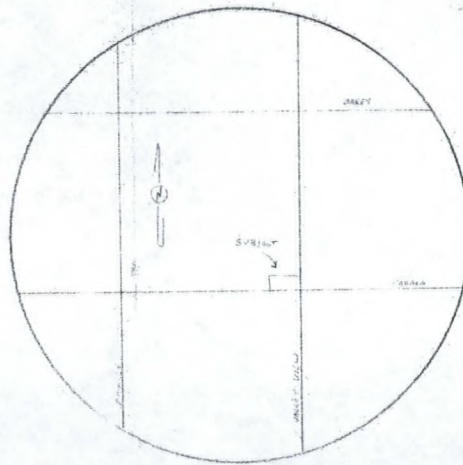


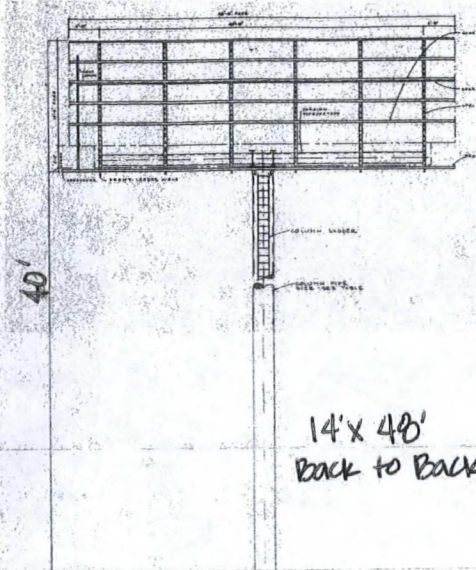

VALLEY VIEW

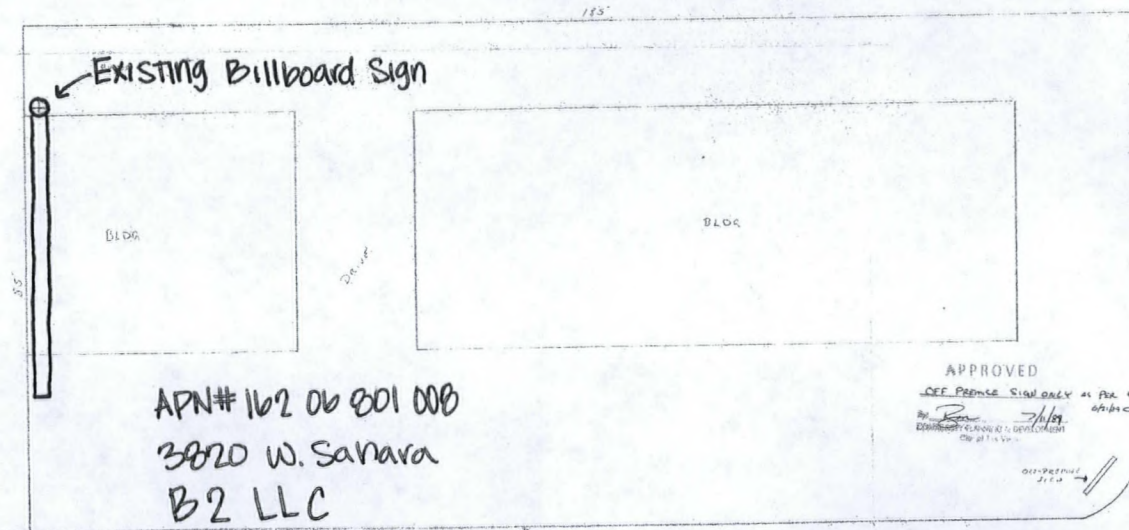

SAHARA AVE

RQR-33797

05/28/09 PC

donREY

SCALE 1" = 10'

DATE 2-6-18

DRAWING NUMBER 1

Joseph Salome

1311 West Bonanza Road Drawn By Michael Petran Phone 382-5030