

Steve Jones

From: Steve Jones
Sent: Thursday, May 03, 2012 4:04 PM
To: Abigail Mayrena (AMayrena@regionalflood.org)
Cc: okwon@lasvegasnevada.gov; Todd Steadham (tsteadham@shg-inc.com)
Subject: RE: Kyle Canyon exhibits
Attachments: Exhibit J - Regional Facilities Map.pdf

Abi,

Facility U4 is intended to be constructed in the ultimate condition when Sheep Mountain Parkway is improved. Prior to Sheep Mountain Parkway improvements, the discharge from the regional detention basin Facility P01W (Facility P04W) is maintained in the existing southern arroyo and conveyed thru the Kyle Canyon site to the Hualapai Way alignment where it is conveyed north. Therefore, rather than revising the regional alignment after Sheep Mountain Parkway is complete and proposing a new developer financed (Category B) regional facility, Facility U4 has been changed to a future local facility and the regional alignment has been changed to match the proposed drainage condition presented in the CLV conditionally approved drainage study. Per the March 22, 2012 meeting with you and Andrew, this was determined an acceptable regional alignment to replace U4.

The attached Exhibit J and its summary table of West Regional Facilities has been updated accordingly. Note the only flow identified in the updated summary table that has not been updated is for Facility P22W; however, the flow reported and utilized for conceptual sizing of this facility included outflow from Detention Basin P01W which is considered conservative. Therefore, the reported flow and conceptual size for P22W is considered acceptable and the flow returns to as reported in the summary table at the next downstream facility (north of the intersection of Hualapai and Iron Mountain).

Let me know if you have any questions, comments or concerns. Thanks,

Steve Jones, P.E.
Assistant Project Manager

SLATER HANIFAN GROUP

"The Benchmark of Our Profession."

LAS VEGAS

5740 S. ARVILLE STREET #216
LAS VEGAS, NEVADA 89118
PHONE: (702) 284-5300
FAX: (702) 284-5399
www.shg-inc.com

PHOENIX

11801 N. TATUM BLVD. #124
PHOENIX, ARIZONA 85028
PHONE: (602) 687-9664
FAX: (602) 687-9693

Any files contained within are to be used for information ONLY. Accuracy and/or design information to be verified from approved original plans. Use of electronic media is at the sole risk of the user.

From: Abigail Mayrena [<mailto:AMayrena@regionalflood.org>]
Sent: Monday, April 30, 2012 10:09 AM
To: Steve Jones
Cc: Oh Sang Kwon, P.E. (okwon@lasvegasnevada.gov)
Subject: Kyle Canyon exhibits

As discussed last week, can you revise U4 to be a Category B facility. I'll need the revised exhibits before I can process your concurrence letter. Can you also send the revised exhibits to CLV.

Thanks,

Abigail Mayrena, P.E., CFM
Senior Engineer

Clark County Regional Flood Control District
600 South Grand Central Pkwy, Suite 300
Las Vegas, Nevada 89106

AMayrena@regionalflood.org


702-685-0000 (phone)

702-685-0001 (fax)

www.regionalflood.org




Please consider the environment before printing this e-mail.

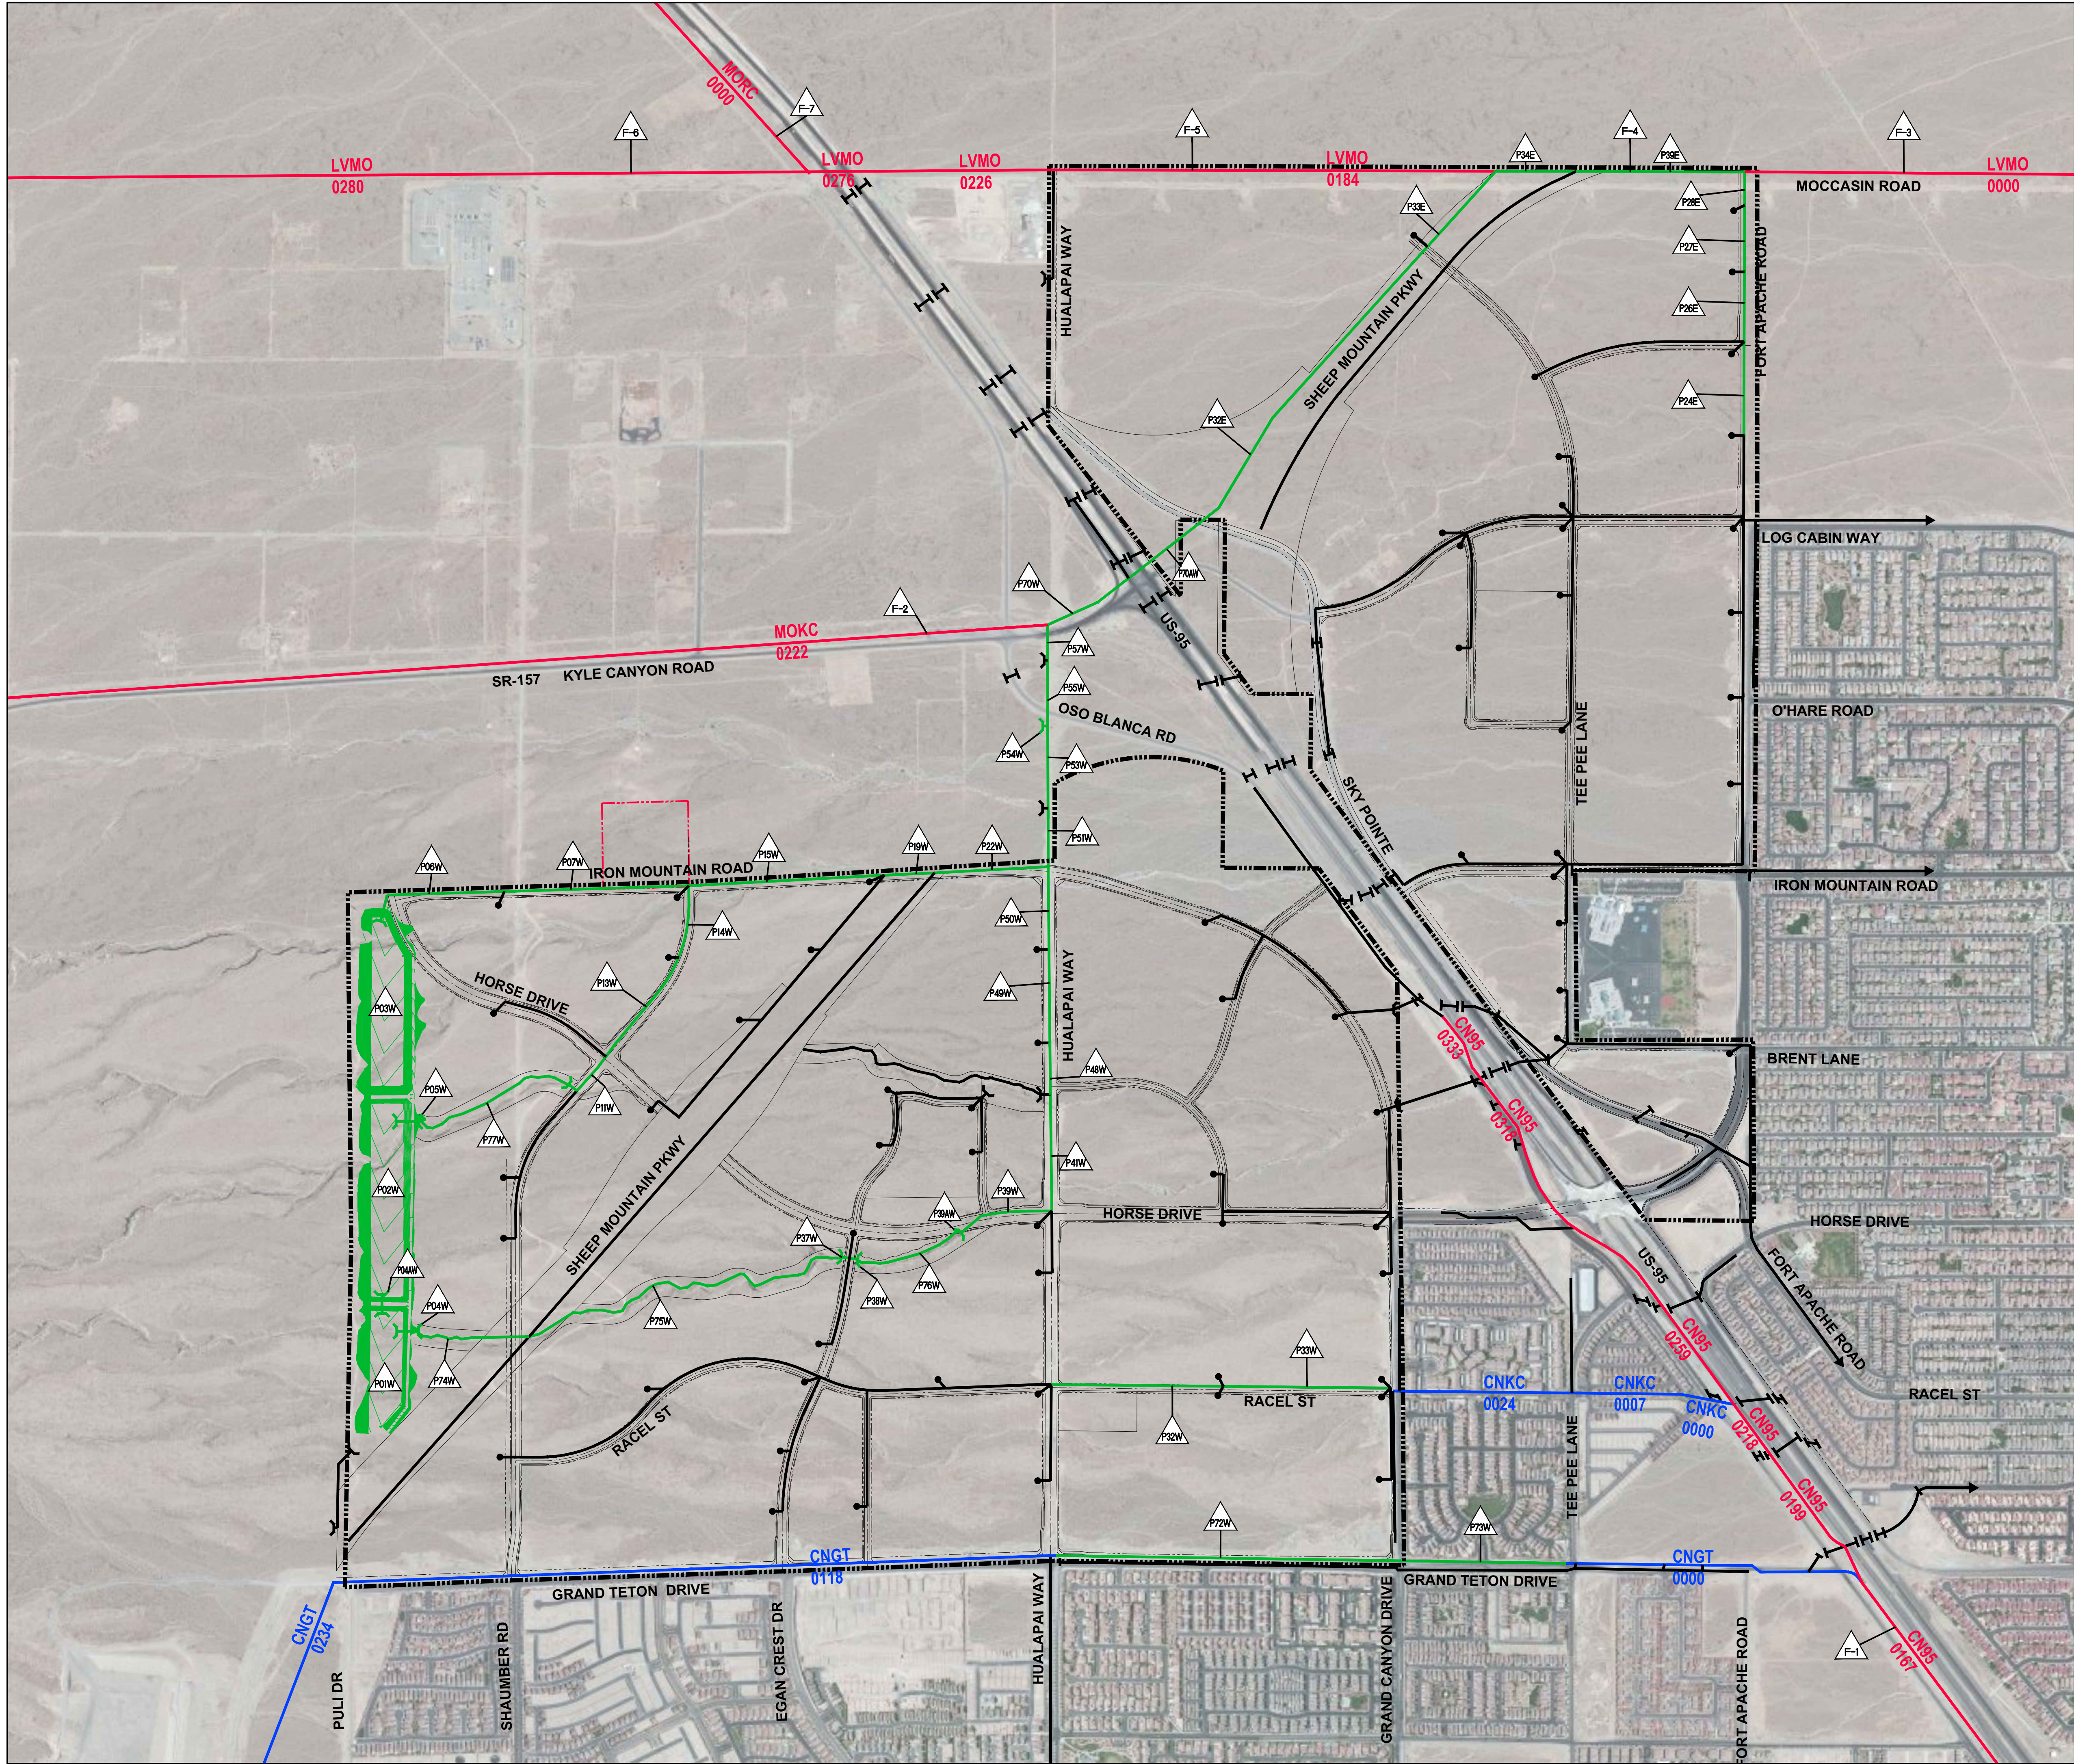

Summary of Regional Facilities Kyle Canyon West				
Facility ID	Q ₁₀₀ (cfs)	Design Slope (%)	Length (ft)	Description
P01W	777	N/A	N/A	Orifice Size: (2) 30-inch (into P74W & P02W) Total Storage Volume: 54.41 acre-ft Debris Volume: 4.41 acre-ft 100-year Storage Volume: 50 acre-ft 100-year Water Surface Elevation: 3040.70-ft PMF Flow: 3.145 cfs PMF Spillway Length: 200'-4 @ 3'-4 depth 18-inch RCP Low Flow Pipe at Bottom
P02W	363	N/A	N/A	Orifice Size: 27-inch (into P77W) Total Storage Volume: 38.44 acre-ft Debris Volume: 1.44 acre-ft 100-year Storage Volume: 30.00 acre-ft 100-year Water Surface Elevation: 3030.85-ft PMF Flow: 3.145 cfs PMF Spillway Length: 200'-4 @ 3'-4 depth 18-inch RCP Low Flow Pipe at Bottom
P03W	549	N/A	N/A	Orifice Size: 30-inch (into P06W) Total Storage Volume: 60.17 acre-ft Debris Volume: 4.17 acre-ft 100-year Storage Volume: 55 acre-ft 100-year Water Surface Elevation: 3011.28-ft PMF Flow: 3.310 cfs PMF Spillway Length: 215'-4 @ 3'-4 depth 18-inch RCP Low Flow Pipe at Bottom
P04W	68	5.2	100	30-inch RCP
P04W	80	1.0	100	30-inch RCP
P05W	49	3.0	100	27-inch RCP
P06W	76	3.6	901	30-inch RCP
P07W	100	3.6	1419	42-inch RCP
P11W	147	1.7	345	48-inch RCP
P13W	198	3.5	950	48-inch RCP
P14W	232	3.5	561	54-inch RCP
P15W	338	3.6	1558	60-inch RCP
P19W	489	3.6	386	5'-4 wide by 5'-4 high RCB
P22W	631	3.6	877	6'-4 wide by 5'-4 high RCB
P32W	532	3.6	1323	56-inch RCP
P33W	602	3.6	1287	72-inch RCP
P37W	204	N/A	63	60-inch RCP Inlet
P38W	267	3.0	64	60-inch RCP
P39W	277	N/A	60	72-inch RCP Inlet
P39W	277	3.0	700	60-inch RCP
P41W	317	0.5	895	7'-4 wide by 5'-4 high RCB
P48W	531	0.5	397	10'-4 wide by 5'-4 high RCB
P49W	578	0.5	719	10'-4 wide by 5'-4 high RCB
P50W	630	0.5	637	10'-4 wide by 5'-4 high RCB
P51W	1128	0.5	373	10'-4 wide by 5'-4 high RCB
P53W	1160	0.5	755	10'-4 wide by 5'-4 high RCB
P54W	1310	N/A	70	10'-4 wide by 5'-4 high RCBs
P55W	1620	0.5	461	14'-4 wide by 5'-4 high RCB
P57W	1578	0.5	327	14'-4 wide by 5'-4 high RCB
P70W	3324	3.0	707	14'-4 wide by 8'-4 high RCB, Crossing of US-95, Designed for Larger Ultimate Condition Flow
P70A	3477	3.0	879	14'-4 wide by 8'-4 high RCB, Crossing of US-95, Designed for Larger Ultimate Condition Flow
P72W	584	N/A	2670	8'-4 wide by 5'-4 high RCB
P73W	707	N/A	1253	10'-4 wide by 5'-4 high RCB
P74W	79	N/A	520	Existing Arroyo
P75W	204	N/A	2352	Existing Arroyo
P76W	277	N/A	846	Existing Arroyo
P77W	77	N/A	1334	Existing Arroyo
F-2	2708	N/A	N/A	Future Offsite Regional Facility (By Others)

Summary of Regional Facilities Kyle Canyon East				
Facility ID	Q ₁₀₀ (cfs)	Design Slope (%)	Length (ft)	Description
P24E	507	0.5	721	8'-4 wide by 5'-4 high RCB
P28E	641	0.5	537	9'-4 wide by 5'-4 high RCB
P27E	703	0.5	513	10'-4 wide by 5'-4 high RCB
P28E	760	0.5	400	10'-4 wide by 5'-4 high RCB
P32E	3553	2.4	2585	14'-4 wide by 8'-4 high RCB
P33E	3687	2.4	783	14'-4 wide by 8'-4 high RCB, Designed to convey larger Ultimate Condition Flow
P34E	3787	2.9	619	14'-4 wide by 8'-4 high RCB, to be replaced by Facility F-4
P39E	3880	2.6	1298	14'-4 wide by 8'-4 high RCB, to be replaced by Facility F-4
F-3	10872	N/A	N/A	Future Offsite Regional Facility (By Others)
F-4	10869	N/A	N/A	Future Onsite Regional Facility (By Others), Replaces Facilities P34E & P39E
F-5	10298	N/A	N/A	Future Onsite Regional Facility (By Others), Replaces Facility P31E
F-6	N/A	N/A	N/A	Future Offsite Regional Facility (By Others)
F-7	N/A	N/A	N/A	Future Offsite Regional Facility (By Others)

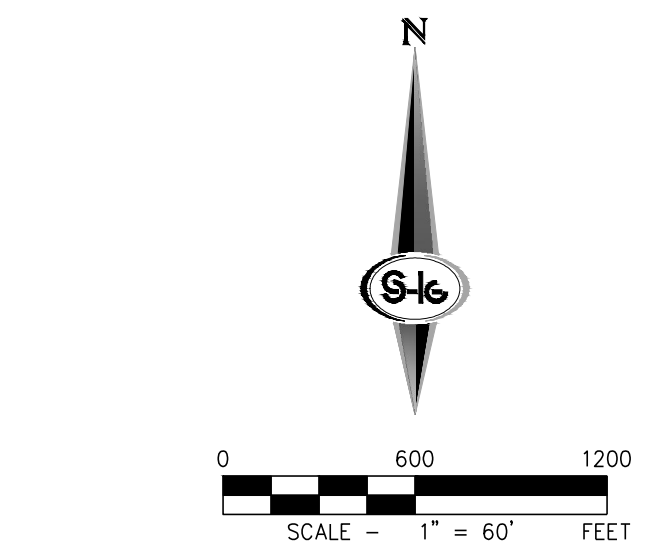

LEGEND	
	PROJECT BOUNDARY
	EXISTING CCRFCD FACILITY
	PROPOSED CATEGORY 'A' CCRFCD FACILITY
	PROPOSED CATEGORY 'B' CCRFCD FACILITY
	LOCAL/PRIVATE FACILITY
	2008 CCRFCD MPU ID TAG
	FACILITY SUMMARY ID

NOTES:

- ALL FACILITIES IDENTIFIED AS CATEGORY 'B' ARE TO BE CONSTRUCTED BY THE KYLE CANYON MASTER PLAN.
- STORM DRAIN CROSSING AT U.S. HIGHWAY 95 IS TO BE CONSTRUCTED BY KYLE CANYON MASTER PLAN, AND IS PLANNED TO BE THE PERMANENT FACILITY IN THE REGIONAL ALIGNMENT.
- ADDITIONAL CCRFCD MPU FACILITIES IDENTIFIED ON THE EXHIBIT AS CATEGORY 'B' HAVE NOT BEEN IDENTIFIED WITH 2008 MPU ID TAGS SINCE THEY ARE CONSIDERED ADDED MPU FACILITIES TO BE INCORPORATED IN A FUTURE MPA.
- FLOW COLLECTED BY THE CN95 MPU REGIONAL FACILITY IS CONVEYED SOUTH WITH NO FLOW SPLIT TO THE EAST.
- PER 2008 MPU, FUTURE CCRFCD FACILITIES IN THE KYLE CANYON ROAD AND MOCCASIN ROAD ALIGNMENTS ARE TO TIE INTO PROPOSED FACILITIES IN SHEEP MOUNTAIN PARKWAY & MOCCASIN.

EXHIBIT J

KYLE CANYON MASTER DRAINAGE STUDY (RFCDD SUPP)
CCRFCDD REGIONAL FACILITIES MAP

WCR0902.004

SLATER HANIFAN GROUP
CONSULTING ENGINEERS & PLANNERS
5740 S. ARVILLE STREET #216, LAS VEGAS, NV 89118
PHONE (702) 284-5300 FAX (702) 284-5399

