


CITY OWNED WATER WELLS

WELL NO.	STATE APPLICATION NO.	LOCATION
31	10183	"Stock's Gravel"
100	9601	Old Dog Pound
101	9602	Squires Park
102	9614	Cemetery
103	11111	
106	9939	Squires Park
109	9940	Fish Hatchery
110	8173	
115	10182	Golf Course

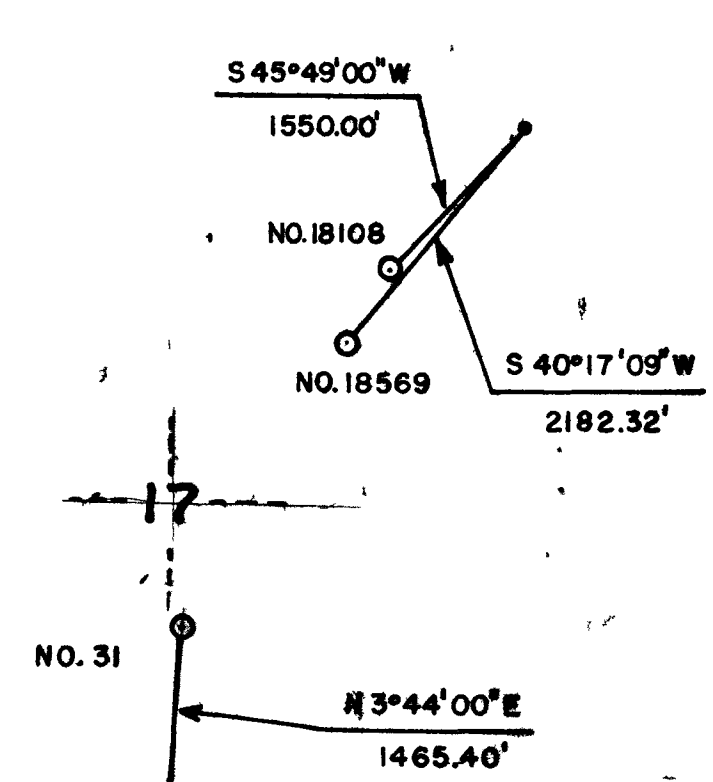

1500 900 600 300 0

1960

CITY OF


DRAWN BY

CHECKED BY

9733

722-1

SHT. 2

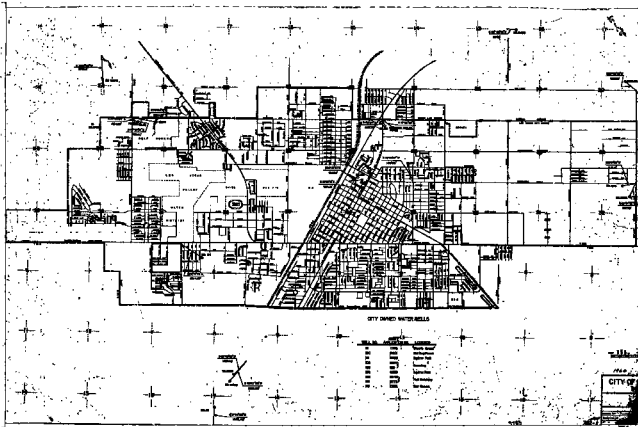

CITY OWNED WATER WELLS

1940
CITY OF