
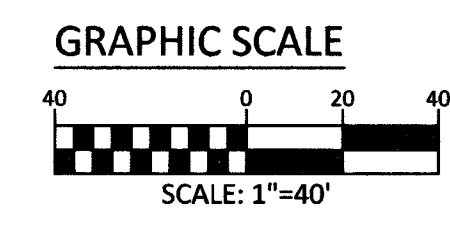


DROP INLET NOTE
 WHERE 10 FEET PARALLEL SEPARATION IS NOT PRACTICABLE:
 CAST-IN-PLACE MONOLITHIC POUR WITH WATERSTOP BETWEEN SLAB AND WALLS. BASE, WALLS AND TOP TO BE CONSTRUCTED WITH WATERSTOPS, CENTER BULB, OR FLAT STRIP (VINYL, GREENSTREAK PLASTIC PRODUCTS OR APPROVED EQUAL).

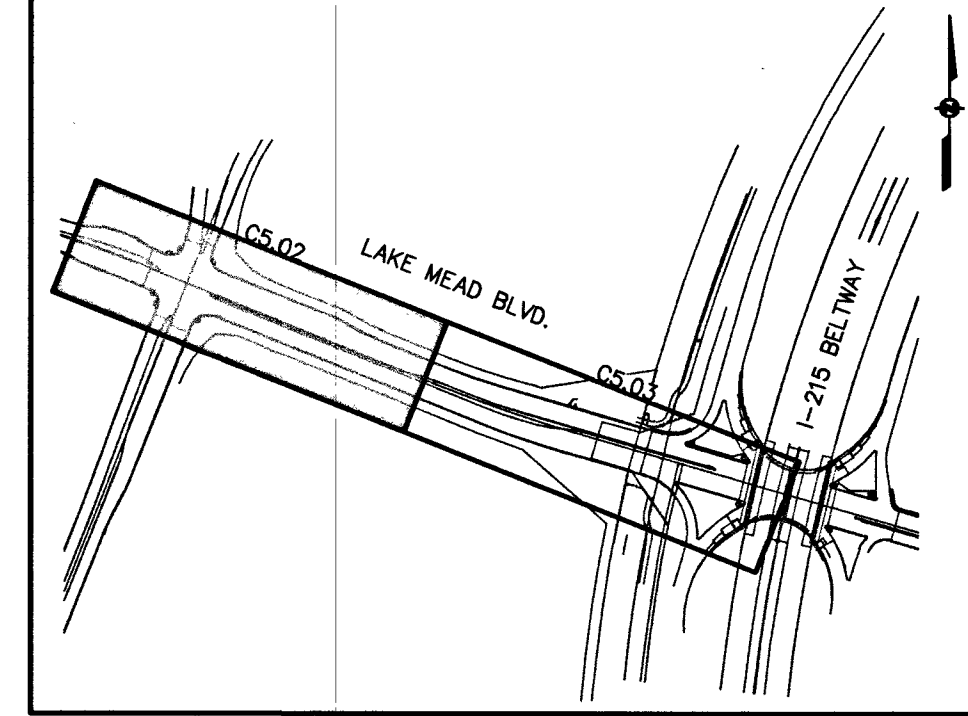

LVVWD STATIONING
 REFERENCE PROFILE ON THIS SHEET FOR ALL EX. LVVWD FACILITY STATIONING.

BASIS OF BEARING
 NORTH 89°45'05" EAST BEING THE SOUTH LINE OF THE SOUTHWEST QUARTER (SW 1/4) OF SECTION 35, TOWNSHIP 20 SOUTH, RANGE 59 EAST, M.D.M., AS SHOWN BY MAP ON FILE IN FILE 91, PAGE 28 OF PARCEL MAPS IN THE CLARK COUNTY RECORDER'S OFFICE, CLARK COUNTY, NEVADA

BENCHMARK
 U.S.C&G'S BRASS DISC SET IN ROCK ON THE EAST SIDE OF CHARLESTON BOULEVARD AND SOUTH OF THE RED ROCK DETENTION BASIN.
 CLV BM NO.: 0368 3
 ELEVATION: 989.599 METERS (NAV88)
 3426.71 FEET
 TO OBTAIN SUMMERLIN VILLAGE 26 - REVERSE PROJECT MODIFIED DATUM ADD 0.42 FEET TO NAV88 DATUM.

CONSTRUCTION NOTES:

- NO. ITEM: USDOCA: UNIFORM STANDARD DRAWINGS CLARK COUNTY AREA
1. INSTALL "A" TYPE ISLAND CURB PER USDOCA DWG NO. 219.
2. INSTALL "L" TYPE CURB & GUTTER PER USDOCA DWG NO. 216.
3. INSTALL A.C. PAVEMENT PER TYPICAL STREET DESIGN DETAILS.
4. INSTALL HANDICAP RAMP CURB DEPRESSION (BY OTHERS).
5. VERIFY LOCATION AND ELEVATION OF EXISTING IMPROVEMENT. IF DISCREPANCY EXISTS, NOTIFY ENGINEER PRIOR TO CONSTRUCTION.
6. SAWCUT AND REPLACE EXISTING A.C. PAVEMENT.
7. CONSTRUCT CURB OPENING PER DETAIL '5' SHEET C8.01.
8. CONSTRUCT 0" TALL TYPE 'A' CURB PER DETAIL '7' SHEET C8.01.
9. CONSTRUCT CURB TRANSITION FROM 6" TALL CURB TO 0" TALL CURB PER DETAIL '6' SHEET C8.01.
10. TEMPORARY PORTABLE CONCRETE JERSEY BARRIER PER NDOT STD. DWG. NO. R-8.7.1.1.

SEWER CONSTRUCTION NOTES:

- NO. ITEM: DCSWCS DESIGN AND CONSTRUCTION STANDARDS FOR WASTEWATER COLLECTION SYSTEMS
1. INSTALL 72" DIA. SEWER MANHOLE W/CORROSION PROTECTION & DUAL CONCENTRIC LIDS DCSWCS-2.
2. INSTALL TEMPORARY PLUG AND CAP.
3. REMOVE PLUG & CONNECT TO EX. SEWER LINE (CONTRACTOR TO VERIFY SIZE, INVERT, AND LOCATION OF EXISTING SEWER LINE) PRIOR TO CONSTRUCTION.
4. INSTALL 60" SEWER MANHOLE W/CORROSION PROTECTION.

STORM DRAIN CONSTRUCTION NOTES:

- NO. ITEM: UDACS: PLATE NO. PER UNIFORM DESIGN AND CONSTRUCTION STANDARD FOR WATER DISTRIBUTION SYSTEMS.
 1. INSTALL TYPE I STORM DRAIN MANHOLE.
 2. INSTALL TYPE II STORM DRAIN MANHOLE.
 3. INSTALL TYPE IV STORM DRAIN MANHOLE, SEE DETAIL 4 SHEET C8.01.
 4. INSTALL TEMPORARY PLUG AND CAP.
 5. INSTALL MODIFIED TYPE "CM" DROP INLET PER USDOCA DWG. NO. 422. ADD STORMWATER INLET CONCRETE STAMP PER USDOCA DWG. NO. 421.
 6. INSTALL JUNCTION STRUCTURE.
 7. CONNECT TO EXISTING STORM DRAIN LINE (CONTRACTOR TO VERIFY SIZE, INVERT, AND LOCATION OF EXISTING STORM DRAIN LINE).
- CONTRACTOR TO VERIFY SIZE, INVERT, AND LOCATION OF EXISTING STORM DRAIN LINE

FOR TRENCHES SIX (6) FEET WIDE AND GREATER:

IF THE PIPE MATERIAL IS A CP, THE EXPOSED PIPE MUST BE REPLACED WITH DUCTILE IRON PIPE.
 CONTRACTOR MUST SUBMIT PIPE SUPPORT DETAIL PREPARED BY A NEVADA LICENSED ENGINEER, TO LVVWD ENGINEERING SERVICES BEFORE CONSTRUCTION TO SHOW HOW WATERLINE(S) WILL BE SUPPORTED DURING EXCAVATION AND BACKFILL.
 SUPPORTED PIPE MAY BE EXPOSED FOR NO LONGER THAN 90 DAYS MAXIMUM. IF THE PIPE WILL BE EXPOSED FOR MORE THAN 90 DAYS, PLANS MUST BE SUBMITTED AND APPROVED BY THE LVVWD TO RELOCATE PIPE.


FOR ALL DRY UTILITY CROSSINGS

- MAINTAIN MINIMUM 12" VERTICAL SEPARATION AT ALL POINTS OF CROSSING
- MAINTAIN MINIMUM 3' PARALLEL SEPARATION
- ANY EXCAVATION AT BACK OF CURB MUST REMAIN OPEN FOR INSPECTION OF COPPER SERVICE LATERALS. ANY COPPER SERVICE LATERAL KINKED, BENT OR OTHERWISE DAMAGED MUST BE REPLACED FROM THE MAIN TO THE ANGLE METER STOP.

PROTECT IN PLACE AND ADJUST LVVWD EXISTING FACILITIES TO FINISHED GRADE. ALL LVVWD FACILITIES SHALL BE ACCESSIBLE AT ALL TIMES.

ESN: 078 01/05/15

APPROVED FOR CONSTRUCTION
 LAS VEGAS VALLEY WATER DISTRICT ENGINEERING SERVICES MANAGER
 DATE: 6/11/17 PROJECT NO.: 124803

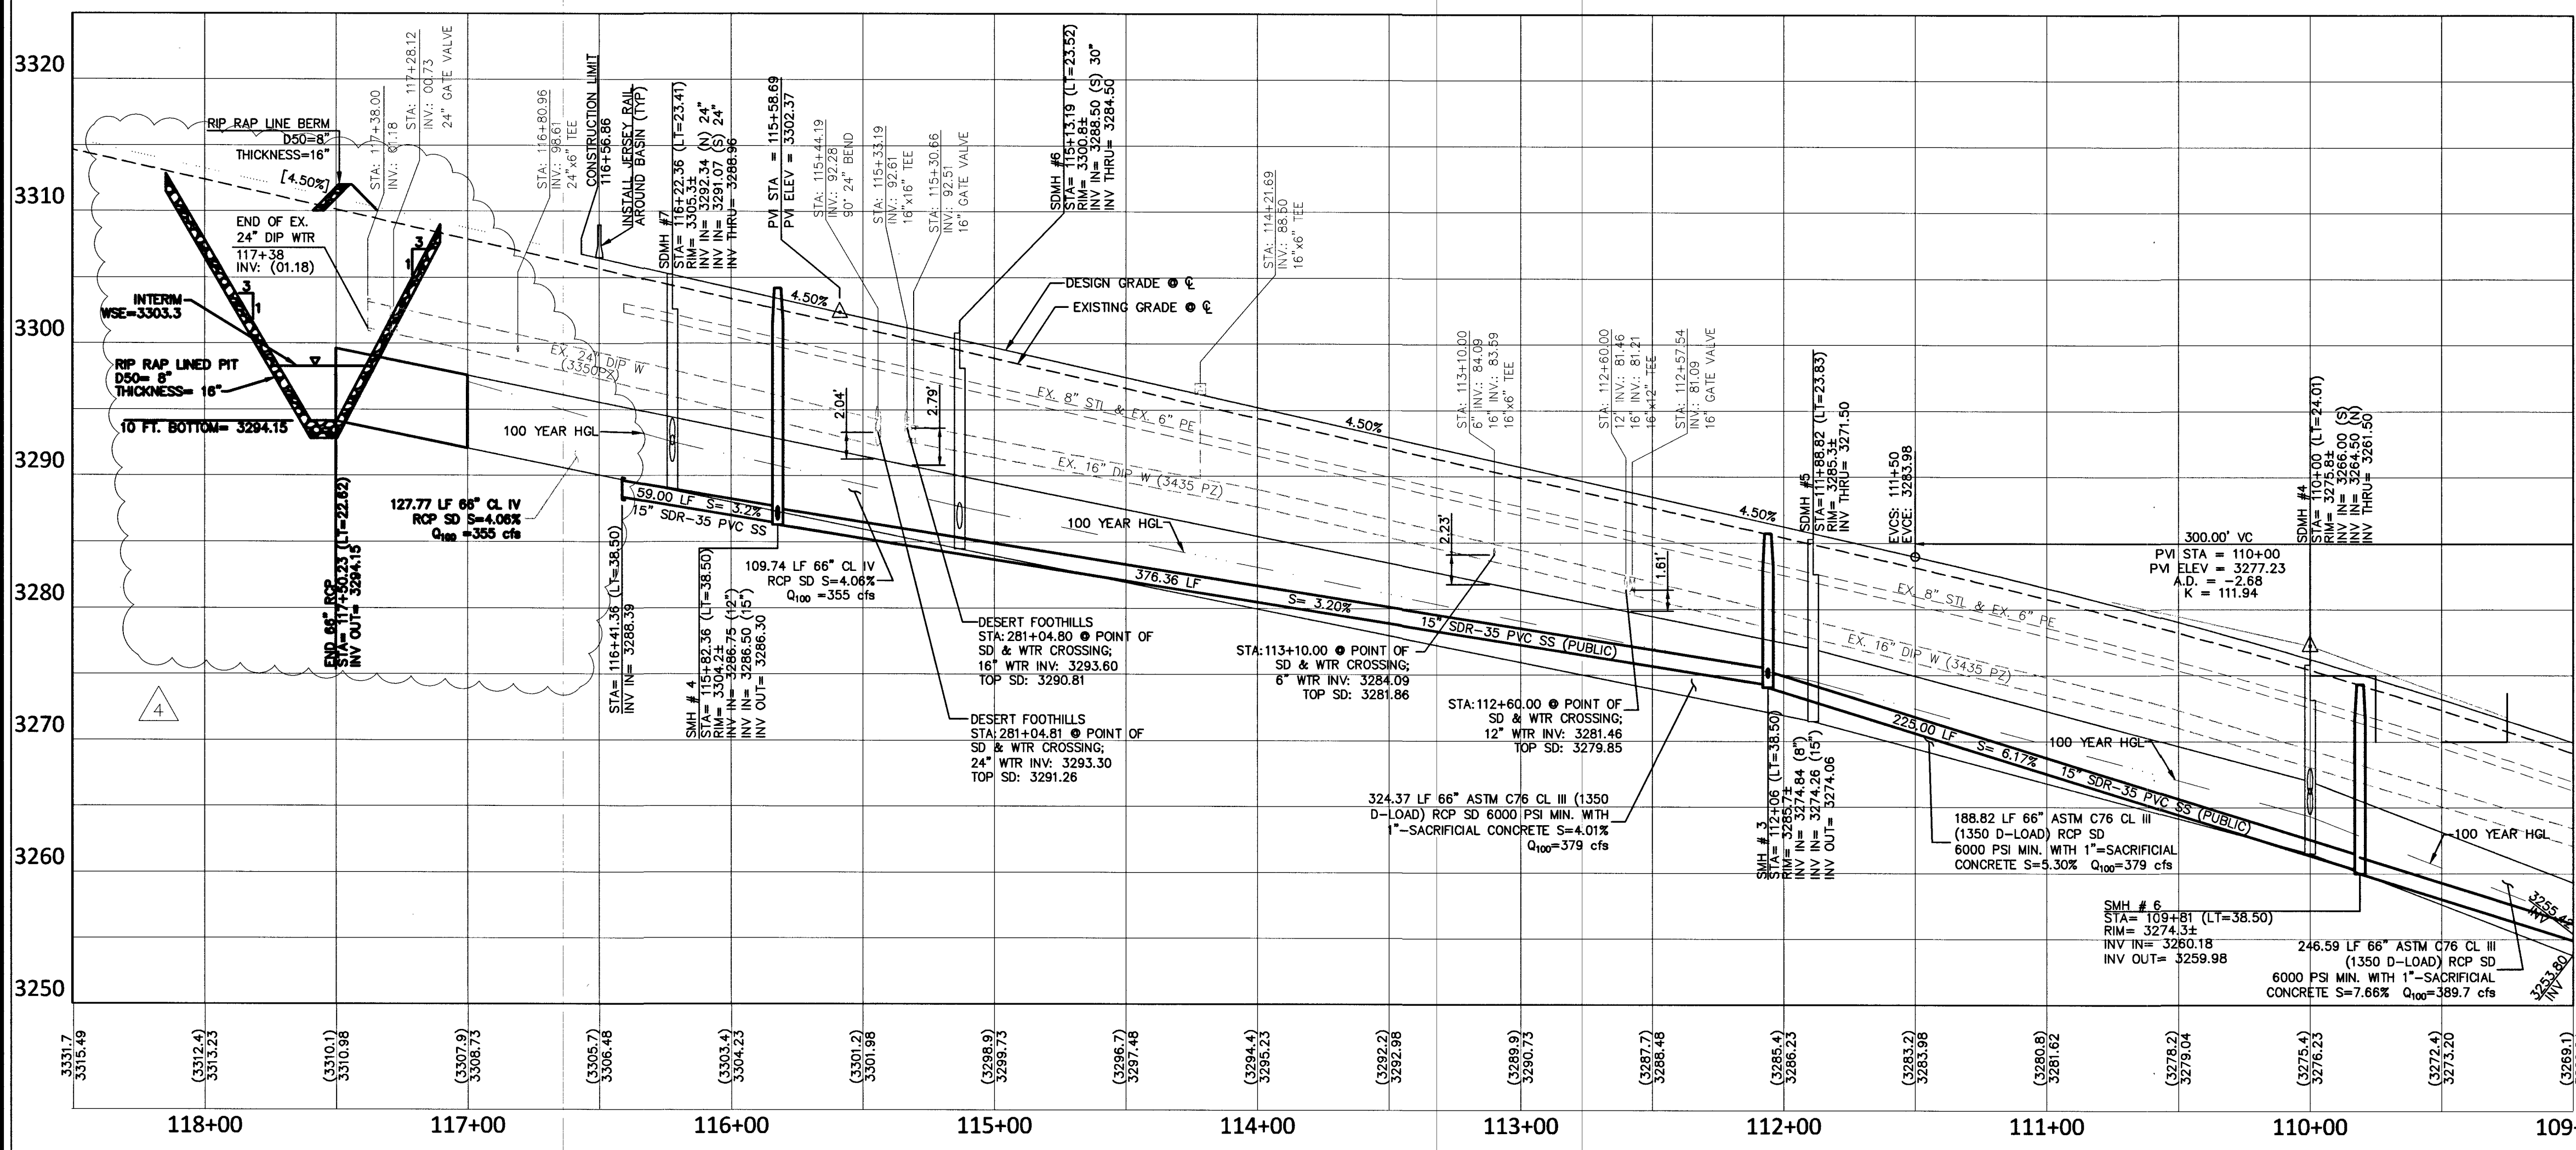

LAKE MEAD BLVD - PROFILE

H: 1"=40'
 V: 1"=8'

CALL BEFORE YOU DIG
 AVOID CUTTING UNDERGROUND UTILITY LINES. IT'S COSTLY!

CALL BEFORE YOU DO UNDERGROUND WORK
 CALL 1-702-455-7511
 CALL 1-702-432-5300

AVOID HITTING OVERHEAD POWER LINES. IT'S COSTLY.
 CALL BEFORE YOU DO OVERHEAD WORK
 CALL 1-702-227-2929

COLLINS ENGINEERS ASSUMES NO RESPONSIBILITY FOR EXISTING UTILITY LOCATIONS AND ELEVATIONS. THE UTILITIES SHOWN ON THIS DRAWING HAVE BEEN PLOTTED FROM THE BEST AVAILABLE INFORMATION. IT IS, HOWEVER, THE CONTRACTOR'S RESPONSIBILITY TO FIELD VERIFY THE LOCATION AND ELEVATION OF ALL UTILITIES PRIOR TO THE COMMENCEMENT OF ANY CONSTRUCTION. CONTRACTOR TO FIELD VERIFY ALL EXISTING SITE CONDITIONS PRIOR TO CONSTRUCTION. IF A CONFLICT EXISTS BETWEEN WHAT IS SHOWN ON THESE DRAWINGS AND WHAT EXISTS IN THE FIELD, THE CONTRACTOR IS TO NOTIFY THE ARCHITECT OR ENGINEER IMMEDIATELY.

LEGEND

EXISTING PROPOSED	EXISTING PROPOSED	EXISTING PROPOSED	EXISTING PROPOSED	EXISTING PROPOSED	EXISTING PROPOSED
PL-RIGHT-OF-WAY	PL-ADJACENT CENTERLINE	EASEMENT LINE	FLOW LINE	SIGN W/POLE	SAWOUT LINE
FIRE HYDRANT CONNECTION	WATER VALVE	REDUCER	SEWER MANHOLE	CLEANOUT	GAS VALVE
PL-RIGHT-OF-WAY	PL-ADJACENT CENTERLINE	EASEMENT LINE	SIGN W/POLE	SAWOUT LINE	AREA LIGHT
FIRE HYDRANT CONNECTION	WATER VALVE	REDUCER	SEWER MANHOLE	CLEANOUT	GAS VALVE
PL-RIGHT-OF-WAY	PL-ADJACENT CENTERLINE	EASEMENT LINE	SIGN W/POLE	SAWOUT LINE	AREA LIGHT
FIRE HYDRANT CONNECTION	WATER VALVE	REDUCER	SEWER MANHOLE	CLEANOUT	GAS VALVE