


P:\2012\0003 Franklin Park\Construction\Asbuilt\UNIT 3 ASBUILT\Storm Drain Asbuilt\FRANKLIN PARK U3 SD ASBUILT.dwg rdoyle Mon, 10 Oct 2016 - 11:52am



PROVIDENCE POD 211 PH-2
PER BOOK 150, PAGE 6 OF PLATS

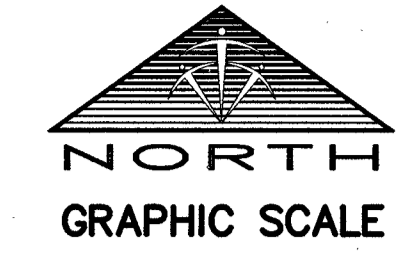

GRAPHIC SCALE
(IN FEET)
1 inch = 30 ft.

LEGEND

	SUBDIVISION BOUNDARY
	SECTION LINE
	RIGHT OF WAY
	EXISTING RIGHT OF WAY
	PROPERTY LINE
	CENTERLINE
	ASSESSORS PARCEL LINE
	STORM DRAIN PIPE
	EXISTING STORM DRAIN PIPE
	LOT NUMBER
	STORM DRAIN MANHOLE
	EXISTING STORM DRAIN MANHOLE
	STORM DRAIN JUNCTION BOX
	STORM DRAIN DROP INLET
	AS-BUILT POINT NUMBER

HORIZONTAL DATUM
HORIZONTAL DATUM SHOWN HEREON IS BASED UPON NORTH AMERICAN DATUM OF 1983 (NAD 83 (2011) EPOCH 2010.00 REALIZATION), NEVADA STATE PLANE COORDINATE SYSTEM EAST ZONE (2701).

BENCHMARK
CITY OF LAS VEGAS BENCHMARK: 6LV99 24NNW6
BEING A RIVET AND PLATE IN CONCRETE PAD (ELETRIC) 200' +/- SW OF PI OF ELKHORN ROAD AND SCHAMBER ROAD
ELEVATION: 3000.77 (U.S. SURVEY FEET)
914.637 (METERS)

BASED UPON NORTH AMERICAN VERTICAL DATUM OF 1988 (NAVD '88), CITY OF LAS VEGAS 2008 ADJUSTMENT

- NOTES**
- THE PURPOSE OF THIS SURVEY IS TO PROVIDE AS-BUILT INFORMATION FOR THE STORM DRAIN FACILITIES IN FRANKLIN PARK AT PROVIDENCE II - PHASE 3, AS SHOWN BY MAP THEREOF ON FILE IN THE CLARK COUNTY RECORDERS OFFICE IN BOOK 149, PAGE 17 OF PLATS, SITUATE IN THE SOUTHWEST QUARTER (SW 1/4) OF THE SOUTHWEST QUARTER (SW 1/4) OF SECTION 13, TOWNSHIP 19 SOUTH, RANGE 59 EAST, M.D.M., CITY OF LAS VEGAS, CLARK COUNTY, NEVADA, AND THE SURVEY WAS COMPLETED ON OCTOBER 7, 2016.
THE POSITIONAL CERTAINTY OF THE AS-BUILT INFORMATION SHOWN HEREON IS WITHIN +/- 0.3' HORIZONTALLY AND VERTICALLY.
 - UNABLE TO SURVEY OUTSIDE CORNERS OF STORM DRAIN JUNCTION BOX LOCATED AT POINT #23000 DUE TO STRUCTURE BEING BACKFILLED PRIOR TO SURVEY.
- TRI-CORE SURVEYING ASSUMES NO RESPONSIBILITY FOR EXISTING UTILITIES SHOWN OR NOT SHOWN. THE UTILITIES SHOWN ON THIS DRAWING HAVE BEEN PLOTTED FOR THE CONVENIENCE ONLY. IT IS THE CONTRACTOR'S RESPONSIBILITY TO FIELD VERIFY BOTH THE HORIZONTAL AND VERTICAL LOCATION OF ALL RELEVANT UTILITIES PRIOR TO COMMENCEMENT OF CONSTRUCTION. IF A CONFLICT OR DISCREPANCY IS DISCOVERED, THE CONTRACTOR SHALL NOTIFY TRI-CORE SURVEYING IN WRITING IMMEDIATELY.


POINT TABLE				
POINT #	NORTHING	EASTING	ELEVATION	DESCRIPTION
1611	26808050.72	730017.73	0.00	CP 1 - CURB SCRIBE 32/33
1613	26808157.01	729984.37	0.00	CP 3 - CURB SCRIBE 36/37
1679	26808091.33	730326.95	0.00	CP 2 - CURB SCRIBE 139/140
5000	26808067.84	729885.09	3036.98	TOP 42" RCP
5001	26808067.57	729911.45	3032.61	TOP 42" RCP
5004	26808067.06	730069.45	3025.42	INSIDE CORNER JUNCTION BOX
5005	26808067.20	730074.69	3025.42	INSIDE CORNER JUNCTION BOX
5006	26808071.85	730074.57	3025.42	INSIDE CORNER JUNCTION BOX
5007	26808071.71	730069.32	3025.42	INSIDE CORNER JUNCTION BOX
5008	26808067.57	729902.06	3029.28	42" RCP INV @ INSIDE FACE DI
23000	26808069.46	730072.01	3025.42	INVERT ELEVATION @ SDMH CL BARREL
23007	26808076.83	729903.50	3038.06	EDGE OF DI @ TOP OF CURB
23008	26808058.65	729903.85	3038.10	EDGE OF DI @ TOP OF CURB

CLV PROJECT H#56814
CLV DRAWING #107Y4898-3
FMP-56904

DATE:	10/10/2016	NO.	DESCRIPTION	DATE
DESIGNED BY:	GS	1"		
CHECKED BY:	RD	30"		
ADA CHECKED:		60"		
JOB NO.:	20712.0003	120"		
SCALE:	1"=30'			

TRI-CORE SURVEYING, LLC
LAND SURVEYING - CONSTRUCTION STAKING
BOUNDARY & TOPOGRAPHIC SURVEYS
6781 WEST CHARLESTON BLVD.
LAS VEGAS, NV 89118
TEL (702) 821-1554 FAX (702) 870-4378

TOLL BROTHERS
FRANKLIN PARK AT PROVIDENCE II - PHASE 3
STORM DRAIN FINAL MAP LOCATION

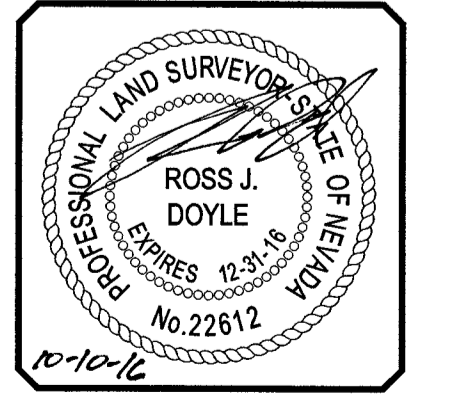

SHEET
1
OF 1

Memorandum

Department of Public Works
City Engineer Division
Survey Section
333 North Rancho Dr., 8th Floor
Las Vegas, Nevada 89106
Phone (702) 229-6217
Fax (702) 804-8582

To: Michael Cunningham, Manager
Building and Safety Department

From: Alan R. Riecki, PLS
City Surveyor

C: Ross J Doyle, PLS
Tri-Core Surveying
Oh-Sang Kwon, P.E., Engineering Project Manager
Flood Control Section

Date: October 27, 2016

Re: Storm Drain Final Location Map
FRANKLIN PARK AT PROVIDENCE II PHASE 3
(Drawing No. 107Y4898-3, L-Civil No. 56814)

The Survey Section has reviewed the Final Location Map and as far as our jurisdiction of this project is concerned, we find that the map is:

Acceptable: _____ October 27, 2016 _____



Signature

City Surveyor
Title

Public Works/Survey
Department/Division



City of Las Vegas
Department of Public Works
Survey Section

REVIEW CHECKLIST
STORM DRAIN
FINAL LOCATION MAP

JOB NUMBER H56814 SD2
PROJECT NAME FRANKLIN PARK AT PROVIDENCE II PHASE 3
WORK AUTH. NO. P28000
SUBMITTED BY Tri-Core Surveying
PROJECT TYPE CIP Land Dev Street Rehab
DATE 10/27/16
REVIEWED BY O. SANTANA

REVIEW DETERMINATION

- Approved
 Not Acceptable

TO BE RE-SUBMITTED

- Two bond copies (no mylar)
 Electronic media with comma-separated coordinate file

REVIEW ITEM	OK	SEE R/L	N/A	COMMENTS
Submittal Contents				
Two bond copies (no mylar)	<input checked="" type="checkbox"/>	<input type="checkbox"/>	<input type="checkbox"/>	
Electronic media containing comma-separated coordinate file	<input checked="" type="checkbox"/>	<input type="checkbox"/>	<input type="checkbox"/>	
General Map Contents				
Sheet size 24" x 36"	<input type="checkbox"/>	<input type="checkbox"/>	<input type="checkbox"/>	
Sheet number and number of sheets	<input type="checkbox"/>	<input type="checkbox"/>	<input type="checkbox"/>	
North arrow (pointing up, left or right)	<input type="checkbox"/>	<input type="checkbox"/>	<input type="checkbox"/>	
Scale (written & graphic, correctly shown, appropriate scale used)	<input type="checkbox"/>	<input type="checkbox"/>	<input type="checkbox"/>	
Lettering legibility (minimum text size 0.08")	<input type="checkbox"/>	<input type="checkbox"/>	<input type="checkbox"/>	
Map title shown ("Storm Drain Final Location Map")	<input type="checkbox"/>	<input type="checkbox"/>	<input type="checkbox"/>	
CLV project name shown	<input type="checkbox"/>	<input type="checkbox"/>	<input type="checkbox"/>	
CLV Hansen No. shown	<input type="checkbox"/>	<input type="checkbox"/>	<input type="checkbox"/>	
CLV Drawing No. shown	<input type="checkbox"/>	<input type="checkbox"/>	<input type="checkbox"/>	
Preparer's company name and contact information shown	<input type="checkbox"/>	<input type="checkbox"/>	<input type="checkbox"/>	
Legend (all linetypes and symbols defined)	<input type="checkbox"/>	<input type="checkbox"/>	<input type="checkbox"/>	
Non-standard abbreviations defined	<input type="checkbox"/>	<input type="checkbox"/>	<input type="checkbox"/>	
Distances, coordinates and elevations labeled using decimal feet	<input type="checkbox"/>	<input type="checkbox"/>	<input type="checkbox"/>	
Approximate limits of streets shown (improvements or right-of-way)	<input type="checkbox"/>	<input type="checkbox"/>	<input type="checkbox"/>	
Street names labeled (identified as public or private)	<input type="checkbox"/>	<input type="checkbox"/>	<input type="checkbox"/>	

REVIEW CHECKLIST – STORM DRAIN FINAL LOCATION MAP

REVIEW ITEM	OK	SEE R/L	N/A	COMMENTS
Storm Drain Improvements Data				
*NOTE As of December 1, 2015 manhole cover locations are no longer required.				
Manhole Barrel/Base: (measured horizontally at centerline of barrel/base structure, vertical location does not apply)	<input type="checkbox"/>	<input type="checkbox"/>	<input type="checkbox"/>	
Drop Inlets (measured horizontally at back of curb at each outer extent of box, vertically at top of curb)	<input type="checkbox"/>	<input type="checkbox"/>	<input type="checkbox"/>	
Vaults and Junction Structures (measured horizontally at all outer extents of structure, vertically at top of structure)	<input checked="" type="checkbox"/>	<input type="checkbox"/>	<input type="checkbox"/>	
Pipes and RCB's: locate at all connections to other pipes and structures, all horizontal and vertical deflections, points of termination (stubs), point at which pipe/RCB exits the public right-of-way or easement (measured horizontally at centerline of pipe/RCB, vertically at top of pipe/RCB)	<input checked="" type="checkbox"/>	<input type="checkbox"/>	<input type="checkbox"/>	
*NOTE All pipe connections to manholes and other structures should be located at outside face of structure before backfilling due to accuracy limitations of pipe measurements from the structure's surface access point.				
Coordinate Information				
Data acquisition completion date indicated	<input type="checkbox"/>	<input type="checkbox"/>	<input type="checkbox"/>	
Coordinate system indicated (only CLV approved coordinate systems are to be used)	<input type="checkbox"/>	<input type="checkbox"/>	<input type="checkbox"/>	
Horizontal datum, datum adjustment, and epoch date indicated (only CLV approved datums are to be used)	<input type="checkbox"/>	<input type="checkbox"/>	<input type="checkbox"/>	
Benchmark ID, description, elevation indicated	<input type="checkbox"/>	<input type="checkbox"/>	<input type="checkbox"/>	
Statement of positional accuracy per the tolerances indicated below	<input type="checkbox"/>	<input type="checkbox"/>	<input type="checkbox"/>	
*NOTE For all projects with improvement plans approved prior to March 1, 2015 coordinates provided must be accurate to within ±0.5 feet horizontally and vertically. For all projects with improvement plans approved after March 1, 2015 coordinates provided must be accurate to within ±0.3 feet horizontally and vertically.				
Coordinate accuracy QA/QC (when available)	<input type="checkbox"/>	<input type="checkbox"/>	<input type="checkbox"/>	

ADDITIONAL COMMENTS