

M. W. Black

TENAYA WEST NO. 1A BY LEWIS HOMES

JANUARY 9, 1991

L-22-5, 7

BLOCK A LOT 1 1840 VIILA VISTA WAY N/S PUBLIC STREET

BLOCK B LOT 52 1713 NAWAJO LAKE WAY N/S PUBLIC STREET
53 1717
54 1721
55 1725
56 1729
57 1733
58 1737
59 1801
60 1805
61 1809
62 1813
63 1817
64 1821
65 1825
66 1829
67 1833
68 1837
69 1841
70 1845
71 1849
72 1901
73 1905
74 1909
75 1913
76 1917

BLOCK B LOT 77 7452 STONEY SHORE DRIVE E/W PUBLIC STREET


78 7448
79 7444
80 7440
~~81 7436~~
82 7432
83 7428
84 7424
85 7420
86 7416
87 7412
88 7408
89 7404
90 7400
91 7352
92 7348
93 7344
94 7340
95 7336
96 7332
97 7328
98 7324
99 7320
100 7316
101 7312
102 7308
103 7304
104 7300

BLOCK B LOT 105 1916 VIILA VISTA WAY N/S PUBLIC STREET

~~106 1912~~
~~107 1908~~
~~108 1904~~
~~109 1900~~

TENAYA WEST

DEVIATIONS FROM STANDARD DRAWINGS

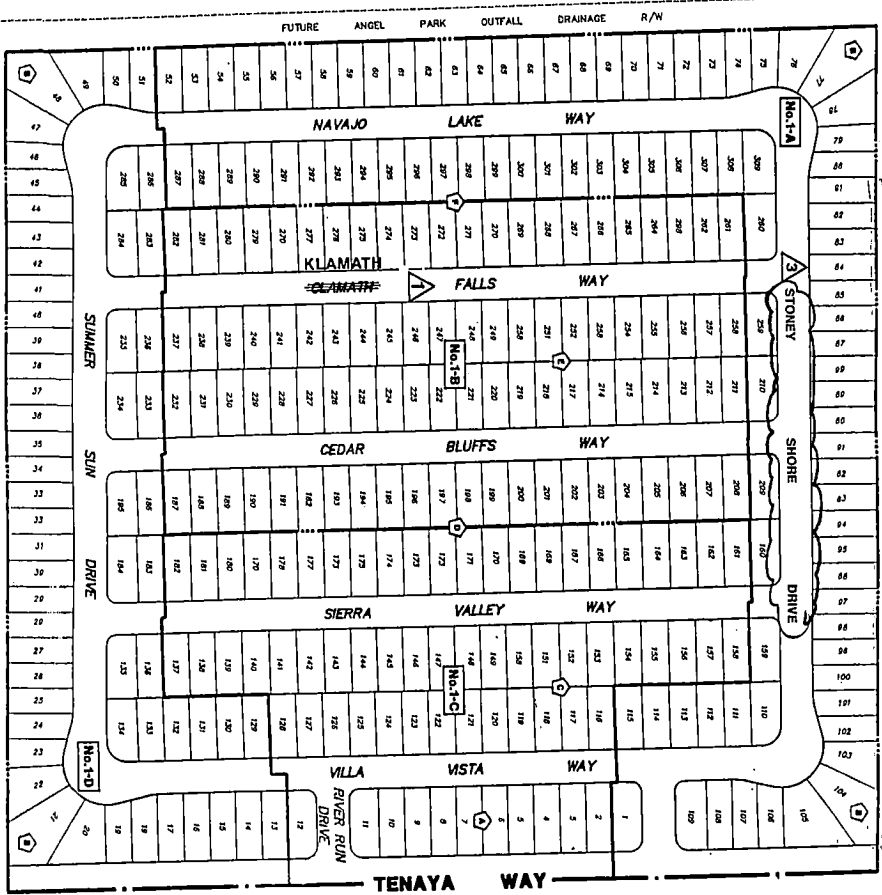

Co 'DCA' 11

TENAYA WAY

M. W. Black

TENAYA WEST NO. 1A BY LEWIS HOMES

JANUARY 9, 1991

L-22-5, 7

BLOCK A LOT 1 1840 VILLA VISTA WAY N/S PUBLIC STREET

BLOCK B LOT 52 1713 NAWAJO LAKE WAY N/S PUBLIC STREET

53 1717

54 1721

55 1725

56 1729

57 1733

58 1737

59 1801

60 1805

61 1809

62 1813

63 1817

64 1821

65 1825

66 1829

67 1833

68 1837

69 1841

70 1845

71 1849

72 1901

73 1905

74 1909

75 1913

76 1917

BLOCK B LOT 77 7452 STONEY SHORE DRIVE E/W PUBLIC STREET

78 7448

79 7444

80 7440

~~81 7436~~

~~82 7432~~

~~83 7428~~

~~84 7424~~

~~85 7420~~

~~86 7416~~

~~87 7412~~

~~88 7408~~

~~89 7404~~

~~90 7400~~

~~91 7352~~

~~92 7348~~

~~93 7344~~

~~94 7340~~

~~95 7336~~

~~96 7332~~

~~97 7328~~

~~98 7324~~

~~99 7320~~

~~100 7316~~

~~101 7312~~

~~102 7308~~

~~103 7304~~

~~104 7300~~

BLOCK B LOTS 105 1916 VILLA VISTA WAY N/S PUBLIC STREET

~~106 1912~~


~~107 1908~~

~~108 1904~~

~~109 1900~~

TENAYA WEST

DEVIATIONS FROM STANDARD DRAWINGS

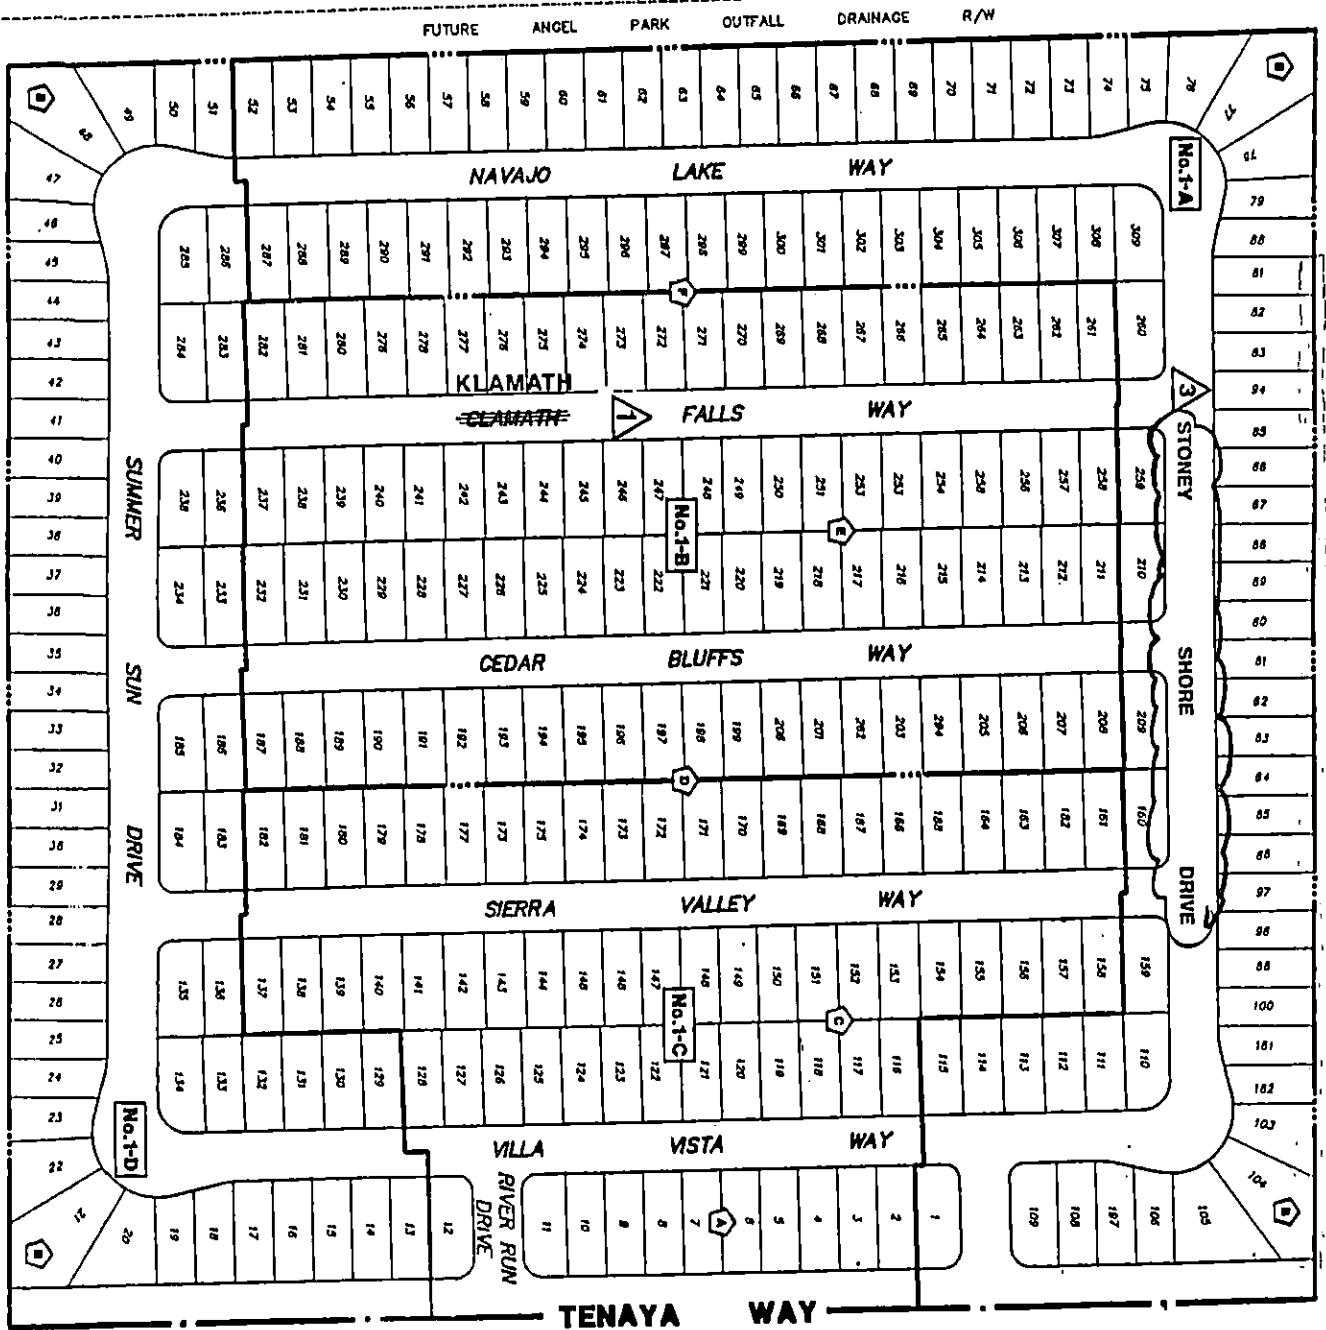

6' wide

TENAYA WEST NO. 1A BY LEWIS HOMES

JANUARY 9, 1991

L-22-5, 7

| | | | | | | |
|---------|-----|-----|------|--------------------|-----|---------------|
| BLOCK A | LOT | 1 | 1B40 | VILLA VISTA WAY | N/S | PUBLIC STREET |
| BLOCK B | LOT | 52 | 1713 | NAVAJO LAKE WAY | N/S | PUBLIC STREET |
| | | 53 | 1717 | | | |
| | | 54 | 1721 | | | |
| | | 55 | 1725 | | | |
| | | 56 | 1729 | | | |
| | | 57 | 1733 | | | |
| | | 58 | 1737 | | | |
| | | 59 | 1801 | | | |
| | | 60 | 1805 | | | |
| | | 61 | 1809 | | | |
| | | 62 | 1813 | | | |
| | | 63 | 1817 | | | |
| | | 64 | 1821 | | | |
| | | 65 | 1B25 | | | |
| | | 66 | 1B29 | | | |
| | | 67 | 1B33 | | | |
| | | 68 | 1B37 | | | |
| | | 69 | 1841 | | | |
| | | 70 | 1845 | | | |
| | | 71 | 1849 | | | |
| | | 72 | 1901 | | | |
| | | 73 | 1905 | | | |
| | | 74 | 1909 | | | |
| | | 75 | 1913 | | | |
| | | 76 | 1917 | | | |
| BLOCK B | LOT | 77 | 7452 | STONEY SHORE DRIVE | E/W | PUBLIC STREET |
| | | 78 | 7448 | | | |
| | | 79 | 7444 | | | |
| | | 80 | 7440 | | | |
| | | 81 | 7436 | | | |
| | | 82 | 7432 | | | |
| | | 83 | 7428 | | | |
| | | 84 | 7424 | | | |
| | | 85 | 7420 | | | |
| | | 86 | 7416 | | | |
| | | 87 | 7412 | | | |
| | | 88 | 7408 | | | |
| | | 89 | 7404 | | | |
| | | 90 | 7400 | | | |
| | | 91 | 7352 | | | |
| | | 92 | 7348 | | | |
| | | 93 | 7344 | | | |
| | | 94 | 7340 | | | |
| | | 95 | 7336 | | | |
| | | 96 | 7332 | | | |
| | | 97 | 7328 | | | |
| | | 98 | 7324 | | | |
| | | 99 | 7320 | | | |
| | | 100 | 7316 | | | |
| | | 101 | 7312 | | | |
| | | 102 | 7308 | | | |
| | | 103 | 7304 | | | |
| | | 104 | 7300 | | | |
| BLOCK B | LOT | 105 | 1916 | VILLA VISTA WAY | N/S | PUBLIC STREET |
| | | 106 | 1912 | | | |
| | | 107 | 1908 | | | |
| | | 108 | 1904 | | | |
| | | 109 | 1900 | | | |

TENAYA WEST NO. 1A BY LEWIS HOMES

JANUARY 9, 1991

| | | | | | |
|---------|---------|------|-------------------|-----|---------------|
| BLOCK C | LOT 110 | 1913 | VILLA VISTA WAY | N/S | PUBLIC STREET |
| | 111 | 1909 | | | |
| | 112 | 1905 | | | |
| | 113 | 1901 | | | |
| | 114 | 1B45 | | | |
| | 115 | 1841 | | | |
| BLOCK C | LOT 159 | 1912 | SIERRA VALLEY WAY | N/S | PUBLIC STREET |
| BLOCK D | LOT 160 | 1913 | SIERRA VALLEY WAY | N/S | PUBLIC STREET |
| BLOCK D | LOT 209 | 1912 | CEDAR BLUFFS WAY | N/S | PUBLIC STREET |
| BLOCK E | LOT 210 | 1913 | CEDAR BLUFFS WAY | N/S | PUBLIC STREET |
| BLOCK E | LOT 259 | 1912 | KLAMATH FALLS WAY | N/S | PUBLIC STREET |
| BLOCK F | LOT 160 | 1913 | KLAMATH FALLS WAY | N/S | PUBLIC STREET |
| BLOCK F | LOT 2B7 | 1712 | NAVAJO LAKE WAY | N/S | PUBLIC STREET |
| | 288 | 1716 | | | |
| | 289 | 1720 | | | |
| | 290 | 1724 | | | |
| | 291 | 172B | | | |
| | 292 | 1732 | | | |
| | 293 | 1736 | | | |
| | 294 | 1800 | | | |
| | 295 | 1B04 | | | |
| | 296 | 1808 | | | |
| | 297 | 1816 | | | |
| | 298 | 1820 | | | |
| | 299 | 1B24 | | | |
| | 300 | 1B28 | | | |
| | 301 | 1832 | | | |
| | 302 | 1B36 | | | |
| | 303 | 1840 | | | |
| | 304 | 1844 | | | |
| | 305 | 1848 | | | |
| | 306 | 1900 | | | |
| | 307 | 1904 | | | |
| | 308 | 1908 | | | |
| | 309 | 1912 | | | |

STREETS WITH NO ADDRESSES:

TENAYA WAY
OLD MISSION DRIVE

N/S PUBLIC STREET
E/W PUBLIC STREET

 MATT PINJUV
PLANNER

MP/dr

TENAYA WEST NO. 1A BY LEWIS HOMES

JANUARY 9, 1991

L-22-5, 7

| | | | | | | |
|---------|-----|-----|------|-------------------|-----|---------------|
| BLOCK A | LOT | 1 | 1840 | VILLA VISTA WAY | N/S | PUBLIC STREET |
| BLOCK B | LOT | 52 | 1713 | NAVAJO LAKE WAY | N/S | PUBLIC STREET |
| | | 53 | 1717 | | | |
| | | 54 | 1721 | | | |
| | | 55 | 1725 | | | |
| | | 56 | 1729 | | | |
| | | 57 | 1733 | | | |
| | | 58 | 1737 | | | |
| | | 59 | 1801 | | | |
| | | 60 | 1805 | | | |
| | | 61 | 1809 | | | |
| | | 62 | 1813 | | | |
| | | 63 | 1817 | | | |
| | | 64 | 1821 | | | |
| | | 65 | 1825 | | | |
| | | 66 | 1829 | | | |
| | | 67 | 1833 | | | |
| | | 68 | 1837 | | | |
| | | 69 | 1841 | | | |
| | | 70 | 1845 | | | |
| | | 71 | 1849 | | | |
| | | 72 | 1901 | | | |
| | | 73 | 1905 | | | |
| | | 74 | 1909 | | | |
| | | 75 | 1913 | | | |
| | | 76 | 1917 | | | |
| BLOCK B | LOT | 77 | 7452 | STONE SHORE DRIVE | E/W | PUBLIC STREET |
| | | 78 | 7448 | | | |
| | | 79 | 7444 | | | |
| | | 80 | 7440 | | | |
| | | 81 | 7436 | | | |
| | | 82 | 7432 | | | |
| | | 83 | 7428 | | | |
| | | 84 | 7424 | | | |
| | | 85 | 7420 | | | |
| | | 86 | 7416 | | | |
| | | 87 | 7412 | | | |
| | | 88 | 7408 | | | |
| | | 89 | 7404 | | | |
| | | 90 | 7400 | | | |
| | | 91 | 7352 | | | |
| | | 92 | 7348 | | | |
| | | 93 | 7344 | | | |
| | | 94 | 7340 | | | |
| | | 95 | 7336 | | | |
| | | 96 | 7332 | | | |
| | | 97 | 7328 | | | |
| | | 98 | 7324 | | | |
| | | 99 | 7320 | | | |
| | | 100 | 7316 | | | |
| | | 101 | 7312 | | | |
| | | 102 | 7308 | | | |
| | | 103 | 7304 | | | |
| | | 104 | 7300 | | | |
| BLOCK B | LOT | 105 | 1916 | VILLA VISTA WAY | N/S | PUBLIC STREET |
| | | 106 | 1912 | | | |
| | | 107 | 1908 | | | |
| | | 108 | 1904 | | | |
| | | 109 | 1900 | | | |

TENAYA WEST NO. 1A BY LEWIS HOMES

JANUARY 9, 1991

| | | | | | |
|---------|---------|------|-------------------|-----|---------------|
| BLOCK C | LOT 110 | 1913 | VILLA VISTA WAY | N/S | PUBLIC STREET |
| | 111 | 1909 | | | |
| | 112 | 1905 | | | |
| | 113 | 1901 | | | |
| | 114 | 1845 | | | |
| | 115 | 1841 | | | |
| BLOCK C | LOT 159 | 1912 | SIERRA VALLEY WAY | N/S | PUBLIC STREET |
| BLOCK D | LOT 160 | 1913 | SIERRA VALLEY WAY | N/S | PUBLIC STREET |
| BLOCK D | LOT 209 | 1912 | CEDAR BLUFFS WAY | N/S | PUBLIC STREET |
| BLOCK E | LOT 210 | 1913 | CEDAR BLUFFS WAY | N/S | PUBLIC STREET |
| BLOCK E | LOT 259 | 1912 | KLAMATH FALLS WAY | N/S | PUBLIC STREET |
| BLOCK F | LOT 160 | 1913 | KLAMATH FALLS WAY | N/S | PUBLIC STREET |
| BLOCK F | LOT 287 | 1712 | NAVAJO LAKE WAY | N/S | PUBLIC STREET |
| | 288 | 1716 | | | |
| | 289 | 1720 | | | |
| | 290 | 1724 | | | |
| | 291 | 1728 | | | |
| | 292 | 1732 | | | |
| | 293 | 1736 | | | |
| | 294 | 1800 | | | |
| | 295 | 1804 | | | |
| | 296 | 1808 | | | |
| | 297 | 1816 | | | |
| | 298 | 1820 | | | |
| | 299 | 1824 | | | |
| | 300 | 1828 | | | |
| | 301 | 1832 | | | |
| | 302 | 1836 | | | |
| | 303 | 1840 | | | |
| | 304 | 1844 | | | |
| | 305 | 1848 | | | |
| | 306 | 1900 | | | |
| | 307 | 1904 | | | |
| | 308 | 190B | | | |
| | 309 | 1912 | | | |

STREETS WITH NO ADDRESSES:

TENAYA WAY
OLD MISSION DRIVE

N/S PUBLIC STREET
E/W PUBLIC STREET

 MATT PINJUV
PLANNER

MP/dr

TENAYA WEST NO. 1A BY LEWIS HOMES

JANUARY 9, 1991

L-22-5, 7

| | | | | | | |
|---------|-----|-----|------|--------------------|-----|---------------|
| BLOCK A | LOT | 1 | 1840 | VILLA VISTA WAY | N/S | PUBLIC STREET |
| BLOCK B | LOT | 52 | 1713 | NAVAJO LAKE WAY | N/S | PUBLIC STREET |
| | | 53 | 1717 | | | |
| | | 54 | 1721 | | | |
| | | 55 | 1725 | | | |
| | | 56 | 1729 | | | |
| | | 57 | 1733 | | | |
| | | 58 | 1737 | | | |
| | | 59 | 1801 | | | |
| | | 60 | 1805 | | | |
| | | 61 | 1809 | | | |
| | | 62 | 1813 | | | |
| | | 63 | 1817 | | | |
| | | 64 | 1821 | | | |
| | | 65 | 1825 | | | |
| | | 66 | 1829 | | | |
| | | 67 | 1833 | | | |
| | | 68 | 1837 | | | |
| | | 69 | 1841 | | | |
| | | 70 | 1845 | | | |
| | | 71 | 1849 | | | |
| | | 72 | 1901 | | | |
| | | 73 | 1905 | | | |
| | | 74 | 1909 | | | |
| | | 75 | 1913 | | | |
| | | 76 | 1917 | | | |
| BLOCK B | LOT | 77 | 7452 | STONEY SHORE DRIVE | E/W | PUBLIC STREET |
| | | 78 | 7448 | | | |
| | | 79 | 7444 | | | |
| | | 80 | 7440 | | | |
| | | 81 | 7436 | | | |
| | | 82 | 7432 | | | |
| | | 83 | 7428 | | | |
| | | 84 | 7424 | | | |
| | | 85 | 7420 | | | |
| | | 86 | 7416 | | | |
| | | 87 | 7412 | | | |
| | | 88 | 7408 | | | |
| | | 89 | 7404 | | | |
| | | 90 | 7400 | | | |
| | | 91 | 7352 | | | |
| | | 92 | 7348 | | | |
| | | 93 | 7344 | | | |
| | | 94 | 7340 | | | |
| | | 95 | 7336 | | | |
| | | 96 | 7332 | | | |
| | | 97 | 7328 | | | |
| | | 98 | 7324 | | | |
| | | 99 | 7320 | | | |
| | | 100 | 7316 | | | |
| | | 101 | 7312 | | | |
| | | 102 | 7308 | | | |
| | | 103 | 7304 | | | |
| | | 104 | 7300 | | | |
| BLOCK B | LOT | 105 | 1916 | VILLA VISTA WAY | N/S | PUBLIC STREET |
| | | 106 | 1912 | | | |
| | | 107 | 1908 | | | |
| | | 108 | 1904 | | | |
| | | 109 | 1900 | | | |

TENAYA WEST NO. 1A BY LEWIS HOMES

JANUARY 9, 1991

| | | | | | |
|---------|---------|------|-------------------|-----|---------------|
| BLOCK C | LOT 110 | 1913 | VILLA VISTA WAY | N/S | PUBLIC STREET |
| | 111 | 1909 | | | |
| | 112 | 1905 | | | |
| | 113 | 1901 | | | |
| | 114 | 1B45 | | | |
| | 115 | 1B41 | | | |
| BLOCK C | LOT 159 | 1912 | SIERRA VALLEY WAY | N/S | PUBLIC STREET |
| BLOCK D | LOT 160 | 1913 | SIERRA VALLEY WAY | N/S | PUBLIC STREET |
| BLOCK D | LOT 209 | 1912 | CEDAR BLUFFS WAY | N/S | PUBLIC STREET |
| BLOCK E | LOT 210 | 1913 | CEDAR BLUFFS WAY | N/S | PUBLIC STREET |
| BLOCK E | LOT 259 | 1912 | KLAMATH FALLS WAY | N/S | PUBLIC STREET |
| BLOCK F | LOT 160 | 1913 | KLAMATH FALLS WAY | N/S | PUBLIC STREET |
| BLOCK F | LOT 287 | 1712 | NAVAJO LAKE WAY | N/S | PUBLIC STREET |
| | 288 | 1716 | | | |
| | 289 | 1720 | | | |
| | 290 | 1724 | | | |
| | 291 | 1728 | | | |
| | 292 | 1732 | | | |
| | 293 | 1736 | | | |
| | 294 | 1800 | | | |
| | 295 | 1804 | | | |
| | 296 | 180B | | | |
| | 297 | 1816 | | | |
| | 298 | 182D | | | |
| | 299 | 1824 | | | |
| | 300 | 1828 | | | |
| | 301 | 1832 | | | |
| | 302 | 1836 | | | |
| | 303 | 1B40 | | | |
| | 304 | 1844 | | | |
| | 305 | 1848 | | | |
| | 306 | 1900 | | | |
| | 307 | 1904 | | | |
| | 308 | 1908 | | | |
| | 309 | 1912 | | | |

STREETS WITH NO ADDRESSES:

TENAYA WAY
OLD MISSION DRIVE

N/S PUBLIC STREET
E/W PUBLIC STREET

MP MATT PINJUV
PLANNER

MP/dr