

6336 BRISTOL

Charles L. Jackson 2/24/61

DEPT. of BLDG. & SAFETY - CITY of LAS VEGAS, NEVADA		DATE
OWNER: SPROUL HOMES, INC.	ADDRESS: 6336 Bristol Way	11/10/60
GEN. CONT. SAME	LEGAL DESCRIPTION: Lot 24, Bl. 7, Chas. Hts. #23	TYPE OF STRUCTURE: S. F. DWELLING
PERMIT NO. 2181		
LOCATION & FLOOR ELEVATION	PLUMBING CONT. 1613 DATE 11-16-60	TEMP. POLE CONT. _____ DATE _____
FOOTINGS 11-14-60	HEAT. & VENT. CONT. 1613 DATE 1-3-61	INSPECTION _____ DATE _____
FOUND & PIERS	SEWER CONT. 1613 DATE 11-16-60	ELECTRICAL CONT. 1626 DATE 11-16-60
WALL STEEL	ROUGH SOIL 11-25-60	PERMIT NO. 1626 DATE 11-16-60
BOND BEAM STEEL	ROUGH WATER 11-25-60	OUTLETS 43
FRAMING & ROOF SHEATHING 11-14-60	SEWER OR SEPTIC TANK 11-25-60	MOTORS _____ H.P. _____
STEEL FABRICATION	TOP-OUT 12-16-60	SLAB 11-14-60
CONNECTIONS & PAINTING	ROUGH GAS 12-16-60	ROUGH _____
LATHING	ROUGH DUCT 12-16-60	FINAL ROUGH _____
PLASTER	FINAL PLUMBING 12-16-60	FIXTURE CONT. 1626 DATE 11-16-60
SCRATCH	FINAL HEATING 12-16-60	PERMIT NO. 1626 DATE 11-16-60
BROWN	FINAL GAS 12-16-60	FIXTURES 2
FINAL BLDG. 11-18-60		FINAL FIXTURE _____
SHADING & DRAINAGE		APPROVED FOR METER _____
ON-SITE PARKING		
ENG. APPROVAL OF OFF-SITE IMPROVEMENTS		

APPROVED for OCCUPANCY: **11-18-60** INSPECTOR

PLEASE NOTE REMARKS ON REVERSE SIDE
6336 Bristol Way DWELLING

11/10/60

LOG: #T-40 Area: **4** 23.04

Dona H. H. H.

10-29-82

CITY OF LAS VEGAS, NEVADA

LOG NO. & AREA

DEPARTMENT OF BUILDING AND SAFETY

CONS. VAL. \$ 1845.00

APPLICATION & BUILDING PERMIT - for:
Fence, Wall, Retaining Wall.

ADDRESS OF CONSTRUCTION: 12336 Bristol Way

OWNER: Kempston

LOT(s) 24 BLOCK 7 SUBDIVISION Char. Hgts #23

ZONE R-1

Materials of Construction: Block ☒ Concrete ☐ Wire ☐ Wood ☐ Other ☐

Yes No

ARCHITECT:

ENGINEER:

PLANS: ☐ ☐

CALCS: ☐ ☐

CONTRACTOR: Wons Masonry

STATE LICENSE # 19612 19580


CITY LICENSE # C11 15742
21757

Remarks:

TOTAL SQUARE FEET: TOTAL LINEAL FEET:

CONDITIONS OF THE PERMIT:

- Any type of retaining wall must be engineered by a Civil or Structural Engineer.
- If a home owner takes out the Building Permit and if the owner sublets the work to a Contractor, then the Contractor must take out the permit and pay for it.
- No fence or wall can be built on City property or rights-of-way, but this is not intended to preclude construction within utility easements if utilities will not be damaged or made inaccessible.
- The fence or wall shall not enclose any water meter, light standard, or fire alarm box and shall not come closer than 24" from the nearest fire hydrant outlet.
- Department Inspectors must approve footings before concrete is poured and block wall reinforcing before grouting is done.
- Maximum height of any wall or fence is 6' side and rear yards; 4' maximum in front yard with the vertical surface above the height of 2' 50% open.
- I must not obstruct required onsite parking space (2 spaces for each dwelling unit) by the erection of this fence or wall.
- By the signing of this application I herewith agree to the requirements outlined above.

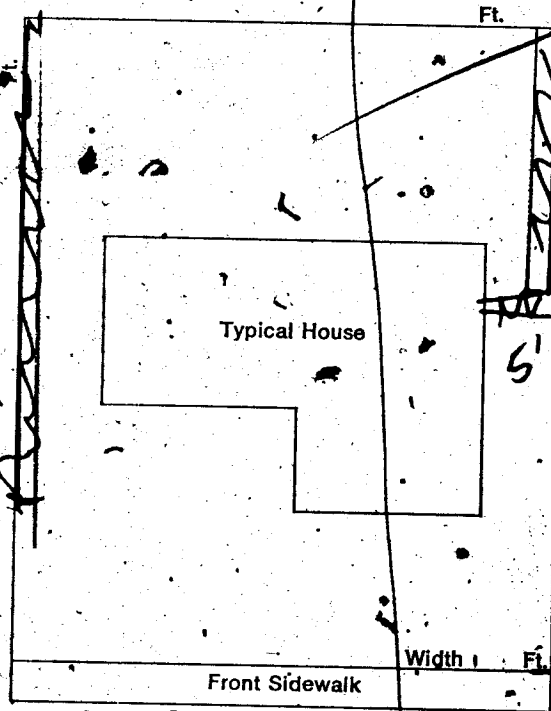

BRISTOL WY.

SIGNED:

CONTRACTOR ☒ AGENT ☐ OWNER ☐

11.00
WALL 32.50
9TL 32.50
TOTAL 32.50
CHECK DATE 32.50

PLANNING DEPT:

Date: 10/27/82

PUBLIC WORKS DEPT:

Date: 10/27/82

BUILDING DIVISION:

Date:

PERMIT NO: 4437

PERMIT FEE \$ 3250

AP#4437 SR#001/01
CITY LAS VEGAS
BLDG. & SAFETY
10/27/82

Don Hasty

12-14-82

FENCE & RETAINING WALLS			
OWNER		DATE	
Kempton		10-27-82	
ADDRESS			
6336 Bristol Way			
CONTRACTOR		PERMIT NO.	FINAL INSPECTION
Dons Masonary		4437	
LOT	BLOCK	SUBDIVISION	
24	7	Chas. Hgts.#	
LOG #		23	
AREA			
FENCES (wire, wood, block, & retaining walls)			
1	Location		
2	Footing		
3	Wall Steel		
	1st	2nd	
4	Bond Beam		
	1st	2nd	
5	Final		
Specify Type Of Fence			

2-1-33

DIV. OF BLDG. & SAFETY
CITY OF LAS VEGAS
REV. 10-78