

• 5813 APPLE VALLEY •

LOT 11 BLK 7 CHARLESTON HGTS 44-A R-1 ZONE

CITY OF LAS VEGAS, NEVADA

LOG. NO. & AREA

CONST. VAL. \$

DEPARTMENT OF BUILDING & SAFETY

APPLICATION & BUILDING PERMIT - for:

Dwelling, Duplexes, Misc. Residential Const.

ADDRESS OF CONSTRUCTION: 5813 APPLE VALLEY LN.

OWNER: HENRY E. HILL

LOT(s): 10 ELOCK 7 SUBDIVISION CHARLESTON ACRES 44-ONE: RT

Existing structure on lot: Dwelling ☐ Accessory bldgs. ☐ Vacant lot ☐ Other ☐

PROPOSED CONSTRUCTION: ENCLOSE GARAGE USE: DEN

MATERIALS OF CONSTRUCTION: NO. FIREPROOF Wood Frame ☐ Concrete Block ☐ Reinforced Concrete ☐ Steel Frame ☐

SQUARE FEET OF FLOOR AREAS: 1st 2nd 3rd Other TOTAL SQ. FT. 400


FIRE ZONE: 1 2 3 Occupancy Group A B C D E F G H I J 2-3-4-5 CONST. TYPE: I II III IV V

ARCHITECT: ENGINEER: NO. of UNITS NO. of STORIES

Plans submitted: Yes ☐ No ☐ Calculations submitted: Yes ☐ No ☐ Sewer Fee Req'd. Yes ☐ No ☐

CONTRACTOR: OWNER STATE LICENSE # CITY LICENSE #

A/D/L PERMITS REQ'D: Air Cond. ☐ Elec. ☒ Plumbing ☐ Signs ☐ Paving ☐ Fence ☐ Public Walks ☐ Curb-gutters ☐ Incinerators ☐ Fire Sprinkling System ☐

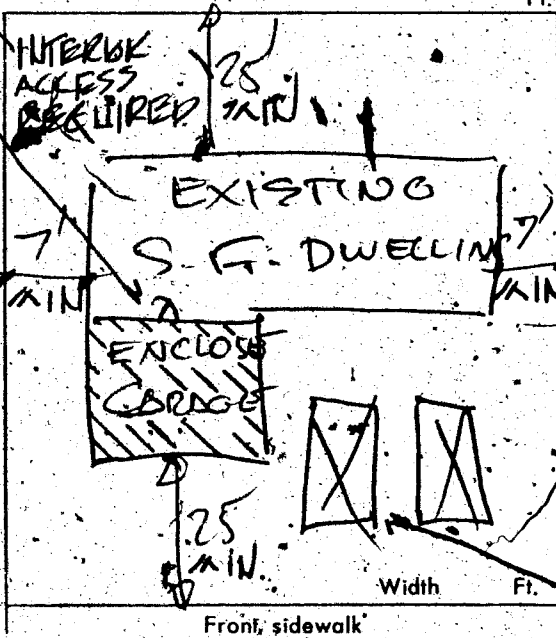

CONDITIONS OF THE PERMIT:

- I agree to call the City Building Department for inspections before concrete is poured, before rough wiring, electrical, plumbing, framing is covered. Also for Air conditioning, sheet-rock and sheathing inspection.
- I agree that when the job is completed that I will call for final inspection before occupancy.
- I agree to perform all construction in accordance with City Ordinances and Building Codes.
- The Contractor's signature below denotes authority from the owner to sign in his behalf and that the owner is aware of all requirements of this application and permit. Separate permits must be taken out for work outlined above this agreement.
- I have read and understand the contents of this application and permit; I hereby state that the information I have supplied on this application is true and correct.

SIGNED: Henry E. Hill Contractor

BY: Agent or Owner

CLARK COUNTY HEALTH DEPT.

Date

LAS VEGAS FIRE DEPARTMENT

Date

PLANNING DEPT:

Date: 7-12-71

PUBLIC WORKS DEPT:

Date: 7-12-71

BUILDING DEPT:

Date: 7-12-71

*12850

PERMIT NO: 146

PERMIT FEE: 1500

RECEIPT

1285 \$015.00 - 8

CITY OF LAS VEGAS
DEPT. OF
BUILDING & SAFETY

MUST BE MACHINE RECORDED

CITY OF LAS VEGAS, NEVADA

DEPARTMENT OF BUILDING & SAFETY - ELECTRICAL APPLICATION & PERMIT

ADDRESS OF
CONSTRUCTION:

5813 Apple Valley

OWNER'S
NAME:

HENRY C Hill

CIRCLE: New Bldg.: Add'n: Remodel: TYPE OF BLDG.: SFD. APT. PUBLIC COMM.

CONTRACTOR'S NAME:

owner

STATE
LICENSE #

CITY
LICENSE #

NUMBER	FIXTURE OR INSTALLATION	UNIT PRICE
6	Fixture or sockets	.15
3	Light, receptacle or switch outlet	.20
	Wall or ceiling space heater	.35
	Blast coil heater per kilowatt	.35
	Garbage grinder outlet	.35
	Dishwasher outlet	.35
	Clothes dryer outlet	.35
	Automatic clothes washer	.35
	Electric range outlet	.35
	Electric water heater outlet	.35
	Mercury arc lamp and equipment	.35
	Special purpose outlet	.35
	X-ray unit and its appurtenances	5.00
	Watts of festoon lighting (Watts) First 3,000 watts	4.00
	for each additional thousand watts	1.50
	Horsepower - all motors first horsepower or less	1.75
	for each additional horsepower	.35
	Temporary power and lights (temporary pole)	4.00
	Electric service (including any single meter socket)	3.00
	for each additional socket	.35
	Air conditioning service	amps 1.50
	Each KW (KVA) Generator (Transformer) (Welder) KW (KVA)	2.00
	First 100 KVA - For each additional KW (KVA)	.01
	Special inspection per hour	4.00
	Speaker outlets	.15
	Signal or Alarm outlets	.15
	Amplifiers	.50
	Control panels	.25
	V. outlets - master system only	.15
	Radio outlets	.15
	Main control racks	1.00
	T. V. and Radio antennas - master system only	.75
	Minimum fee for any permit	4.00
	Total fee	

I hereby certify that I have carefully examined and read the above application; that the same is true and correct; and that the work herein described is to be done in accordance with all the provisions of the applicable Ordinances of the City of Las Vegas, Nevada and State laws whether herein specified or not.

SIGNED

MASTER (ELECTRICIAN) (TECHNICIAN) (OWNER)

DATE

BUILDING DEPARTMENT

DATE

12860

PERMIT NO.

114

PERMIT FEE: \$

4

RECEIPT

12860 \$004.00 - 6

CITY OF LAS VEGAS

DEPT. OF
BUILDING & SAFETY

MUST BE MACHINE VALIDATED

G. Gatewood 2-15-79

CITY OF LAS VEGAS, NEVADA

LOG NO. & AREA

DEPARTMENT OF PUBLIC SERVICES

DIVISION OF BUILDING & SAFETY

APPLICATION FOR BUILDING PERMIT - for:

Fence, Wall, Retaining Wall

CONST. VAL. \$ 1385

ADDRESS OF CONSTRUCTION:

5813 Apple Valley Lane

OWNER: Gerald O. Hillbert

LOT(S)

10

BLOCK

7

SUBDIVISION

Charleston Tracts #44-A

ZONE:

R-1

Materials of Construction:

Block ☒

Concrete ☐

Wire ☐

Wood ☐

Other ☐

Yes No

PLANS: ☐ ☐

CALCS: ☐ ☐

ARCHITECT:

ENGINEER:

CONTRACTOR:

Owner

STATE LICENSE #

CITY LICENSE #

TOTAL SQUARE FEET: 594


TOTAL LINEAL FEET: 79' 8"

Remarks:

15

CONDITIONS OF THE PERMIT:

1. Any type of retaining wall must be engineered by a Civil or Structural Engineer.
2. If a home owner takes out the Building Permit and if the owner sublets the work to a Contractor, then the Contractor must take out the permit and pay for it.
3. No fence or wall can be built on City property or rights-of-way, but this is not intended to preclude construction within utility easements if utilities will not be damaged or made inaccessible.
4. The fence or wall shall not enclose any water meter, light standard, or fire alarm box and shall not come closer than 24" from the nearest fire hydrant outlet.
5. Department inspectors must approve footings before concrete is poured and block wall reinforcing before grouting is done.
6. Maximum height of any wall or fence is 6' side and rear yards; 4' maximum in front yard with the vertical surface above the height of 2' - 50% open.
7. I must not obstruct required onsite parking space (2 spaces for each dwelling unit) by the erection of this fence or wall.
8. By the signing of this application I herewith agree to the requirements outlined above.

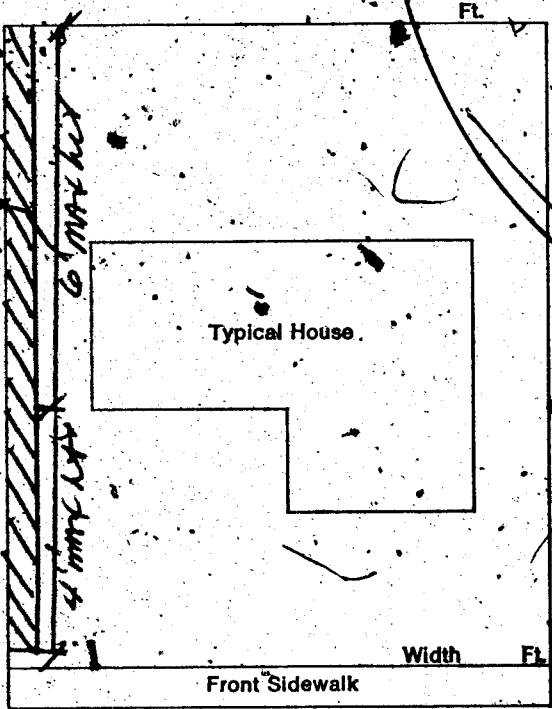

1 DON \$.00
WALL \$ 15.00
STL \$ 15.00
TOTL \$ 15.00
CHK \$ 15.00

SIGNED:

Gerald O. Hillbert

CONTRACTOR ☐

AGENT ☐

#0837 DATE 2-7-79

CITY OF LAS VEGAS

BLDG. & SAFETY

02/08/79

RECEIPT

PLANNING DEPT:

ARU

Date:

2/7/79

PUBLIC WORKS DEPT:

ARU

Date:

2-7-79

BUILDING DIVISION:

WR 7

Date:

2/9/79

#12850

PERMIT NO:

10837

PERMIT FEE \$

15.00

MUST BE MACHINE VALIDATED

Theresa Kipke 11-12-80

DEPT. of BLDG & SAFETY—CITY of LAS VEGAS, NEVADA

OWNER Raleigh Dev. ADDRESS 5813 Apple Valley DATE
GEN. CONT. TYPE OF STRUCTURE Fence
PERMIT NO. 19558 LEGAL DESCRIPTION

BUILDING		MECHANICAL		ELECTRICAL	
LOCATION		PLUMBING CONT.		TEMP. POLE CONT.	
FIREPLACE FTS.		PERMIT NO.	DATE	PERMIT NO.	DATE
FOOTINGS		HEAT & VENT. AC CONT.		INSPECTION	DATE
FOUNDATION WALL		PERMIT NO.	DATE	ELECTRICAL CONT.	
FLOOR FRAMING		SEWER CONT.		PERMIT NO.	DATE
SLAB		PERMIT NO.	DATE	FIXTURES CONT.	
CHIMNEY STEEL (FIREPLACE)		ROUGH SOIL		PERMIT NO.	DATE
WALL STEEL		ROUGH WATER		SLAB	
COLUMN STEEL		TOP-OUT		ROUGH	
BEAM STEEL		ROUGH GAS		FINAL ROUGH	
FRAMING		AC ROUGH DUCT		FINAL FIXTURE	
ROOF SHEATHING		REF. ROUGH PIPING		FINAL ELECTRICAL	
INTERIOR		FINAL PLUMBING		TEMPORARY SERVICE	
DRYWALL		FINAL GAS			
LATHING		FINAL AIR COND.			
BACKING (SIDING)		FINAL REFRIG.			
PLASTER		FINAL SEWER			
SCRATCH		FINAL SEPTIC TANK			
BROWN					
URBAN REDEVELOPMENT APPROVAL					
FINAL BLDG					

APPROVED FOR OCCUPANCY BY METER
PLEASE NOTE REMARKS ON REVERSE SIDE

5813 Apple Valley

DEPARTMENT OF BUILDING & SAFETY
CITY OF LAS VEGAS, NEVADA

KARDEX CARD
FENCE & RETAINING
WALLS

OWNER Henry Hill ADDRESS 5813 Apple Valley Lane DATE 3-10-65
CONTRACTOR W. J. Chester PERMIT NO. 29537
LOT 10 BLOCK 7 SUBDIVISION Chas Hts 44A Wire Fence

Fence (wire, wood, etc.)	Walls (masonry, rock, etc.)
Location	Location
Final Inspection <u>2-23-65</u>	Footings
	Wall Steel 1st <u> </u> 2d <u> </u> 3d <u> </u>
	Final Inspection
Retaining Wall (masonry)	Retaining Wall (concrete)
Location	Location
Footings	Footings
Wall Steel 1st <u> </u> 2d <u> </u> 3d <u> </u>	Wall Steel 1st <u> </u> 2d <u> </u> 3d <u> </u>
Bond Beam 1st <u> </u> 2d <u> </u> 3d <u> </u>	Final Inspection
Final Inspection	

23.14-B

ADDRESS 5813 Apple Valley LOG NO. AREA

Theresa K. Quinter 11-12-80

DEPT. of BLDG. & SAFETY - CITY of LAS VEGAS, NEVADA

OWNER Henry C. Hill ADDRESS 5813 Apple Valley Lane DATE 10-26-73
GEN. CONT. Owner TYPE OF STRUCTURE patio slab & Cover
PERMIT NO. 18673 LEGAL DESCRIPTION L 10 B 7 Char Hgts 44 A

BUILDING	MECHANICAL	ELECTRICAL
Investigation	Plumbing Cont.	Temp. pole cont.
Location & Footing	Permit No. _____ Date _____	Permit No. _____ Date _____
Stem Wall	Heat & Vent. A/C Cont.	Inspection _____ Date _____
Concrete Slab Floor	Permit No. _____ Date _____	Electrical Cont.
Floor Framing	Sewer Cont.	Permit No. _____ Date _____
Fireplace Footing	Permit No. _____ Date _____	Fixtures Cont.
Chimney Steel	Rough Soil	Permit No. _____ Date _____
Vert. Steel Reinf.	Rough Water	Slab
Horiz. Steel Reinf.	Top-Out	Rough
Roof Sheathing	Rough Gas	Final Rough
Framing	A/C Rough Duct	Final Fixture
Backing for siding	Ref. Rough Piping	Final Electrical
Ext. Lath	Final Plumbing	Temporary Service
Ext. Scratch	Final Gas	MISCELLANEOUS
Ext. Brown	Final Air Cond.	Grading & Drainage
Int. Lath	Final Refrig.	On-Site Parking Spaces
Int. Brown	Final Sewer	Eng. Approval of
Drywall	Final Septic Tank	Off-Site Improvements
Permit No.		
Final Building		
Appr. for Occu.		

INSPECTOR:

DATE

APPROVED FOR OCCUPANCY & METER

09/10-29-73

PLEASE NOTE REMARKS ON REVERSE SIDE

5813 Apple Valley Lane

AREA #

DEPT. of BLDG. & SAFETY - CITY of LAS VEGAS, NEVADA

OWNER Henry C. Hill ADDRESS 5813 Apple Valley Lane DATE 7-12-71
GEN. CONT. Owner TYPE OF STRUCTURE one garage
PERMIT NO. 146 LEGAL DESCRIPTION L10 B 7 Charleston Hgts 44 a & fireplace

BUILDING	MECHANICAL	ELECTRICAL
LOCATION	PLUMBING CONT.	TEMP. POLE CONT.
FIREPLACE FTG. 08/10-27-71	PERMIT NO. _____ DATE _____	PERMIT NO. _____ DATE _____
FOOTINGS	HEAT & VENT. AC CONT.	INSPECTION _____ DATE _____
FOUNDATION WALL	PERMIT NO. _____ DATE _____	ELECTRICAL CONT. Owner
FLOOR FRAMING	SEWER CONT.	PERMIT NO. 114 DATE 7-12-71
SLAB 08/24-71	PERMIT NO. _____ DATE _____	FIXTURES CONT.
CHIMNEY STEEL (REPLACE)	ROUGH SOIL	PERMIT NO. _____ DATE _____
WALL STEEL	ROUGH WATER	SLAB
COLUMN STEEL	TOP-OUT	ROUGH 9/24-24-71
BEAM STEEL	ROUGH GAS	FINAL ROUGH
FRAMING 08/24-71	AC ROUGH DUCT	FINAL FIXTURE
ROOF SHEATHING 08/24-71	REF. ROUGH PIPING	FINAL ELECTRICAL 10/29-73
INTERIOR	FINAL PLUMBING	TEMPORARY SERVICE
DRYWALL 08/24-71	FINAL GAS	MISCELLANEOUS
LATHING	FINAL AIR COND.	Grading & Drainage
BACKING (SIDING)	FINAL REFRIG.	On-Site Parking Spaces
PLASTER	FINAL SEWER	Eng. Approval of
SCRATCH	FINAL SEPTIC TANK	Off-Site Improvements
BROWN		
URBAN REDEVELOPMENT APPROVAL		
FINAL BLDG. _____ DATE _____		

APPROVED FOR OCCUPANCY & METER

09/10-29-73

INSPECTOR

DATE

PLEASE NOTE REMARKS ON REVERSE SIDE

5813 Apple Valley Lane

AREA #

2304

Theresa K. R. 11-12-80.

DEPT. of BLDG & SAFETY—CITY of LAS VEGAS, NEVADA

OWNER RALEIGH DEVELOPMENT CO. ADDRESS 5813 APPLE VALLEY DATE 1-10-63
GEN. CONT. Same TYPE OF STRUCTURE SFD
PERMIT NO. 15984 LEGAL DESCRIPTION lot 10 block 7 Charleston Heights 77 A

BUILDING		MECHANICAL	ELECTRICAL
LOCATION		PLUMBING CONT. <u>7-2-63</u>	TEMP. POLE CONT. <u>7-2-63</u>

PLEASE NOTE REMARKS ON REVERSE SIDE

5813 APPLE VALLEY

T 5 4

23 04

Theresa KYRIAKOS 2-2-81

FENCE & RETAINING WALLS			
OWNER		DATE	
Jerald O. Hibbert		2-8-79	
ADDRESS			
5813 Apple Valley Ln			
CONTRACTOR		PERMIT NO.	FINAL INSPECTION
Owner		0837	
LOT	BLOCK	SUBDIVISION	
10	7	Charleston Hgts #44-A	
LOG #		AREA	
FENCES (wire, wood, block, & retaining walls)			
1	Location		
	MN 2879		
2	Footing		
	MN 2879		
3	Wall Steel		
	1st FC 3-1-79		
4	Bond Beam		
	1st		
5	Final		
	FC 1-23-80		
Specify Type Of Fence			
2-1-33	DIV OF BLDG & SAFETY CITY OF LAS VEGAS REV 10-78		2-2-WAY SYSTEM CONCRETE ON 43000 LITHO IN U.S.A