

1140 BLANKENSHIP

LOT 131 VEGAS HGTS #4 ZONE R-2

CITY OF LAS VEGAS, NEVADA

LOG NO. & AREA K-23-31 1970 CONST. VAL \$ 16,500.00

DEPARTMENT OF BUILDING & SAFETY

APPLICATION & BUILDING PERMIT - for Dwellings, Duplexes, Misc. Residential Const.

ADDRESS OF CONSTRUCTION: 1140 Bladudis Ave OWNER: SECURITY HOUSING CORP

LOT(S) 131 C-BLOCK SUBDIVISION VEGAS HEIGHTS UNIT #4 ZONE: R-2

Existing structure on lot: Dwelling  Accessory bldgs.  Vacant lot  Other

PROPOSED CONSTRUCTION: S.F.D USE: RESIDENCES

MATERIALS OF CONSTRUCTION: Wood Frame  Concrete Block  Reinforced Concrete  Steel Frame

SQUARE FEET OF FLOOR AREAS: 1st 1320 2nd \_\_\_\_\_ 3rd \_\_\_\_\_ Other \_\_\_\_\_ TOTAL SQ. FT. 1320


FIRE ZONE: 1 2 3 Occupancy Group A B C D E F G H(1) J:1-2-3-4-5 CONST. TYPE: I II III IV V

ARCHITECT: \_\_\_\_\_ ENGINEER: \_\_\_\_\_ NO. of UNITS: 1 NO. of STORIES: 1

Plans Submitted: Yes  No  Calculations Submitted: Yes  No  Sewer Fee Req'd: Yes  No

CONTRACTOR: SECURITY HOUSING CORP STATE LICENSE # 5863B CITY LICENSE # C-11-180-2-9865

ADD'L. PERMITS REQ'D: Air Cond.  Elec.  Plumbing  Signs  Paving  Fence  Public Walks  Curb-gutters  Incinerators  Fire Sprinkling System

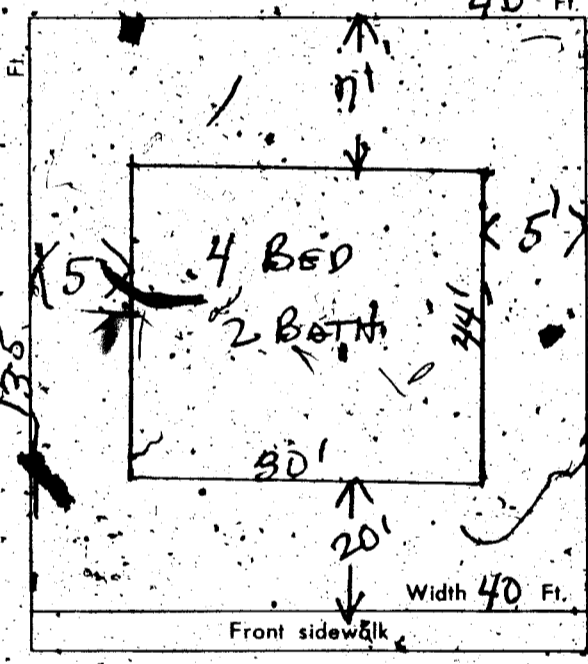

CONDITIONS OF THE PERMIT:

- 1. I agree to call the City Building Department for inspections before concrete is poured, before rough wiring, electrical, plumbing, framing is covered. Also for Air conditioning, sheet-rock and sheathing inspection.
- 2. I agree that when the job is completed that I will call for final inspection before occupancy.
- 3. I agree to perform all construction in accordance with City Ordinances and Building Codes.
- 4. The Contractor's signature below denotes authority from the owner to sign in his behalf and that the owner is aware of all requirements of this application and permit. Separate permits must be taken out for work outlined above this agreement.
- 5. I have read and understand the contents of this application and permit; I hereby state that the information I have supplied on this application is true and correct.

SIGNED: Security Housing Corp Contractor  
BY: L. Nelson Agent or Owner

CLARK COUNTY HEALTH DEPT. Date \_\_\_\_\_  
LAS VEGAS FIRE DEPARTMENT Date \_\_\_\_\_

PLANNING DEPT: [Signature] Date: 12/14/70  
PUBLIC WORKS DEPT: [Signature] Date: 12-15  
BUILDING DEPT: [Signature] Date: \_\_\_\_\_  
#12850 PERMIT NO: 55854 PERMIT FEE \$ 70.00

RECEIPT  
309.0 \$070.00 - 8  
CITY OF LAS VEGAS  
DEPT. OF BUILDING & SAFETY  
MUST BE MACHINE DATED  
18 DEC 70

CITY OF LAS VEGAS, NEVADA

DEPARTMENT OF BUILDING & SAFETY - APPLICATION AND PERMIT FOR PLUMBING

ADDRESS OF CONSTRUCTION: 1140 Blankenship

OWNER'S NAME: Security Housing Corp

CIRCLE: New Bldg. Add'n; Remodel; TYPE OF BLDG.: (SFD) APT. PUBLIC COMM.

CONTRACTOR'S NAME: Vegas Plumbing, Inc.

STATE LICENSE # 5863C

CITY LICENSE # 011-179-208413

UNITS	DESCRIPTION	FEE	TOTAL
1	Bathtub	1.00	1.00
	Shower	1.00	
2	Lavatory	1.00	2.00
2	Toilet	1.00	2.00
	Urinal	1.00	
	Floor Drain	1.00	
	Floor Sink	1.00	
	Wash Tray	1.00	
1	Sink	1.00	1.00
	Garbage Disposal	1.00	
	Garbage Disposal (comm.)	3.00	
	Clothes Dryer (gas)	1.00	
1	Clothes Washer	1.00	1.00
	Clothes Washer (comm.)	5.00	
	Dishwasher	1.00	
	Dishwasher (commercial)	5.00	
	Dental Unit	10.00	
	Drinking Fountain	1.00	
	Any Water using Equipment	1.00	
1	Water Heater (gas)(elect.)	1.00	1.00
	Sewer System - New, Replacement, or any Drainage System	4.00	4.00
	Grease or Sand Trap	2.00	
	Trailer Trap	2.00	
	Septic Disposal System	4.00	
WATER SOFTENERS			
	Nonpermanent Type	4.00	
	Permanent Type (connected to Drainage)	5.00	
SWIMMING POOLS			
	Private or Wading Pool	10.00	
	Public or Semi-public	20.00	

UNITS	DESCRIPTION	FEE	TOTAL
WATER DISTRIBUTION SYSTEM			
1	Single Family Dwelling	4.00	4.00
	Multiple Family Dwelling plus each unit	4.00	
	Bldg. Group "A" thru "G" per each floor	2.00	
	Hotel or Motel plus each bath	6.00	
	Trailer Park plus each space	4.00	
	Irrigation	1.50	
		20.00	
		1.00	
		4.00	
GAS PIPING SYSTEM			
1	Single Family Dwelling	3.00	3.00
	Multiple Family Dwelling plus each unit	6.00	
	Commercial Bldg. per floor plus each unit	1.00	
	Gas Appliance (any type)	3.00	
		3.00	
		1.00	
AUTOMATIC FIRE EXTINGUISHING SYSTEM			
	Underground Piping	10.00	
	Distribution Piping ea. ft.	.01	
	Sprinkler Head each	.10	
	In Range Hood and Vent	5.00	
DRY STANDPIPE SYSTEM			
	Piping	50.00	
	Each Outlet	1.00	
WET STANDPIPE SYSTEM			
	Piping	5.00	
	Fire Hose Cabinet	1.00	
	MINIMUM PERMIT FEE	4.00	
TOTAL PERMIT FEE \$		19.00	
		<del>19.00</del>	

I hereby certify that I have carefully examined and read the above application; that the same is true and correct; and that the work herein described is to be done in accordance with all the provisions of the applicable Ordinances of the City of Las Vegas, Nevada and the State Laws, whether herein specified or not.

Signed J. D. Dilbert Date: 12-15-70  
REGISTERED MASTER PLUMBER, SPEC. CONTR., OR OWNER

Building Department

Date: 12-21-70

#12870

Permit No. 32098

Permit Fee \$ 19.00

RECEIPT  
3127 - \$019.00 - 7  
CITY OF LAS VEGAS  
DEPT. OF BUILDING & SAFETY  
MUST BE MACHINE VALIDATED  
21 DEC 70

*Seybert 1523-17*

**CITY OF LAS VEGAS, NEVADA**  
**DEPARTMENT OF BUILDING & SAFETY - AIR CONDITIONING APPLICATION & PERMIT**

ADDRESS OF CONSTRUCTION: 1440 Blankenship OWNER'S NAME: SECURITY HOUSING CORP.

CIRCLE: Addition Remodel (New Bldg.) TYPE OF BLDG.: (SFD) APT. COMM. PUBLIC

CONTRACTOR'S NAME: Spratt Air Conditioning STATE LICENSE 8214 CITY LICENSE 9850

UNITS	DESCRIPTION	FEE	TOTAL	UNITS	DESCRIPTION	FEE	TOTAL
	Unit heater, floor, wall or suspended	4.00			EVAPORATIVE COOLERS:		
	FOR EACH FORCED AIR OR GRAVITY TYPE FURNACE OR BURNER INCLUDING DUCTS AND VENT ATTACHED TO SUCH APPLIANCES				5 outlets or under	3.00	
	Up to and including 100,000 B.t.u.'s	4.00			Over 5 and up to and including 10	5.00	
	Over 100,000 B.t.u.'s	6.00			Each additional outlet over 10	.25	
	FOR EACH HEATING APPLICATION, REFRIGERATION UNIT, COMMERCIAL COOLING AND HEATING UNIT, ABSORPTION UNIT, COMPRESSOR OR BOILER				VENTILATION:		
	Up to and including 3 ton or horsepower, or absorption system up to and including 100,000 B.t.u.'s	4.00	4.00		For each fan connected to a single duct	1.00	
	Over 3 ton or 3 horsepower up to and including 10, or absorption system over 100,000 B.t.u.'s up to and including 250,000 B.t.u.'s	7.00			For each commercial or industrial ventilation system	5.00	
	Over 10 ton or 10 horsepower up to and including 30, or absorption system over 250,000 B.t.u.'s up to and including 1,000,000 B.t.u.'s	12.00			For each commercial kitchen hood	5.00	
	Over 30 ton or 30 horsepower up to and including 50, or absorption system over 1,000,000 B.t.u.'s up to and including 1,700,000 B.t.u.'s	20.00			MISCELLANEOUS:		
	Over 50 ton or 50 horsepower, or absorption system over 1,700,000 B.t.u.'s	30.00			For each water cooling tower	8.00	
	FOR EACH AIR HANDLING UNIT INCLUDING DUCTS ATTACHED THERETO				Duct work only, each opening	.25	
	Up to and including 10,000 CFM	2.00			For installation or relocation of each commercial or industrial incinerator	15.00	
	Over 10,000 CFM	4.00			Gas piping related to the air cond. work in single family dwelling only	3.00	
					For each appliance, piece of equipment, any mechanical work or alteration or replacement not included in this schedule, the permit fee shall be computed the same as building permit fees by using the cost of installation for the valuation amount.		
					FOR THE ISSUANCE OF EACH PERMIT	3.00	
					TOTAL PERMIT FEE \$	7.00	

I hereby certify that I have carefully examined and read the above application; that the same is true and correct, and that the work herein described is to be done in accordance with all the provisions of the applicable Ordinances of the City of Las Vegas, Nevada and the State Laws, whether herein specified or not.

SIGNED: [Signature] Date 12/28/70  
 Air Conditioning Contractor, Owner

BUILDING DEPARTMENT: [Signature] Date 12-28-70

PERMIT NO. 29895 PERMIT FEE \$ 7.00

RECEIPT  
 3448: \$007.00  
 CITY OF LAS VEGAS  
 DEPT. OF BUILDING & SAFETY  
 MUST BE MACHINE VALIDATED  
 29 DEC 70

#12898

S. Seybert 1-25-71

CITY OF LAS VEGAS, NEVADA

DEPARTMENT OF BUILDING & SAFETY - ELECTRICAL APPLICATION & PERMIT

ADDRESS OF CONSTRUCTION: 1140 Blankenship OWNER'S NAME: Security Homes

CIRCLE: New Bldg. Add'n; Remodel; TYPE OF BLDG. SFD APT. PUBLIC COMM.

CONTRACTOR'S NAME: Denta Electric Co. STATE LICENSE # 9750 CITY LICENSE # C11299

NUMBER	FIXTURE OR INSTALLATION	UNIT PRICE	
8	Fixture or sockets	.15	1.20
41	Light, receptacle or switch outlet	.20	8.20
	Wall or ceiling space heater	.35	
	Blas oil heater per kilowatt	.35	
	Garbage grinder outlet	.35	
	Dishwasher outlet	.35	
	Clothes dryer outlet	.35	
1	Automatic clothes washer	.35	35
	Electric range outlet	.35	
	Electric water heater outlet	.35	
	Mercury arc lamp and equipment	.35	
	Special purpose outlet	.35	
	X-ray unit and its appurtenances	5.00	
	Watts of festoon lighting (Watts) First 3,000 watts	4.00	
	for each additional thousand watts	1.50	
	Horsepower - all motors first horsepower, or less	1.75	
	for each additional horsepower	.35	
	Temporary power and lights (temporary pole)	4.00	
1	Electric service (including any single meter socket)	3.00	3.00
	for each additional socket	.35	
1	Air conditioning service	1.50	150
	Each KW (KVA) Generator (Transformer) (Welder) KW (KVA)	2.00	
	First 100 KVA - For each additional KW (KVA)	.01	
	Special inspection per hour	4.00	
	Speaker outlets	.15	
	Signal or Alarm outlets	.15	
	Amplifiers	.50	
	Control panels	.25	
	T. V. outlets - master system only	.15	
	Radio outlets	.15	
	Main control racks	1.00	
	T. V. and Radio antennas - master system only	.75	
	Minimum fee for any permit	4.00	
	Total fee		141.25

I hereby certify that I have carefully examined and read the above application; that the same is true and correct; and that the work herein described is to be done in accordance with all the provisions of the applicable Ordinances of the City of Las Vegas, Nevada and State laws whether herein specified or not.

SIGNED: E.H. Denta DATE 1-4-71  
MASTER (ELECTRICIAN) (TECHNICIAN) (OWNER)

BUILDING DEPARTMENT: W.P. Miller DATE 1-5-71

\*12860 PERMIT NO. 32658 PERMIT FEE: \$ 141.25

RECEIPT

3687 \$0141.25 - 6

CITY OF LAS VEGAS

DEPT. OF BUILDING & SAFETY


MUST BE MACHINE VALIDATED

5 JAN 71

S. Seybert 7-25-77

CITY OF LAS VEGAS, NEVADA  
Department of Building and Safety

# CERTIFICATE OF INSPECTION

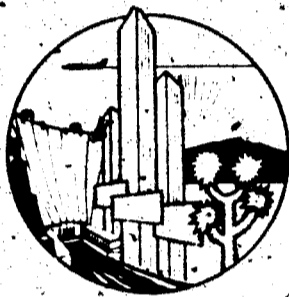

Address 1140 Blankenship Owner D.A.SCO  
Legal Lot 131C Date 4-8-76  
Vegas Heights Unit 4

This certificate issued pursuant to the requirements of Section 306 of the UNIFORM BUILDING CODE certifying that at the time of this issuance, the improvements on this property were in compliance with CITY OF LAS VEGAS, HOUSING, BUILDING, ELECTRICAL, PLUMBING and MECHANICAL CODES

DIRECTOR  
Department of Building & Safety  
*William R. Fitzgerald*

This Certificate does not include conditions subject to normal maintenance.

No. 5011 Fee \$ 10<sup>00</sup>

RECEIPT  
Must be machine validated  
*Paid by Rehab*  
*Permit 5011*  
*11-21-75*  
*WR7*

Seybert 1-25-79

CITY OF LAS VEGAS, NEVADA  
Department of Building and Safety

# CERTIFICATE OF INSPECTION



Address 1140 Blankenship Owner D.A.S.C.O.  
Legal Lot 131C Date 4-8-76  
Vegas Heights Unit 4

This certificate issued pursuant to the requirements of Section 306 of the UNIFORM BUILDING CODE certifying that at the time of this issuance, the improvements on this property were in compliance with CITY OF LAS VEGAS, HOUSING, BUILDING, ELECTRICAL, PLUMBING and MECHANICAL CODES

DIRECTOR  
Department of Building & Safety

*by William R. Fitzgerald*

This Certificate does not include conditions subject to normal maintenance.

No. 5011

Fee \$ 10<sup>00</sup>

### RECEIPT

Must be machine validated

*Paid by Rebel*  
*Permit 5011*  
*11-21-75*  
*WR7*

S. Seybert 7-25-19

CITY OF LAS VEGAS, NEVADA

\$2000

LOG NO. & AREA \_\_\_\_\_ DEPARTMENT OF BUILDING & SAFETY

CONST. VAL. \_\_\_\_\_ APPLICATION & BUILDING PERMIT — for: Dwellings, Duplexes, Misc. Residential Const.

ADDRESS OF CONSTRUCTION: 1140 Blankenship OWNER: Sisco Inc

LOT(s) 131C BLOCK \_\_\_\_\_ SUBDIVISION HYDE PARK #4 ZONE R-2

Existing structure on lot: Dwelling  Accessory bldgs.  Vacant lot  Other

PROPOSED CONSTRUCTION: Renov USE: \_\_\_\_\_

MATERIALS OF CONSTRUCTION: Wood Frame  Concrete Block  Reinforced Concrete  Steel Frame

SQ. FEET OF FLOOR AREAS: 1st \_\_\_\_\_ 2nd \_\_\_\_\_ 3rd \_\_\_\_\_ Other \_\_\_\_\_ TOTAL SQ. FT. \_\_\_\_\_


FIRE ZONE: 1 2 3 Occupancy Group 1 J 1 - 2 CONST. TYPE: I II III IV V

ARCHITECT: \_\_\_\_\_ ENGINEER: \_\_\_\_\_ NO. of UNITS \_\_\_\_\_ NO. of STORIES \_\_\_\_\_

Plans Submitted: Yes  No  Calculations Submitted: Yes  No  Sewer Fee Req'd. Yes  No

CONTRACTOR: Sisco Inc STATE LICENSE # 9778 CITY LICENSE # 0115733

ADD'L. PERMITS REQ'D: Air Cond.  Elec.  Plumbing  Signs  Paving  Fence  Public Walks  Curb-gutters  Incinerators  Fire Sprinkling System

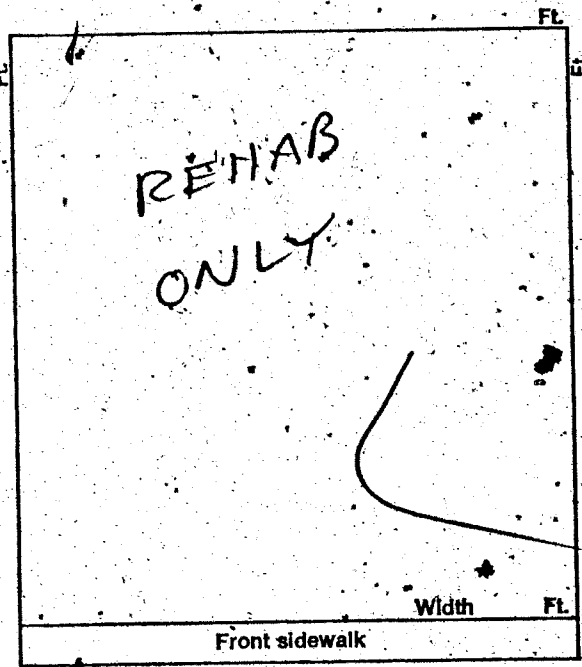

CONDITIONS OF THE PERMIT:

1. I agree to call the City Building Department for inspections before concrete is poured, before rough wiring, electrical, plumbing, framing is covered. Also for air conditioning, sheet-rock and sheathing inspection.
2. I agree that when the job is completed that I will call for final inspection before occupancy.
3. I agree to perform all construction in accordance with City Ordinances and Building Codes.
4. The Contractor's signature below denotes authority from the owner to sign in his behalf and that the owner is aware of all requirements of this application and permit. Separate permits must be taken out for work outlined above this agreement.
5. I have read and understand the contents of this application and permit; I hereby state that the information I have supplied on this application is true and correct.

SIGNED: Sisco Inc Contractor

BY: H. Mills Agent or Owner

\_\_\_\_\_ Date \_\_\_\_\_

CLARK COUNTY HEALTH DEPT. \_\_\_\_\_ Date \_\_\_\_\_

LAS VEGAS FIRE DEPARTMENT \_\_\_\_\_ Date \_\_\_\_\_

PLANNING DEPT.: Maah (PER MPF) Date: 11/21/75

PUBLIC WORKS DEPT.: \_\_\_\_\_ Date: \_\_\_\_\_

BUILDING DEPT.: WRZ Date: 11/21/75

PERMIT NO.: 5011 PERMIT FEE: 1500

RECEIPT

3546 \$015.00 - 8

CITY OF LAS VEGAS  
DEPT. OF BUILDING & SAFETY  
MUST BE MACHINE VALIDATED

24 NOV 75

*These Kynak 1-19-81*

**DEPT. of BLDG & SAFETY - CITY of LAS VEGAS, NEVADA**

OWNER Security Housing Corp ADDRESS 1140 Blankenship Ave. DATE 11-18-70  
 GEN CONT. Same TYPE OF STRUCTURE SFD  
 PERMIT NO. 55854 LEGAL DESCRIPTION Lot 131 C Vegas Heights Unit # 4

BUILDING	MECHANICAL	ELECTRICAL
LOCATION <u>ES 13-16-70 DB 1-4-71</u>	PLUMBING CONT. <u>W 2200</u>	TEMP POLE CONT.
FIREPLACE FTG	PERMIT NO. <u>32098</u> DATE <u>12-21-70</u>	PERMIT NO. _____ DATE _____
FOOTINGS <u>ES 12-16-70 DB 1-15-71</u>	HEAT & VENT. A/C CONT. <u>Spratt</u>	INSPECTION _____ DATE _____
FOUNDATION WALL	PERMIT NO. <u>29695</u> DATE <u>12-30-70</u>	ELECTRICAL CONT. <u>Hinton</u>
FLOOR FRAMING	SEWER CONT.	PERMIT NO. <u>32638</u> DATE <u>1/2/71</u>
SLAB <u>1-16-70</u>	PERMIT NO. _____ DATE _____	FIXTURES CONT.
CHIMNEY STEEL (FIREPLACE)	ROUGH SOIL <u>W 12-15-70</u>	PERMIT NO. _____ DATE _____
WALL STEEL	ROUGH WATER <u>W P 12-13-70</u>	SLAB
COLUMN STEEL	TOP-OUT <u>W 12-30-70</u>	ROUGH <u>W 1-5-71</u>
BEAM STEEL	ROUGH GAS <u>W 12-30-70</u>	FINAL ROUGH
FRAMING <u>DB 1-4-71</u>	A/C ROUGH DUCT <u>W 12-30-70</u>	FINAL FIXTURE
ROOF SHEATHING <u>DB 1-4-71</u>	REF. ROUGH PIPING	FINAL ELECTRICAL
DRYWALL <u>DB 1-14-71 1-18-71</u> INTERIOR EXTERIOR	FINAL PLUMBING <u>W 1-26-71</u>	TEMPORARY SERVICE
LATHING	FINAL GAS <u>W 1-26-71</u>	MISCELLANEOUS
BACKING (SIDING)	FINAL AIR COND. <u>W 1-26-71</u>	GRADING & DRAINAGE
PLASTER SCRATCH	FINAL REFRIG.	ON-SITE PARKING SPACES _____ APP _____
PLASTER BROWN	FINAL SEWER <u>W 12-31-70</u>	ENG APPROVAL OF _____
URBAN REDEVELOPMENT APPROVAL <input type="checkbox"/>	FINAL SEPTIC TANK	OFF-SITE IMPROVEMENTS _____
FINAL BLDG _____ DATE _____		

APPROVED FOR OCCUPANCY & METER J. L. 4-16-71 INSPECTOR \_\_\_\_\_ DATE 11-18-70

PLEASE NOTE REMARKS ON REVERSE SIDE 1140 Blankenship Ave. LOG # \_\_\_\_\_ AREA # \_\_\_\_\_ 23 04

**DEPT. of BLDG. & SAFETY - CITY of LAS VEGAS, NEVADA**

OWNER dasco Inc. ADDRESS 1140 Blankenship DATE 11-21-75  
 GEN CONT. Dasco TYPE OF STRUCTURE Rehab  
 PERMIT NO. 5011 LEGAL DESCRIPTION L 131 C HydePark # 4

BUILDING	MECHANICAL	ELECTRICAL
Investigation	Plumbing Cont.	Temp. pole cont.
Location & Footing	Permit No. _____ Date _____	Permit No. _____ Date _____
Stem Wall	Heat & Vent. A/C Cont.	Inspection _____ Date _____
Concrete Slab Floor	Permit No. _____ Date _____	Electrical Cont. _____
Floor Framing	Sewer Cont.	Permit No. _____ Date _____
Fireplace Footing	Permit No. _____ Date _____	Fixtures Cont.
Chimney Steel	Rough Soil	Permit No. _____ Date _____
Vert. Steel Reinf.	Rough Water	Slab
Horiz. Steel Reinf.	Top Out	Rough
Roof Sheathing	Rough Gas	Final Rough
Framing	A/C Rough Duct	Final Fixture
Backing for siding	Ref. Rough Piping	Final Electrical <u>H 94-876</u>
Ext. Lath	Final Plumbing <u>W 2 P 4-876</u>	Temporary Service
Ext. Scratch	Final Gas <u>W 2 P 4-876</u>	MISCELLANEOUS
Ext. Brown	Final Air Cond.	Grading & Drainage
Int. Lath	Final Refrig.	On-Site Parking Spaces _____ App _____
Int. Brown	Final Sewer	Eng. Approval of _____
Drywall	Final Septic Tank	Off-Site Improvements _____
Permit No. _____		
Final Building _____		
Appr. for Occu. _____		

INSPECTOR: \_\_\_\_\_ DATE \_\_\_\_\_

APPROVED FOR OCCUPANCY & METER W 2 P 4-876

PLEASE NOTE REMARKS ON REVERSE SIDE 1140 Blankenship LOG # \_\_\_\_\_ AREA # \_\_\_\_\_

Dona P. ...

6-16-83

01B-013-009

CITY OF LAS VEGAS, NEVADA

LOG. NO. & AREA

DEPARTMENT OF BUILDING AND SAFETY

CONST. VAL. \$ 819.<sup>00</sup>

APPLICATION & BUILDING PERMIT - for: Fence, Wall, Retaining Wall.

ADDRESS OF CONSTRUCTION: 1140 Blackhawk

OWNER: Clarence & Fernan

LOT(s) 131C BLOCK SUBDIVISION

VEGETA HILLS 4

ZONE R-2

Materials of Construction: Block  Concrete  Wire  Wood  Other  PLANS:  No  Yes

ARCHITECT: ENGINEER: CALCS:  No  Yes


CONTRACTOR: [Signature] STATE LICENSE # CITY LICENSE #

TOTAL SQUARE FEET: 4170 TOTAL LINEAL FEET: 215'

Remarks:

CONDITIONS OF THE PERMIT:

1. Any type of retaining wall must be engineered by a Civil or Structural Engineer.
2. If a home owner takes out the Building Permit and if the owner sublets the work to a Contractor, then the Contractor must take out the permit and pay for it.
3. No fence or wall can be built on City property or rights-of-way, but this is not intended to preclude construction within utility easements if utilities will not be damaged or made inaccessible.
4. The fence or wall shall not enclose any water meter, light standard, or fire alarm box and shall not come closer than 24" from the nearest fire hydrant outlet.
5. Department Inspectors must approve foundation before concrete poured and block wall reinforcing before grouting. **TOTAL \$ 16.00**
6. Maximum height of any wall or fence is 6' and rear yard 4' maximum in front yard with the vertical surface above the height of 2' - 50% open. **TOTAL \$ 16.00**
7. I must not obstruct required onsite parking (2 spaces for each dwelling unit) by the erection of this fence/wall. **TOTAL \$ 16.00**
8. By the signing of this application I hereby agree to the requirements outlined above.

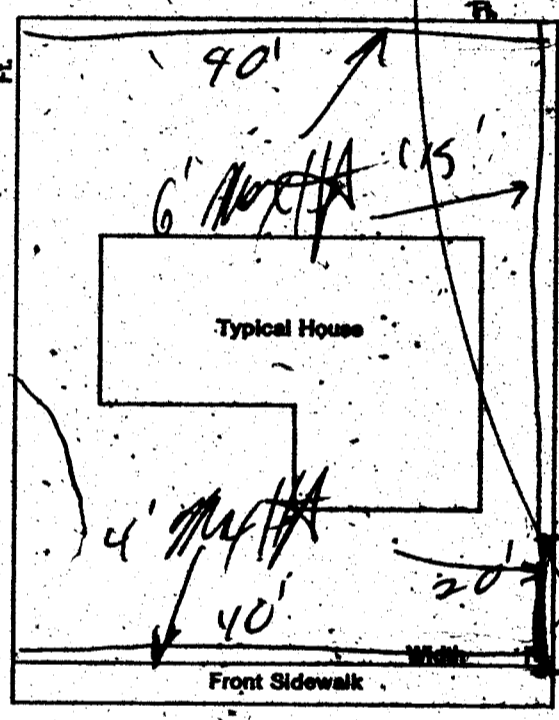

BLDG. & SAFETY 06/13/83

SIGNED: [Signature] DATE: 6-13-83 CONTRACTOR  AGENT  OWNER

PLANNING DEPT: [Signature] Date: 6-13-83  
PUBLIC WORKS DEPT: [Signature] Date: 6-13-83  
BUILDING DIVISION: Date: \_\_\_\_\_  
PERMIT NO: 0560 PERMIT FEE \$ 16.00

RECEIPT  
MUST BE MACHINE VALIDATED

Donna Howard

3-23-84

FENCE & RETAINING WALLS

OWNER: Clarence Foreman DATE: 5-13-83

ADDRESS: 1140 Blankenship

CONTRACTOR: Owner SCHEDULE: 0560 FINAL INSPECTION

LOT: see app BLOCK: SUBDIVISION

LOTT: see app

FENCES (wire, wood, block, & retaining walls)

1	Location	
2	Posting	DB 3-2-84
3	Well Steel	
	1st	
4	Bond Beam	
	1st	
5	Final	DB 3-2-84

Specify Type Of Fence