

6212 BRITTANY WAY

LOT 29 BLK 6 CHARLESOTN HGTS #21 ZONE R-1

L. Gatewood 1-30-79

LOG NO. & AREA

CITY OF LAS VEGAS, NEVADA

CONST. VAL.

1967 500.00

DEPARTMENT OF BUILDING & SAFETY

APPLICATION & BUILDING PERMIT — for:

Dwellings, Duplexes, Misc. Residential Const.

ADDRESS OF CONSTRUCTION:

6212 Brittany

OWNER:

William J. Calvert

LOT(s)

29

BLOCK

6

SUBDIVISION

Char. Hpts. Tr. #21

ZONE: R-1

Existing structure on lot: Dwelling ☒ Accessory bldgs. ☐ Vacant lot ☐ Other ☐

PROPOSED CONSTRUCTION:

Enclose carport

USE: Family Room

MATERIALS OF CONSTRUCTION: Wood Frame ☒ Concrete Block ☐ Reinforced Concrete ☐ Steel Frame ☐

SQUARE FEET OF FLOOR AREAS: 1st _____ 2nd _____ 3rd _____ Other _____ TOTAL SQ. FT. 200


FIRE ZONE: 1 2 3 Occupancy Group A B C D E F G H I J-1-2-3-4-5 CONST. TYPE: I II III IV V

ARCHITECT: _____ ENGINEER: _____ NO. of UNITS _____ NO. of STORIES _____

Plans Submitted: Yes ☐ No ☐ Calculations Submitted: Yes ☐ No ☐ Sewer Fee Req'd. Yes ☐ No ☐

CONTRACTOR: OWNER STATE LICENSE # _____ CITY LICENSE # _____

ADD'L. PERMITS REQ'D: Air Cond. ☐ Elec. ☒ Plumbing ☐ Signs ☐ Paving ☐ Fence ☐ Public Walks ☐ Curb-gutters ☐ Incinerators ☐ Fire Sprinkling System ☐

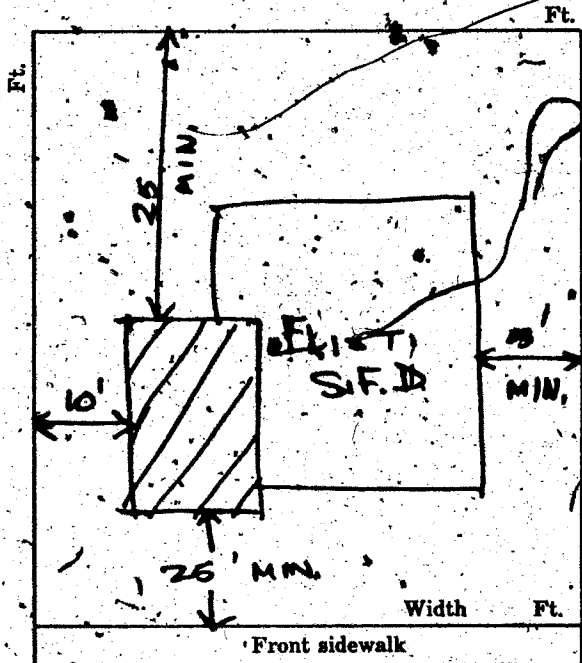

CONDITIONS OF THE PERMIT:

1. I agree to call the City Building Department for inspections before concrete is poured, before rough wiring, electrical, plumbing, framing is covered. Also for Air conditioning, sheet-rock and sheathing inspection.
2. I agree that when the job is completed that I will call for final inspection before occupancy.
3. I agree to perform all construction in accordance with City Ordinances and Building Codes.
4. The Contractor's signature below denotes authority from the owner to sign in his behalf and that the owner is aware of all requirements of this application and permit. Separate permits must be taken out for work outlined above this agreement.
5. I have read and understand the contents of this application and permit; I hereby state that the information I have supplied on this application is true and correct.

SIGNED: _____ Contractor

BY: William J. Calvert Agent or Owner

CLARK COUNTY HEALTH DEPT.

LAS VEGAS FIRE DEPARTMENT

RECEIPT

1361, \$805.00 - 8

CITY OF LAS VEGAS

RECEIVED & PAID

MUST BE MACHINE VALIDATED

29 NOV 67

PLANNING DEPT: _____ Date: 11-27-67

ENGINEERING DEPT: _____ Date: _____

BUILDING DEPT: _____ Date: 11-27-67

#1285 PERMIT NO: 39429 PERMIT FEE \$: 500

H. Gatewood 1-30-79

CITY OF LAS VEGAS, NEVADA

DEPARTMENT OF BUILDING & SAFETY - ELECTRICAL APPLICATION & PERMIT

ADDRESS OF CONSTRUCTION: 6212 Brittany

OWNER'S NAME: William Colbert

LOT(S) BLOCK SUBDIVISION Type of bldg. SFD ☐ Apt. ☐ Comm. ☐

Check Proper Construction: New Bldg. ☐ Addn. ☒ Remodel ☐ Temporary Pole ☐ Old Bldg. ☐

CONTRACTOR'S NAME: STATE LICENSE # CITY LICENSE #

NUMBER	FIXTURE OR INSTALLATION	UNIT PRICE
	Fixture or sockets	.15
2	Light, receptacle or switch outlet	.20
	Wall or ceiling space heater	.35
	Blast coil heater per kilowatt	.35
	Garbage grinder outlet	.35
	Dishwasher outlet	.35
	Clothes dryer outlet	.35
	Automatic clothes washer	.35
	Electric range outlet	.35
	Electric water heater outlet	.35
	Mercury arc lamp and equipment	.35
	Special purpose outlet	.35
	X-ray unit and its appurtenances	5.00
	Watts of festoon lighting (Watts) First 3,000 watts	4.00
	for each additional thousand watts	1.50
	Horsepower - all motors first horsepower or less	1.75
	for each additional horsepower	.35
	Temporary power and lights (temporary pole)	4.00
	Electric service (including any single meter socket)	3.00
	for each additional socket	.35
	Air conditioning service amps	1.50
	Each KW (KVA) Generator (Transformer) (Welder) KW (KVA)	2.00
	First 100 KVA - For each additional KW (KVA)	.01
	Special inspection per hour	4.00
	Speaker outlets	.15
	Signal or Alarm outlets	.15
	Amplifiers	.50
	Control panels	.25
	T. V. outlets - master system only	.15
	Radio outlets	.15
	Main control racks	1.00
	T. V. and Radio antennas - master system only	.75
	Minimum fee for any permit	4.00
	Total fee	4.00

I hereby certify that I have carefully examined and read the above application; that the same is true and correct; and that the work herein described is to be done in accordance with all the provisions of the applicable Ordinances of the City of Las Vegas, Nevada and State laws whether herein specified or not.

SIGNED William J. Colbert MASTER (ELECTRICIAN) (TECHNICIAN) (OWNER)

Date

BUILDING DEPARTMENT

Date 1-27-67

#1286

PERMIT NO. 24355

PERMIT FEE \$ 4.00

RECEIPT

1302 5000.00 6

CITY OF LAS VEGAS

MUST BE MACHINE VALIDATED

H. Gatewood 1-30-79

CITY OF LAS VEGAS, NEVADA

LOG NO. & AREA

DEPARTMENT OF BUILDING & SAFETY

1970

CONST. VAL. \$

2900⁰⁰

APPLICATION & BUILDING PERMIT - for:

Dwellings, Duplexes, Misc. Residential Const.

ADDRESS OF CONSTRUCTION:

6212 BRITTANY WAY

OWNER:

WILLIAM CALVERT

LOT(s)

29

BLOCK

6

SUBDIVISION

CHARLESTON 297'S #21

ZONE:

R1

Existing structure on lot:

Dwelling

☒

Accessory bldgs.

☐

Vacant lot

☐

Other

☐

PROPOSED CONSTRUCTION:

2 BR. RM ADDITION

USE:

Bed Rooms

MATERIALS OF CONSTRUCTION:

Wood Frame

☐

Concrete Block

☐

Reinforced Concrete

☐

Steel Frame

☐

SQUARE FEET OF FLOOR AREAS:

1st

2nd

3rd

Other

TOTAL SQ. FT.

364

FIRE ZONE:

1 2 3

Occupancy Group

A

B

C

D

E

F

G

H

I

J-I-2-3-4-5

CONST. TYPE:

I

II

III

IV

V

ARCHITECT:

ENGINEER:

NO. of UNITS

NO. of STORIES

Plans Submitted:

Yes

☐

No

☐

Calculations Submitted

Yes

☐

No

☐

Sewer Fee Req'd.

Yes

☐

No

☐

CONTRACTOR:

OWNER

STATE LICENSE #

CITY LICENSE #

ADD'L. PERMITS REQ'D:

Air Cond.

☐

Elec.

☐

Plumbing

☐

Signs

☐

Paving

☐

Fence

☐

Public Walks

☐

Curb-gutters


☐

Incinerators

☐

Fire Sprinkling System

☐

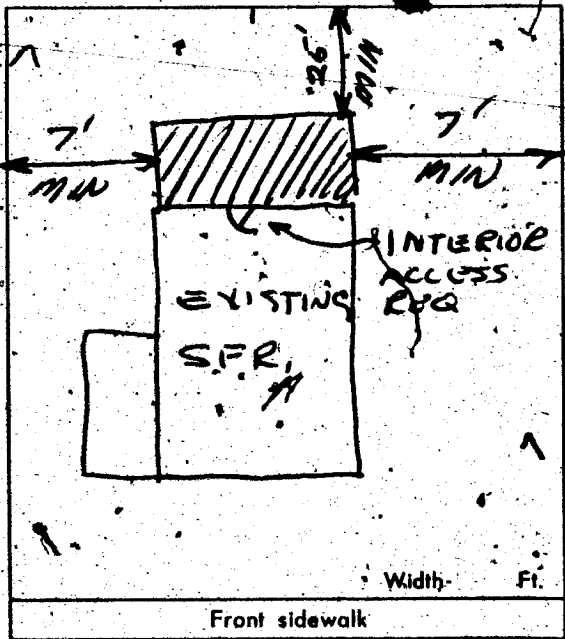

CONDITIONS OF THE PERMIT:

1. I agree to call the City Building Department for inspections before concrete is poured, before rough wiring, electrical, plumbing, framing is covered. Also for Air conditioning, sheet-rock and sheathing inspection.
2. I agree that when the job is completed that I will call for final inspection before occupancy.
3. I agree to perform all construction in accordance with City Ordinances and Building Codes.
4. The Contractor's signature below denotes authority from the owner to sign in his behalf and that the owner is aware of all requirements of this application and permit. Separate permits must be taken out for work outlined above this agreement.
5. I have read and understand the contents of this application and permit; I hereby state that the information I have supplied on this application is true and correct.

SIGNED:

Contractor

BY:

William Calvert

Agent or Owner

Date

CLARK COUNTY HEALTH DEPT.

Date

LAS VEGAS FIRE DEPARTMENT

PLANNING DEPT.

Date:

7/9/70

PUBLIC WORKS DEPT.

Date:

BUILDING DEPT.

Date:

7-9-70

#12850

PERMIT NO.

54083

PERMIT FEE \$

1800

RECEIPT

6849 \$018.00 - 8

CITY OF LAS VEGAS
DEPT. OF
BUILDING & SAFETY

MUST BE MACHINE VALIDATED

10 JUL 70

W. Datwood 1-30-79.

CITY OF LAS VEGAS, NEVADA

DEPARTMENT OF BUILDING & SAFETY - ELECTRICAL APPLICATION & PERMIT

ADDRESS OF CONSTRUCTION: 6712 Brittany

OWNER'S NAME: William J. Calvert

CIRCLE: New Bldg. Add'n Remodel TYPE OF BLDG.: SFD. APT. PUBLIC COMM.

CONTRACTOR'S NAME:

STATE LICENSE #

CITY LICENSE #

NUMBER	FIXTURE OR INSTALLATION	UNIT PRICE	
2	Fixture or sockets	.15	130
9	Light, receptacle or switch outlet	.20	1.80
	Wall or ceiling space heater	.35	
	Blast coil heater per kilowatt	.35	
	Garbage grinder outlet	.35	
	Dishwasher outlet	.35	
	Clothes dryer outlet	.35	
	Automatic clothes washer	.35	
	Electric range outlet	.35	
	Electric water heater outlet	.35	
	Mercury arc lamp and equipment	.35	
	Special purpose outlet	.35	
	X-ray unit and its appurtenances	5.00	
	Watts of festoon lighting (Watts) First 3,000 watts	4.00	
	for each additional thousand watts	1.50	
	Horsepower - all motors first horsepower or less	1.75	
	for each additional horsepower	.35	
	Temporary power and lights (temporary pole)	4.00	
1	Electric service (including any single meter socket)	3.00	3.00
	for each additional socket	.35	
	Air conditioning service amps	1.50	
	Each KW (KVA) Generator (Transformer) (Welder) KW (KVA)	2.00	
	First 100 KVA - For each additional KW (KVA)	.01	
	Special inspection per hour	4.00	
	Speaker outlets	.15	
	Signal or Alarm outlets	.15	
	Amplifiers	.50	
	Control panels	.25	
	T. V. outlets - master system only	.15	
	Radio outlets	.15	
	Main control racks	1.00	
	T. V. and Radio antennas - master system only	.75	
	Minimum fee for any permit	4.00	
	Total fee		3.10

I hereby certify that I have carefully examined and read the above application; that the same is true and correct; and that the work herein described is to be done in accordance with all the provisions of the applicable Ordinances of the City of Las Vegas, Nevada and State laws whether herein specified or not.

SIGNED

William J. Calvert

DATE

BUILDING DEPARTMENT

J. U. Kemp

DATE

1-30-79

*12860

PERMIT NO.

31120

PERMIT FEE: \$

5.10

RECEIPT

6922 \$005.10 - 6

CITY OF LAS VEGAS

DEPT. OF BUILDING & SAFETY

1-30-79

L. Gatewood 1-30-79

#6190

CITY OF LAS VEGAS, NEVADA

7971

LOG NO. & AREA

DEPARTMENT OF BUILDING & SAFETY

CONST. VAL. \$

APPLICATION & BUILDING PERMIT - for:

Dwellings, Duplexes, Misc. Residential Const.

ADDRESS OF CONSTRUCTION: 6212 Buttery

OWNER: Calvert

LOT(s) BLOCK SUBDIVISION ZONE

Existing structure on lot: Dwelling ☐ Accessory bldgs. ☐ Vacant lot ☐ Other ☐

PROPOSED CONSTRUCTION: Roofing USE:

MATERIALS OF CONSTRUCTION: Wood Frame ☐ Concrete Block ☐ Reinforced Concrete ☐ Steel Frame ☐

SQUARE FEET OF FLOOR AREAS: 1st 2nd 3rd Other TOTAL SQ. FT.

FIRE ZONE: 1 2 3 Occupancy Group A B C D E F G H I J-1-2-3-4-5 CONST. TYPE: I II III IV V

ARCHITECT: ENGINEER: NO. of UNITS NO. of STORIES

Plans Submitted: Yes ☐ No ☐ Calculations Submitted: Yes ☐ No ☐ Sewer Fee Req'd. Yes ☐ No ☐

CONTRACTOR: Las Vegas Roofing STATE LICENSE # CITY LICENSE #

ADD'L. PERMITS REQ'D: Air Cond. ☐ Elec. ☐ Plumbing ☐ Signs ☐ Paving ☐ Fence ☐ Public Walks ☐ Curb-gutters ☐ Incinerators ☐ Fire Sprinkling System ☐

Front sidewalk

Width. Ft.

Ft.

CONDITIONS OF THE PERMIT:

1. I agree to call the City Building Department for inspections before concrete is poured, before rough wiring, electrical, plumbing, framing is covered. Also for Air conditioning, sheet-rock and sheathing inspection.

2. I agree that when the job is completed that I will call for final inspection before occupancy.

3. I agree to perform all construction in accordance with City Ordinances and Building Codes.

4. The Contractor's signature below denotes authority from the owner to sign in his behalf and that the owner is aware of all requirements of this application and permit. Separate permits must be taken out for work outlined above this agreement.

5. I have read and understand the contents of this application and permit; I hereby state that the information I have supplied on this application is true and correct.

SIGNED: Las Vegas Roofing Contractor

BY: [Signature] Agent or Owner

CLARK COUNTY HEALTH DEPT. Date

LAS VEGAS FIRE DEPARTMENT Date

PLANNING DEPT. Date:

PUBLIC WORKS DEPT. Date:

BUILDING DEPT. J. Wenzl Date: 6-16-71

#12850 PERMIT NO: 81007 PERMIT FEE \$ 500

RECEIPT

786 \$005.00

CITY OF LAS VEGAS

DEPT. OF BUILDING & SAFETY

MUST BE MACHINE VALIDATED

17 JUN 71

D. Gatewood 1-30-79

CITY OF LAS VEGAS, NEVADA

LOG NO. & AREA

DEPARTMENT OF BUILDING & SAFETY

CONST. VAL. \$

2412

APPLICATION & BUILDING PERMIT — for
Fence, Wall, Retaining Wall.

ADDRESS OF
CONSTRUCTION:

6212 Brittany Way

OWNER

Wm Calvert

LOT(s)

29

BLOCK

6

SUBDIVISION

CHAM HGT'S #21

ZONE

R1

Materials of Construction:

Block ☐

Concrete ☒

Wire ☐

Wood ☐

Other ☐

Yes No

PLANS

☐ ☐

ARCHITECT

ENGINEER

CALCS

☐ ☐

CONTRACTOR

Owner

STATE
LICENSE #

CITY
LICENSE #

TOTAL SQUARE FEET

1608


TOTAL LINEAL FEET

268

Remarks:

CONDITIONS OF THE PERMIT:

1. Any type of retaining wall must be engineered by a Civil or Structural Engineer.
2. If a home owner takes out the Building Permit and if the owner sublets the work to a Contractor, then the Contractor must take out the permit and pay for it.
3. No fence or wall can be built on City property or rights-of-way, but this is not intended to preclude construction within utility easements if utilities will not be damaged or made inaccessible.
4. The fence or wall shall not enclose any water meter, light standard, or fire alarm box and shall not come closer than 24" from the nearest fire hydrant outlet.
5. Department Inspectors must approve footings before concrete is poured and block wall reinforcing before grouting is done.
6. Maximum height of any wall or fence is 6' side and rear yards; 4' maximum in front yard with the vertical surface above the height of 2' — 50% open.
7. I must not obstruct required onsite parking space (2 spaces for each dwelling unit) by the erection of this fence or wall.
8. By the signing of this application I herewith agree to the requirements outlined above.

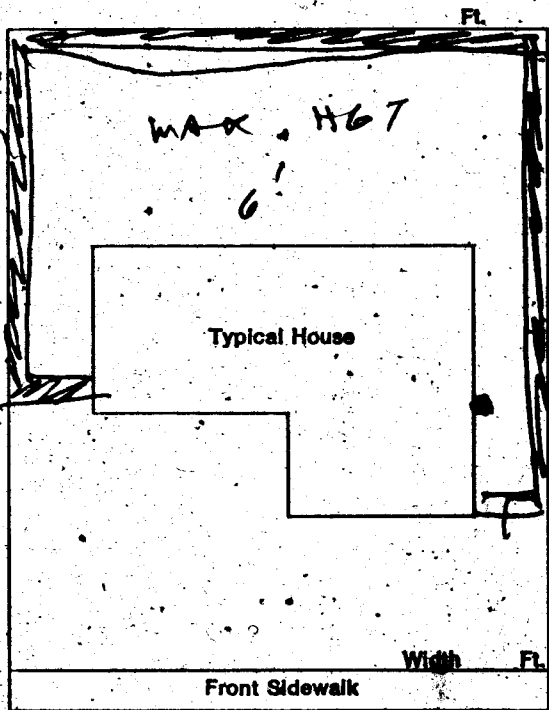

SIGNED

William Calvert

DATE

CONTRACTOR ☐

AGENT ☐

OWNER ☐

PLANNING DEPT.

Date

6/14/76

PUBLIC WORKS DEPT.

Date

BUILDING DEPT.

Date

6-14-76

#12850

PERMIT NO.

3146

PERMIT FEE \$

18.00

RECEIPT

3440 \$018.00 - 8

CITY OF LAS VEGAS

MUST BE MACHINE VALIDATED

Calvert L. Jackson 2/24/80

DEPT. of BLDG & SAFETY—CITY of LAS VEGAS, NEVADA
OWNER Calvert ADDRESS 6212 Brittany DATE 6/17/71
GEN. CONT. Las Vegas Roofing TYPE OF STRUCTURE Roofing
PERMIT NO. 81007 LEGAL DESCRIPTION

BUILDING		MECHANICAL	ELECTRICAL
LOCATION		PLUMBING CONT.	TEMP. POLE CONT.
FIREPLACE FTS.		PERMIT NO. DATE	PERMIT NO. DATE
FOOTINGS		HEAT & VENT. AC CONT.	INSPECTION DATE
FOUNDATION WALL		PERMIT NO. DATE	ELECTRICAL CONT.
FLOOR FRAMING		SEWER CONT.	PERMIT NO. DATE
SLAB		PERMIT NO. DATE	FIXTURES CONT.
CHIMNEY STEEL (FIREPLACE)		ROUGH SOL.	PERMIT NO. DATE
WALL STEEL		ROUGH WATER	SLAB
COLUMN STEEL		TOP-OUT	ROUGH
BEAM STEEL		ROUGH GAS	FINAL ROUGH
FRAMING		AC ROUGH DUCT	FINAL FIXTURE
ROOF SHEATHING		REF. ROUGH PIPING	FINAL ELECTRICAL
INTERIOR	EXTERIOR	FINAL PLUMBING	TEMPORARY SERVICE
DRYWALL		FINAL GAS	
LATHING		FINAL AIR COND.	
BACKING (SIDING)		FINAL REFRIG.	
PLASTER	SCRATCH	FINAL SEWER	
	BROWN	FINAL SEPTIC TANK	
URBAN REDEVELOPMENT APPROVAL			
FINAL BLDG	DATE		

MISCELLANEOUS	
GRADING & DRAINAGE	
ON-SITE PARKING SPACES	APP.
ENG. APPROVAL OF	
OFF-SITE IMPROVEMENTS	

APPROVED FOR OCCUPANCY & METER 226-21-71 INSPECTOR DATE

PLEASE NOTE REMARKS ON REVERSE SIDE 6212 Brittany LOG # AREA # 23 04

DEPARTMENT OF BUILDING & SAFETY
CITY OF LAS VEGAS, NEVADA

KARDEX CARD
FENCE & RETAINING
WALLS

OWNER Wm Calvert ADDRESS 6212 Brittany Way DATE 6-14-76

CONTRACTOR Owner PERMIT NO. 3146

LOT 1 BLOCK 1 SUBDIVISION concrete fence

Fence (wire, wood, etc.)	Walls (masonry, rock, etc.)
Location	Location <u>046-14-76</u>
Final Inspection	Footing <u>046-14-76</u>
	Wall Steel 1st <u>2d</u> 3d
	Final Inspection <u>046-23-76</u>

Retaining Wall (masonry)	Retaining Wall (concrete)
Location	Location
Footing	Footing
Wall Steel 1st <u>2d</u> 3d	Wall Steel 1st <u>2d</u> 3d
Bond Beam 1st <u>2d</u> 3d	Final Inspection
Final Inspection	

Angela L. Jackson 2/24/80

DEPT. of BLDG & SAFETY—CITY of LAS VEGAS, NEVADA

OWNER William Calvert ADDRESS 6212 Brittany DATE 11/28/67

GEN. CONT. Owner TYPE OF STRUCTURE Enclosed

PERMIT NO. 39129 LEGAL DESCRIPTION L 29 B 6 Charleston Heights #21

BUILDING		MECHANICAL		ELECTRICAL	
LOCATION		PLUMBING CONT.		TEMP. POLE CONT.	
FIREPLACE FTS.		PERMIT NO.	DATE	PERMIT NO.	DATE
FOOTINGS		HEAT & VENT. AC CONT.		INSPECTION	DATE
FOUNDATION WALL		PERMIT NO.	DATE	ELECTRICAL CONT. <u>Owner</u>	
FLOOR FRAMING		SEWER CONT.		PERMIT NO. <u>21355</u>	DATE <u>11/28/67</u>
SLAB		PERMIT NO.	DATE	FIXTURES CONT.	
CHIMNEY STEEL (FIREPLACE)		ROUGH SOIL		PERMIT NO.	DATE
WALL STEEL		ROUGH WATER		SLAB	
COLUMN STEEL		TOP-OUT		ROUGH <u>Walls 11-12-67</u>	
BEAM STEEL		ROUGH GAS		FINAL ROUGH	
FRAMING <u>11-15-67</u>		AC ROUGH DUCT		FINAL FIXTURE	
ROOF SHEATHING		REF. ROUGH PIPING		FINAL ELECTRICAL	
INTERIOR	EXTERIOR	FINAL PLUMBING		TEMPORARY SERVICE	
DRYWALL		FINAL GAS			
LATHING		FINAL AIR COND.			
BACKING (SIDING)		FINAL REFRIG.			
PLASTER		FINAL SEWER			
SCRATCH		FINAL SEPTIC TANK			
BROWN					
URBAN REDEVELOPMENT APPROVAL					
FINAL BLDG	DATE				

APPROVED FOR OCCUPANCY METER C.H. 10-14-68 INSPECTOR

PLEASE NOTE REMARKS ON REVERSE SIDE 6212 Brittany LOG # AREA # 23.04

DEPT. of BLDG & SAFETY—CITY of LAS VEGAS, NEVADA

OWNER William Calvert ADDRESS 6212 Brittany Way DATE 7/10/70

GEN. CONT. Owner TYPE OF STRUCTURE 2 Bed Add.

PERMIT NO. 54083 LEGAL DESCRIPTION L 29 B 6 Charleston Heights #21

BUILDING		MECHANICAL		ELECTRICAL	
LOCATION		PLUMBING CONT.		TEMP. POLE CONT.	
FIREPLACE FTS.		PERMIT NO.	DATE	PERMIT NO.	DATE
FOOTINGS		HEAT & VENT. AC CONT.		INSPECTION	DATE
FOUNDATION WALL		PERMIT NO.	DATE	ELECTRICAL CONT. <u>Owner</u>	
FLOOR FRAMING		SEWER CONT.		PERMIT NO. <u>31120</u>	DATE <u>7-13-70</u>
SLAB <u>CH 7-12-70</u>		PERMIT NO.	DATE	FIXTURES CONT.	
CHIMNEY STEEL (FIREPLACE)		ROUGH SOIL		PERMIT NO.	DATE
WALL STEEL		ROUGH WATER		SLAB	
COLUMN STEEL		TOP-OUT		ROUGH <u>Walls 7-15-70</u>	
BEAM STEEL		ROUGH GAS		FINAL ROUGH	
FRAMING <u>CH 7-13-70</u>		AC ROUGH DUCT		FINAL FIXTURE	
ROOF SHEATHING <u>CH 7-15-70</u>		REF. ROUGH PIPING		FINAL ELECTRICAL	
INTERIOR	EXTERIOR	FINAL PLUMBING		<u>Made Key 7-16-70</u>	
DRYWALL		FINAL GAS		TEMPORARY SERVICE	
LATHING		FINAL AIR COND.			
BACKING (SIDING)		FINAL REFRIG.			
PLASTER		FINAL SEWER			
SCRATCH		FINAL SEPTIC TANK			
BROWN					
URBAN REDEVELOPMENT APPROVAL					
FINAL BLDG	DATE				

APPROVED FOR OCCUPANCY METER Office 7-27-71 INSPECTOR

PLEASE NOTE REMARKS ON REVERSE SIDE 6212 Brittany Way LOG # AREA # 23.04

Angela L. Jackson 2/24/80

DEPT. of BLDG & SAFETY—CITY of LAS VEGAS, NEVADA

OWNER William Cabert ADDRESS 6212 Brittany DATE 11/28/67
GEN. CONT. Owner TYPE OF STRUCTURE Enclosed Port
PERMIT NO. 39129 LEGAL DESCRIPTION L 29 B 6 Charleston Heights #21

BUILDING		MECHANICAL		ELECTRICAL	
LOCATION		PLUMBING CONT.		TEMP. POLE CONT.	
FIREPLACE FTS.		PERMIT NO.	DATE	PERMIT NO.	DATE
FOOTINGS		HEAT & VENT. AC CONT.		INSPECTION	DATE
FOUNDATION WALL		PERMIT NO.	DATE	ELECTRICAL CONT.	<u>Owner</u>
FLOOR FRAMING		SEWER CONT.		PERMIT NO.	<u>21,355</u> DATE <u>11/28/67</u>
SLAB		PERMIT NO.	DATE	FIXTURES CONT.	
CHIMNEY STEEL (FIREPLACE)		ROUGH SOL.		PERMIT NO.	DATE
WALL STEEL		ROUGH WATER		SLAB	
COLUMN STEEL		TOP-OUT		ROUGH	<u>12-12-67</u>
BEAM STEEL		ROUGH GAS		FINAL ROUGH	
FRAMING	<u>11-11-67</u>	AC ROUGH DUCT		FINAL FIXTURE	
ROOF SHEATHING		REF. ROUGH PIPING		FINAL ELECTRICAL	
INTERIOR		FINAL PLUMBING		TEMPORARY SERVICE	
EXTERIOR		FINAL GAS			
DRYWALL		FINAL AIR COND.		MISCELLANEOUS	
LATHING		FINAL REFRIG.		GRADING & DRAINAGE	
BACKING (SIDING)		FINAL SEWER		ON-SITE PARKING SPACES	APP.
PLASTER	<u>SCRATCH</u>	FINAL SEPTIC TANK		ENG. APPROVAL OF	
PLASTER	<u>BROWN</u>			OFF-SITE IMPROVEMENTS	
URBAN REDEVELOPMENT APPROVAL					
FINAL BLDG	DATE				

APPROVED FOR OCCUPANCY & METER

INSPECTOR

DATE

PLEASE NOTE REMARKS ON REVERSE SIDE

6212 Brittany

LOG #

AREA #

23.04

DEPT. of BLDG & SAFETY—CITY of LAS VEGAS, NEVADA

OWNER William Calvert ADDRESS 6212 Brittany Way DATE 7/10/70
GEN. CONT. Owner TYPE OF STRUCTURE 2 Bed Add
PERMIT NO. 54083 LEGAL DESCRIPTION L 29 B 6 Charleston Heights #21

BUILDING		MECHANICAL		ELECTRICAL	
LOCATION		PLUMBING CONT.		TEMP. POLE CONT.	
FIREPLACE FTS.		PERMIT NO.	DATE	PERMIT NO.	DATE
FOOTINGS		HEAT & VENT. AC CONT.		INSPECTION	DATE
FOUNDATION WALL		PERMIT NO.	DATE	ELECTRICAL CONT.	<u>Owner</u>
FLOOR FRAMING		SEWER CONT.		PERMIT NO.	<u>31120</u> DATE <u>7-13-70</u>
SLAB	<u>CH 7-10-70</u>	PERMIT NO.	DATE	FIXTURES CONT.	
CHIMNEY STEEL (FIREPLACE)		ROUGH SOL.		PERMIT NO.	DATE
WALL STEEL		ROUGH WATER		SLAB	
COLUMN STEEL		TOP-OUT		ROUGH	<u>7-15-70</u>
BEAM STEEL		ROUGH GAS		FINAL ROUGH	
FRAMING	<u>CH 7-10-70</u>	AC ROUGH DUCT		FINAL FIXTURE	
ROOF SHEATHING	<u>CH 7-15-70</u>	REF. ROUGH PIPING		FINAL ELECTRICAL	
INTERIOR		FINAL PLUMBING		TEMPORARY SERVICE	
EXTERIOR		FINAL GAS			
DRYWALL		FINAL AIR COND.		MISCELLANEOUS	
LATHING		FINAL REFRIG.		GRADING & DRAINAGE	
BACKING (SIDING)		FINAL SEWER		ON-SITE PARKING SPACES	APP.
PLASTER	<u>SCRATCH</u>	FINAL SEPTIC TANK		ENG. APPROVAL OF	
PLASTER	<u>BROWN</u>			OFF-SITE IMPROVEMENTS	
URBAN REDEVELOPMENT APPROVAL					
FINAL BLDG	DATE				

APPROVED FOR OCCUPANCY & METER

INSPECTOR

DATE

PLEASE NOTE REMARKS ON REVERSE SIDE

6212 Brittany Way

LOG #

AREA #

23.04

Register Jackson 2/24/80

DEPT. of BLDG. & SAFETY - CITY of LAS VEGAS, NEVADA

OWNER: SPROUL HOMES, INC. ADDRESS: 6212 Brittany Way DATE: 8/30/60

GEN. CONT. SAME TYPE OF STRUCTURE S. F. DWELLING

PERMIT NO. 1383 LEGAL DESCRIPTION: Lot 29, Bl. 6, Chas. Hts. #21

LOCATION & FLOOR ELEVATION FOOTINGS <u>Arthur 9-18-60</u> FOUND. & MEMS WALL STEEL BOND BEAM STEEL FRAMING & ROOF SHEATHING <u>Arthur 10-13-60</u> STEEL FABRICATION CONNECTIONS & PAINTING LATHING PLASTER SCRATCH BROWN FINAL BLDG. <u>Arthur 12-2-60</u> GRADING & DRAINAGE ON-SITE PARKING ENG. APPROVAL OF OFF-SITE IMPROVEMENTS	PLUMBING CONT. <u>limited</u> PERMIT NO. <u>1319</u> DATE <u>9-27-60</u> HEAT & VENT. CONT. <u>limited</u> PERMIT NO. <u>1436</u> DATE <u>10-13-60</u> SEWER CONT. <u>limited</u> PERMIT NO. <u>1319</u> DATE <u>9-27-60</u> ROUGH SOIL <u>Bailey 9-26-60</u> ROUGH WATER <u>Bailey 9-26-60</u> SEWER OR SEPTIC TANK <u>Bailey 11-18-60</u> TOP-OUT <u>Gordon 10-18-60</u> ROUGH GAS ROUGH DUCT <u>Mace 10-14-60</u> FINAL PLUMBING <u>Bailey 11-22-60</u> FINAL HEATING <u>W. K. 11-22-60</u> FINAL GAS <u>Bailey 11-22-60</u>	TEMP. POLE CONT. PERMIT NO. DATE INSPECTION DATE ELECTRICAL CONT. <u>Robert</u> PERMIT NO. <u>1412</u> DATE <u>10-22-60</u> OUTLETS <u>43</u> MOTORS SLAB ROUGH FINAL ROUGH FIXTURE CONT. <u>Robert</u> PERMIT NO. <u>1412</u> DATE <u>10-22-60</u> FIXTURES <u>9</u> FINAL FIXTURE APPROVED FOR METER <u>Arthur 12-2-60</u>
---	--	---

APPROVED for OCCUPANCY: Arthur 12-2-60

INSPECTOR

DATE

PLEASE NOTE REMARKS ON REVERSE SIDE

6212 Brittany Way

DWELLING 8/30/60

LOG: # T-31 Area: # 4

23.04

DEPT. of BLDG. & SAFETY - CITY of LAS VEGAS, NEVADA

OWNER: WILLIAM J. CALVERT ADDRESS: 6212 Brittany Way DATE: 5-21-62

GEN. CONT. owner TYPE OF STRUCTURE wood fence

PERMIT NO. 10088 LEGAL DESCRIPTION

BUILDING LOCATION FIREPLACE FTG FOOTINGS FOUNDATION WALL STEM WALL FLOOR FRAMING SLAB CHIMNEY STEEL (FIREPLACE) WALL STEEL COLUMN STEEL BEAM STEEL STEEL FABRICATION FRAMING ROOF SHEATHING INTERIOR EXTERIOR DRYWALL LATHING BACKING (SIDING) PLASTER SCRATCH BROWN FINAL BLDG. <u>1014</u> DATE <u>11-5-62</u>	MECHANICAL PLUMBING CONT. PERMIT NO. DATE HEAT & VENT. AC CONT. PERMIT NO. DATE SEWER CONT. PERMIT NO. DATE ROUGH SOIL ROUGH WATER TOP-OUT ROUGH GAS AC ROUGH DUCT REF. ROUGH PIPING FINAL PLUMBING FINAL GAS FINAL AIR COND. FINAL HEATING FINAL SEWER FINAL SEPTIC TANK	ELECTRICAL TEMP. POLE CONT. PERMIT NO. DATE INSPECTION DATE ELECTRICAL CONT. PERMIT NO. DATE FIXTURES CONT. PERMIT NO. DATE SLAB ROUGH FINAL ROUGH FINAL FIXTURE TEMPORARY SERVICE MISCELLANEOUS URBAN REDEVELOPMENT APPROVAL GRADING & DRAINAGE ON-SITE PARKING SPACES APP. ENG. APPROVAL OF OFF-SITE IMPROVEMENTS
--	--	--

APPROVED FOR OCCUPANCY

APPROVED FOR METER

PLEASE NOTE REMARKS ON REVERSE SIDE

6212 Brittany Way

LOG #

AREA #

23.04